



B.M. 164.50 "R" in Ritchie E.L. Capri N. Co. Zimmerly
 B.M. 164.77 "K" in Ritchie Top Ch. E. end radi. N.E. Co. Zimmerly & Rosalik
 B.M. 155.31 "R" in Ritchie E.L. Capri S. Co. Bayley

Final Quantities

Units	Quantities	Totals
C.Y.	Excav.	1985.9

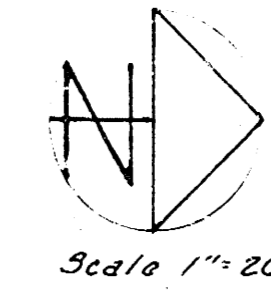

Units	Quantities	Totals

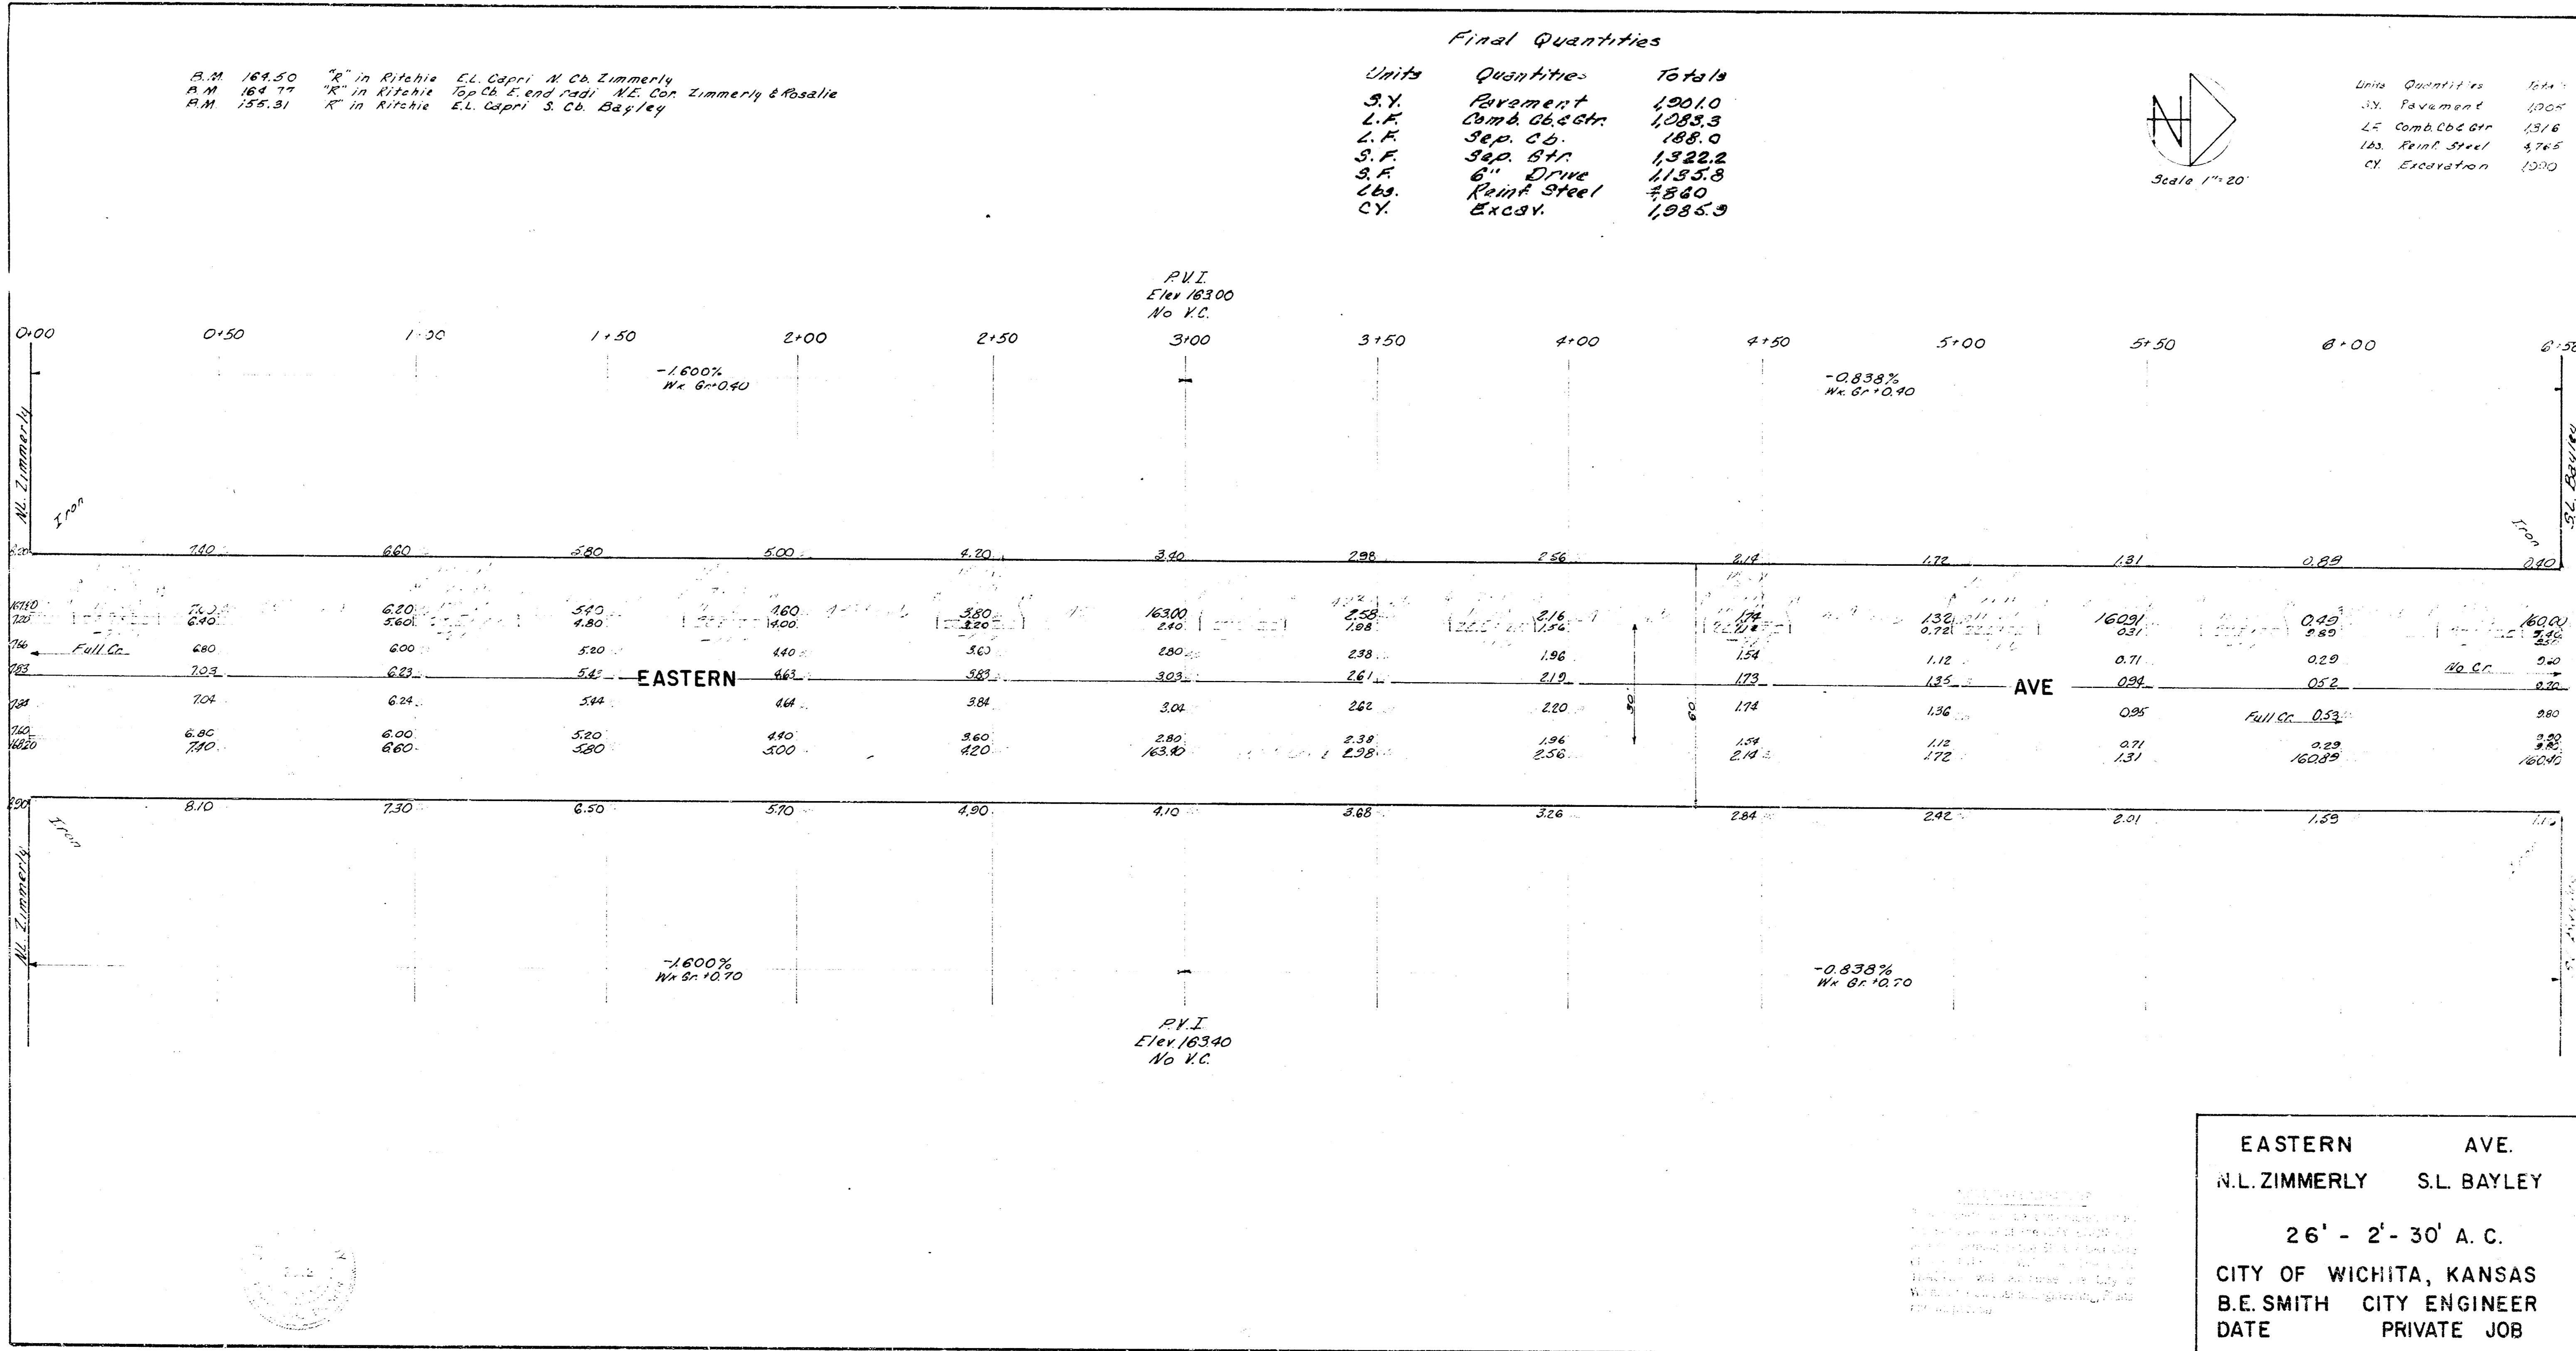

EASTERN AVE.
 N.L. ZIMMERLY S.L. BAYLEY
 26' - 2' - 30' A.C.
 CITY OF WICHITA, KANSAS
 B.E. SMITH CITY ENGINEER
 DATE PRIVATE JOB