
B.M: 150.73 "R" in Ritchie W.L. Eastmoor & N. curb of Zimmerly
B.M: 148.89 SW cor Porch Ho. NE cor. Zimmerly & Paige.
Stationing on East Property Line.

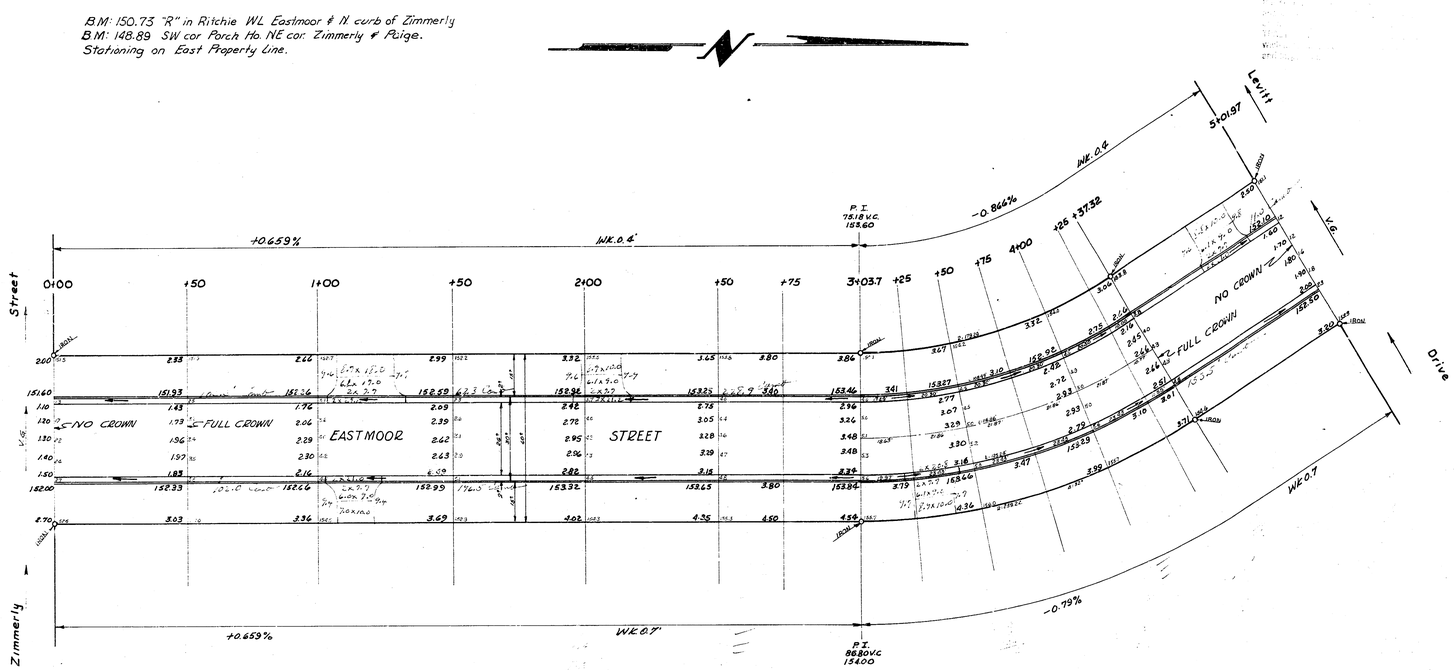

ESTIMATE OF QUANTITIES

No driveways figured or deductions made for same.

Quantity	Unit	Item	Final Quantity
1402.2	Sq. yds	Asph. Conc. Pav't.	
970.4	Lin. Ft.	Comb. Cb & Gutter	
1499.0	Cu. yds	Excavation	
3506.0	lbs	Reinf. Steel	

CURVE DATA:- Sta. 3+03.7 to Sta. 4+37.32

R:= 239.24 Δ= 32° Sta. on East Prop. Line.

STATION	Deflection Angle	Total Deflection	Chord Length 8" offset C.& G.	Chord Length 8" offset Wk.
3+03.7				
+25	2° 33' 02"	2° 33' 02"	20.47	14.57
+50	2° 59' 27"	5° 32' 29"	24.86	19.45
+75	2° 59' 27"	8° 32' 16"	24.86	19.45
4+00	2° 59' 27"	11° 31' 53"	24.86	19.45
+25	2° 59' 27"	14° 31' 30"	24.86	19.45
4+37.32	1° 28' 30"	16° 00' 00"	11.96	9.59

EASTMOOR STREET

N/L Zimmerly to S/L Levitt

26-2-30 AC.

CITY OF WICHITA, KANSAS

B. E. SMITH CITY ENGINEER

PRIVATE JOB.