

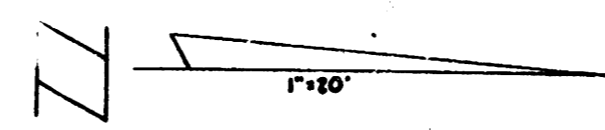


B.M. 91605 Sta. Meridian @ 31st St. So. (Used for Drive)

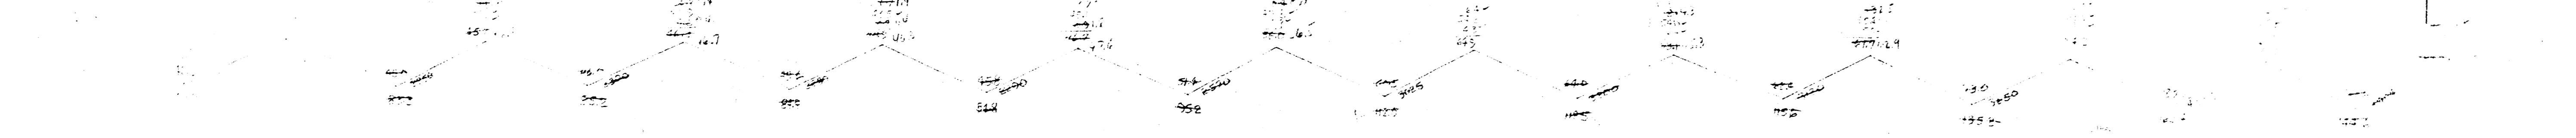

NOTE: TO FIELD ENG.
CONSTRUCT DITCHES &
DIRT & SAND HOOK UP
TO 31st ST. SOUTH

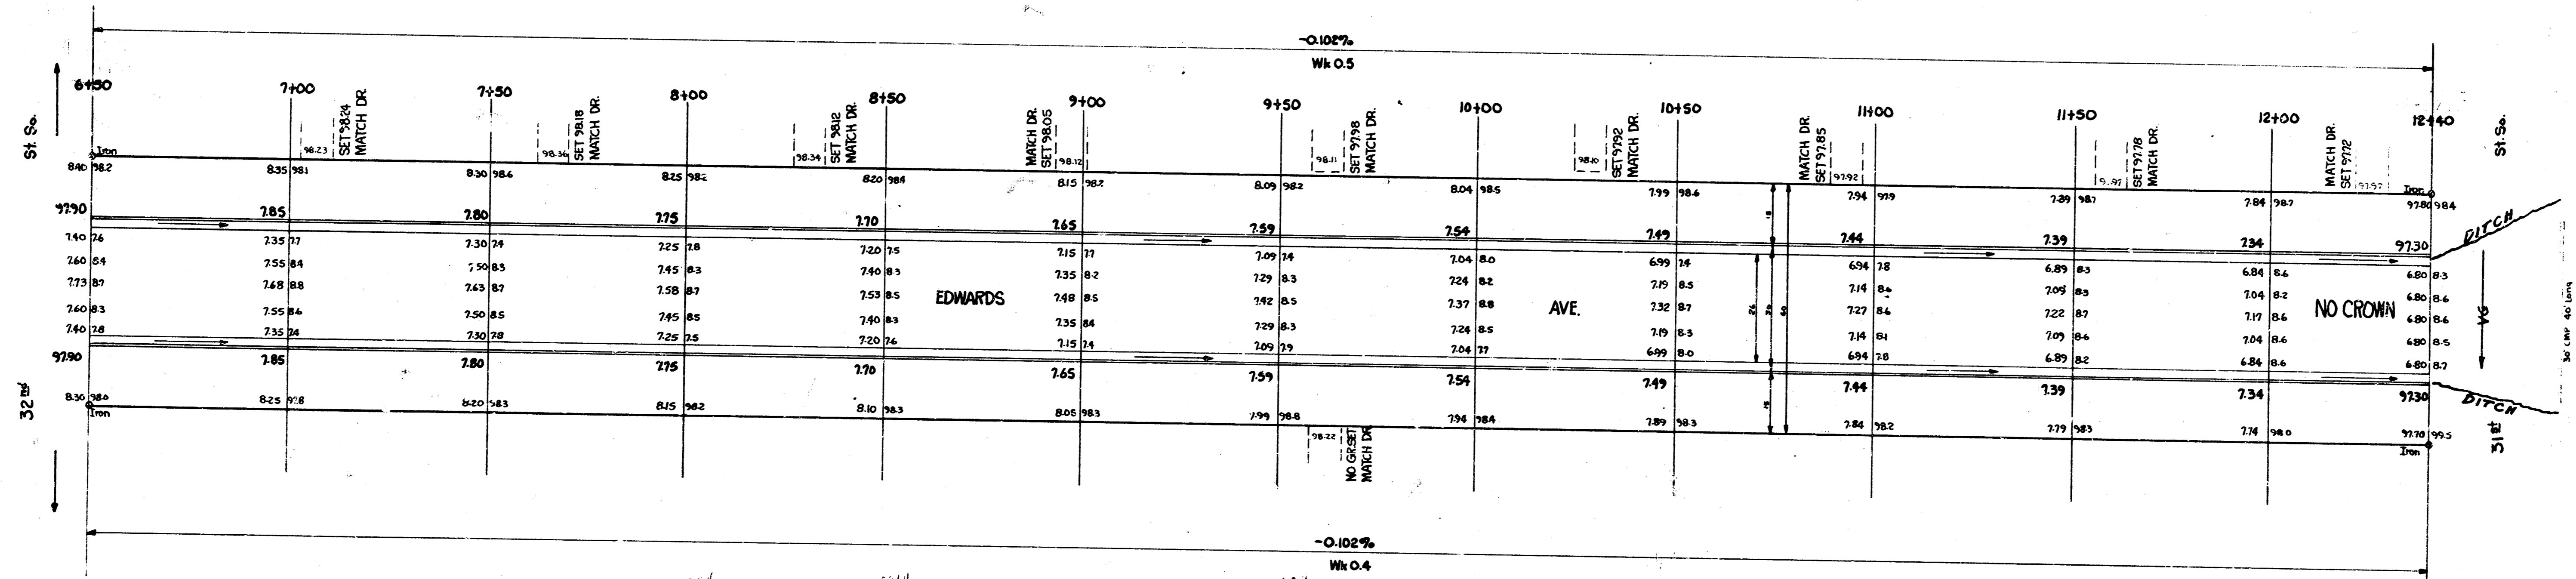

(6)

EDWARDS AVE
PROJ. NO. C15-89