
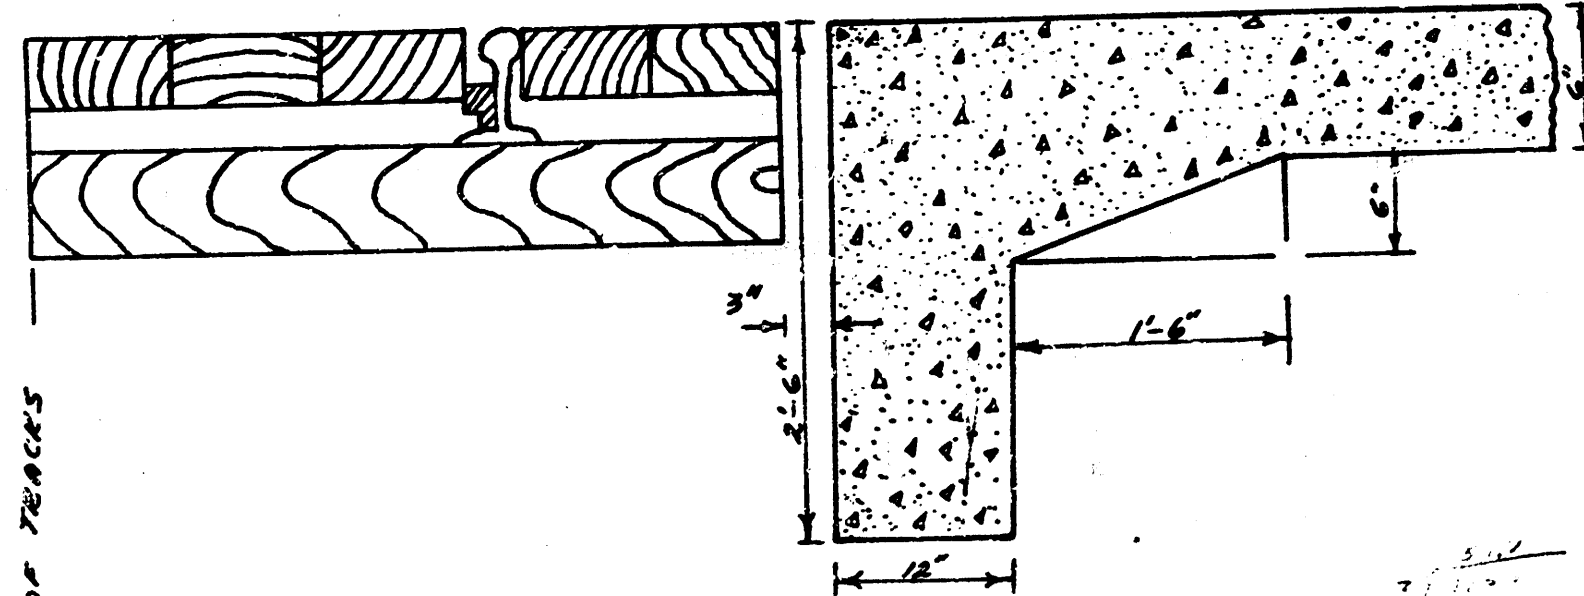


BM 11720 "G" IN GLOBE END NW RND. EDWARDS & ST. LOUIS
 B.M. 11789 "G" IN GLOBE END SE RND. GORDON & ST. LOUIS
 B.M. 11760 "G" IN GLOBE END SE RND. NEWELL & EDWARDS

STA ON E

- 01002 CURB VINE FENCE SCALE
- 01155 18" ELM 17' 8" W
- 01335 WATER METER 19" D.E.
- 01462 18" ELM 17' 8" W
- 01470 END OF DRIVE 24' 1" E
- 01475 E 8' CONC. DR. 24' 1" E
- 01489 10" ELM 18' 0" W
- 01496 WATER METER 18" D.E.
- 01497 8" ELM 18' 0" W
- 01498 8" ELM 18' 0" W
NOTE: CROSS SECTIONS FROM STA 2+00 TO 3+50 TO BE TAKEN IN FIELD WHEN JOB IS STAKED

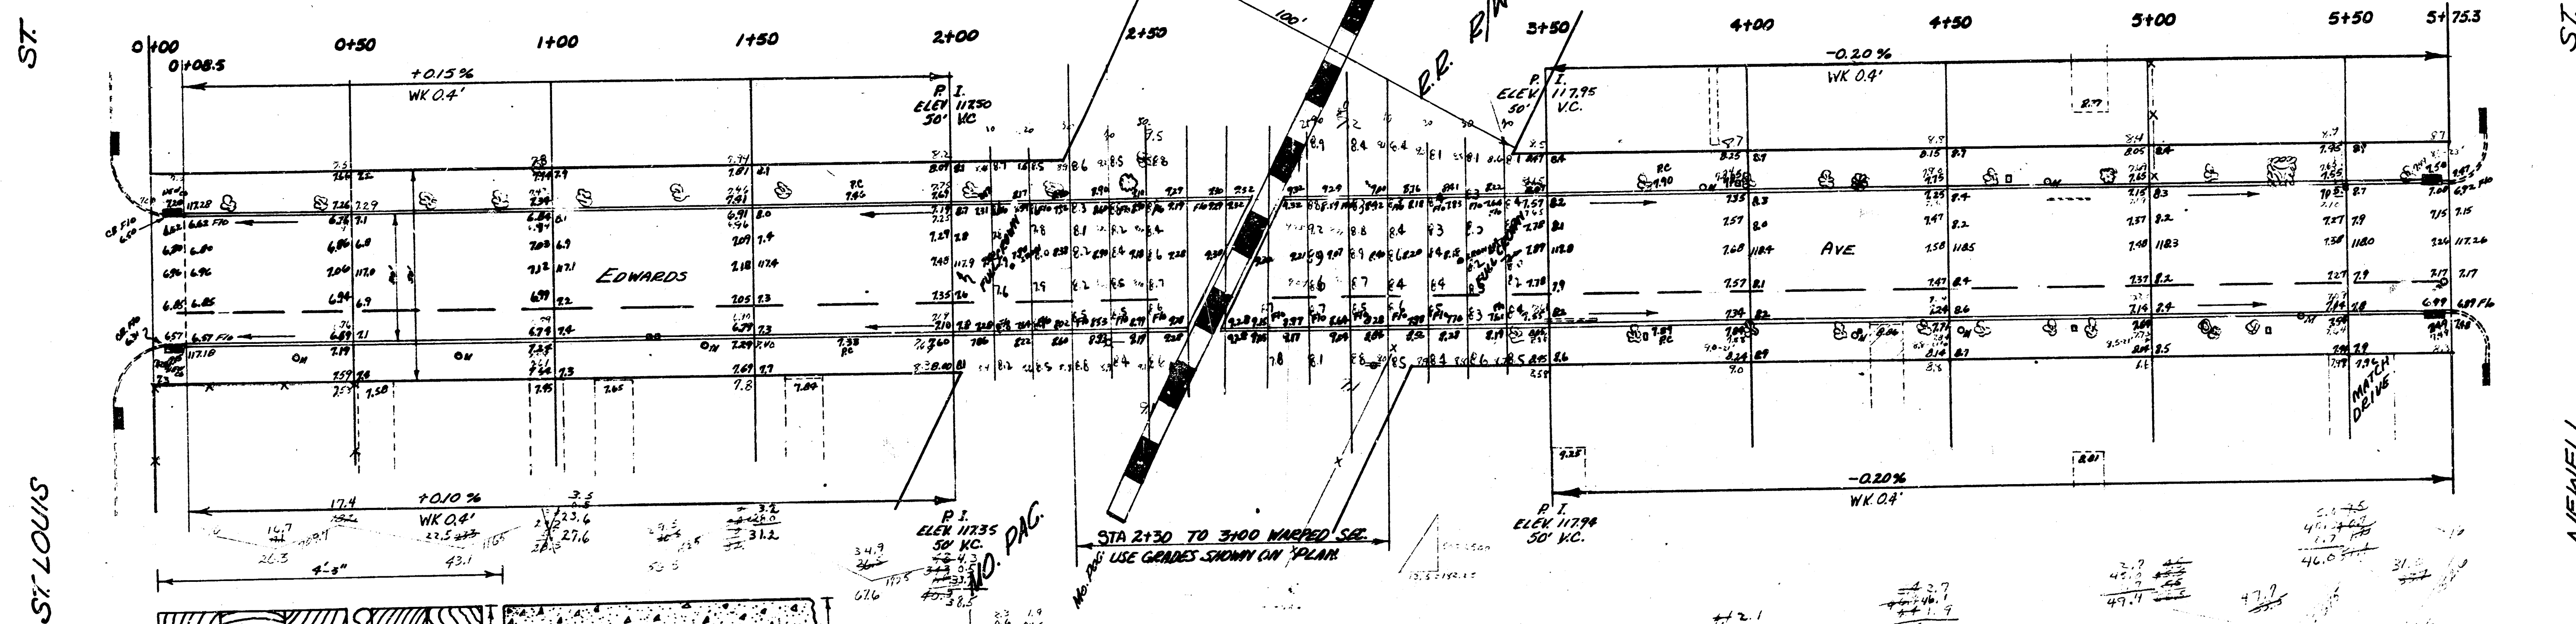

DETAIL OF CONCRETE HEADER
 NO SCALE

TIES TO IRONS
 STA 2+163 4' 75" N.E. TO CORNER OF S. CON.
 STA 3+20.8 1125' N.W. TO MID. 5' IRON IN 11" ELM
 1172' S.W. TO CORNER OF N. CON.
 25.91' N.W. TO MID. 5' IRON IN 11" ELM

NOTE TO FIELD ENGINEER:
 SAVE ALL TREES POSSIBLE.
 COUNT & TURN IN CARD ON
 TREES REMOVED.

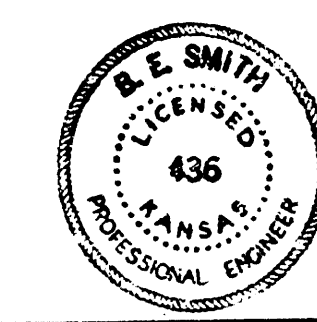

EDWARDS AVE
 N.E. ST. LOUIS ST. TO S.E. NEWELL ST.
 30' CONC. & C&G

CITY OF WICHITA, KAN.

B.E. SMITH
 DEC 1952

CITY ENGINEER
 PROJ. NO. C-12-88