



B.M. 130.16 City Std Top N. Hubgd. E. End Flood Control Bridge
 B.M. 118.53 S.W. Cor. Conc. Porch Ho. No. 5224 W. Maple

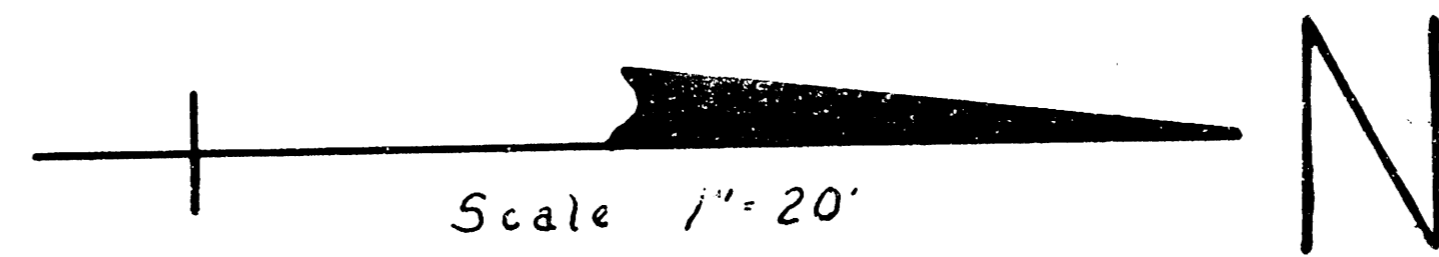

NOTE:
 Change in Steel Pattern
 See Sketch Sheet 2

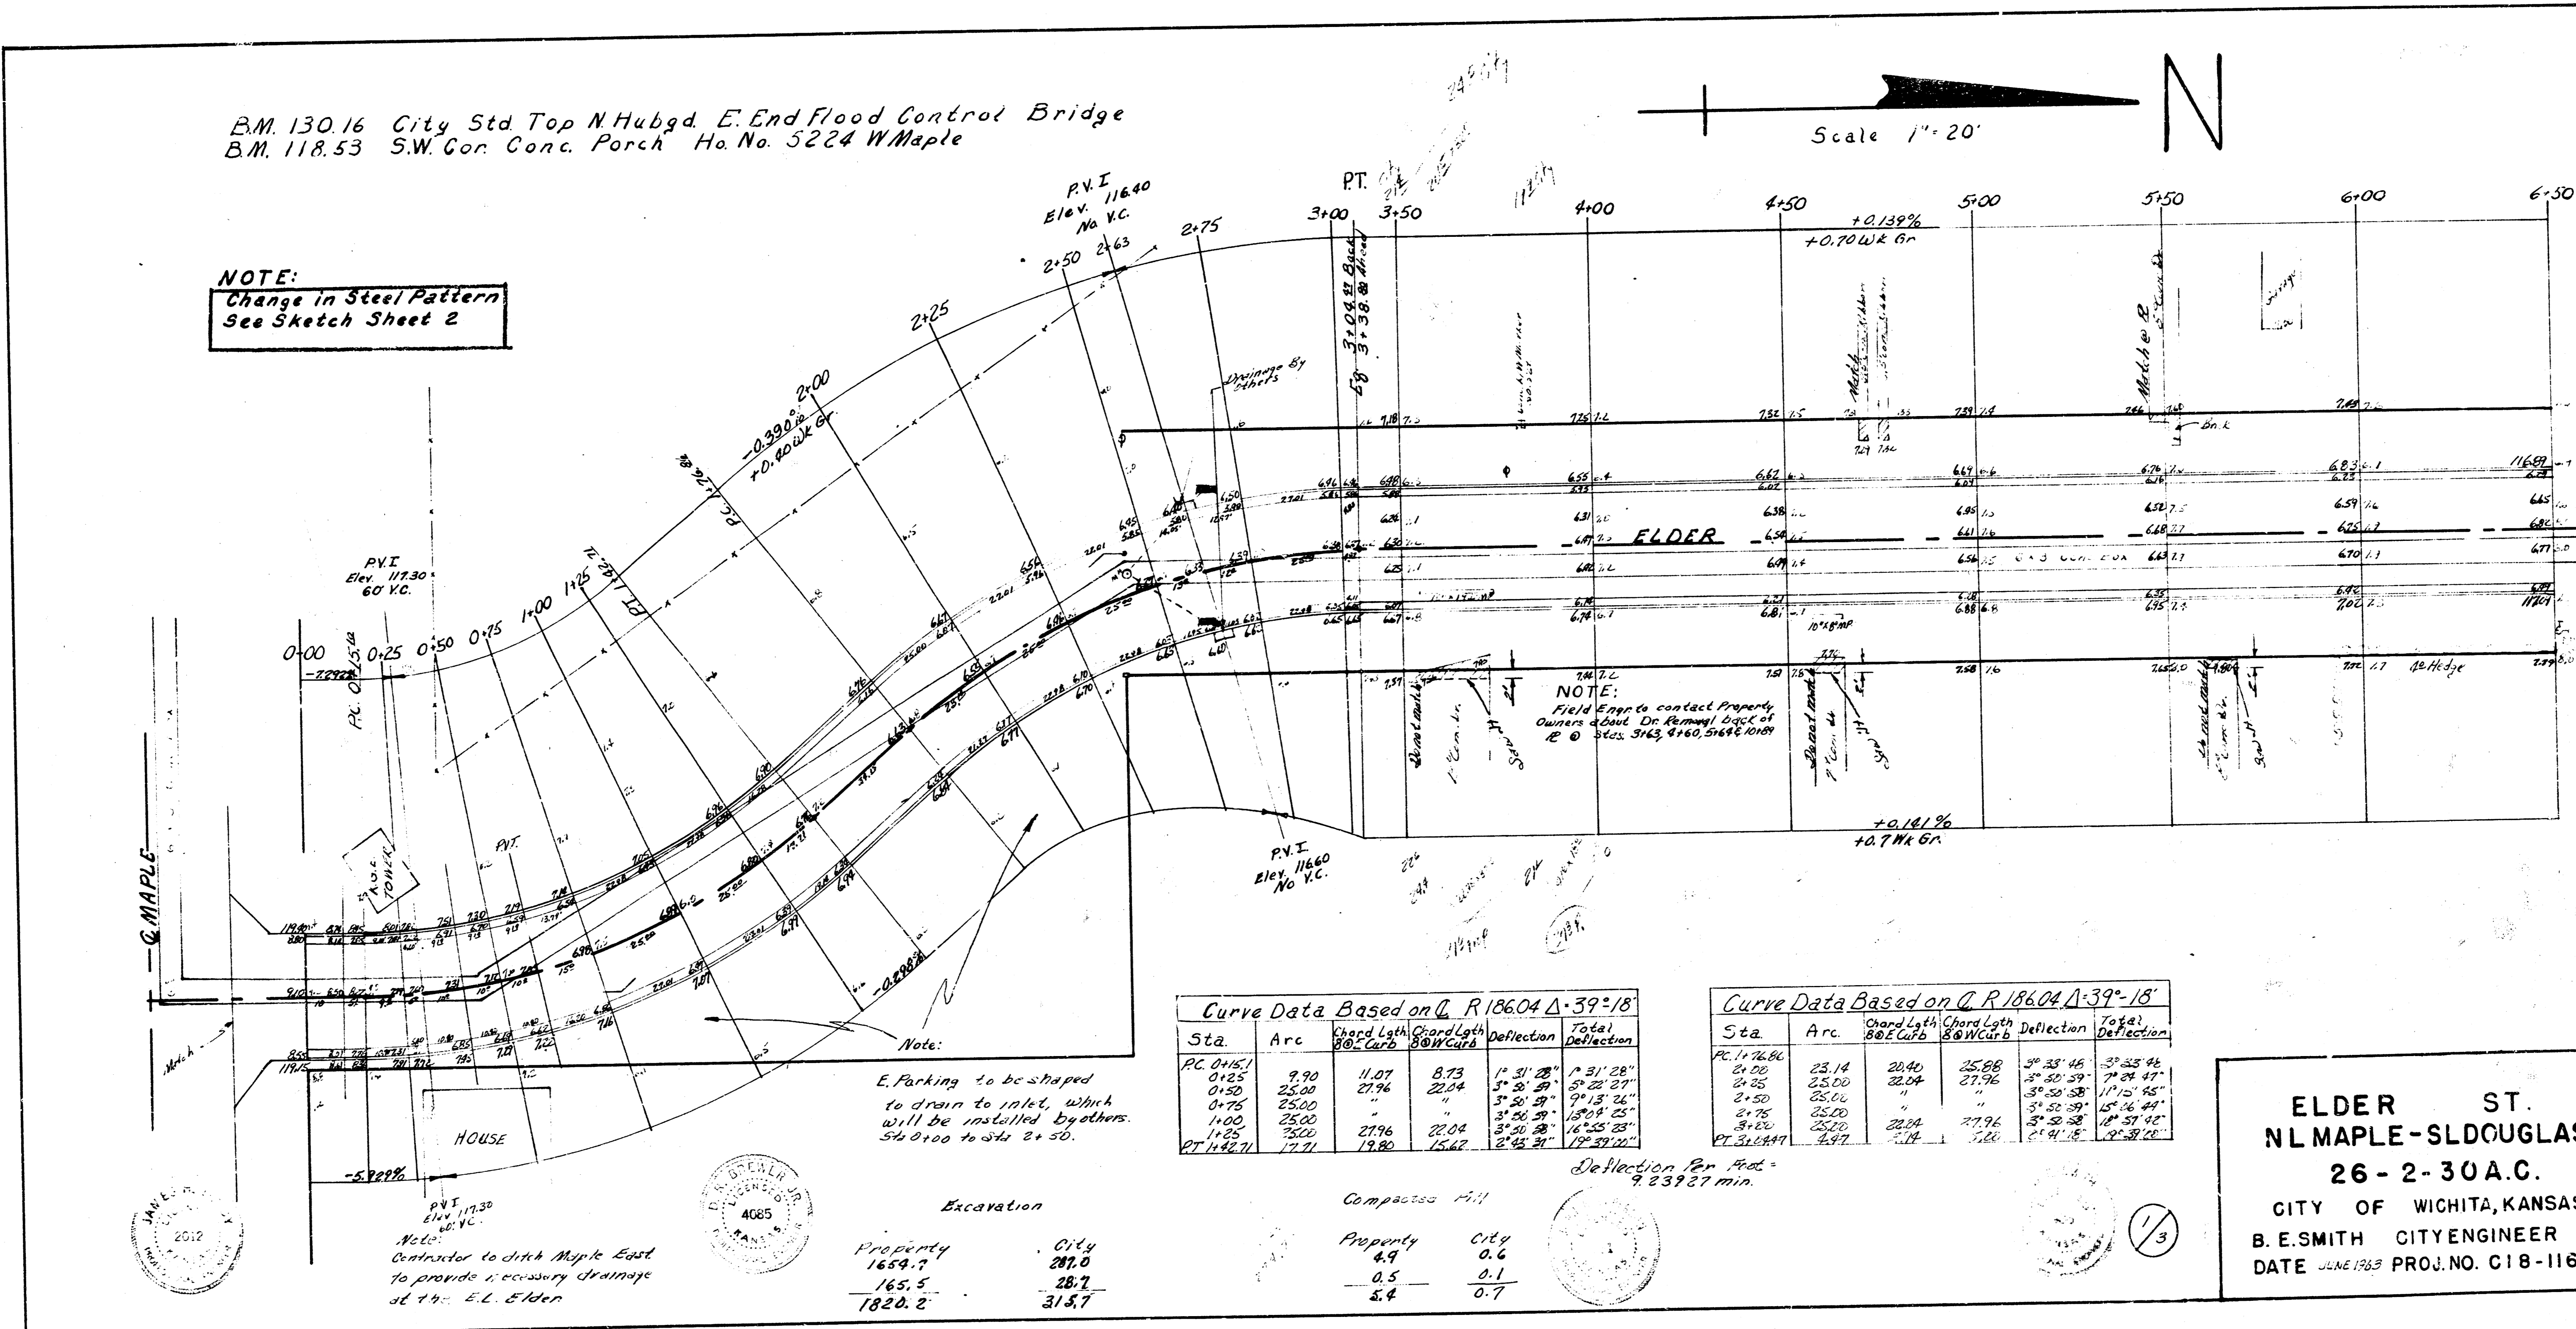

Curve Data Based on $\Delta R 186.04 \Delta 39^{\circ} 18'$

Sta	Arc	Chord Lth	Chord Lth	Deflection	Total Deflection
		80' Curve	80' Curve		
PC 0+15.1	9.90	11.07	8.73	1° 31' 28"	1° 31' 28"

Curve Data Based on $\Delta R 186.04 \Delta 39^{\circ} 18'$

Sta	Arc	Chord Lth	Chord Lth	Deflection	Total Deflection
		80' Curve	80' Curve		

Note:
 E. Parking to be shaped
 to drain to inlet, which
 will be installed by others.
 Sta 0+00 to Sta 2+50.

Excavation

Property	City
1654.7	287.0
1820.2	28.7
	315.7

Compacted Fill

Property	City
4.9	0.6
0.5	0.1
5.4	0.7

ELDER ST.
N. L. MAPLE - SLDUGLAS
26-2-30 A.C.
 CITY OF WICHITA, KANSAS
 B. E. SMITH CITY ENGINEER

