B.M.: 102. SW cor. conc. porch No. 1444 So. Lydia.

N

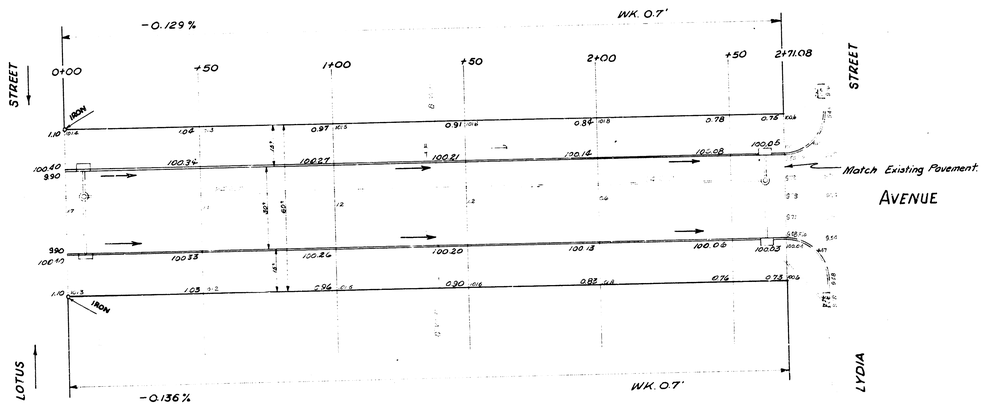

1/2

ELIZABETH AVENUE
NL Lotus to SL Lydia
30' Conc. & C.b.
CITY OF WICHITA, KANSAS
B. E. SMITH CITY ENGINEER
APRIL 1958 PROJ. NO. C17-5

SCALE 1"=20'

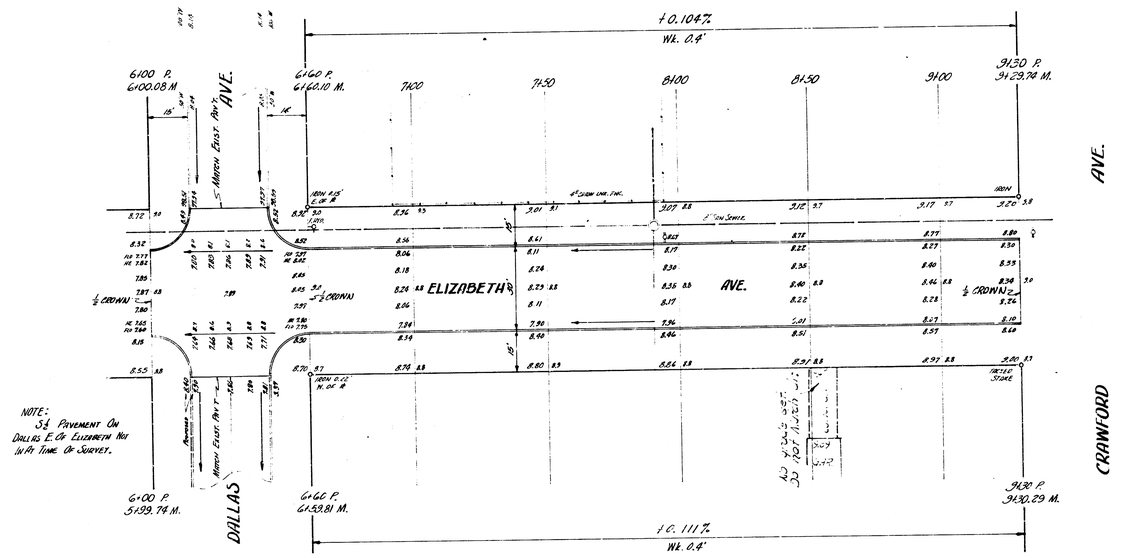

ELIZABETH AVE.
NE GREENFIELD - SE CRAWFORD
PROJ. NO. C16-129

(2/4)