


N

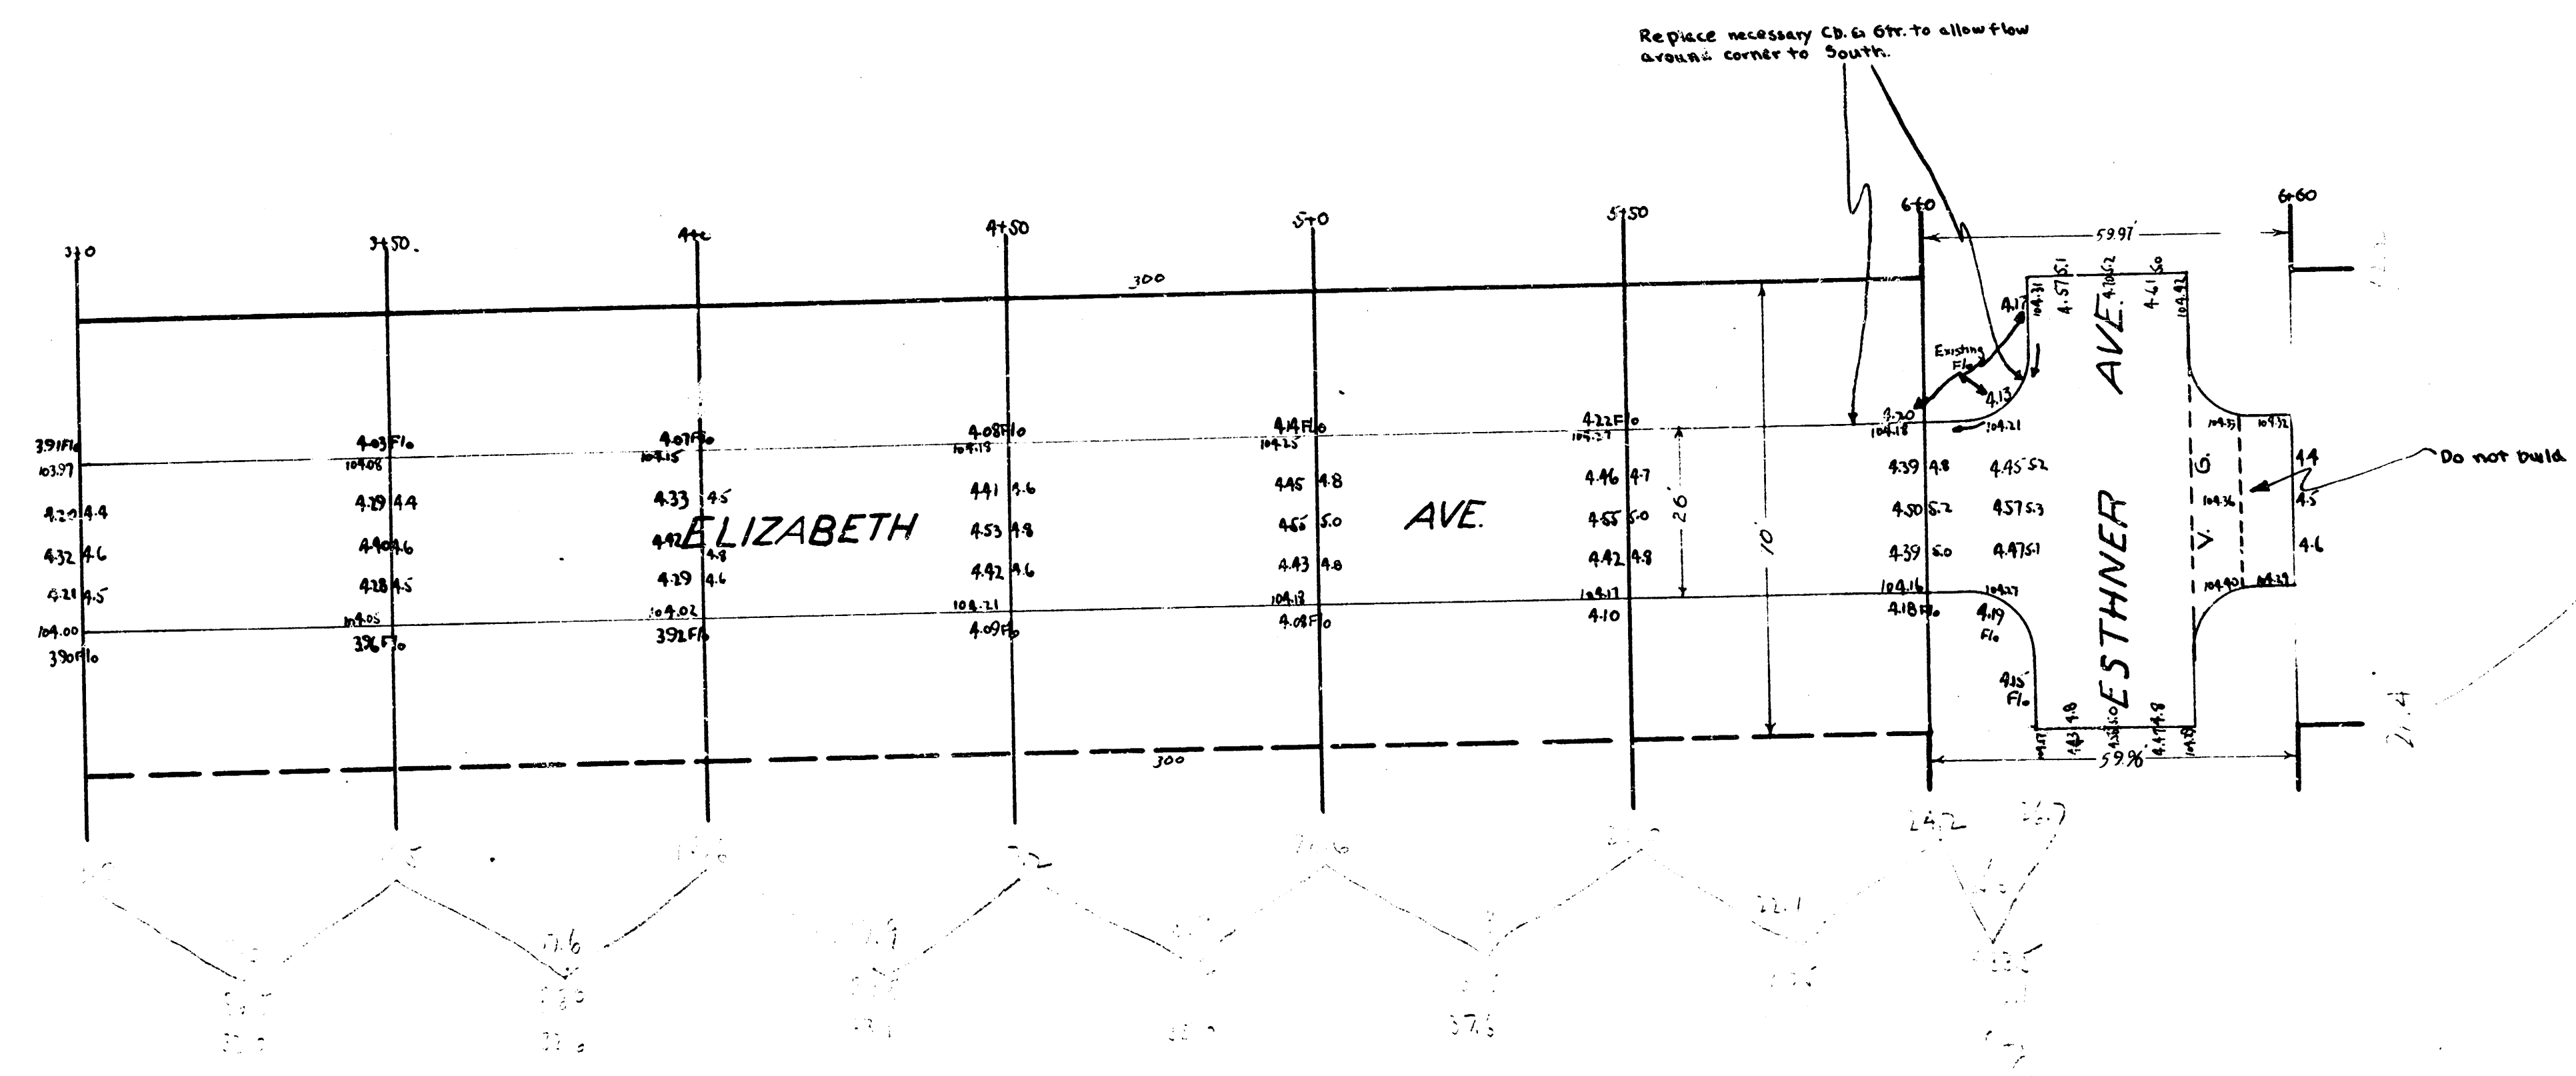






ELIZABETH AVE
N. L. ESTHNER TO S. L. DORR
26' CONCRETE
CITY OF WICHITA, KANSAS
L. K. WHITE CITY ENGINEER
JULY 1946

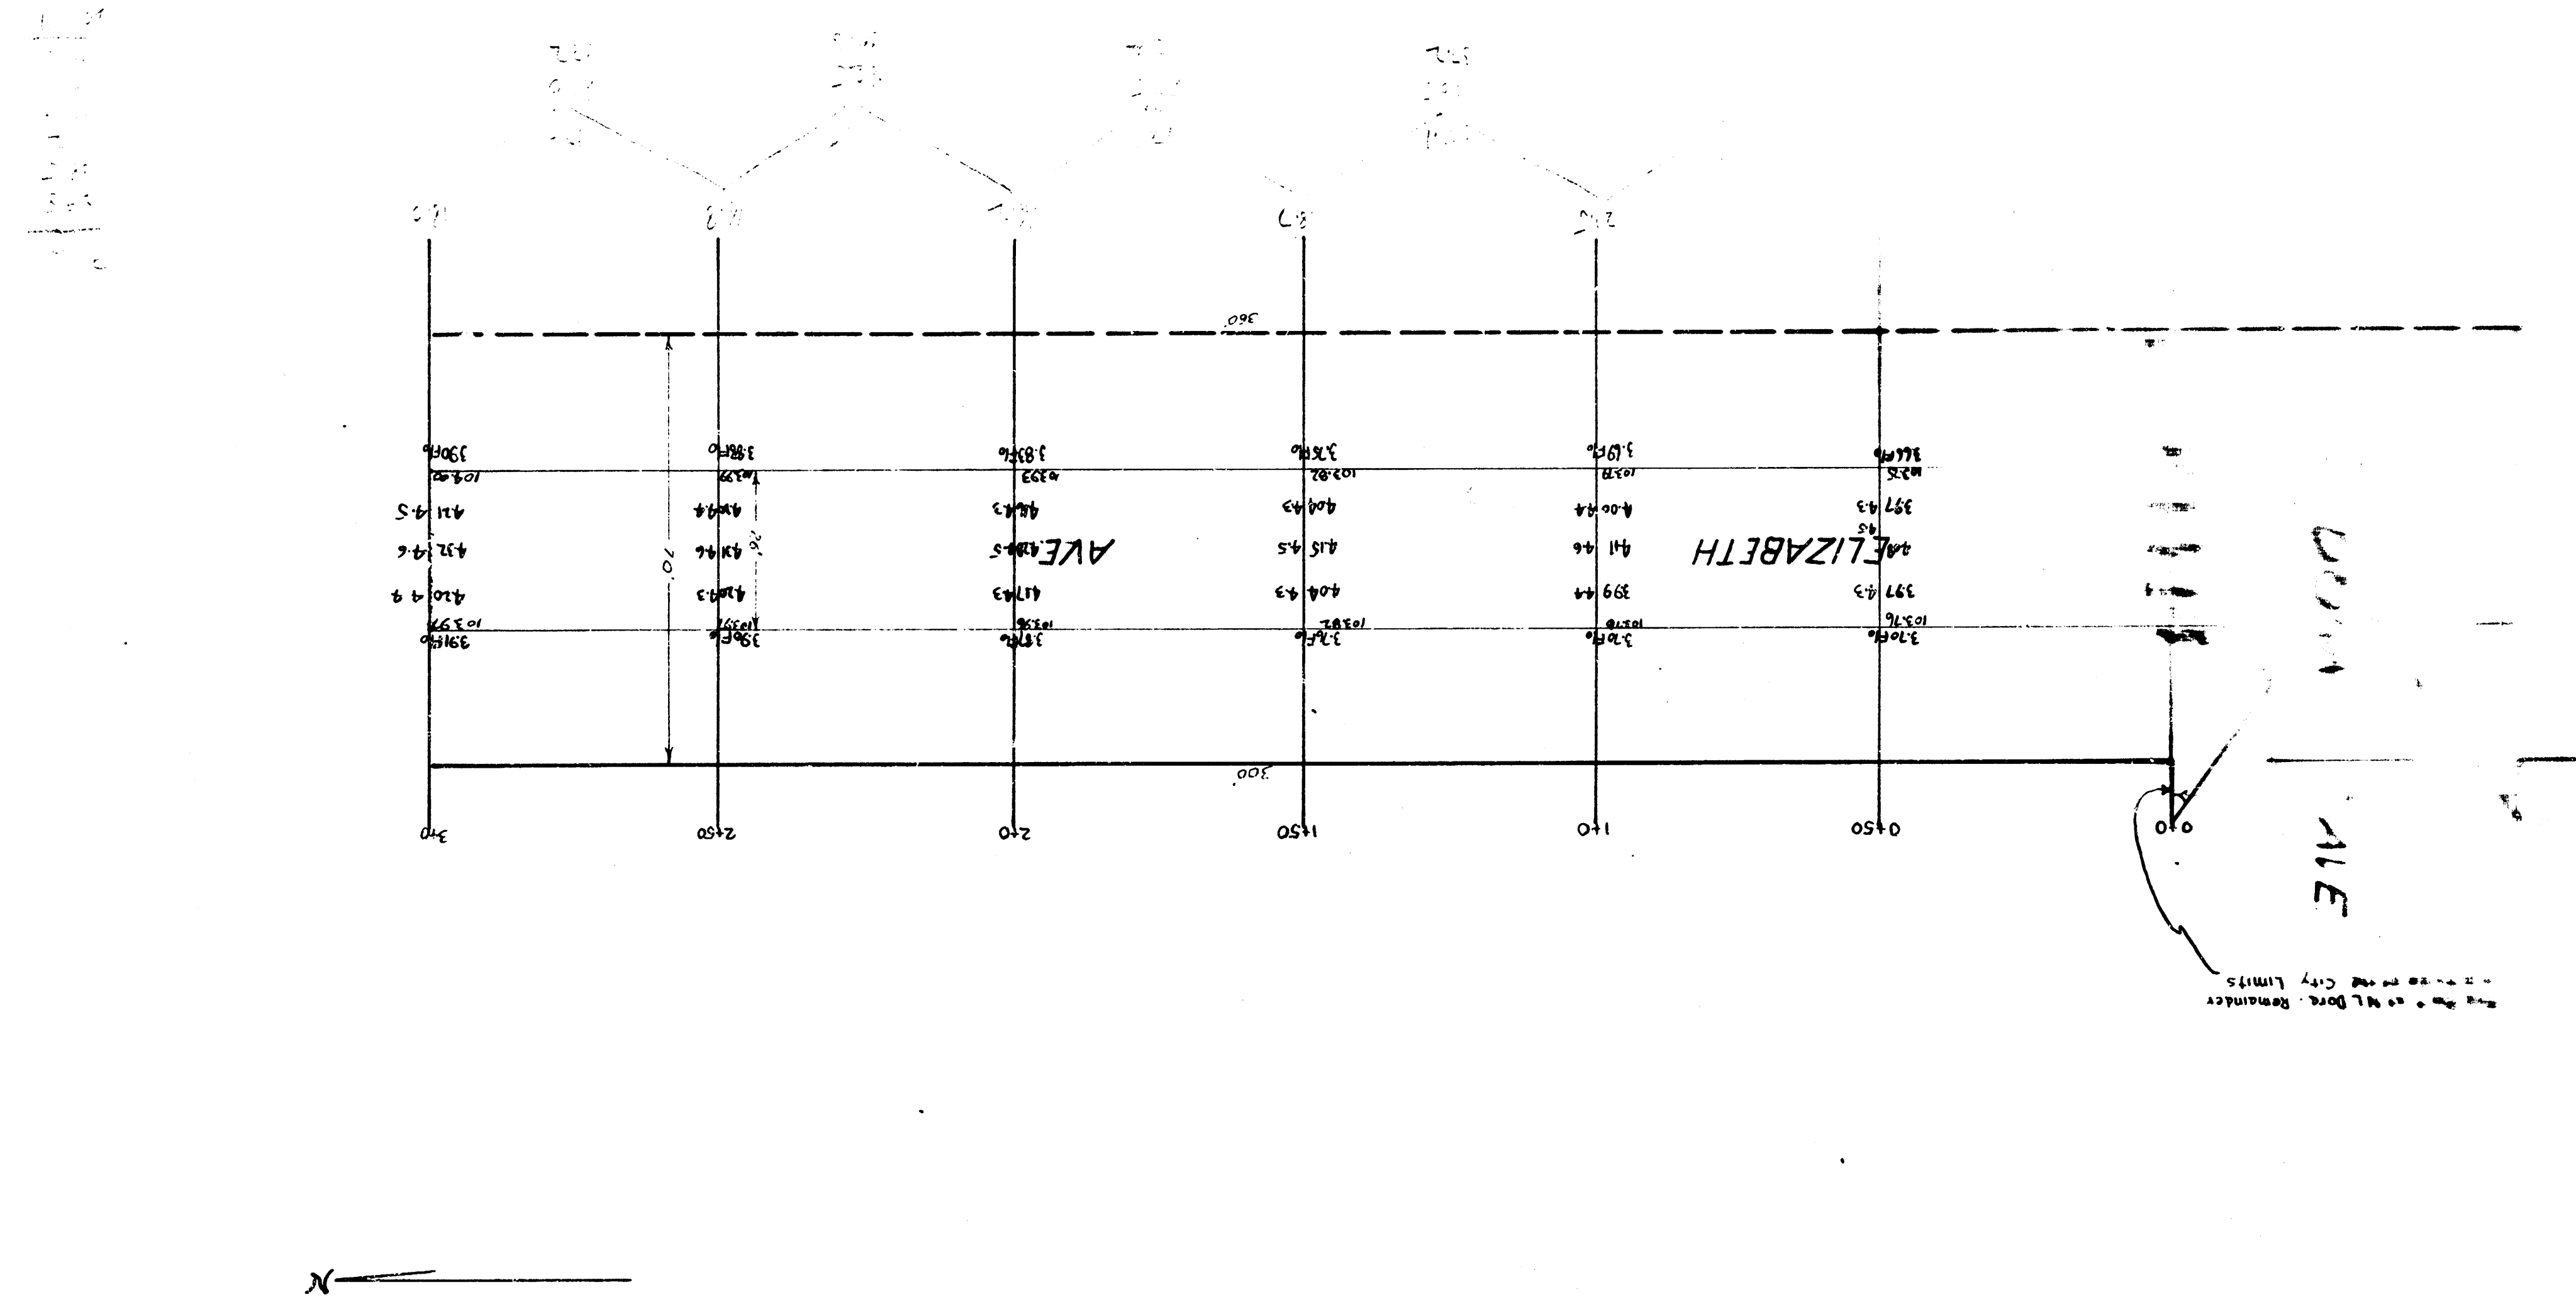

1941
 ELIZABETH - S. L. ESTHNER TO N. L. DORA.
 COMB. CURB & GUTTER

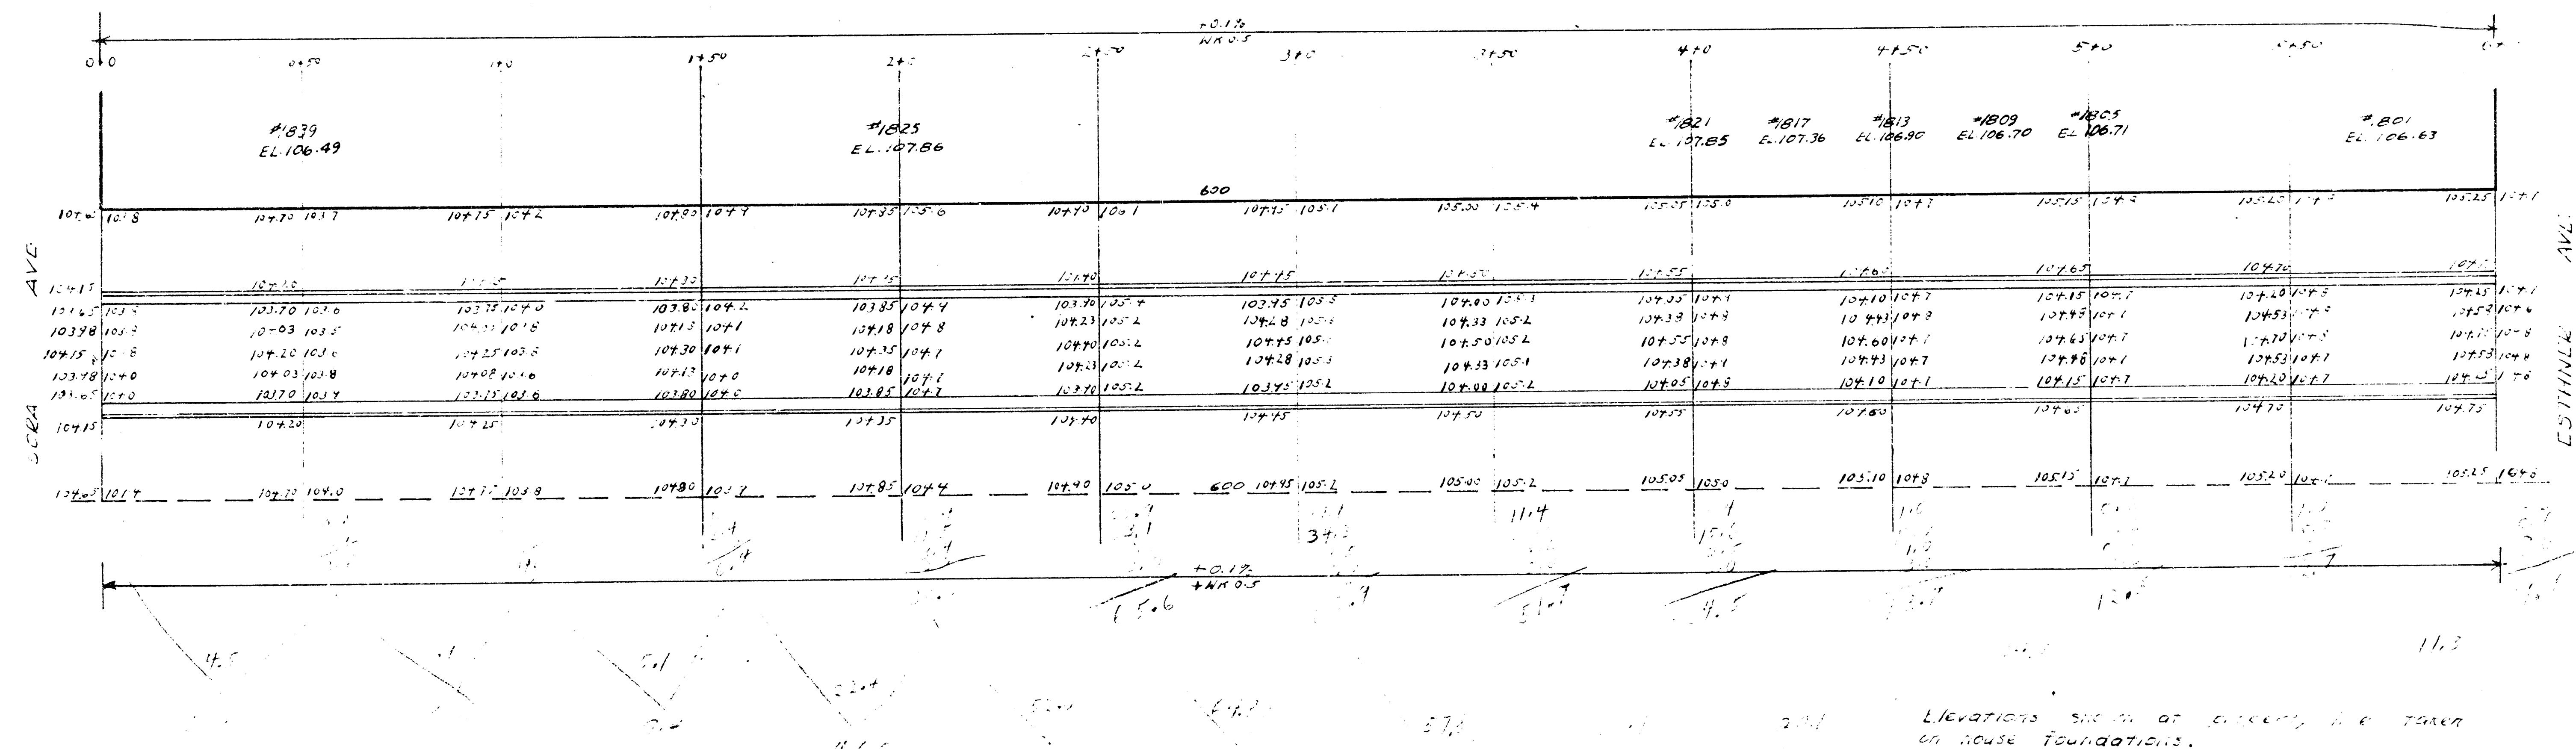

BM 10520 N. RIM 74 W. SIDE SCHOOL 100' SW OF SW COR. OF SCHOOL

ELEVATIONS SHOWN AT CORNERS ARE TAKEN ON HOUSE FOUNDATIONS.