




SW 1/4 SEC. 12 TWP. 27S R.1E

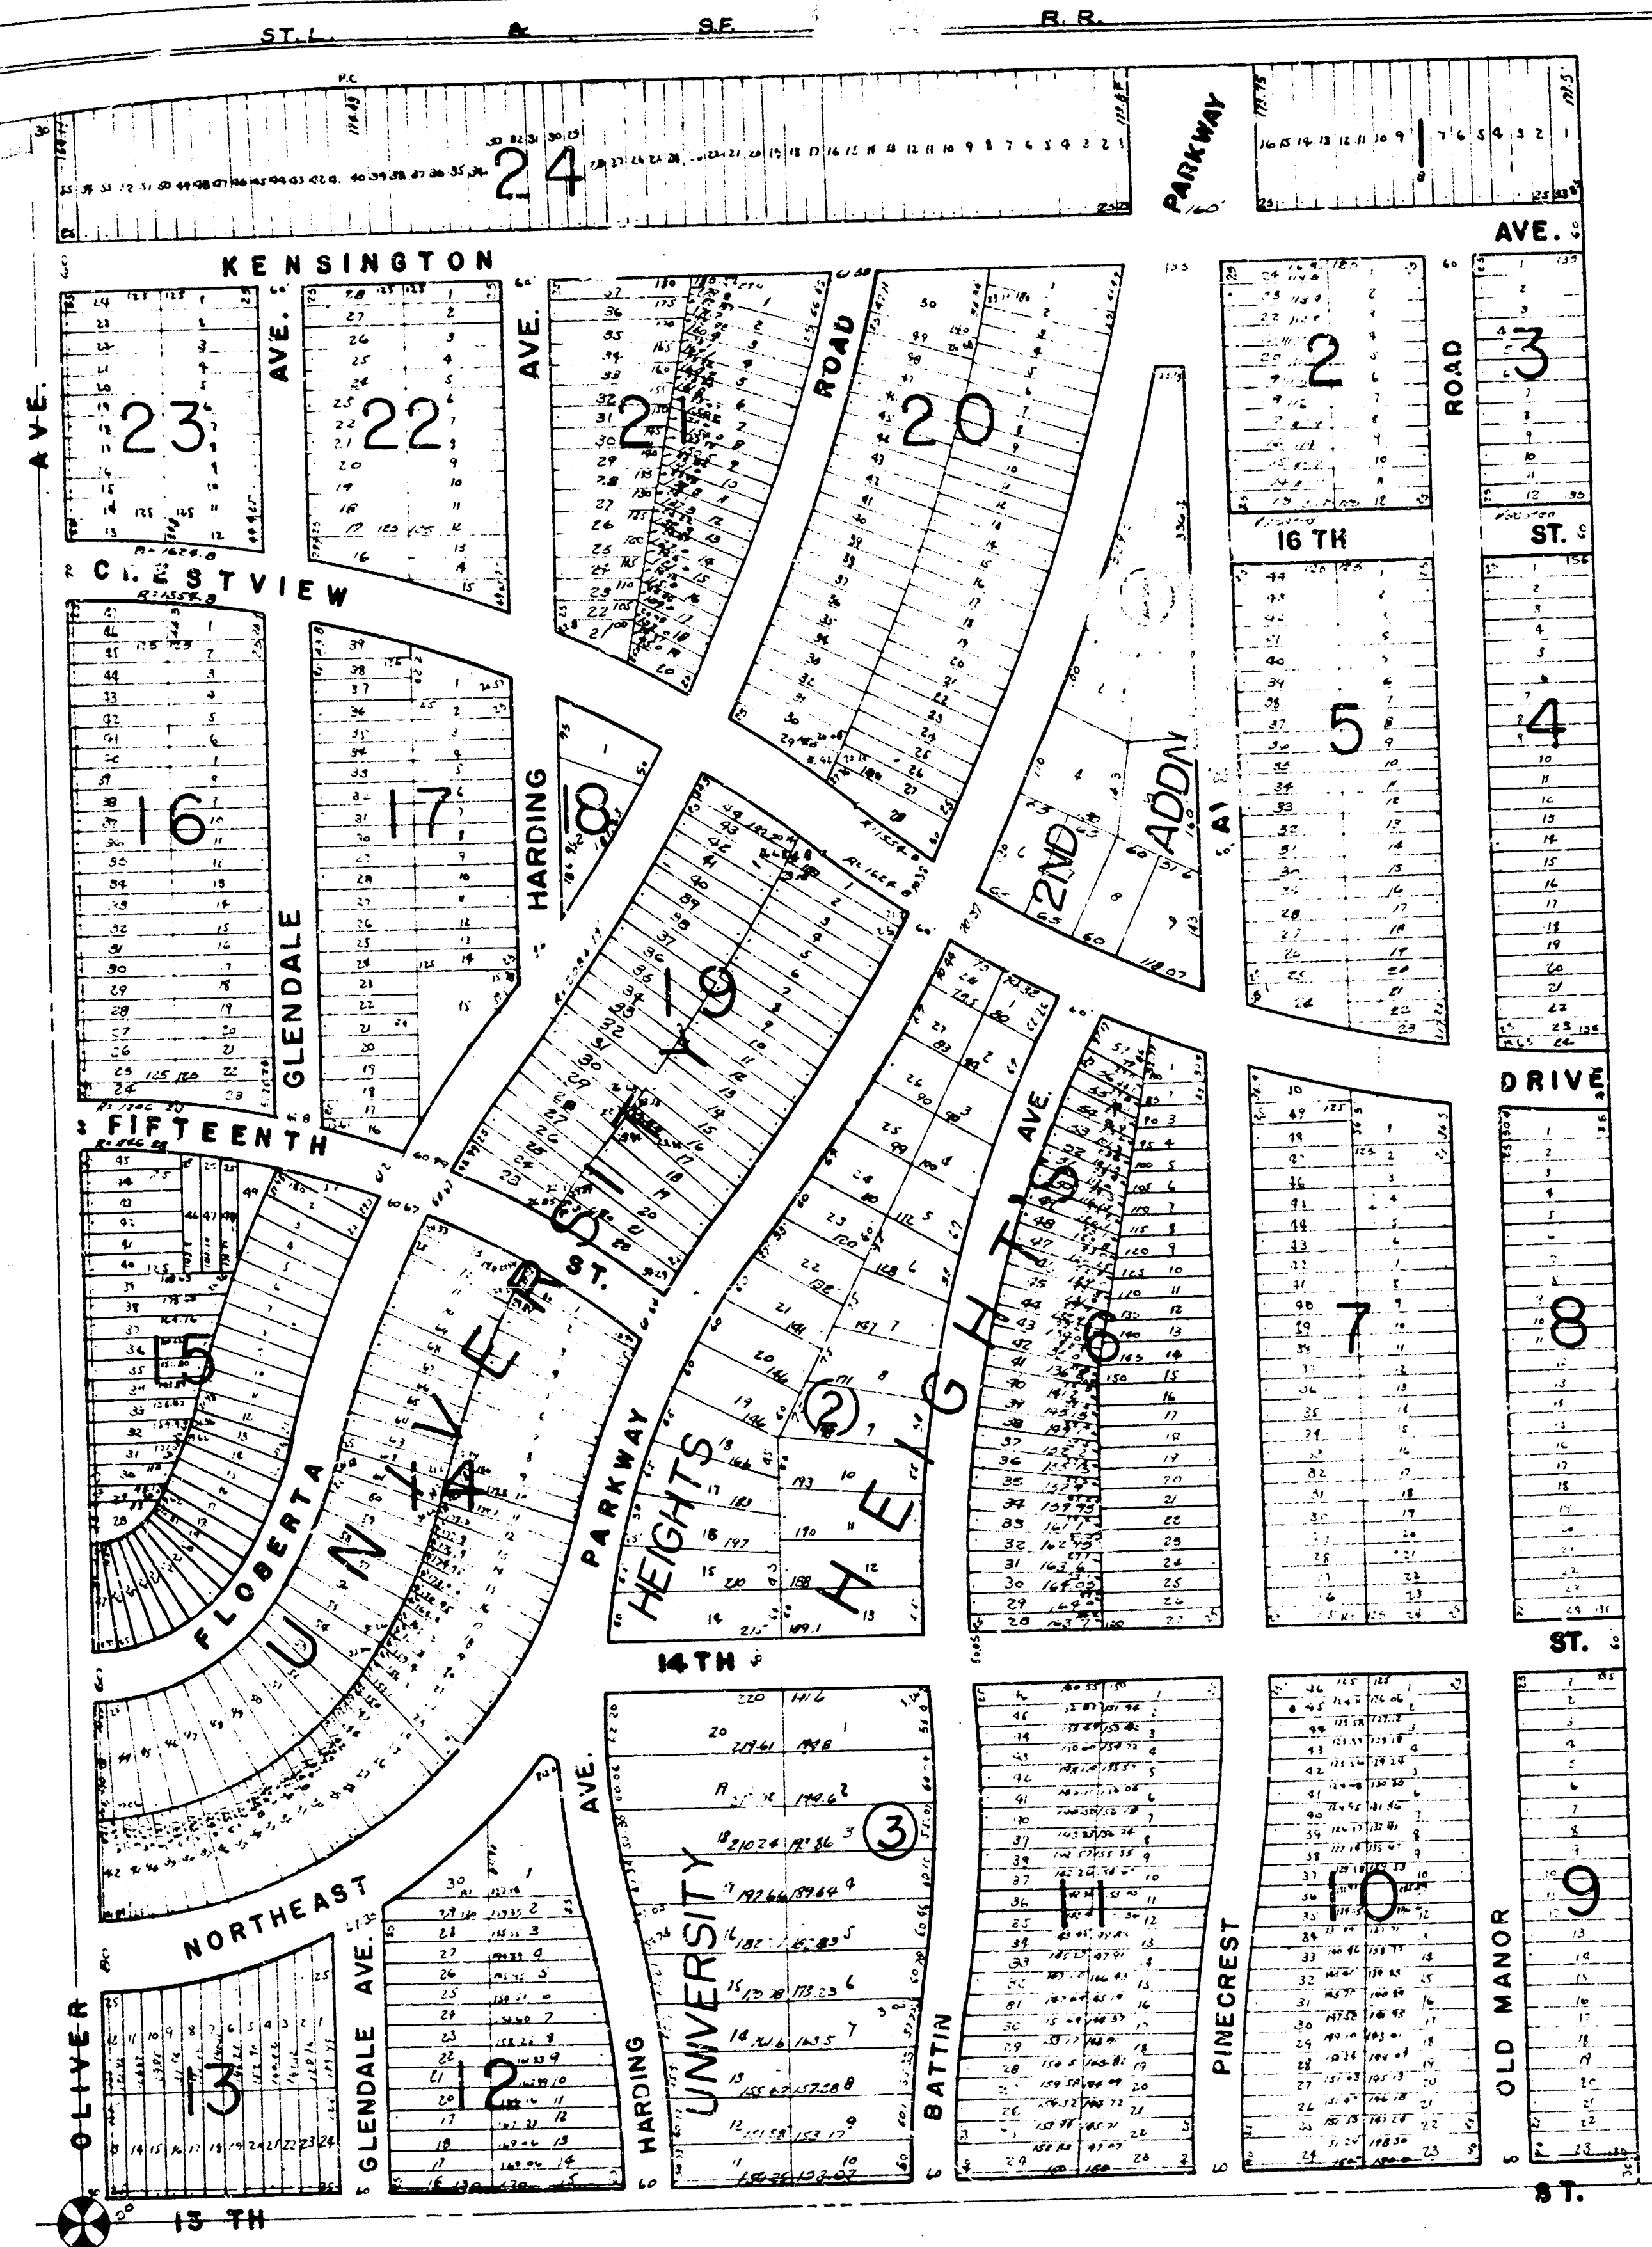


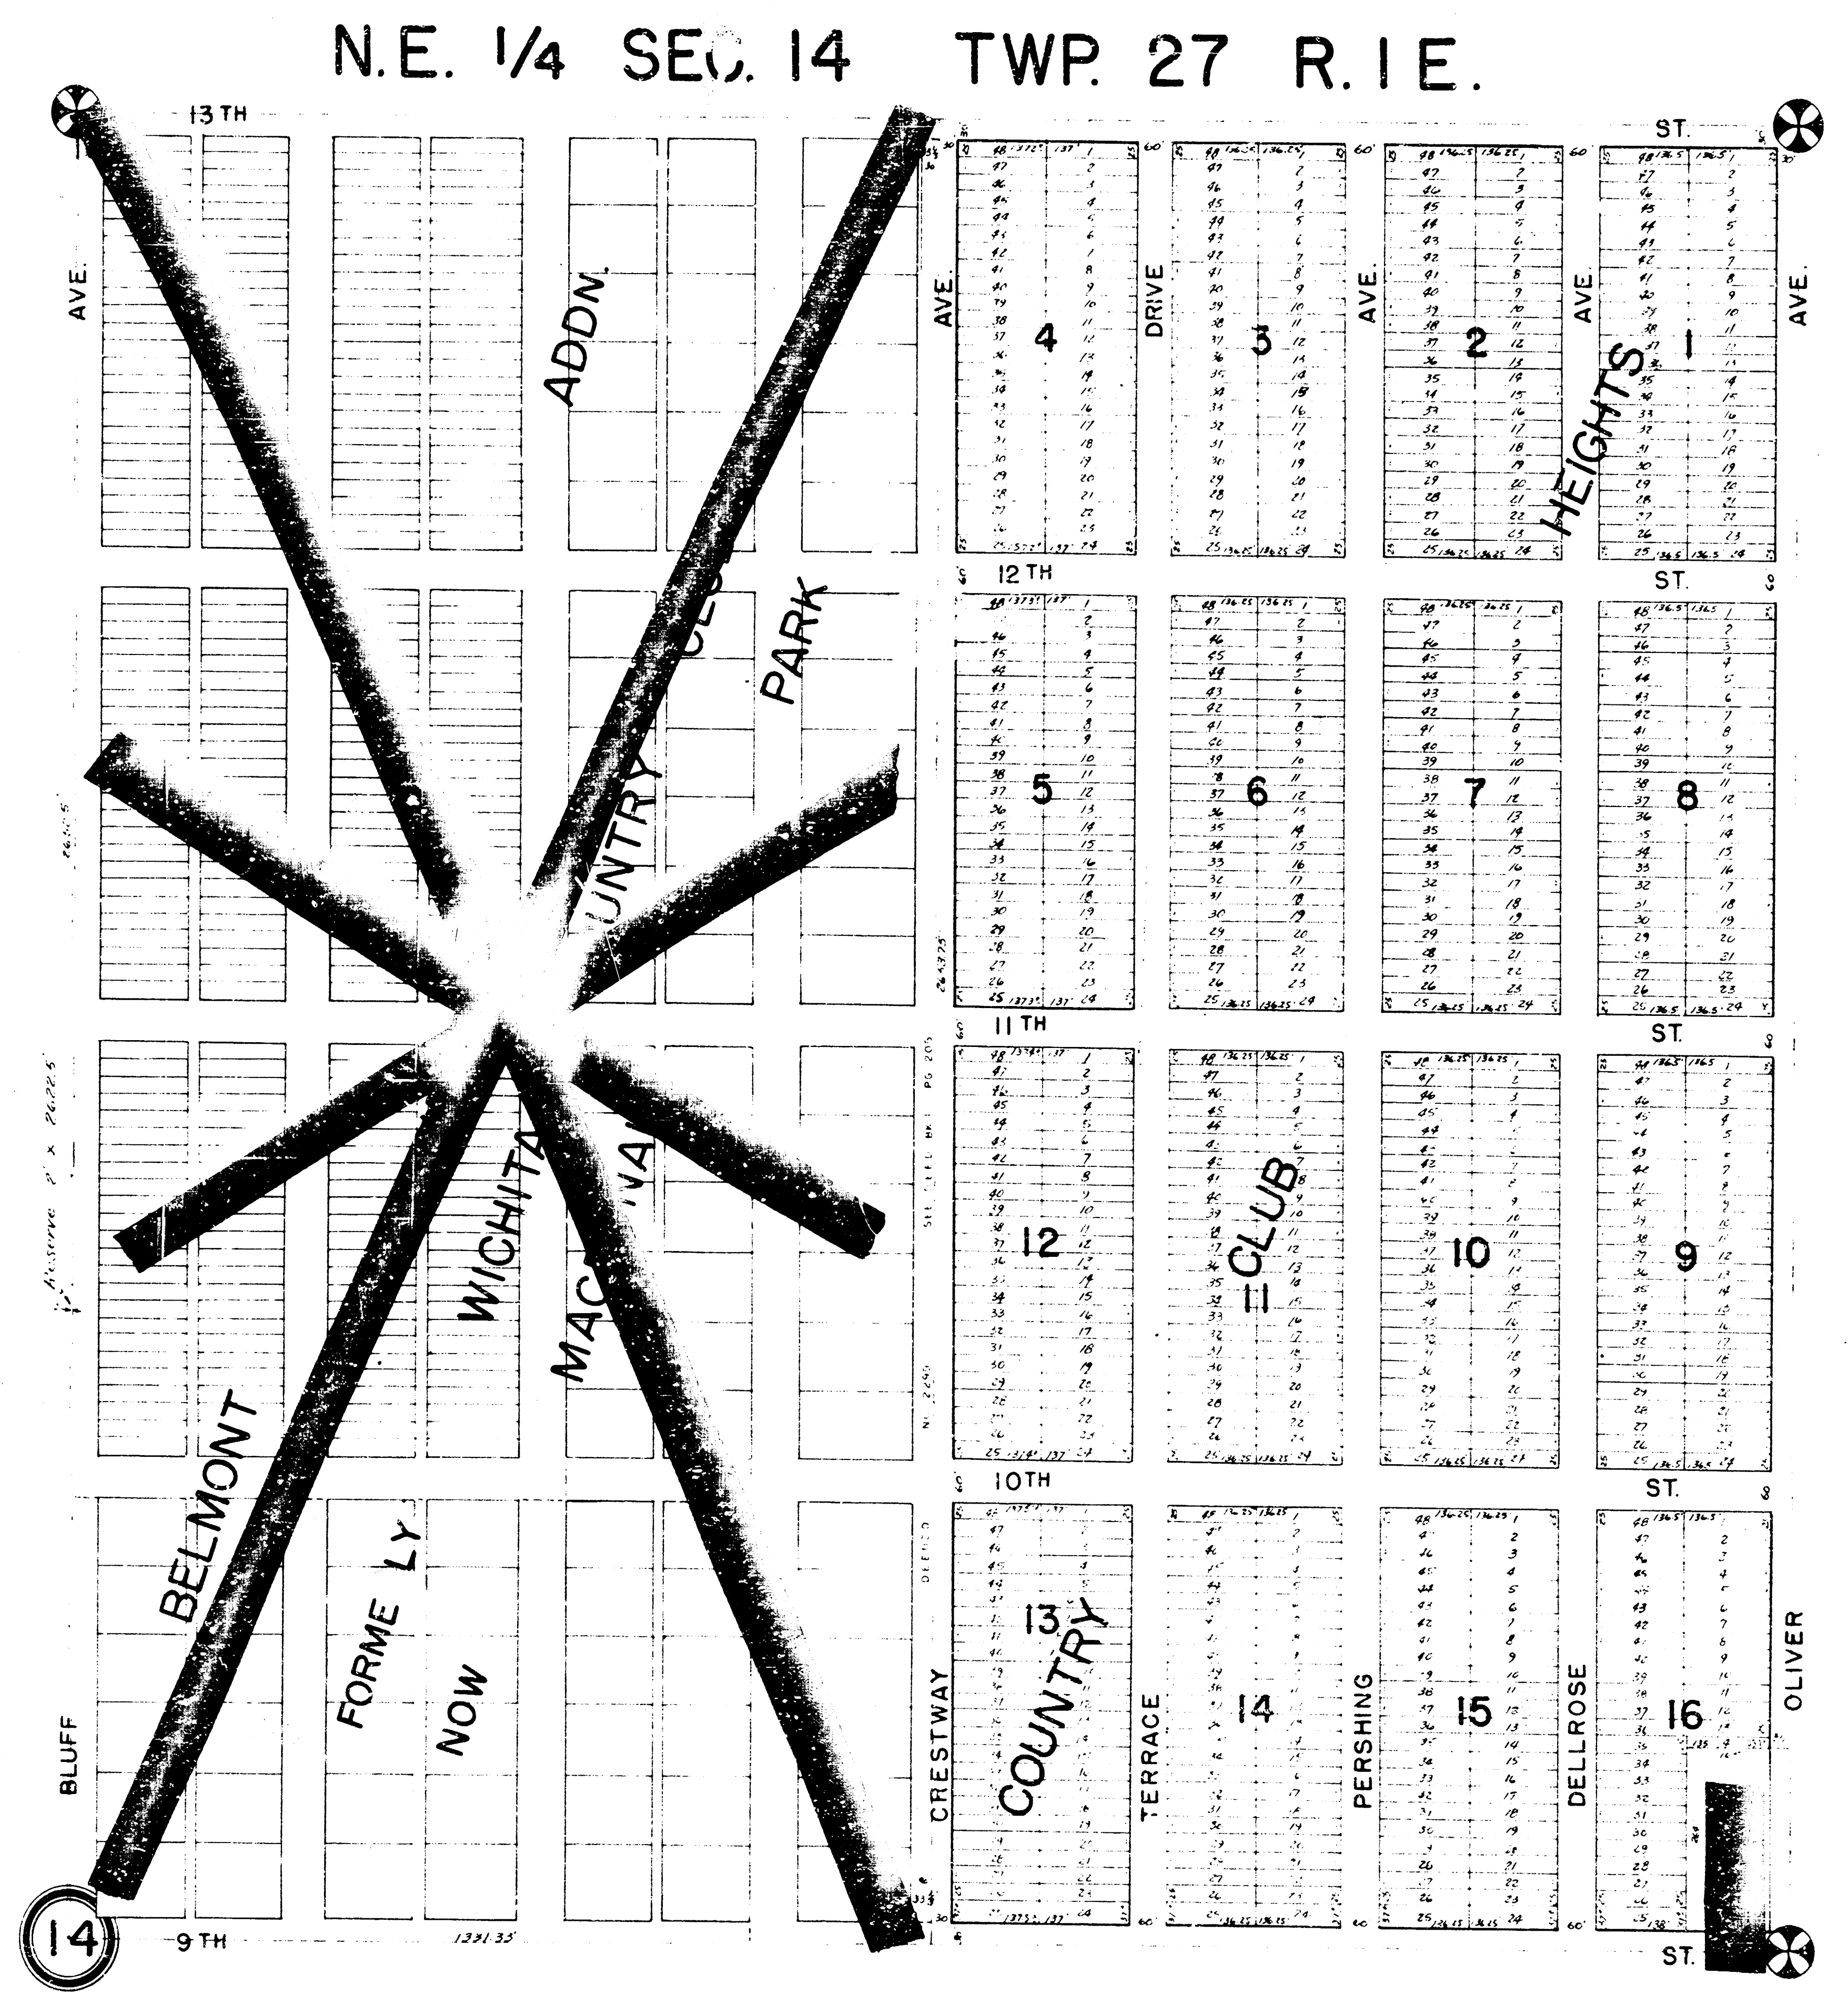

3

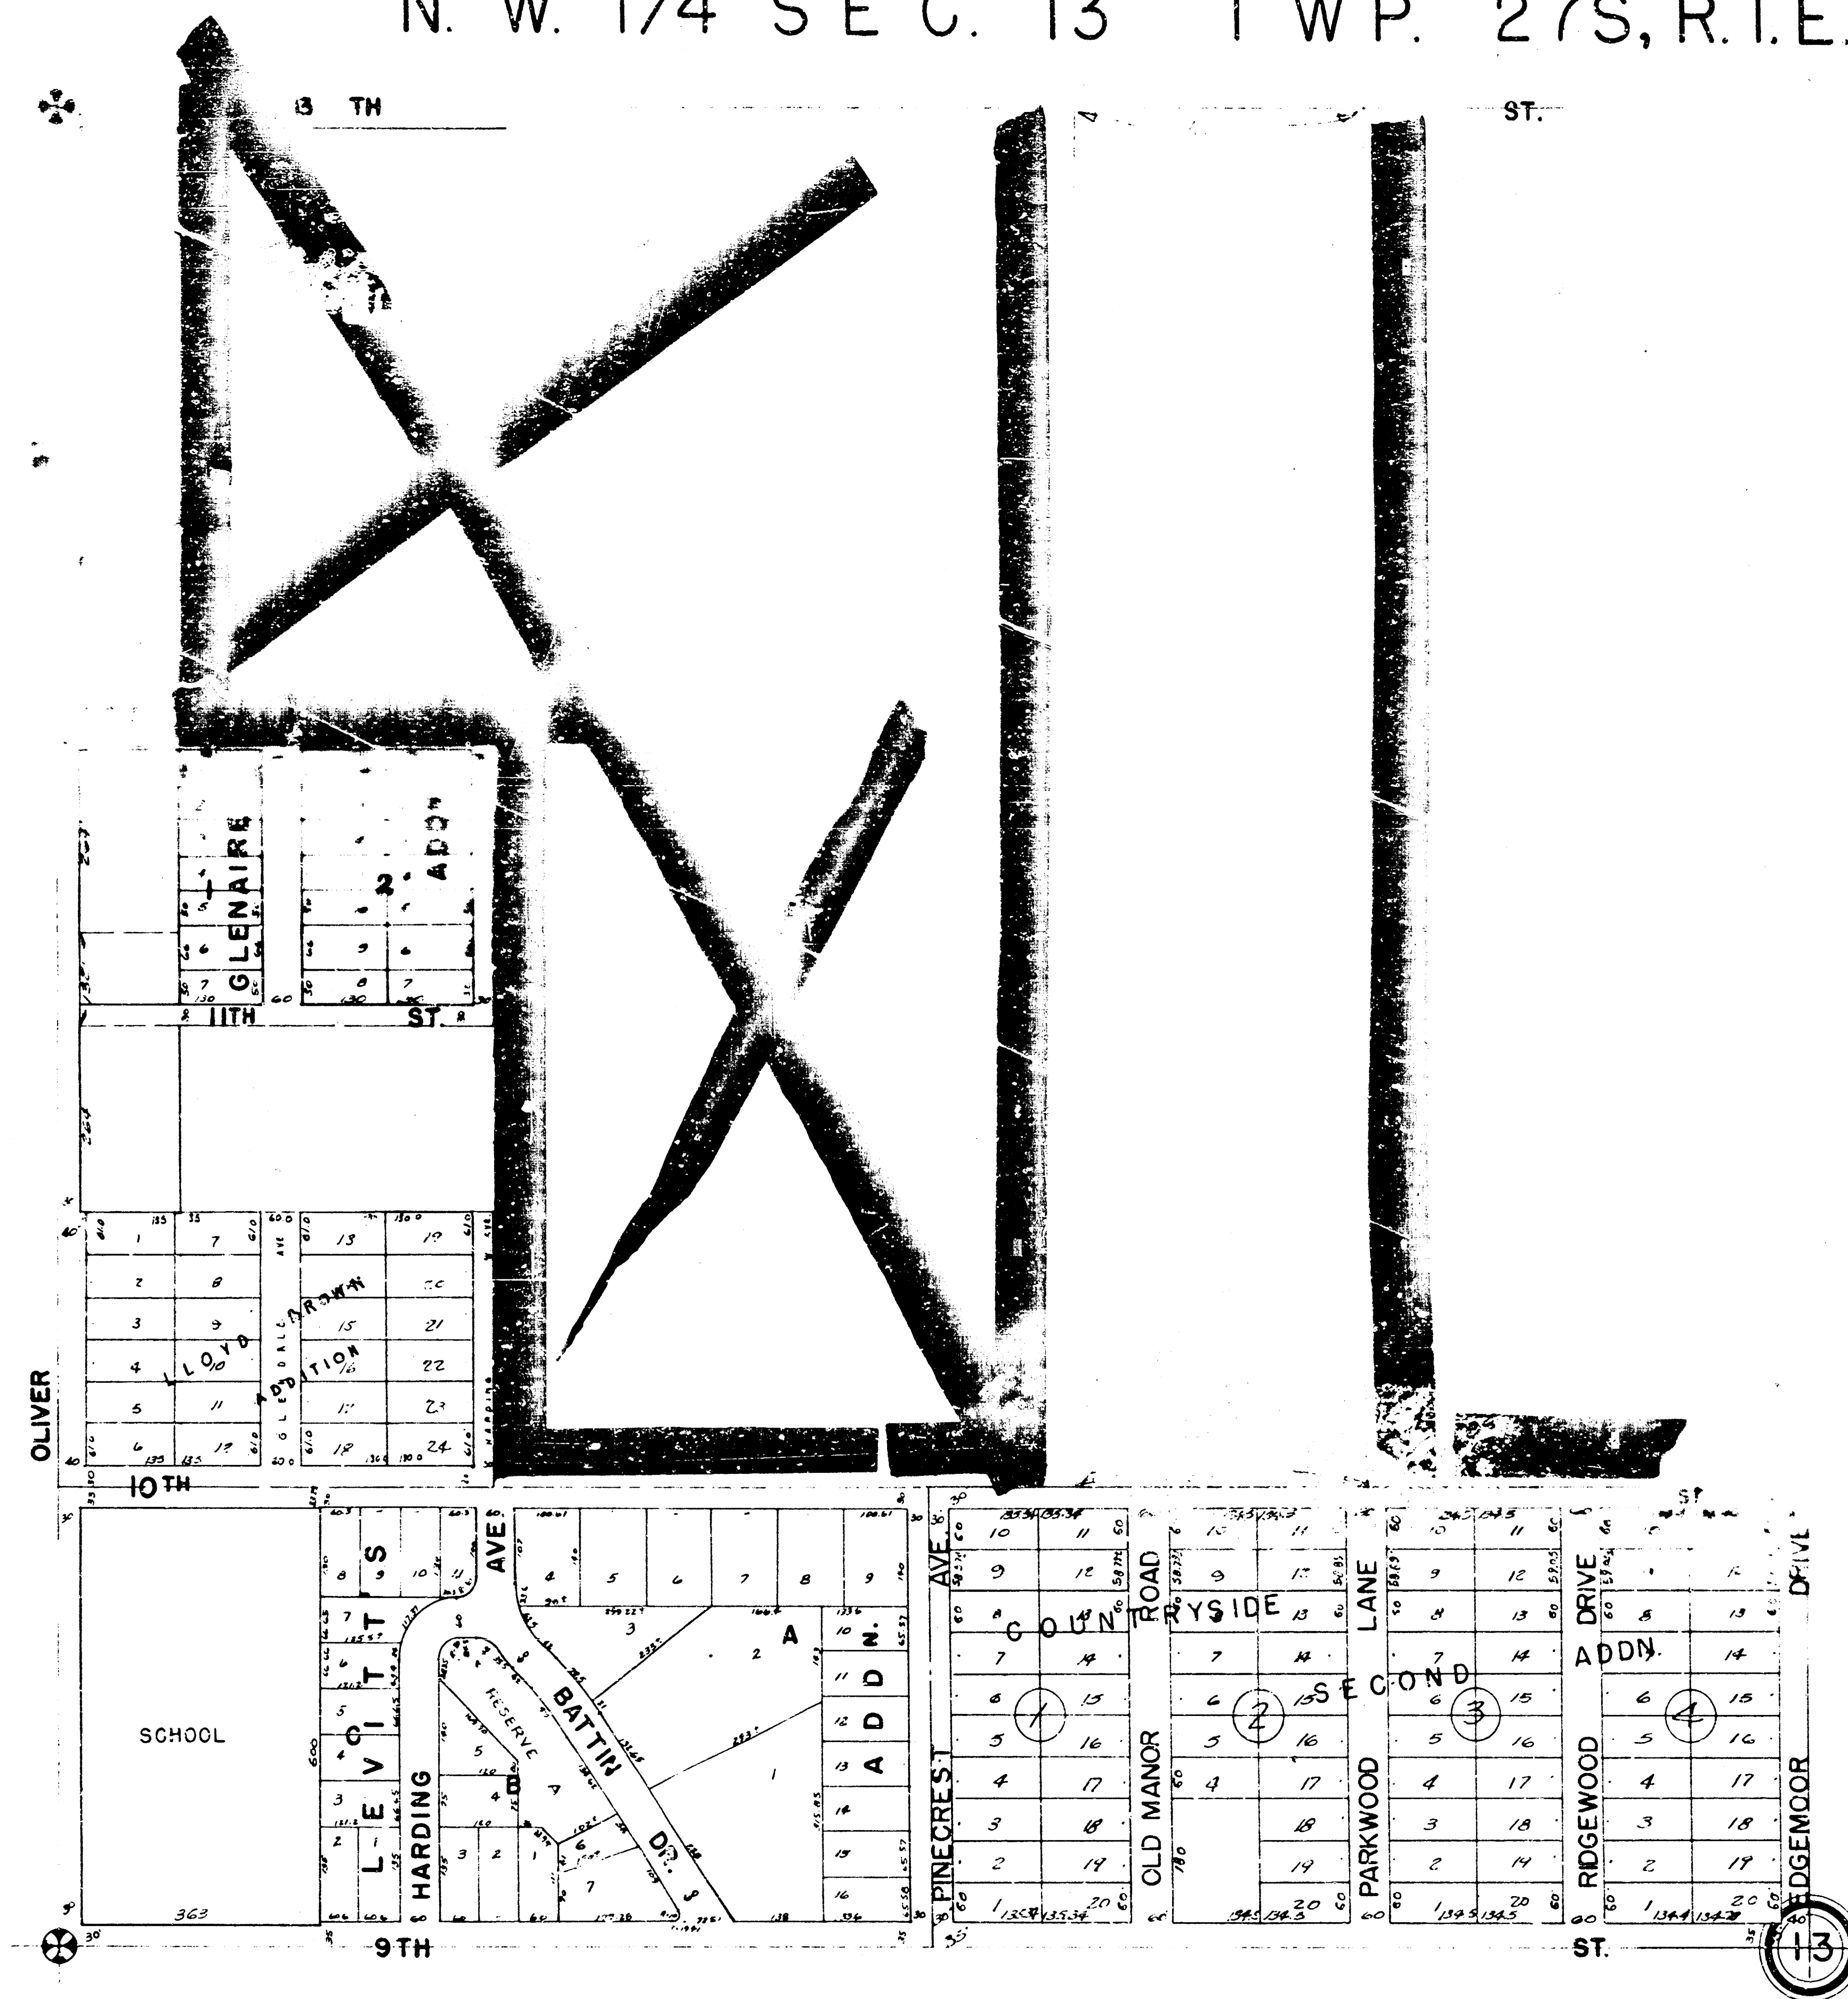


N.E. 1/4 SEC. 13, TWP. 27 S., R. 1 E.

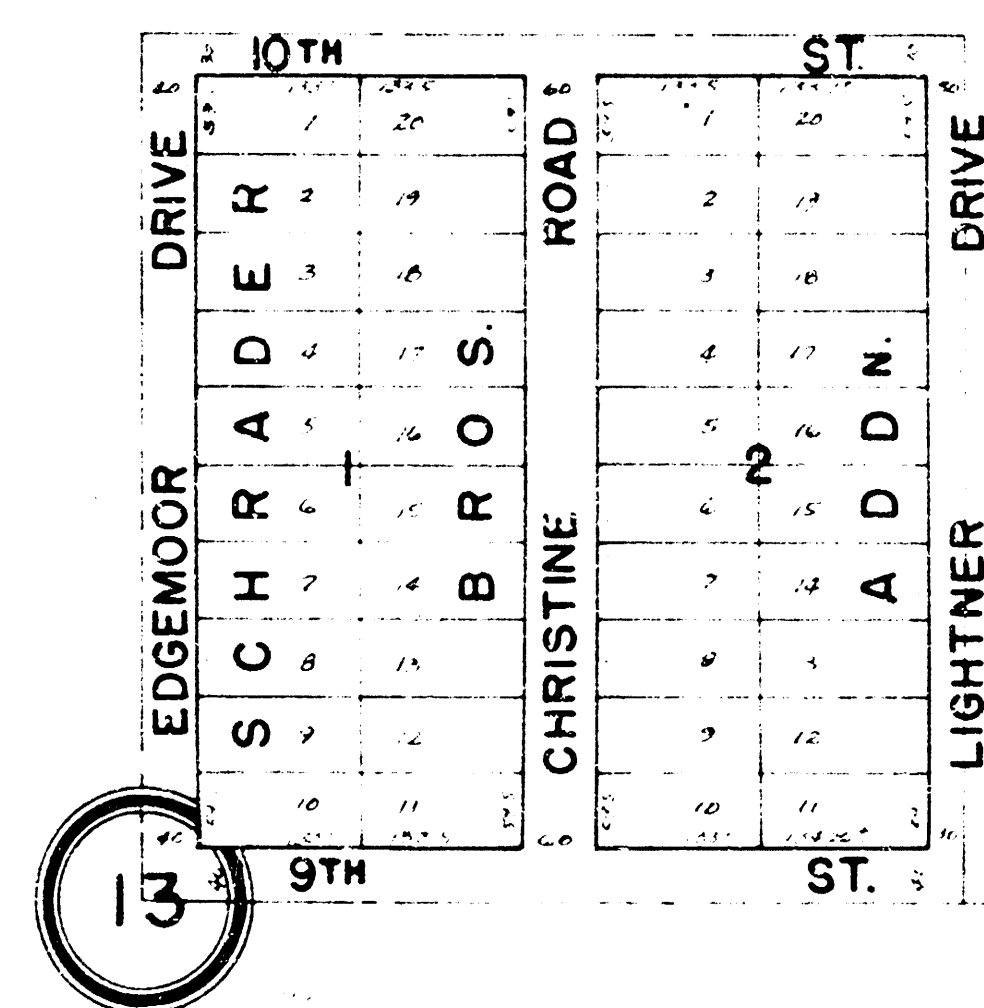


S.W. 1/4 SEC. 13 TWP. 27 S. R.1 E.

4

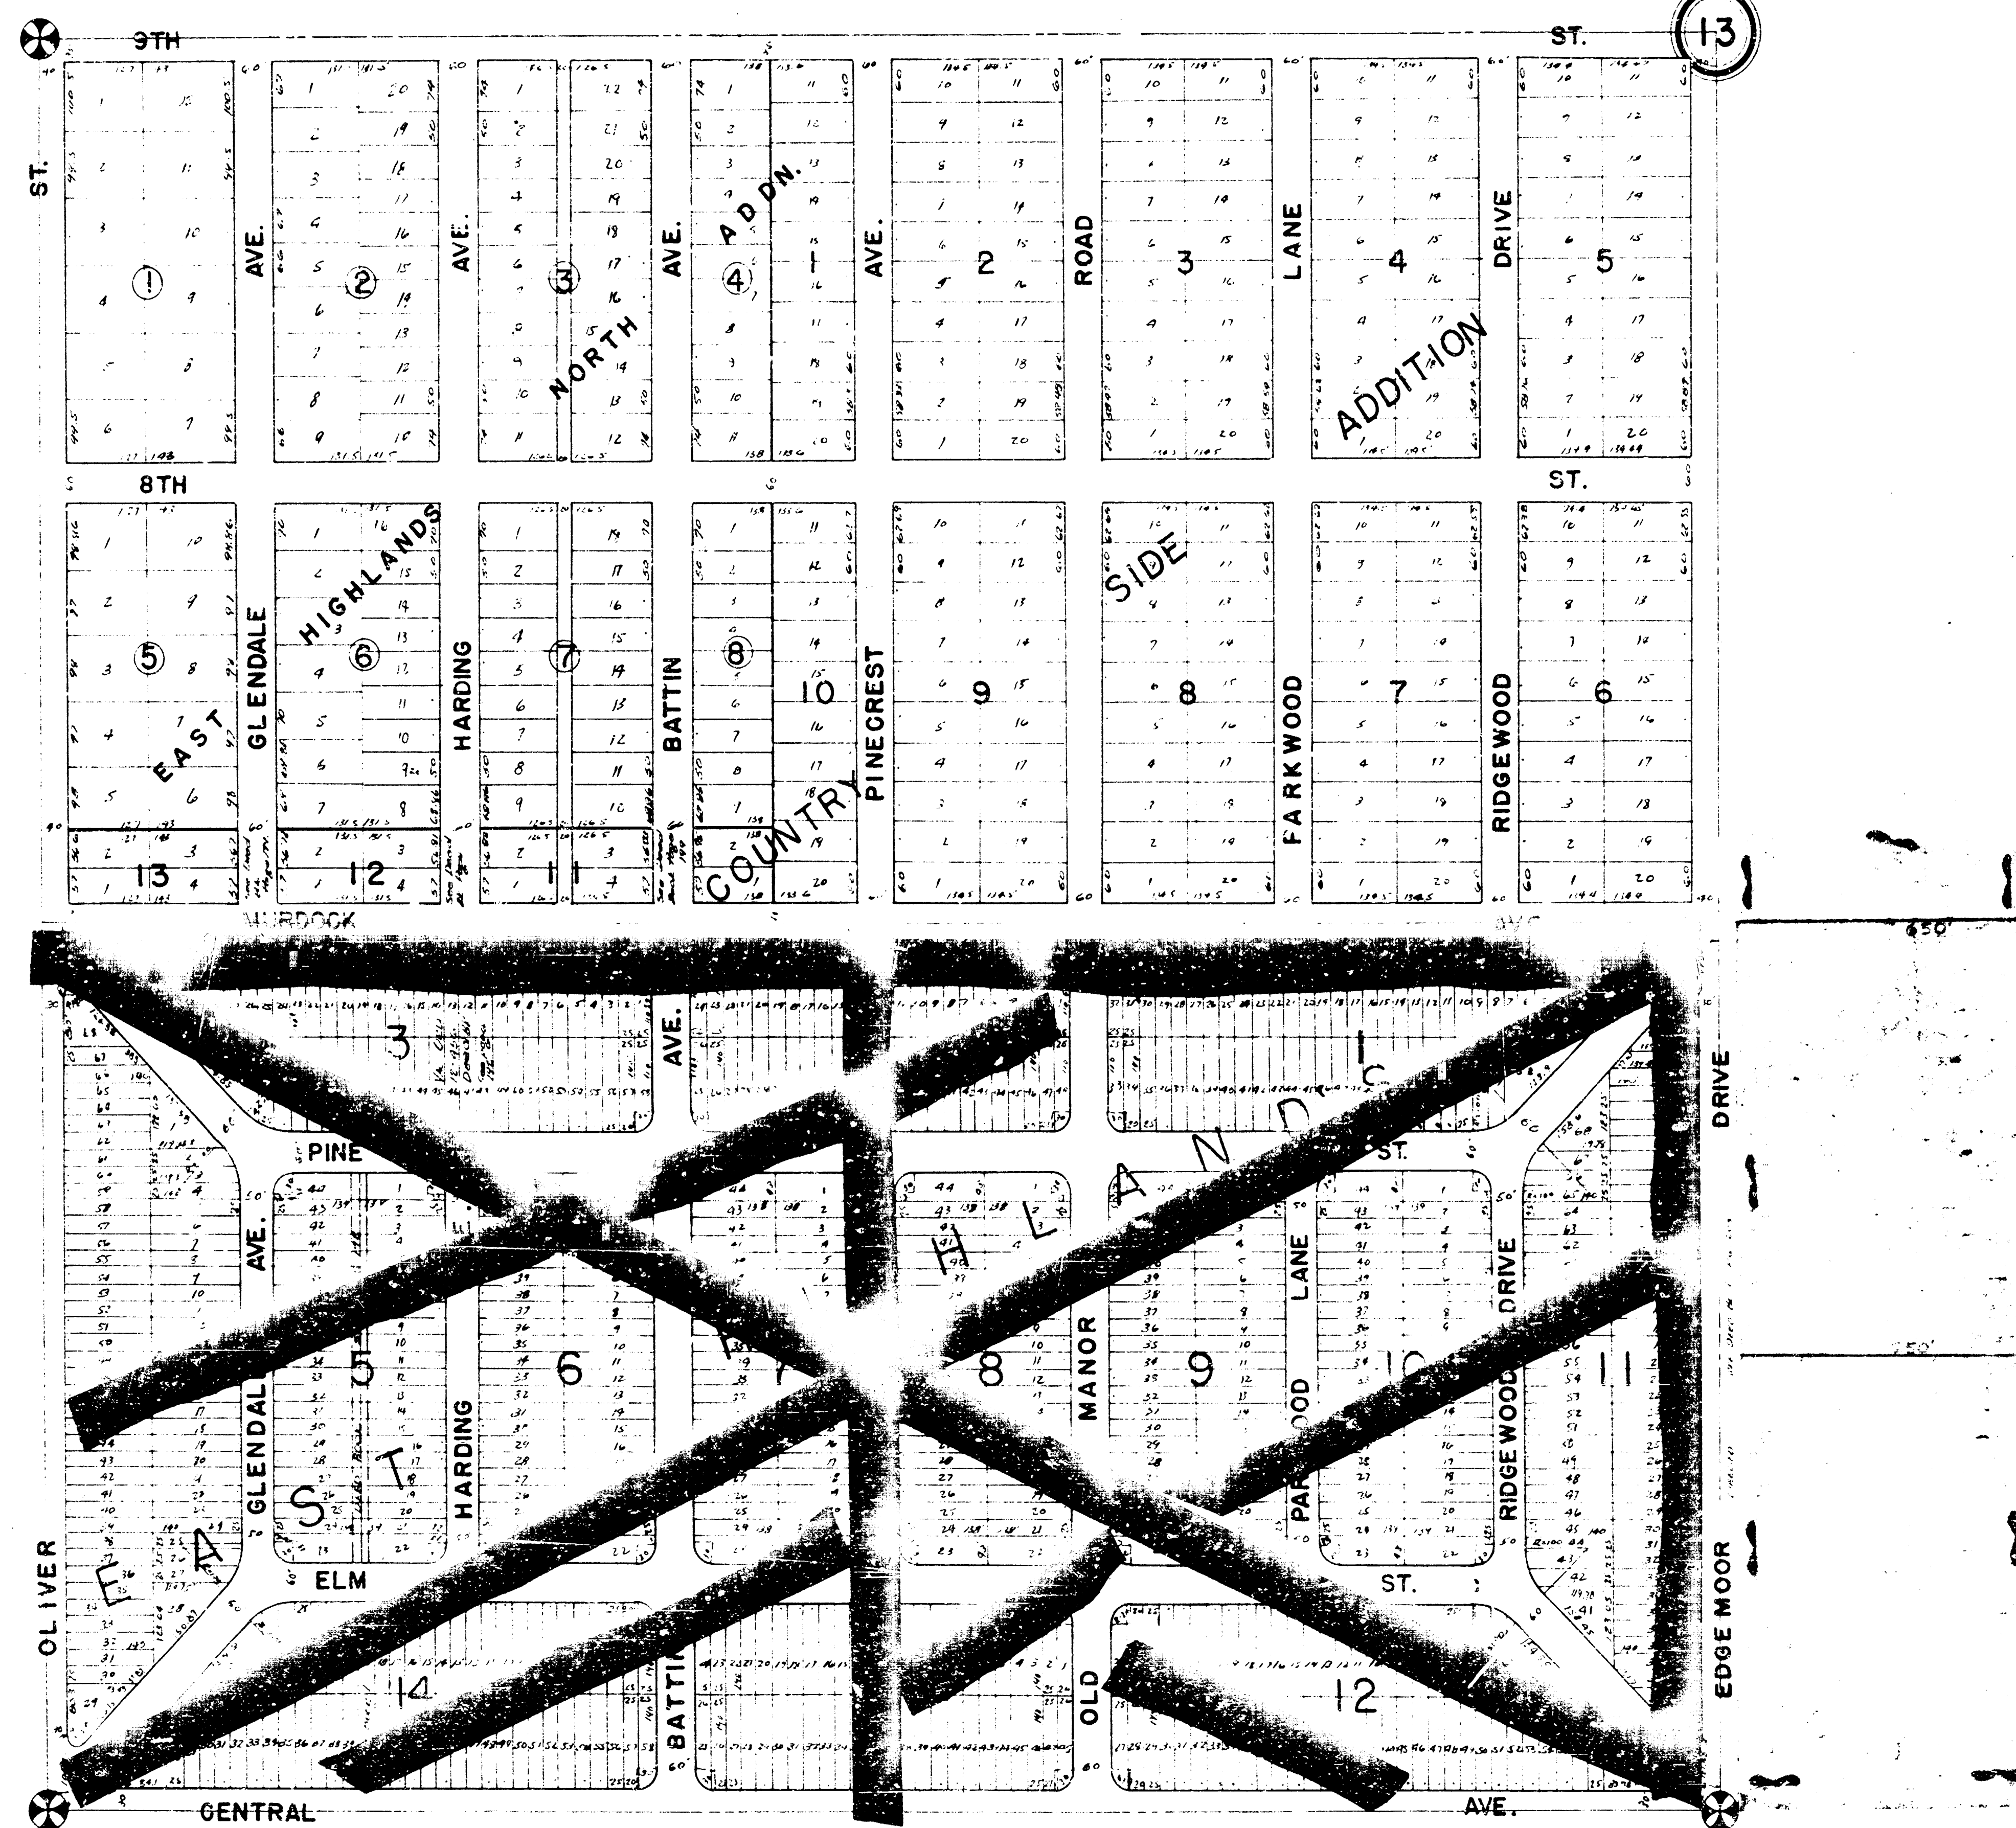

N.W. QUAR. SEC.24 TWP.27 R.I.E.

5

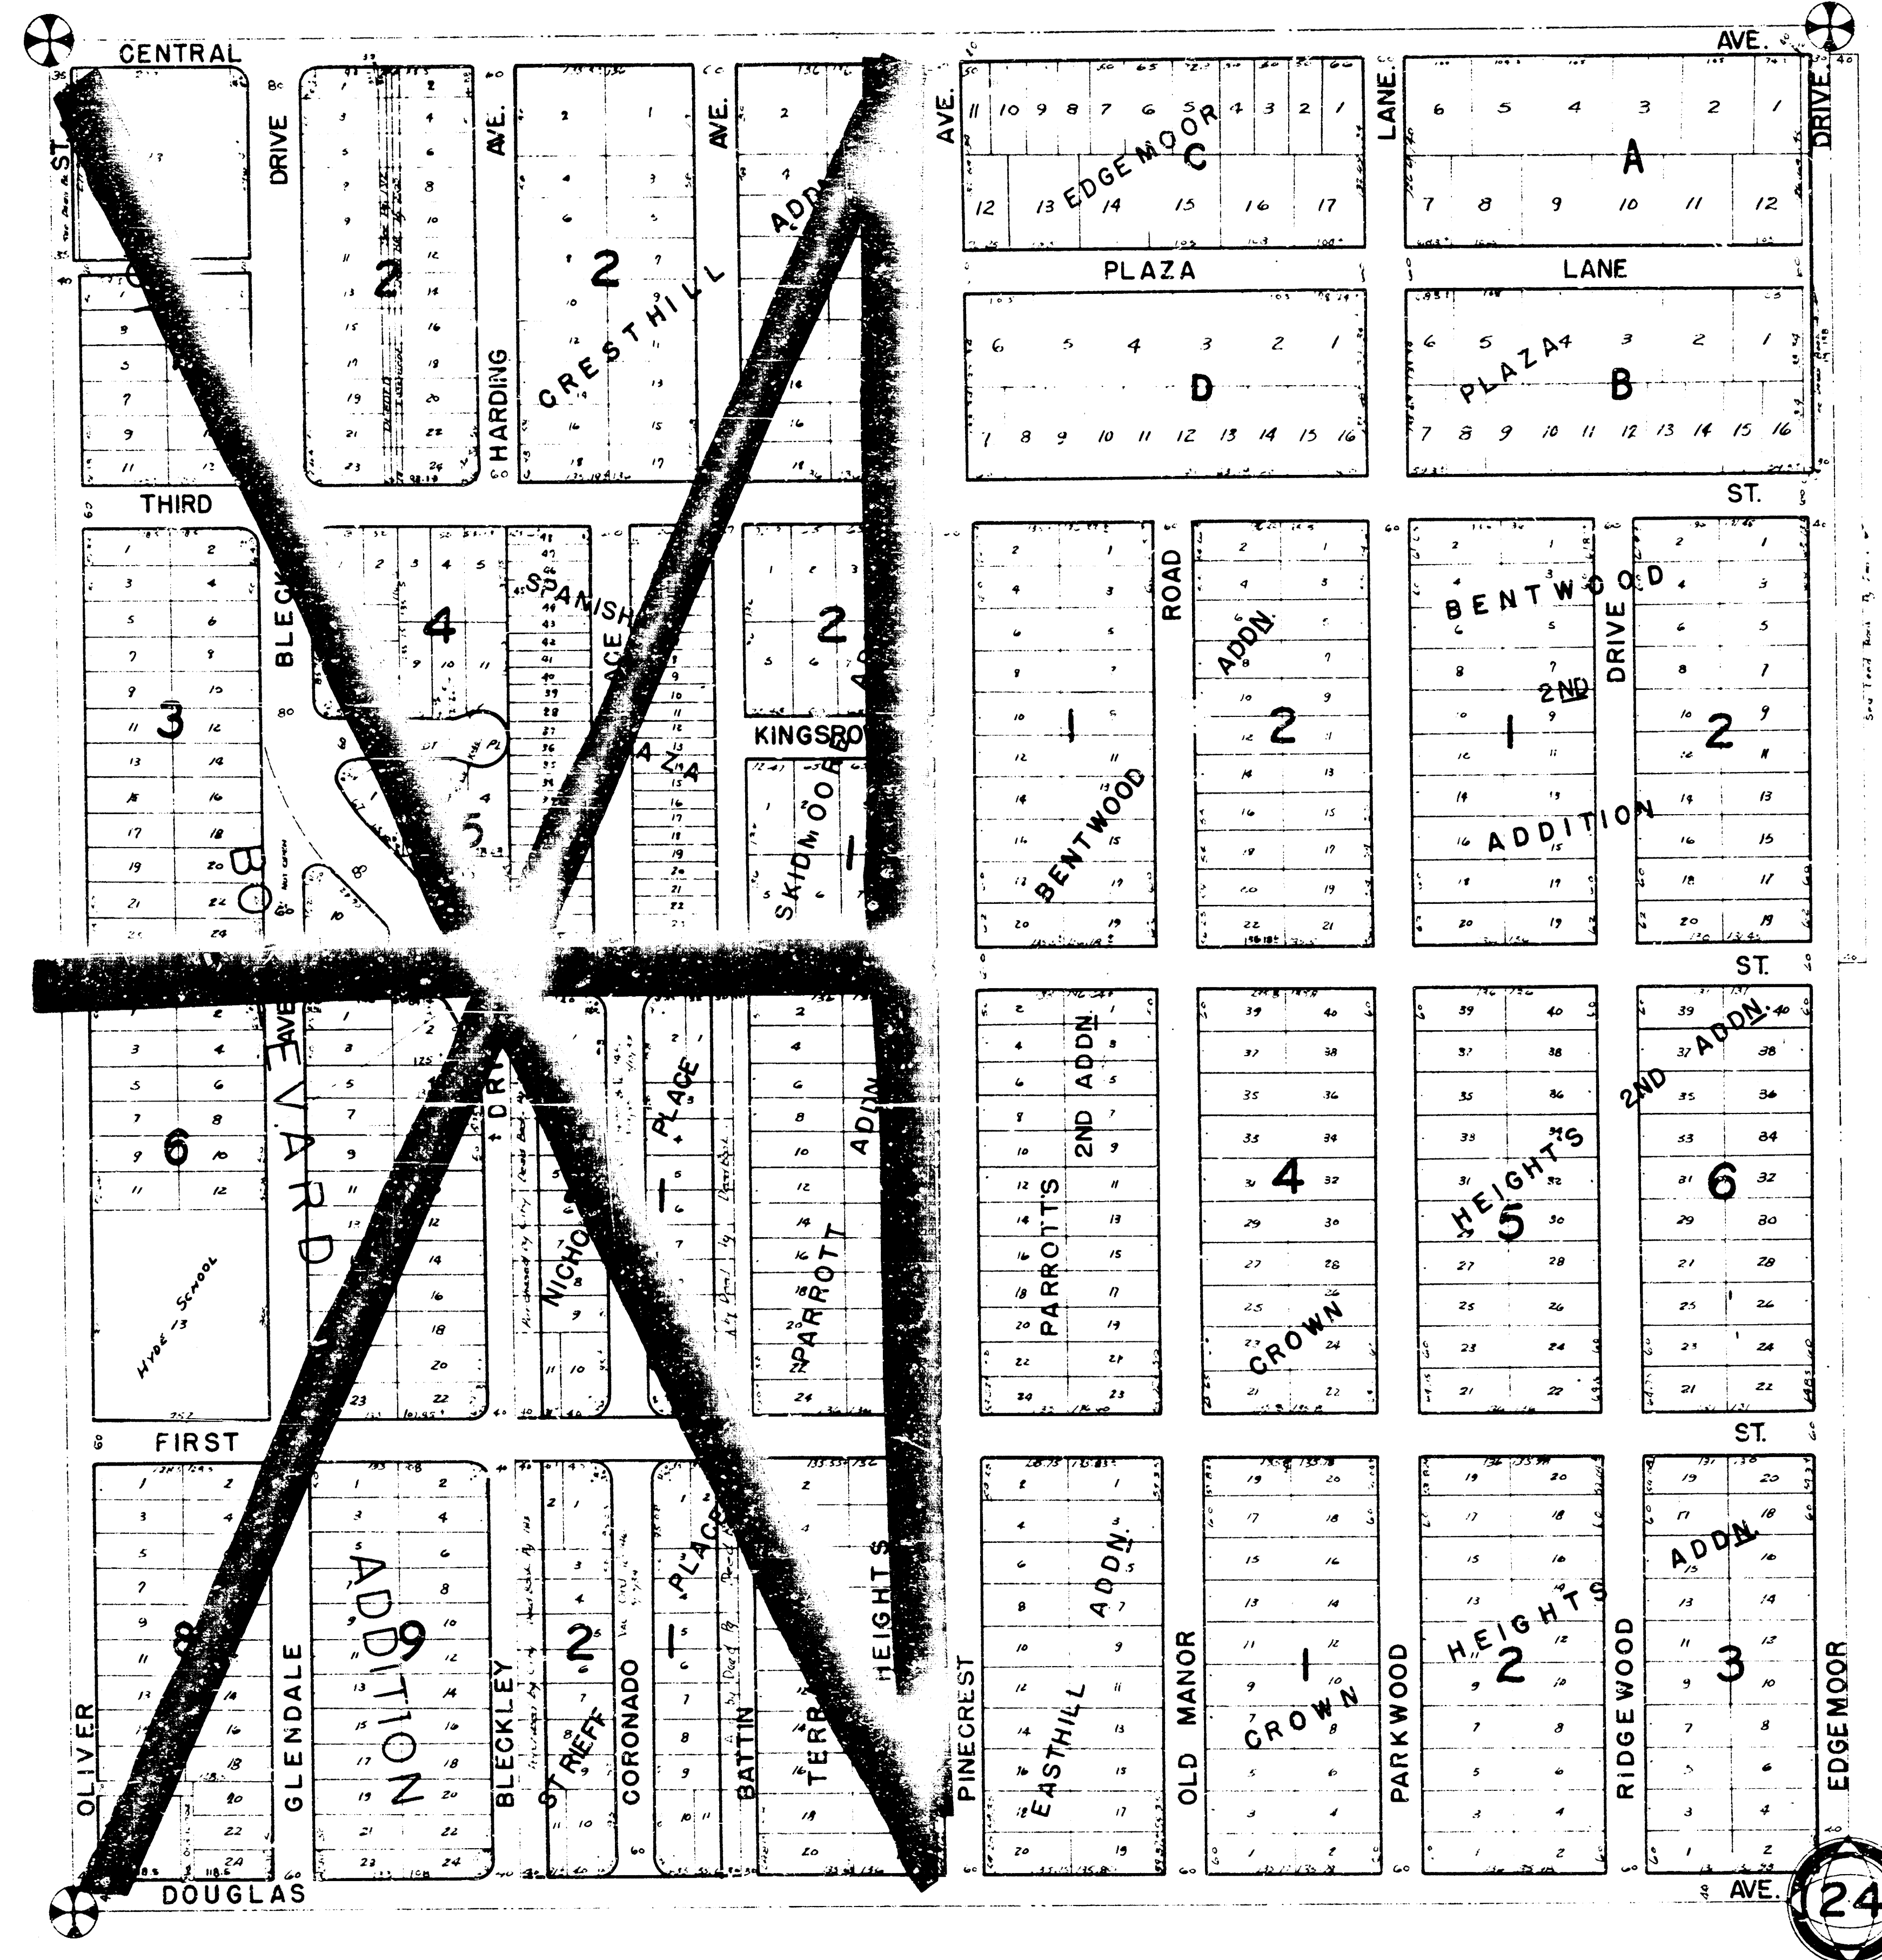










S.W. ¼ SEC. 24. TWP. 27S. R.1E.

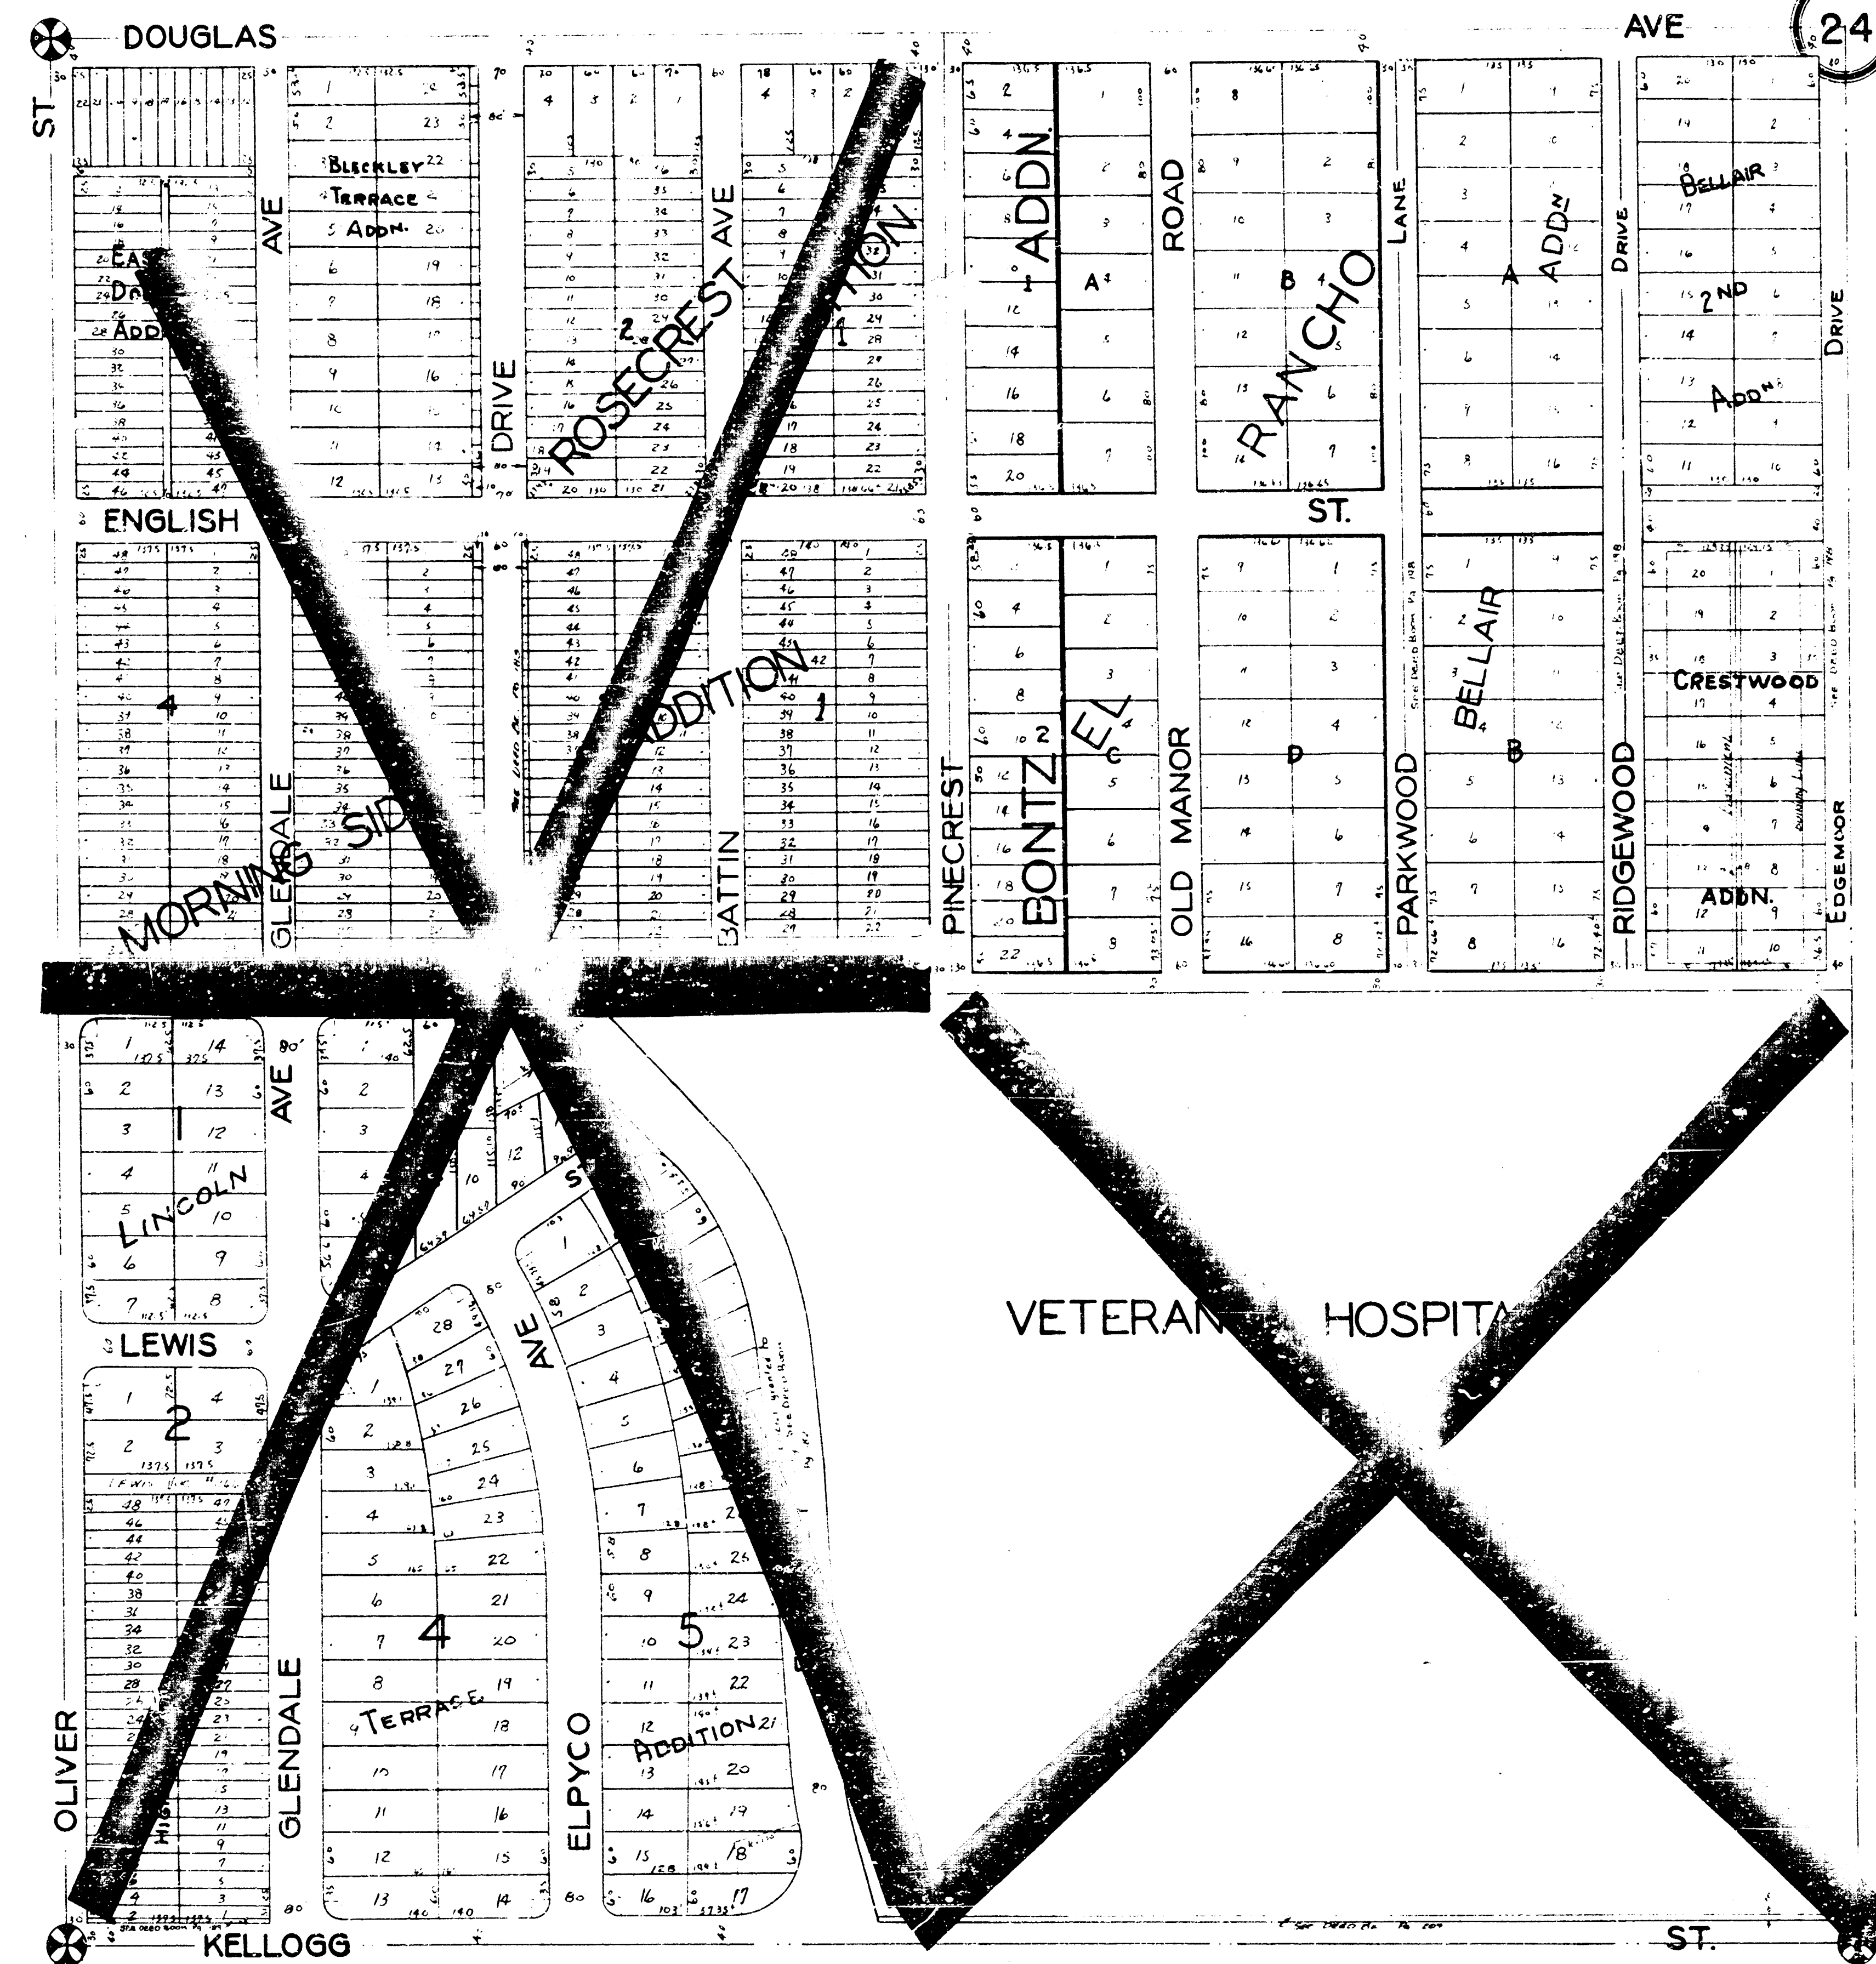

S.E. 1/4 SEC. 24 TWP. 27 S. R. 1 E.

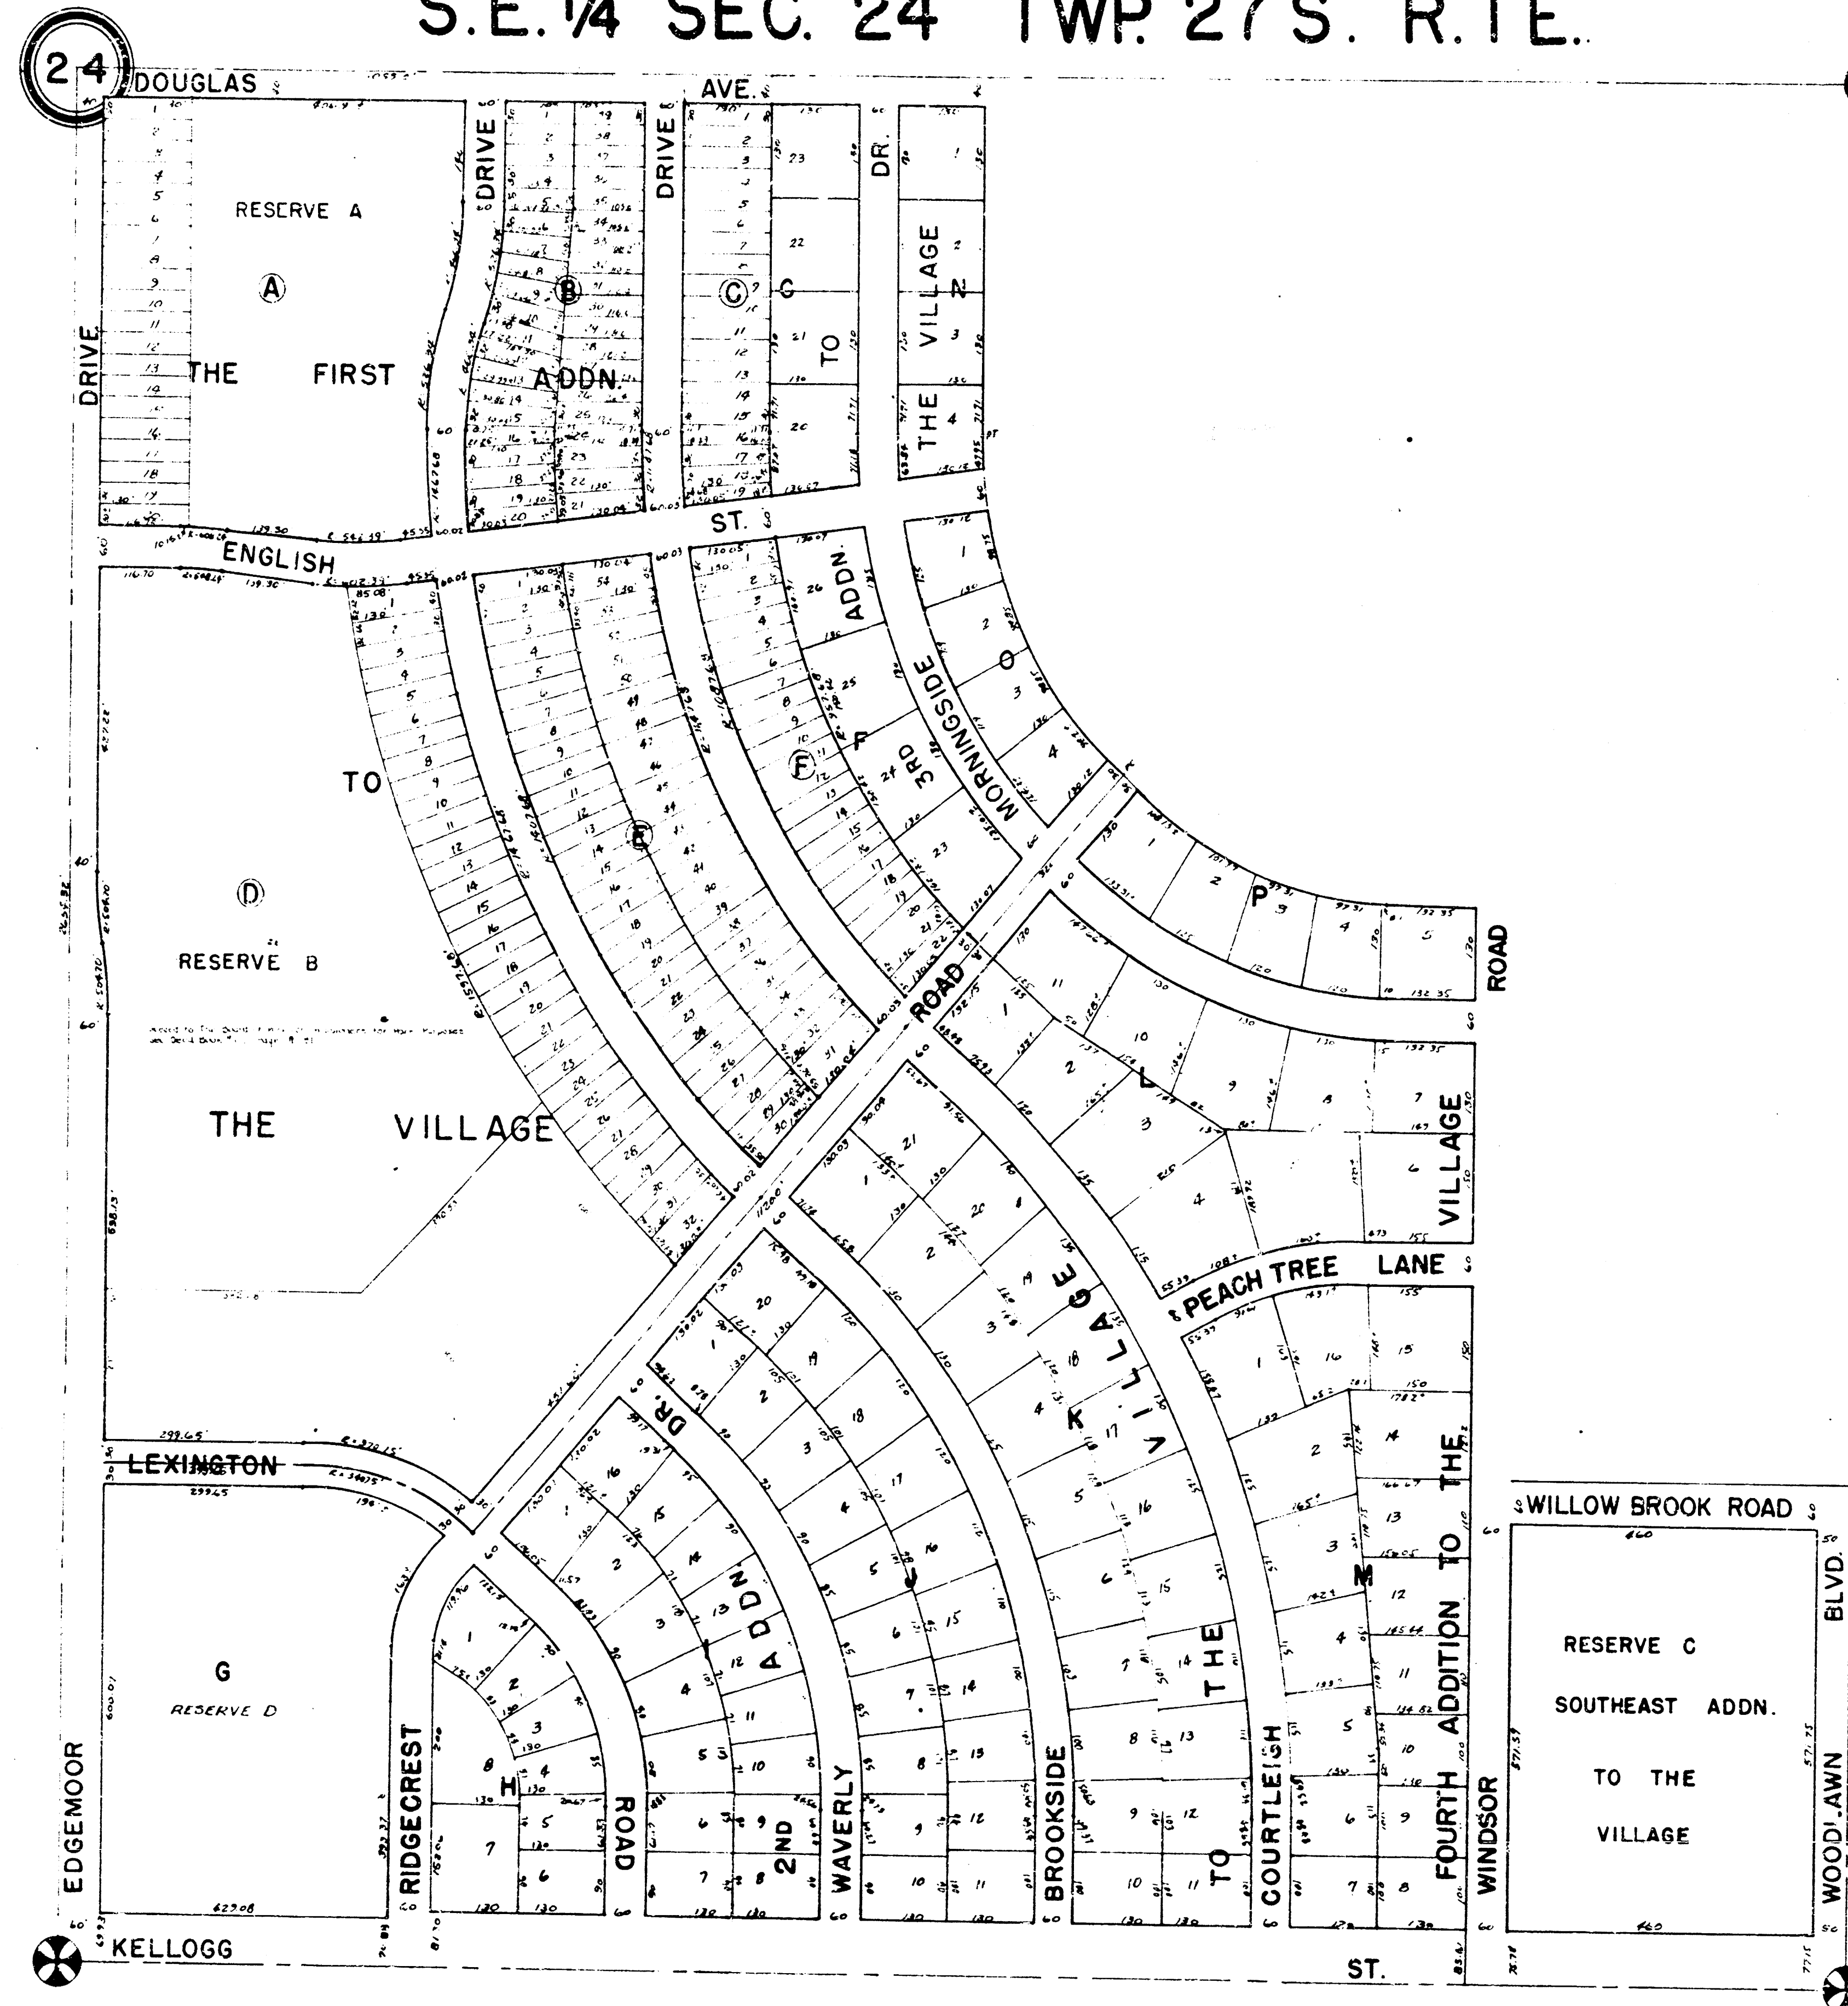


N.E. 1/4 SEC. 26 TWP. 27 R. 1 E.

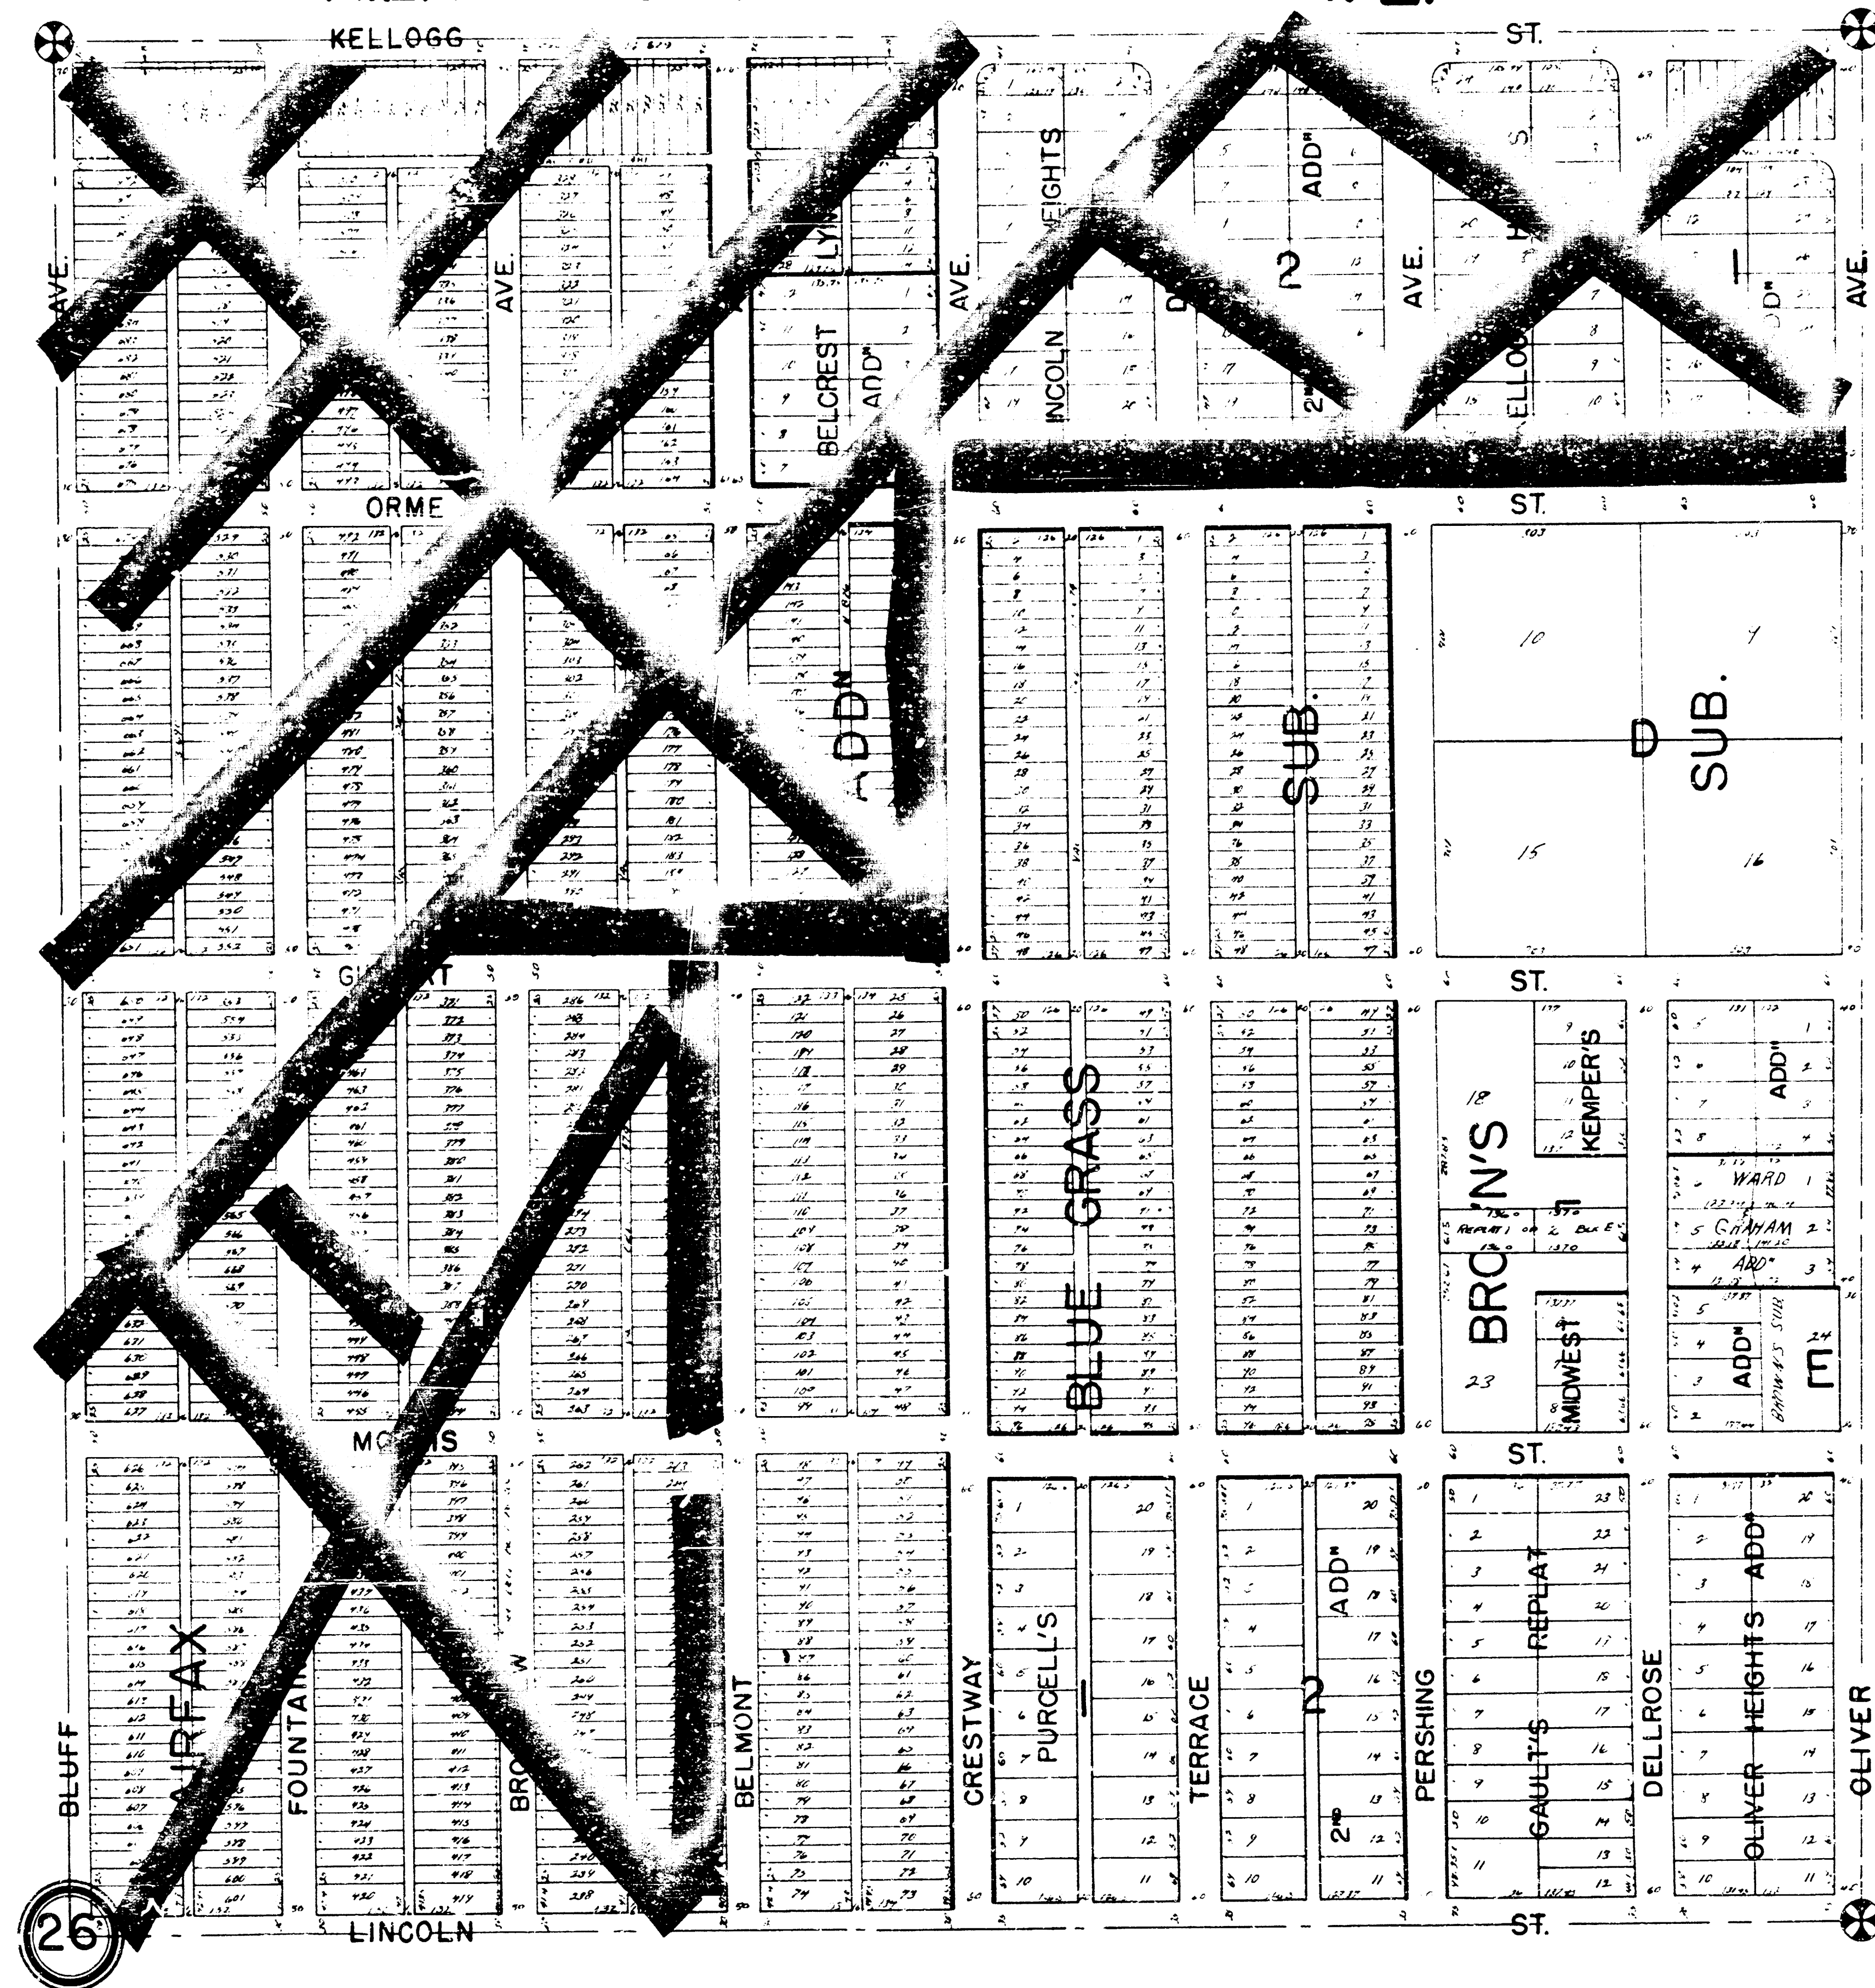


NW 1/4 SEC. 25 TWP. 27 S. R. 1 E.

10

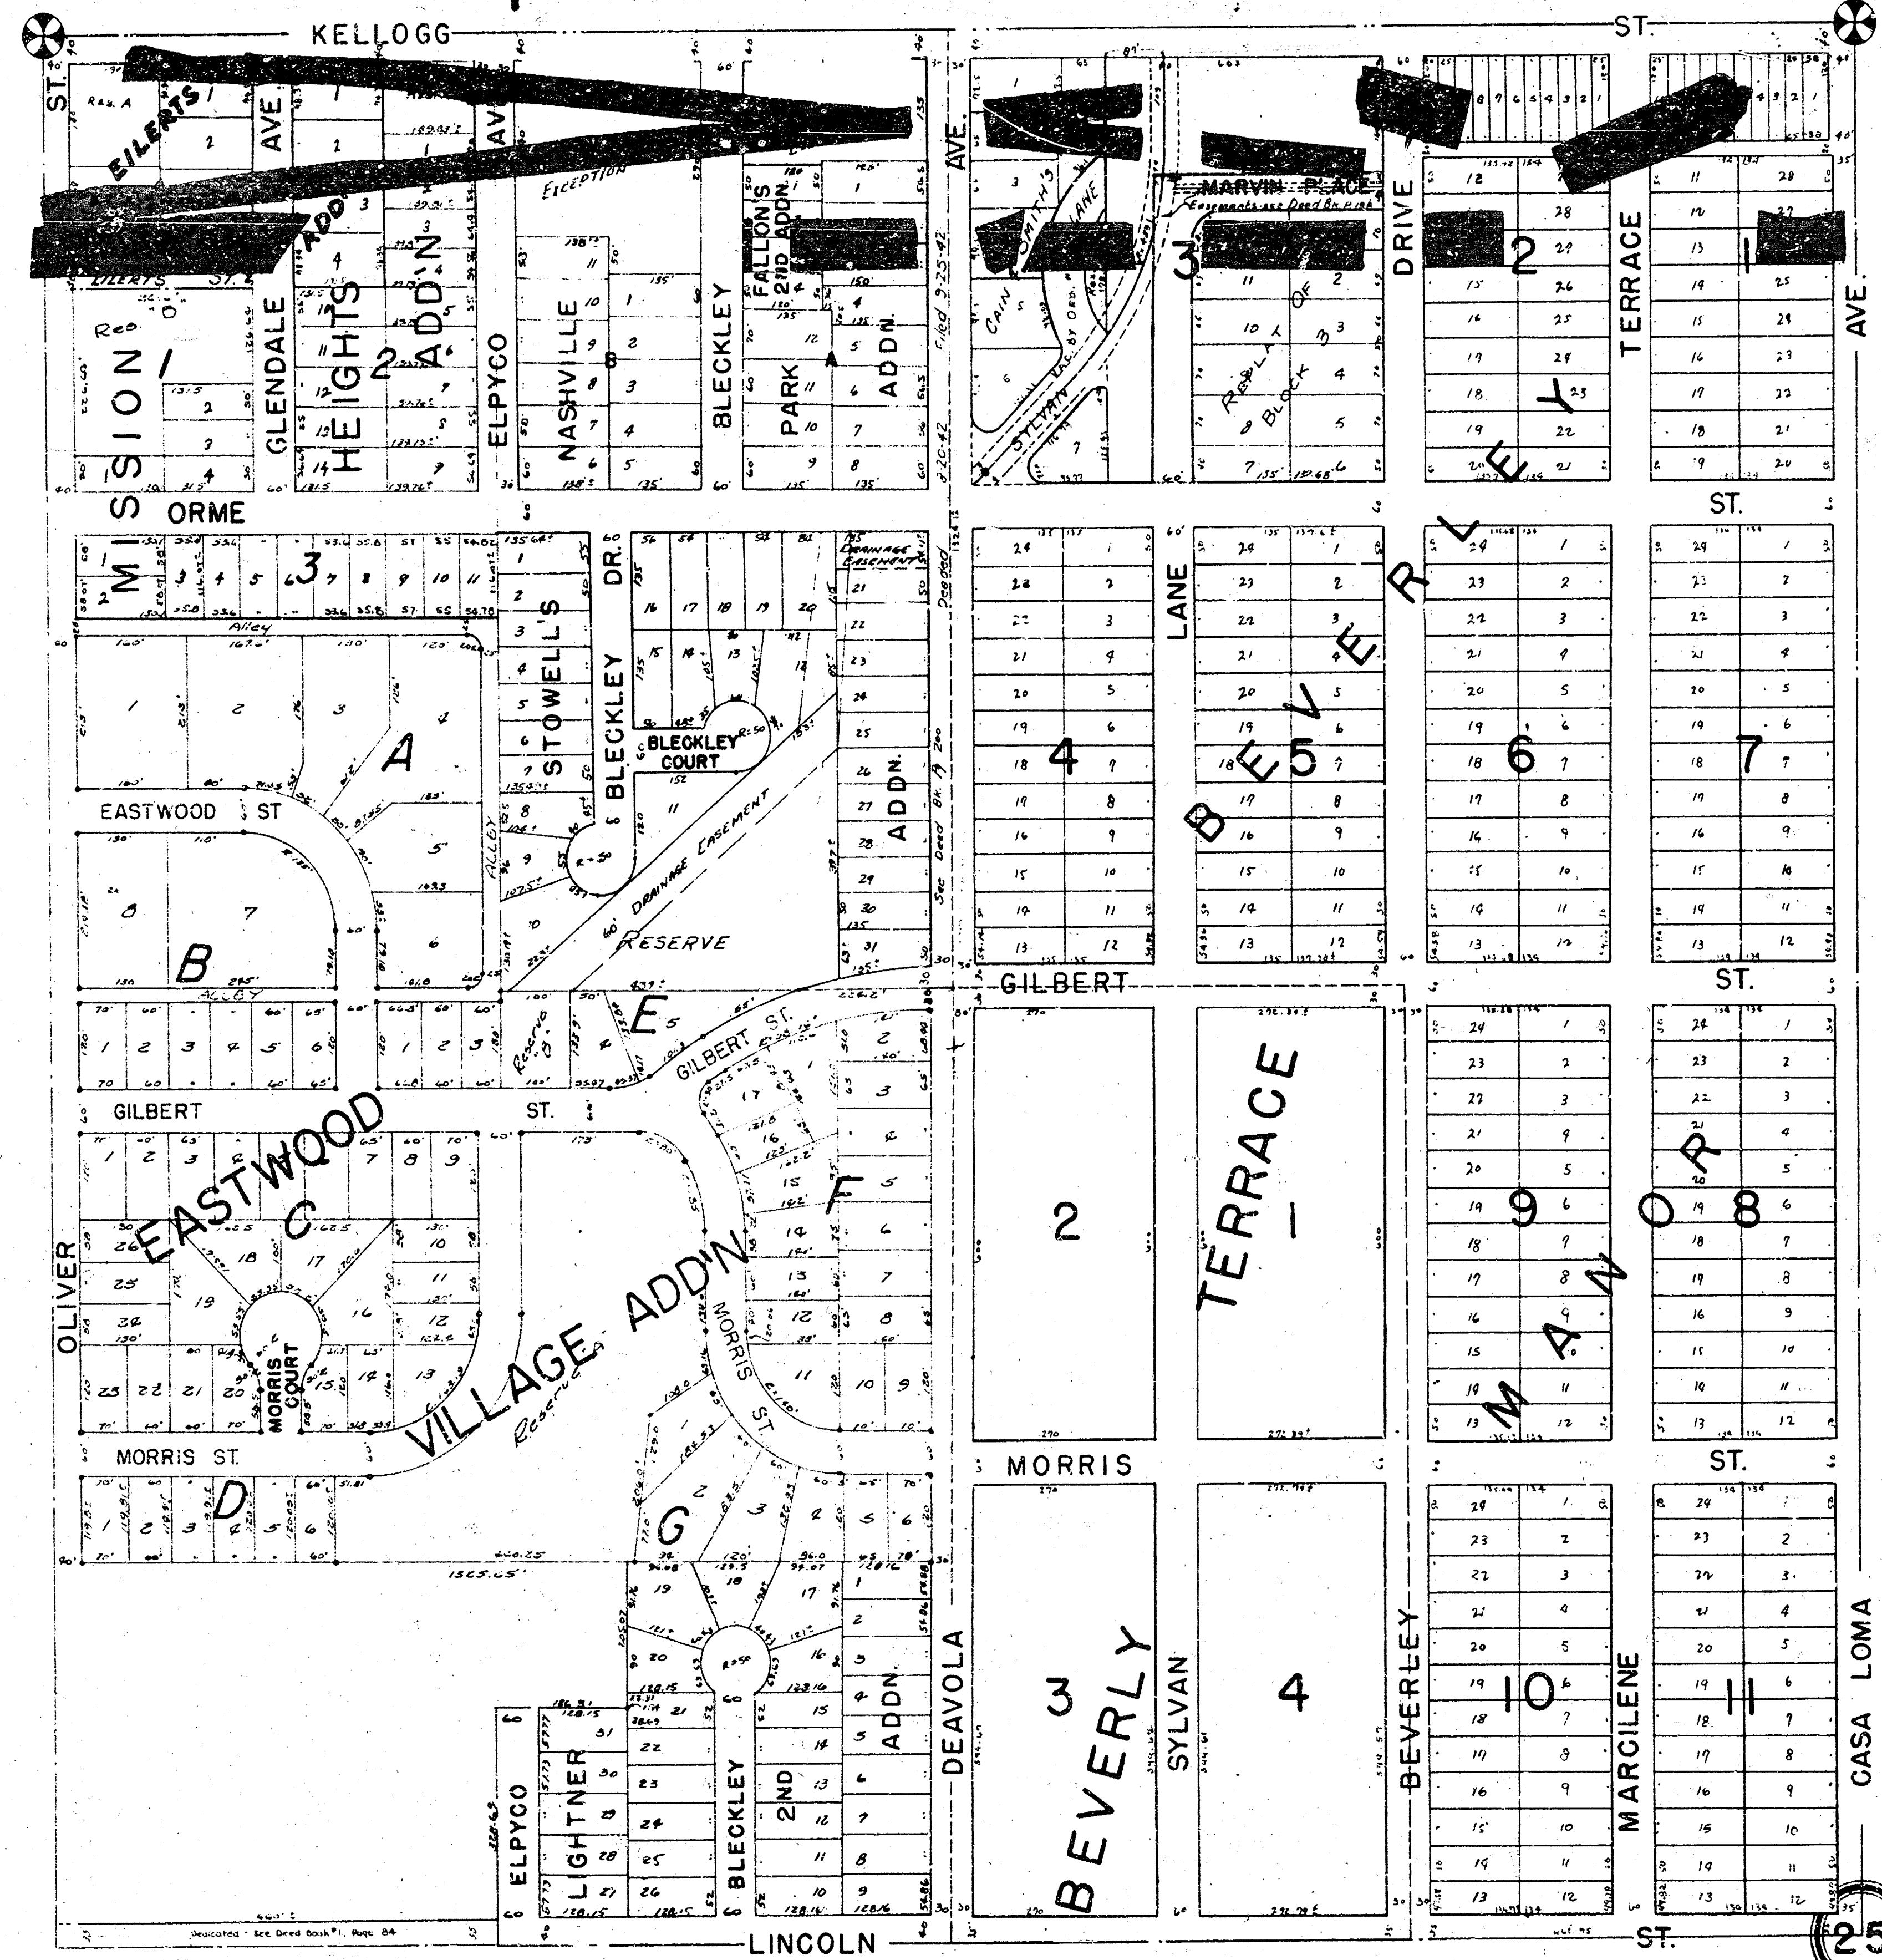


25


N.E. 1/4 SEC. 25 TWP. 27 S. R.1 E.

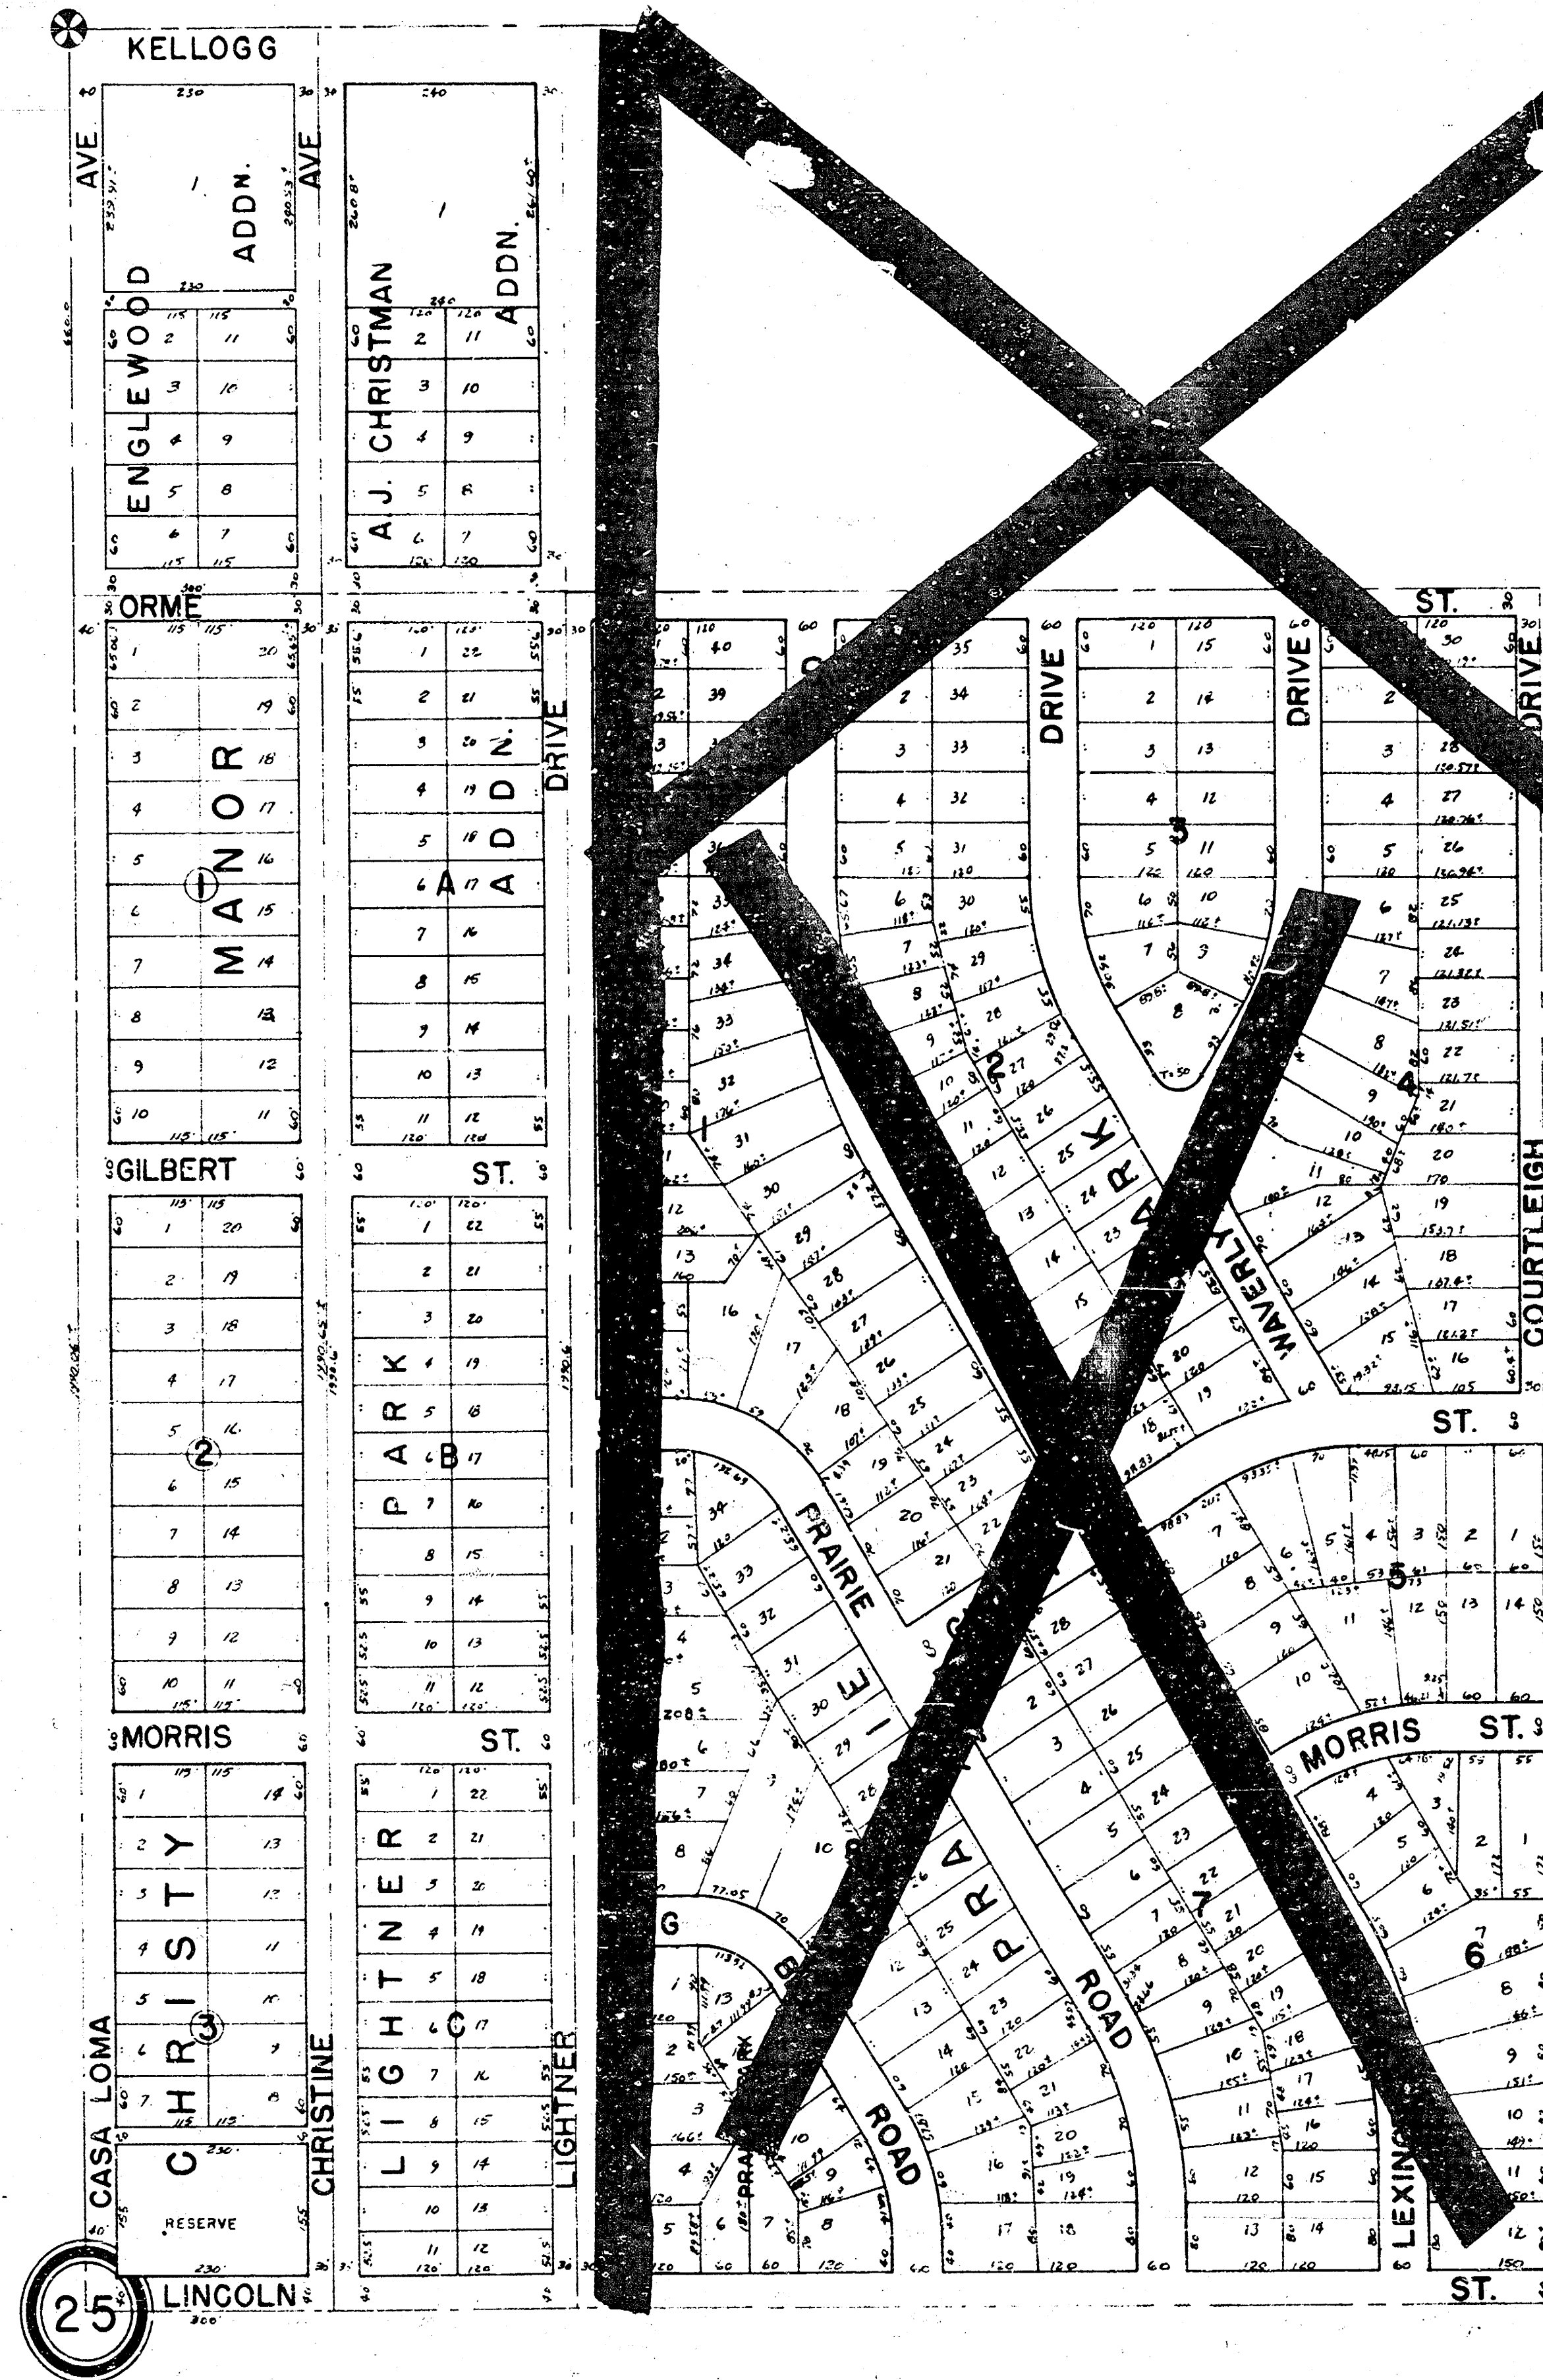


S.E. $\frac{1}{4}$ SEC. 26 T. 27 S. R. 1 E.

12

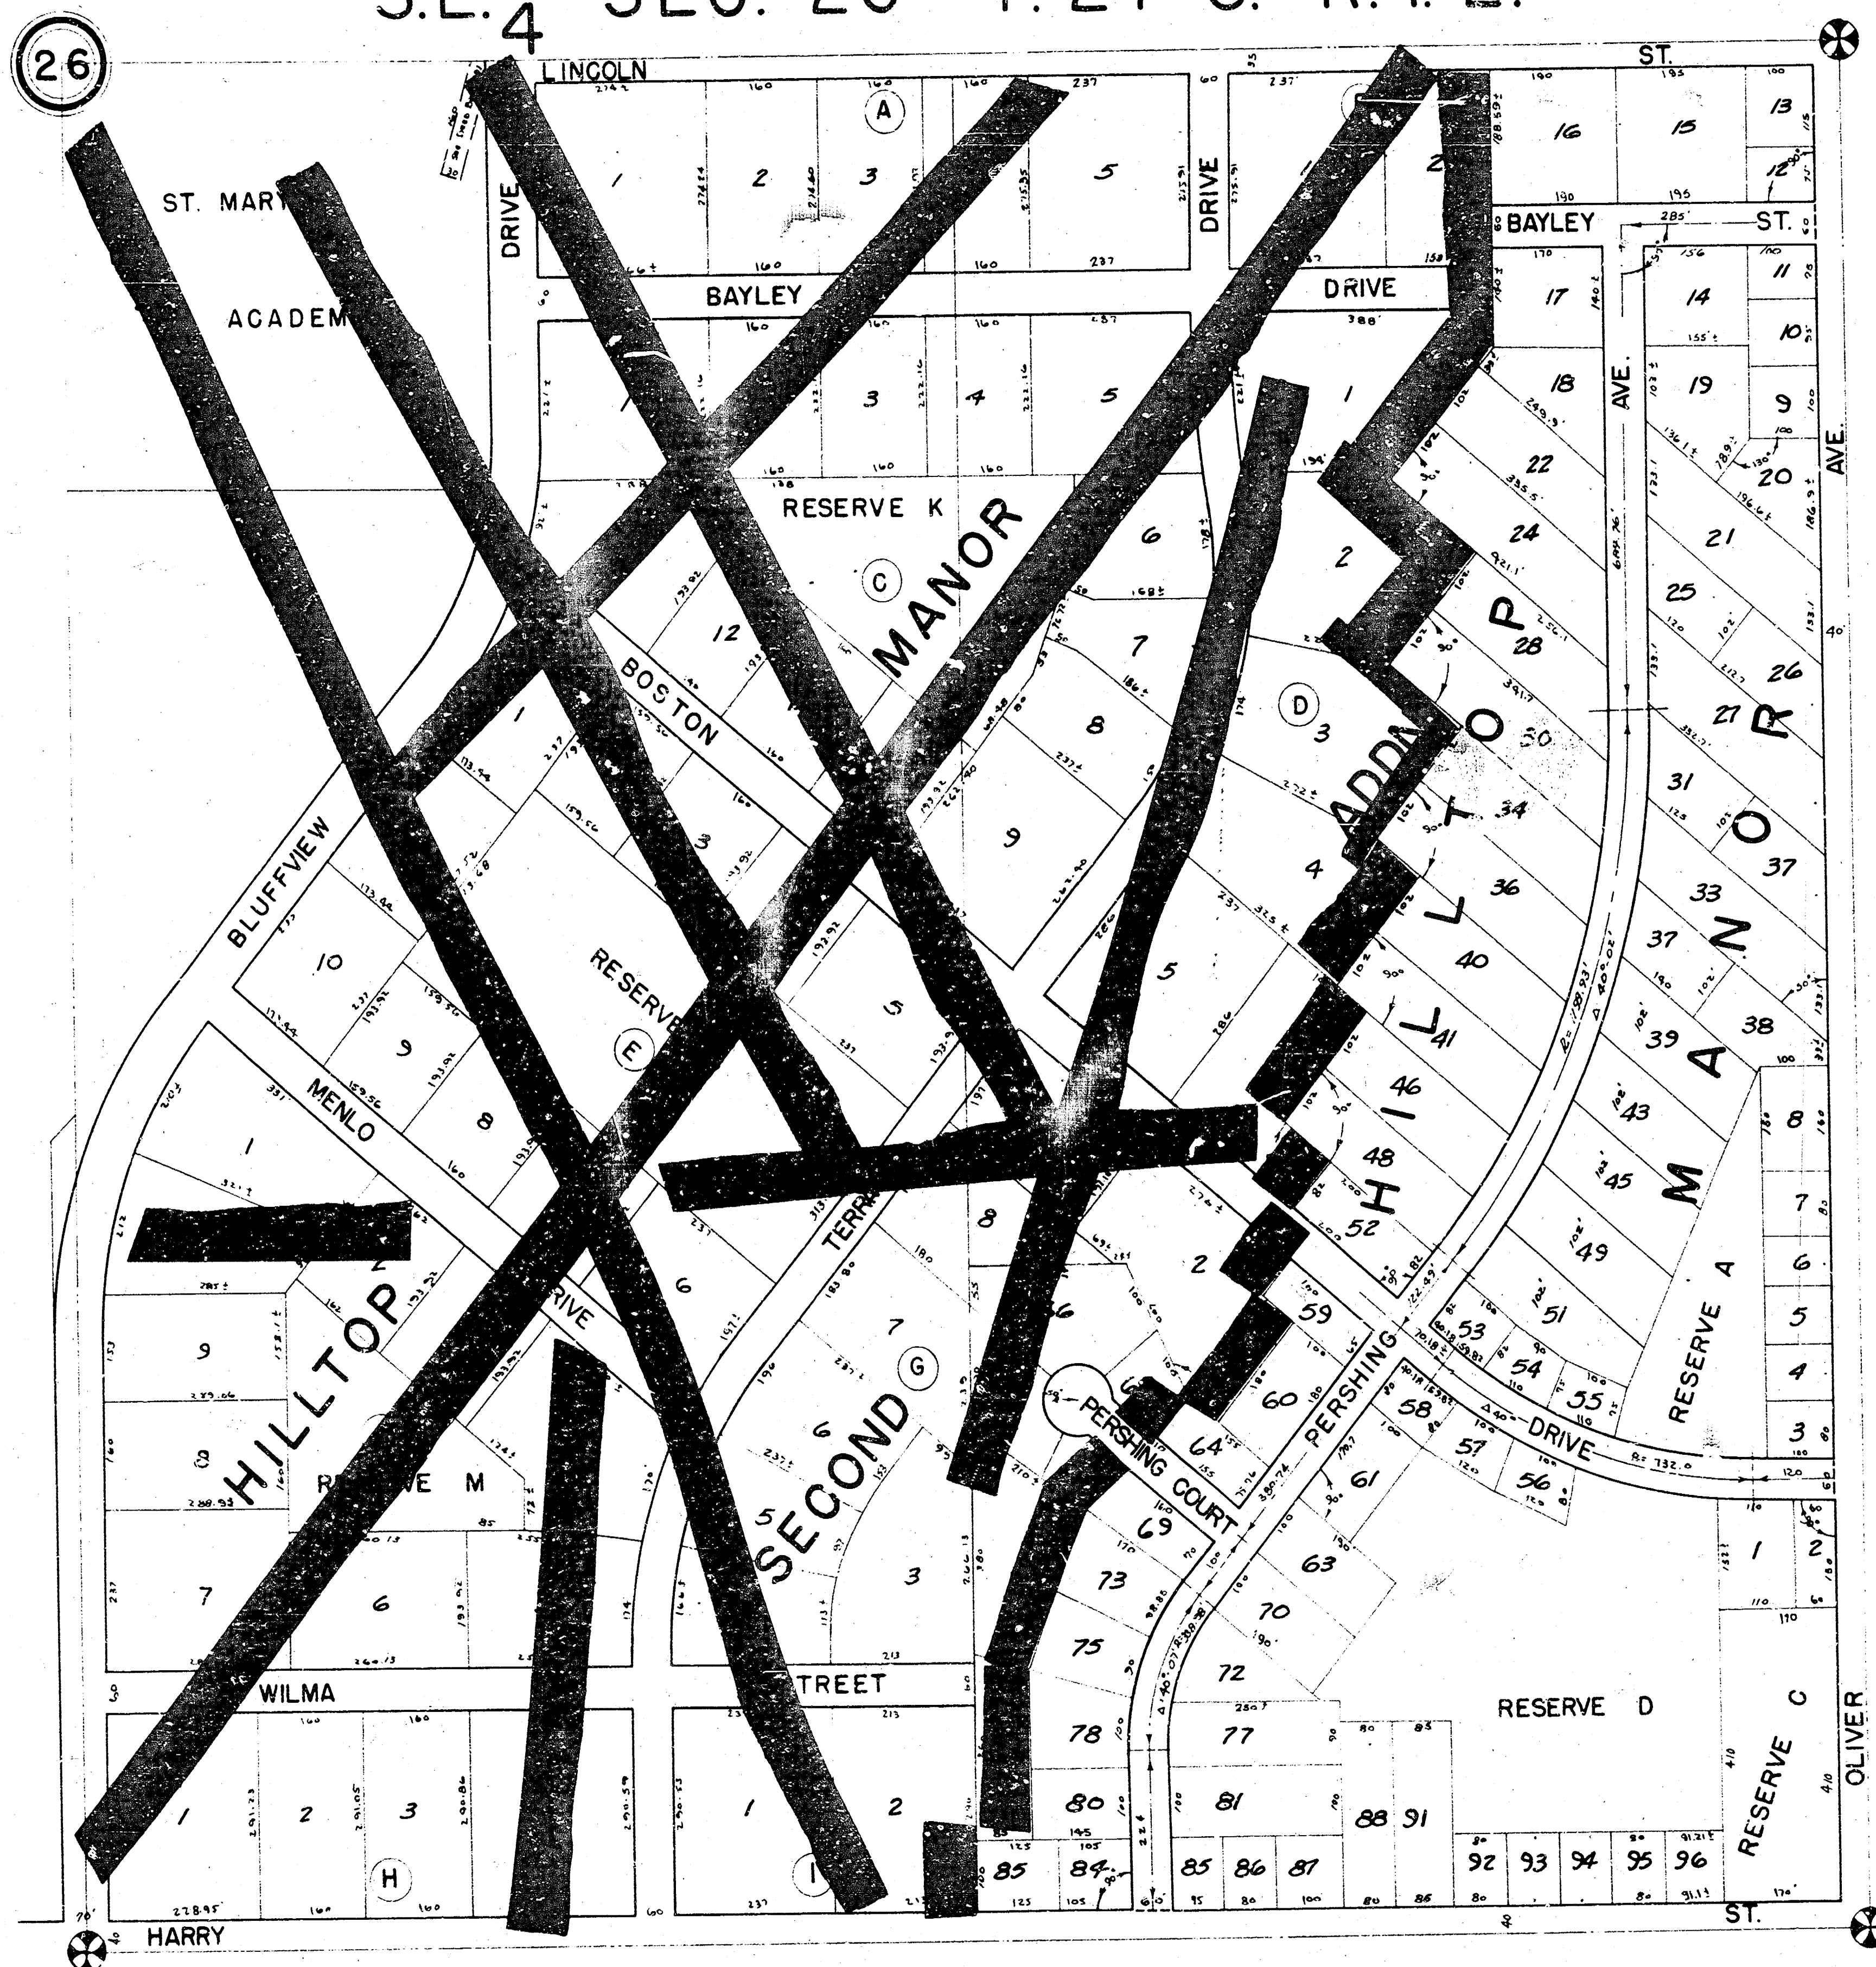


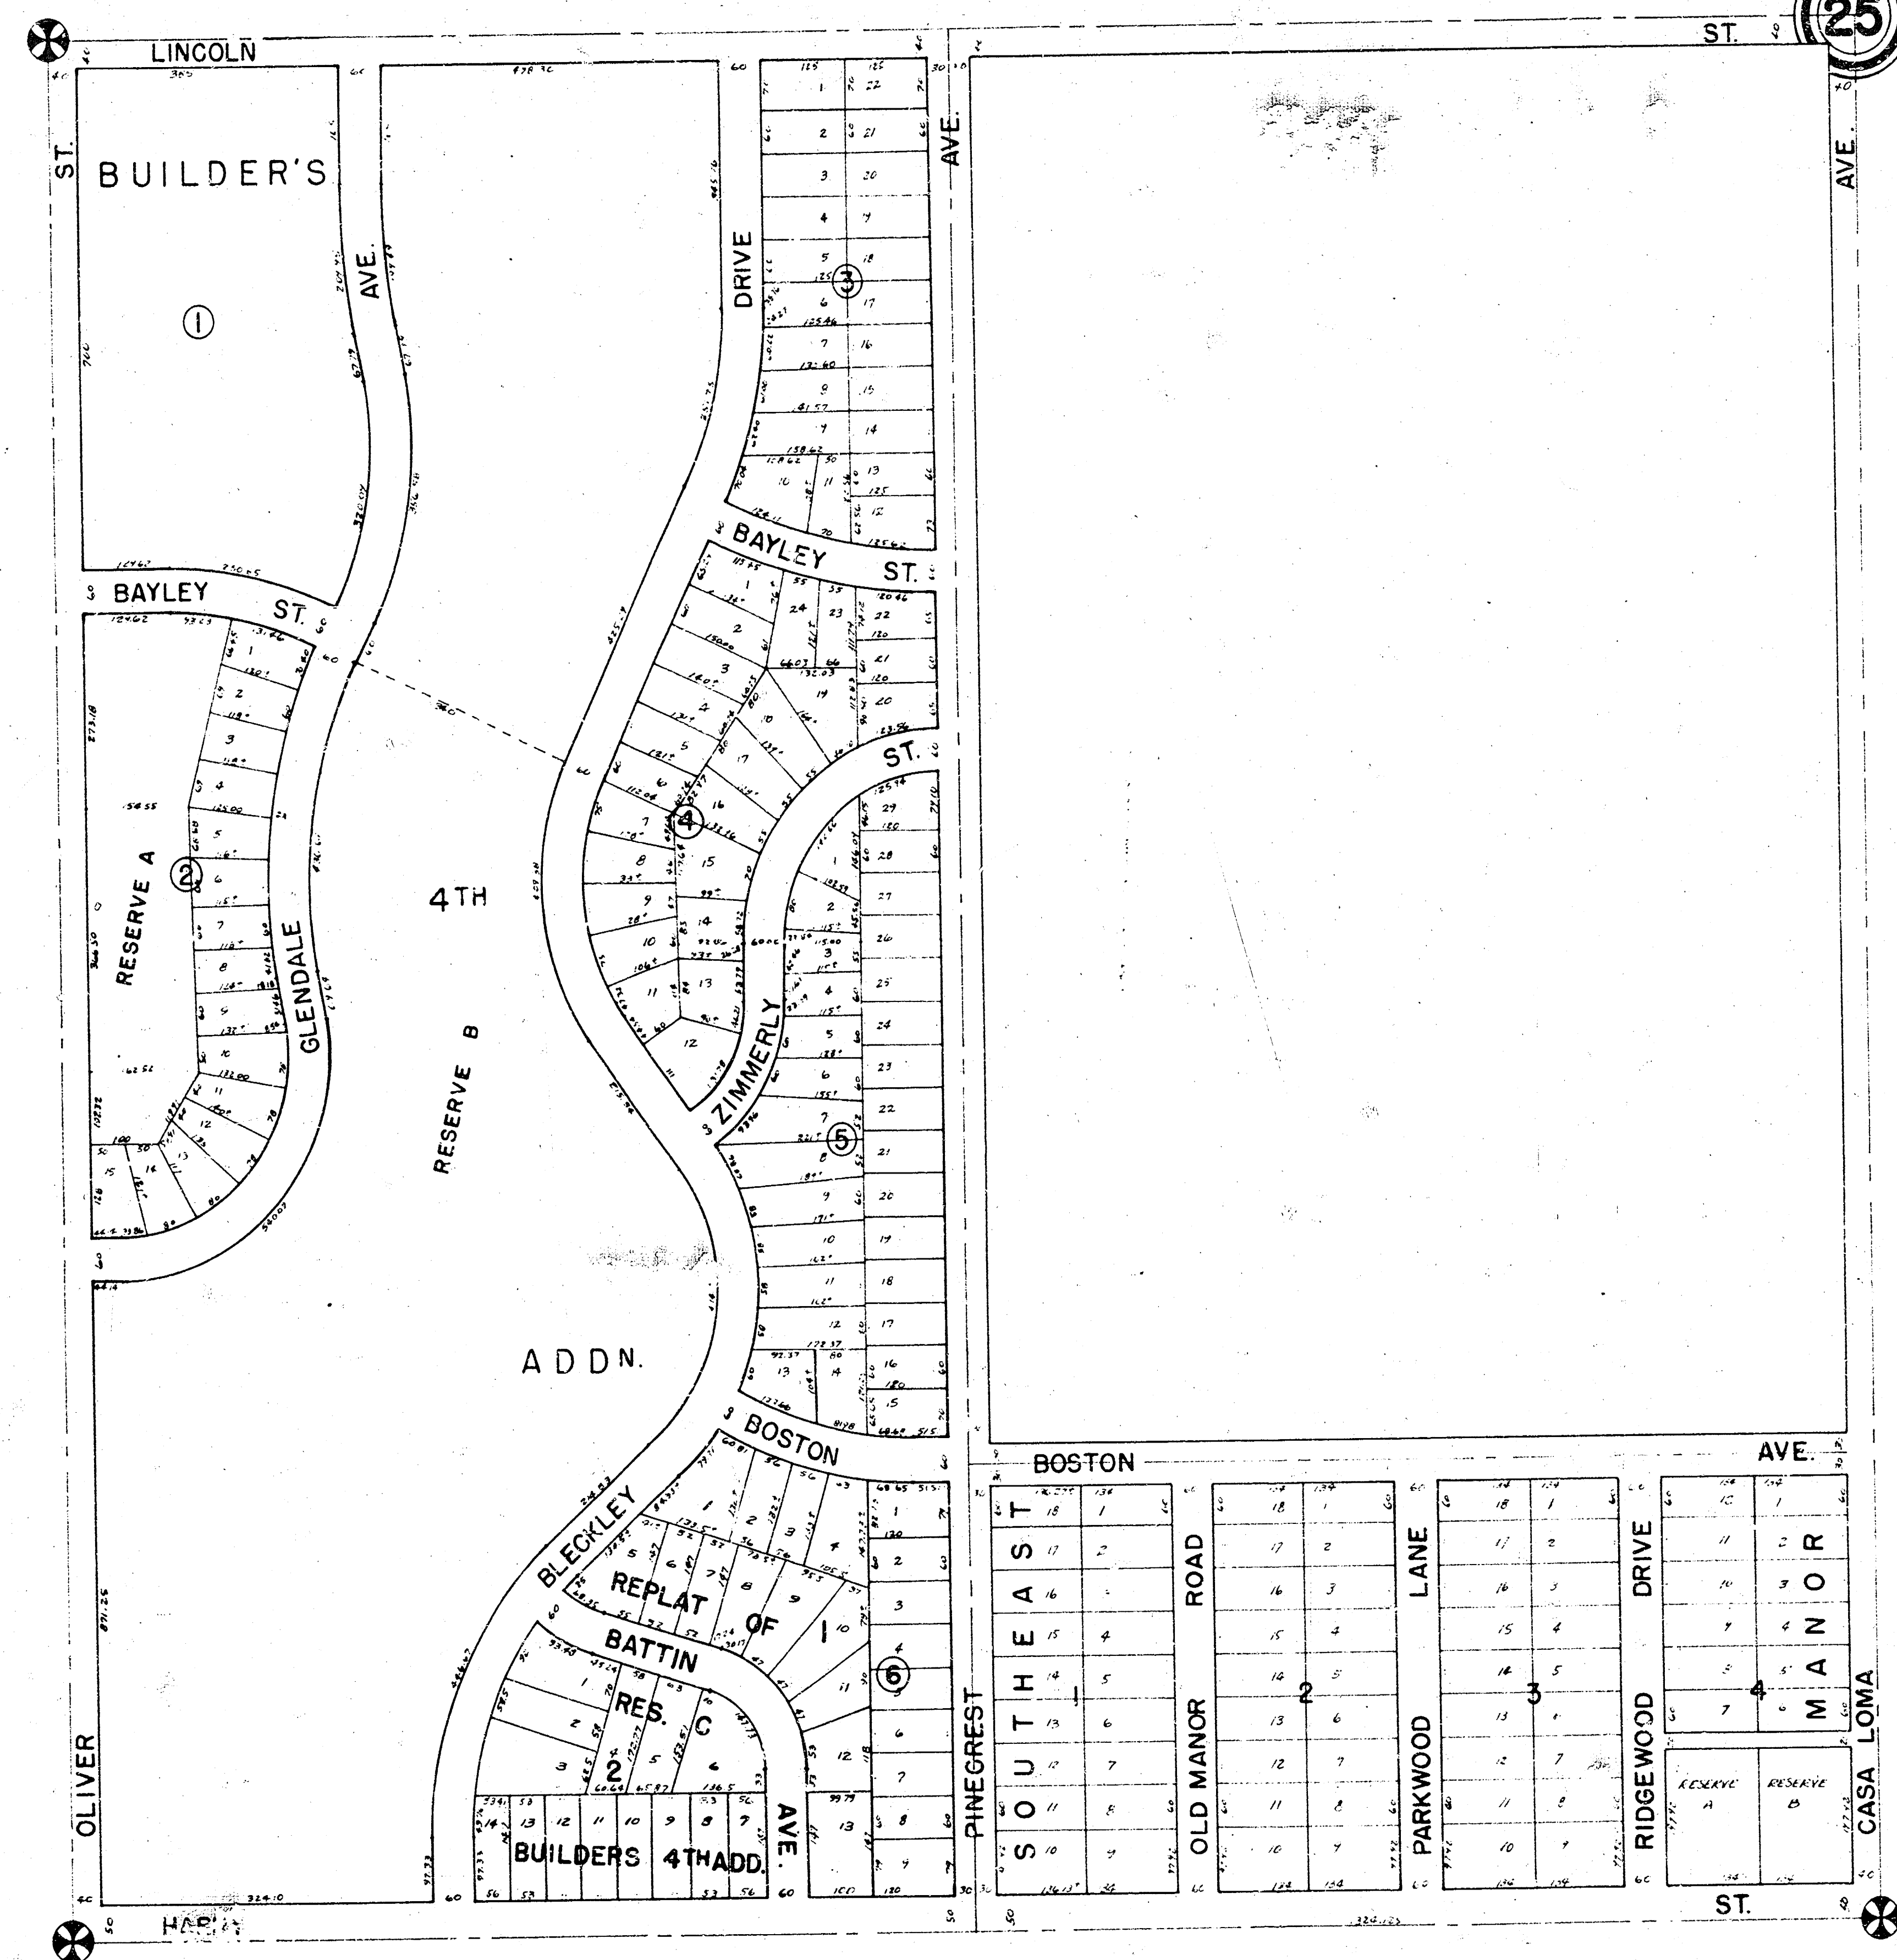

S.E. 1/4 SEC. 25 TWP. 27S. R.1E.

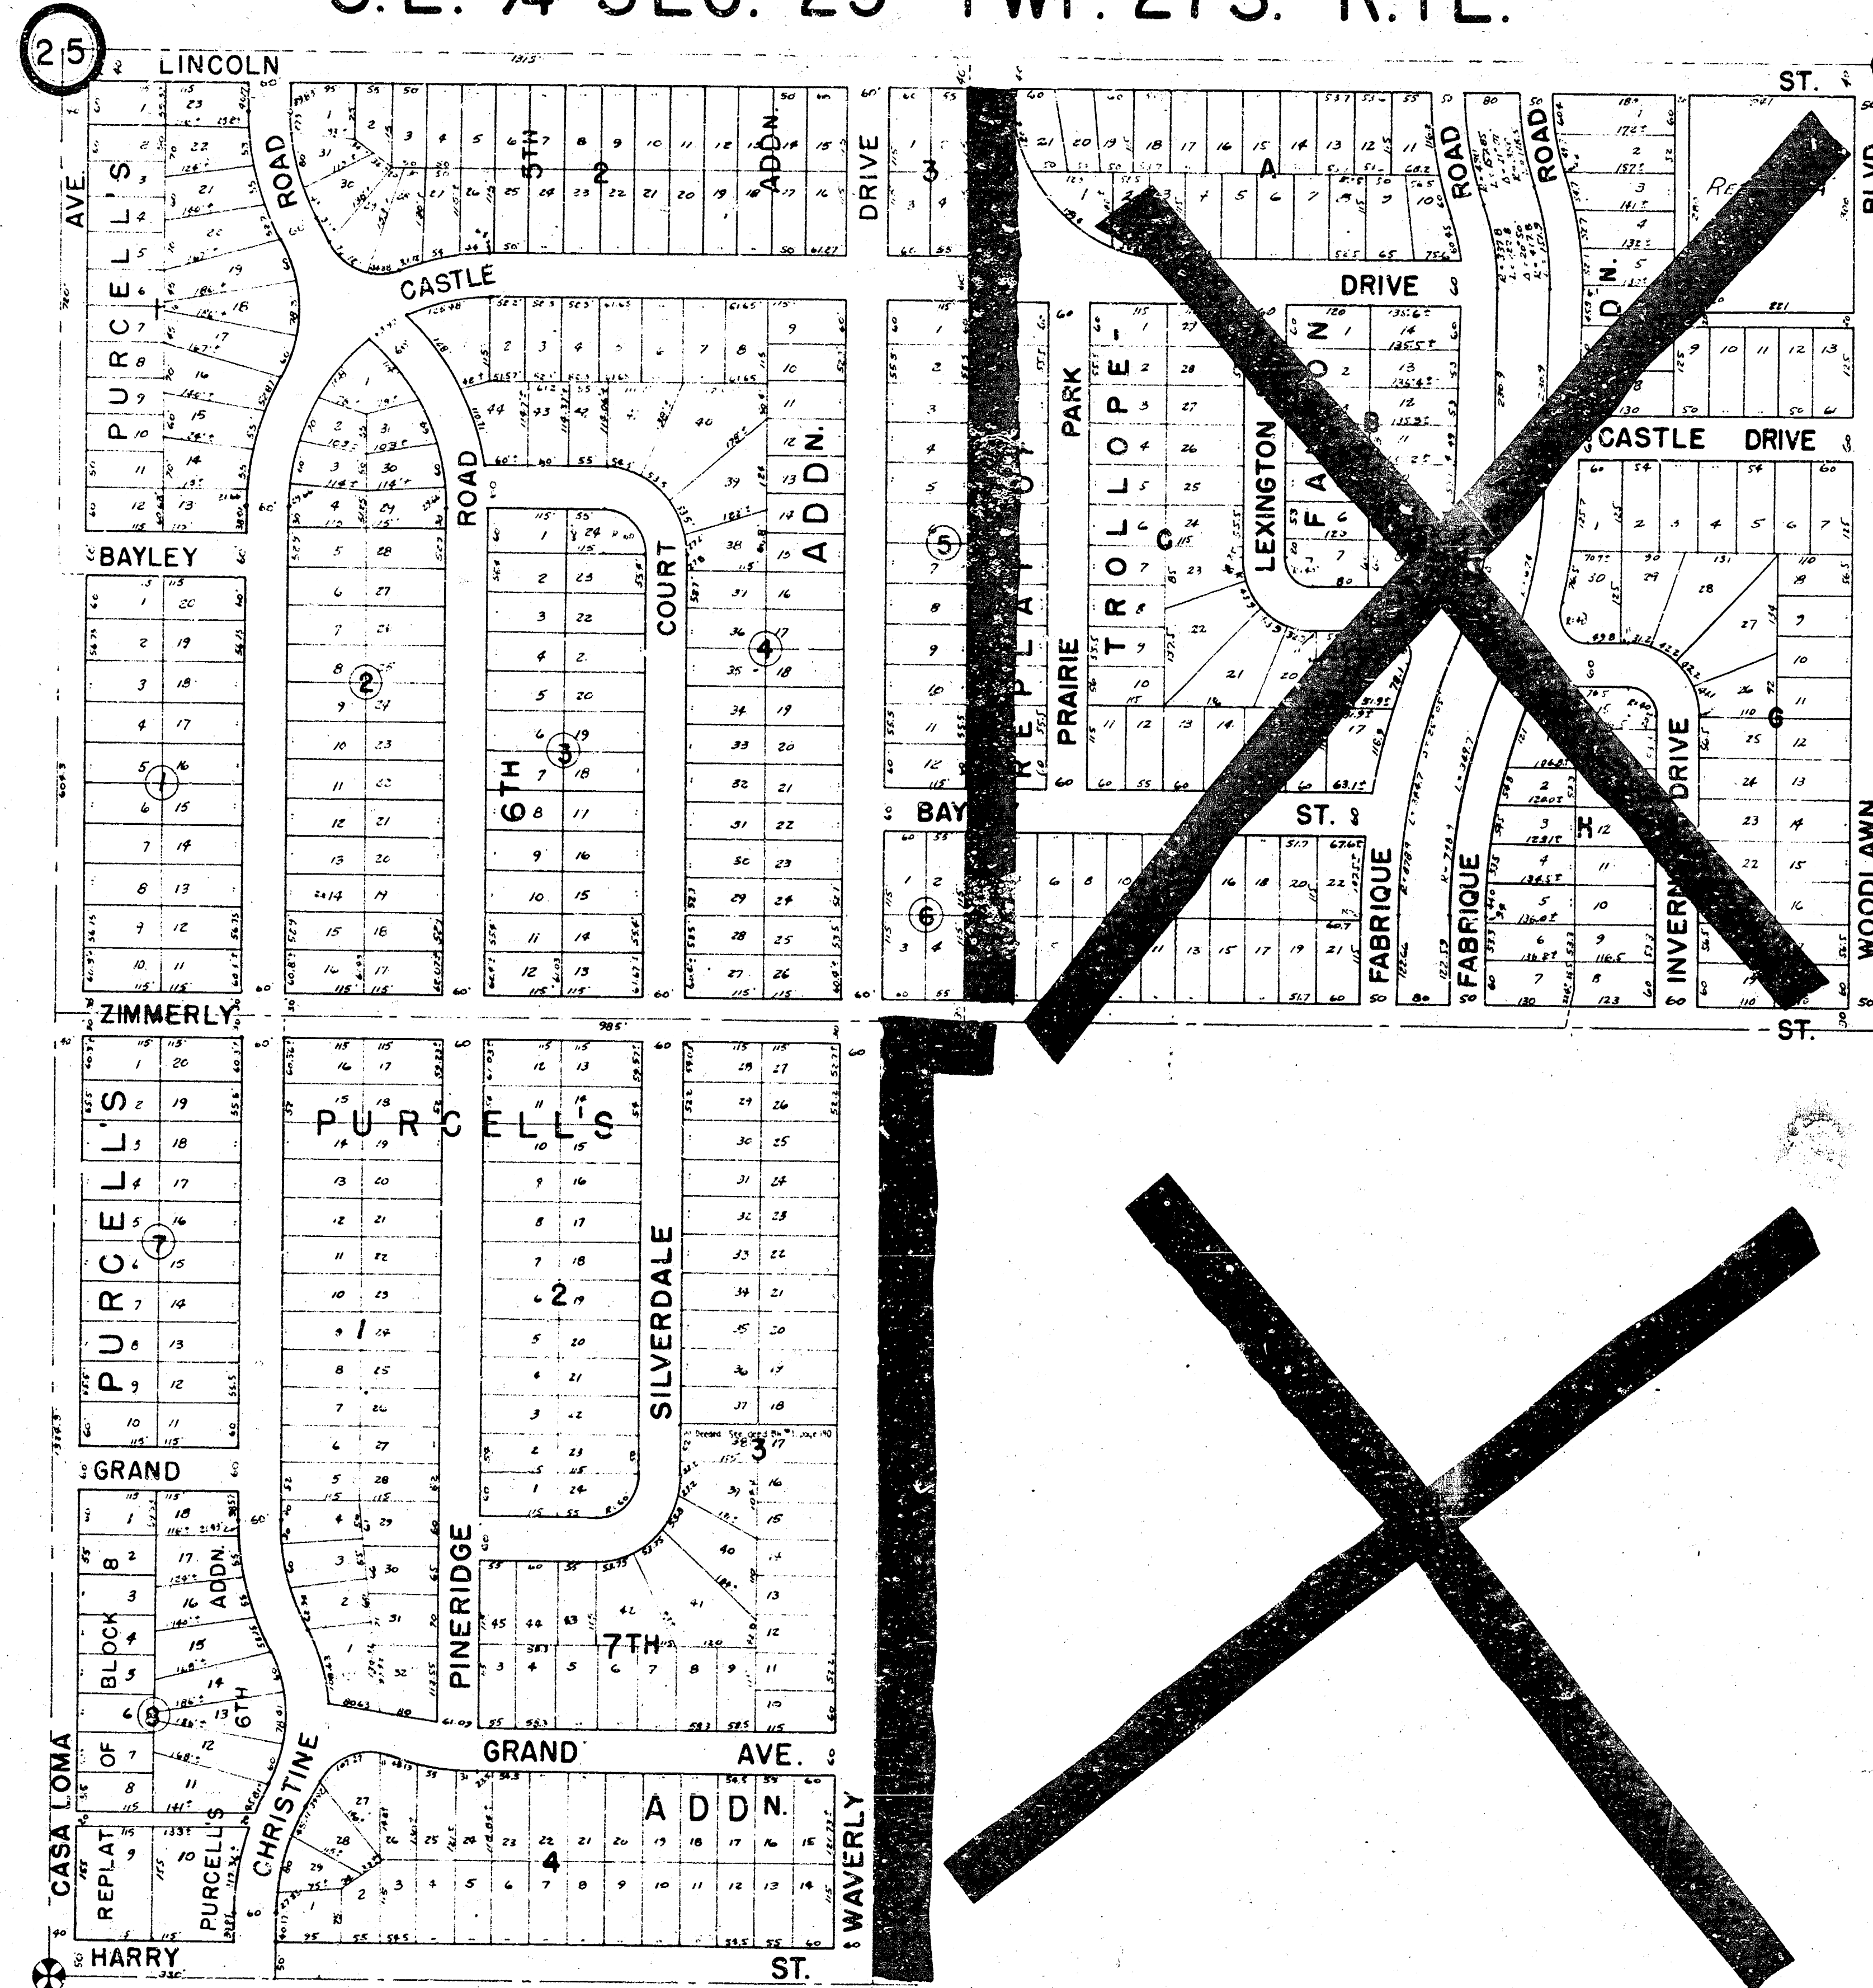

N.E. $\frac{1}{4}$ SEC. 35 TWP. 27 S. R. 1 E.

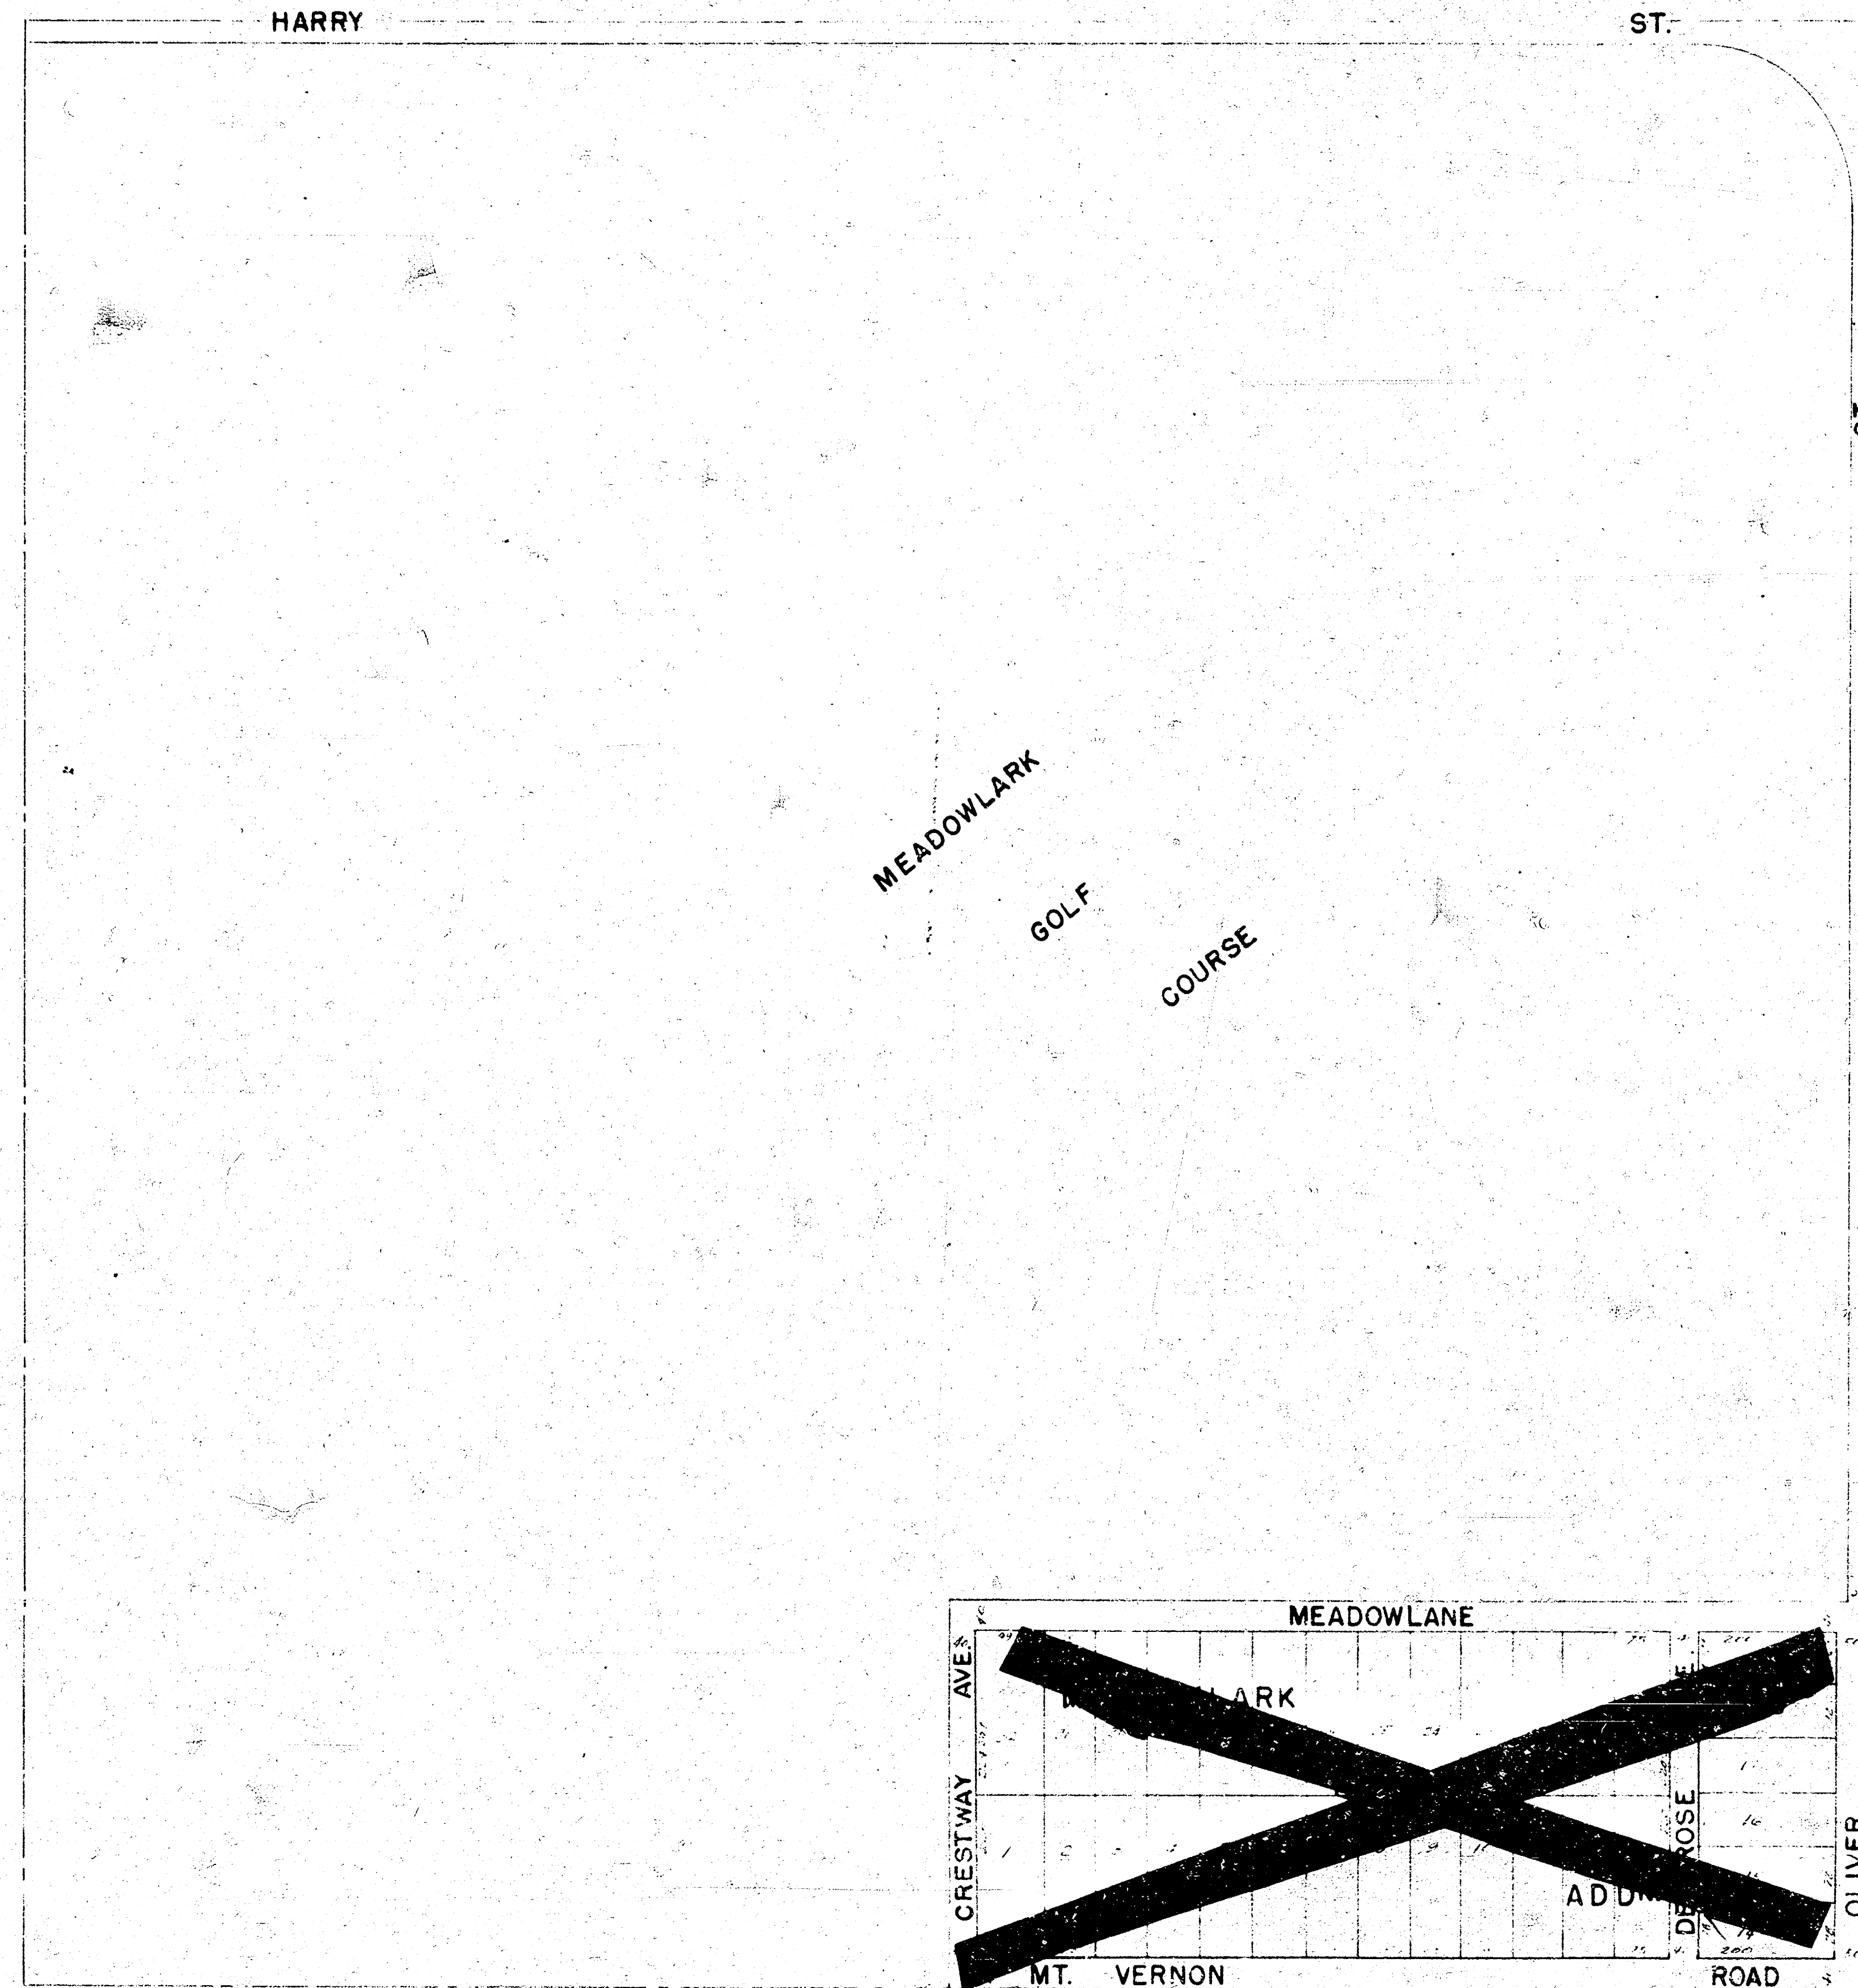

N.W. 1/4 SEC. 36 TWP. 27S. R.1E.

