

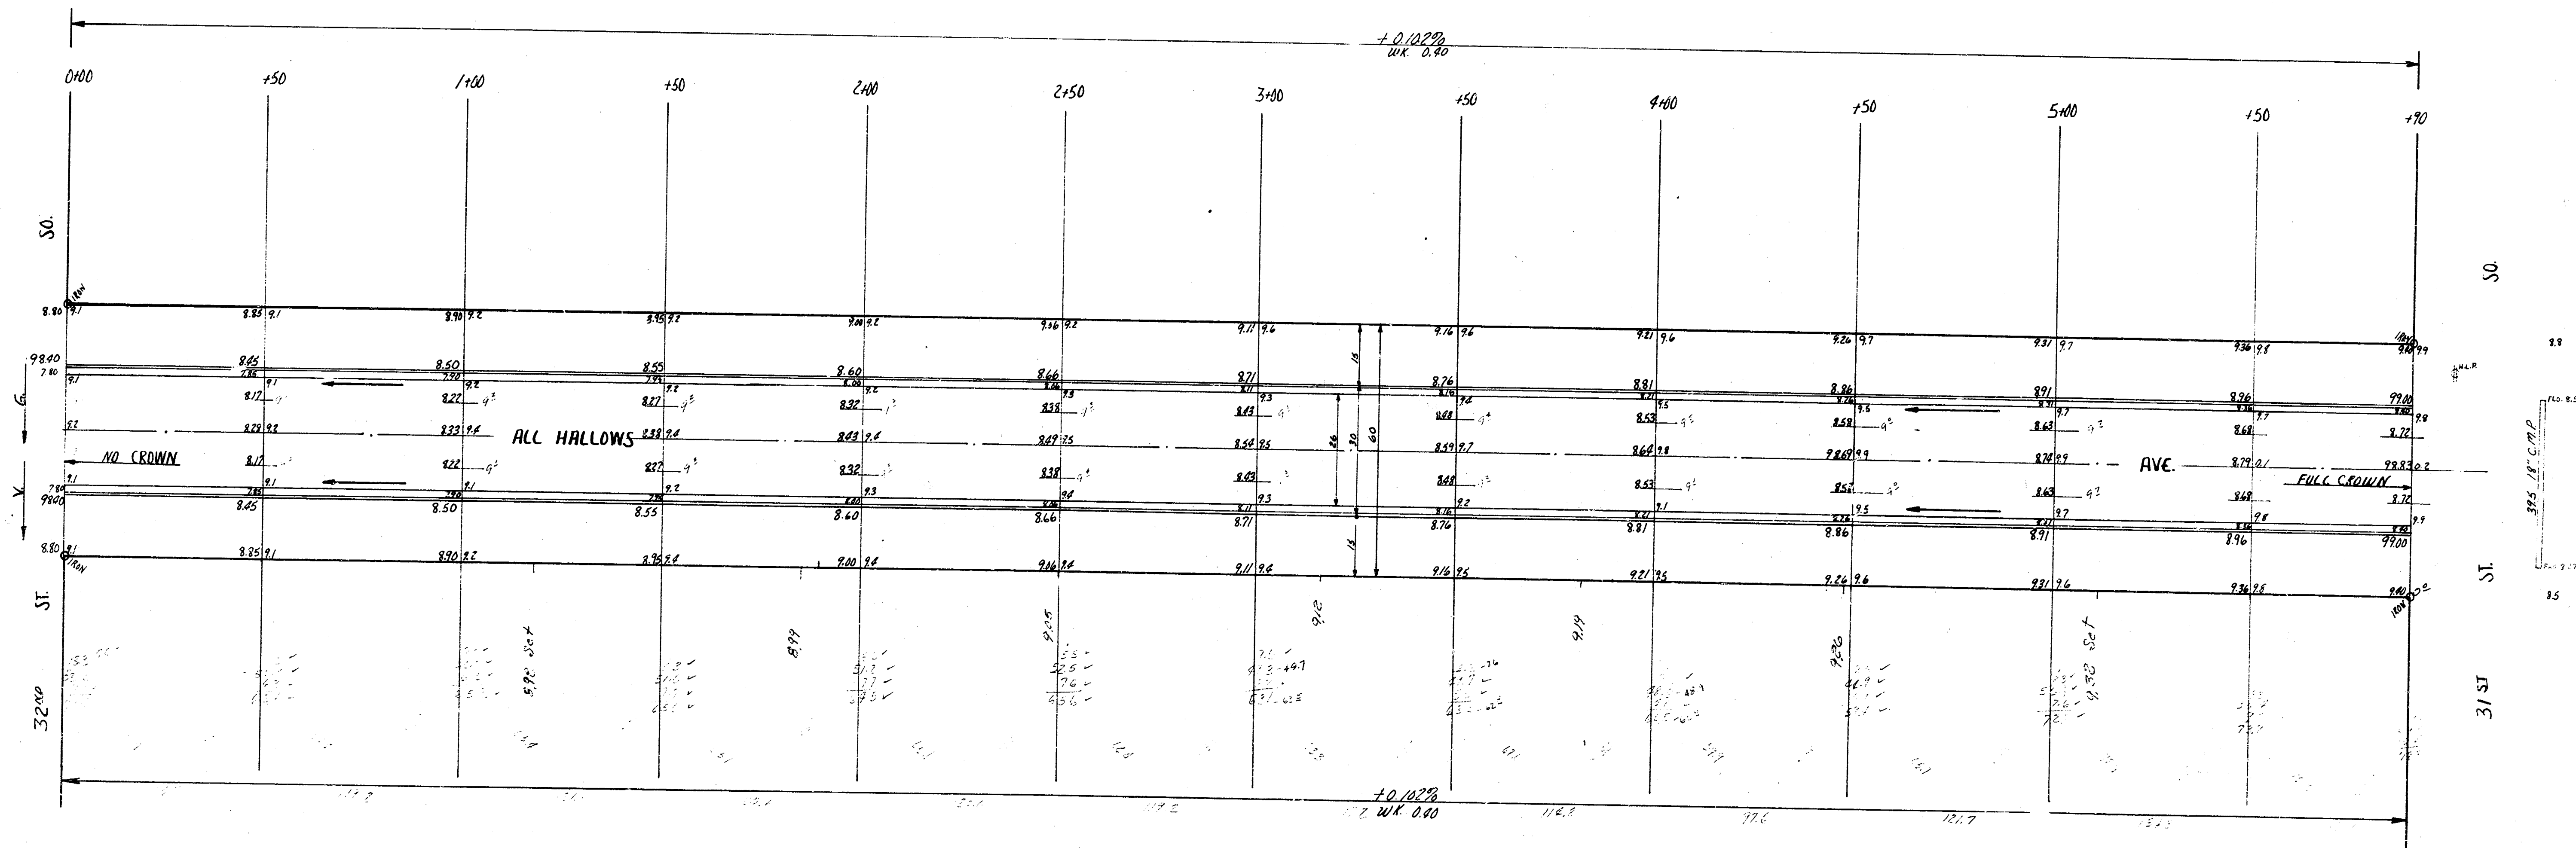


BM 10023 RR SPIKE S.S. TP. S.W. COR. GOW & 31ST ST. SO.
 BM 9993 STANDARD S.E. COR. SHERIDAN & 31ST ST. SO.
 BASE LINE ON W. PC.

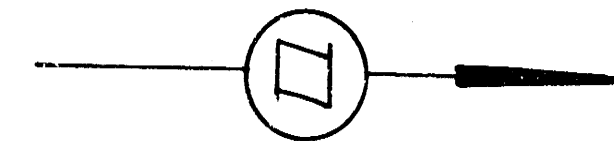

TOTAL EXCAV.
 PROP.

156.4
 124.7
 124.7

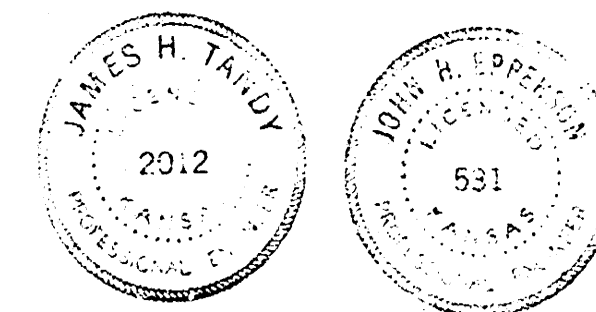

ALL HALLOWS AVE.
 N.C. 32ND ST. SO. — S.E. 31ST ST. SO.
 26-2-30-AC
 CITY OF WICHITA, KANSAS
 B.E. SMITH CITY ENGINEER
 DATE AUG. 1955, PROJ. NO. C-18-62