






FROM PROFILE

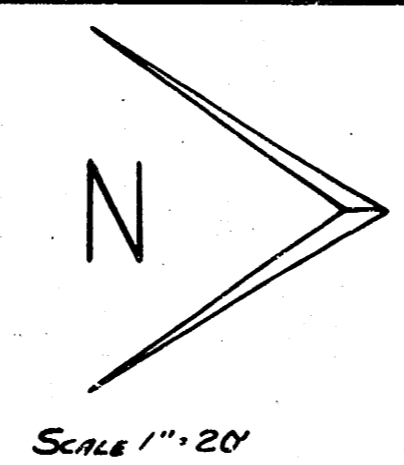

Profile
 20.5
 35.7
 36.1
 41.7
 50.9
 72.3
 123.1
 123.1
 115.7
 115.7
 70.7
 971.7
 +10.0% 112
 980.7 20700 210

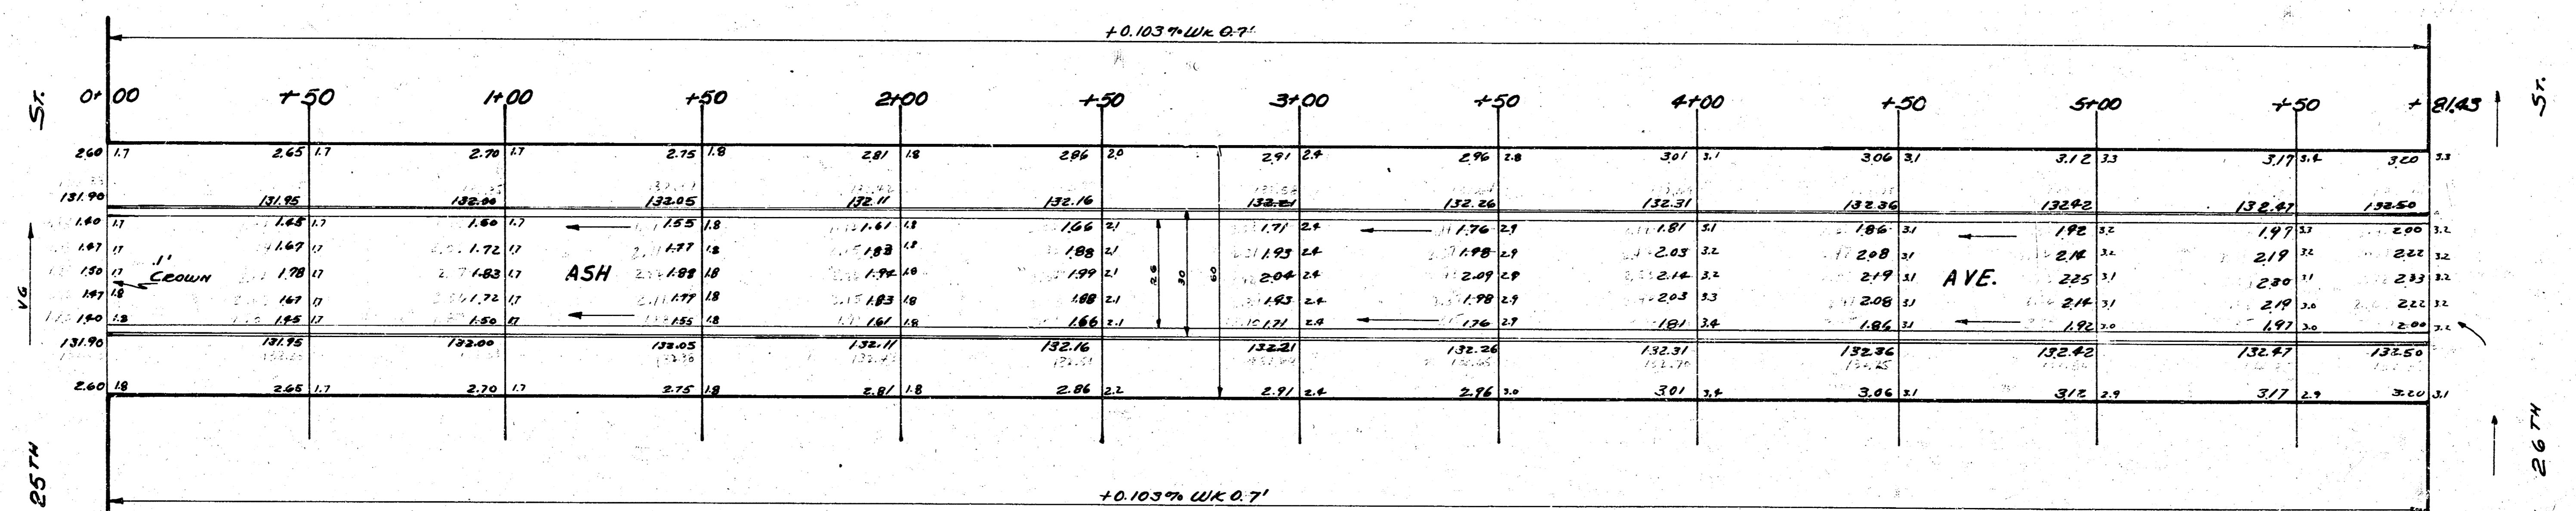

X Section from Balance Plan, Grading, P.L.C. 05, 6-10-58

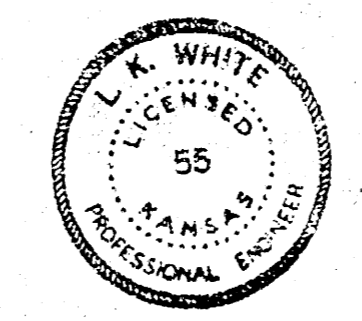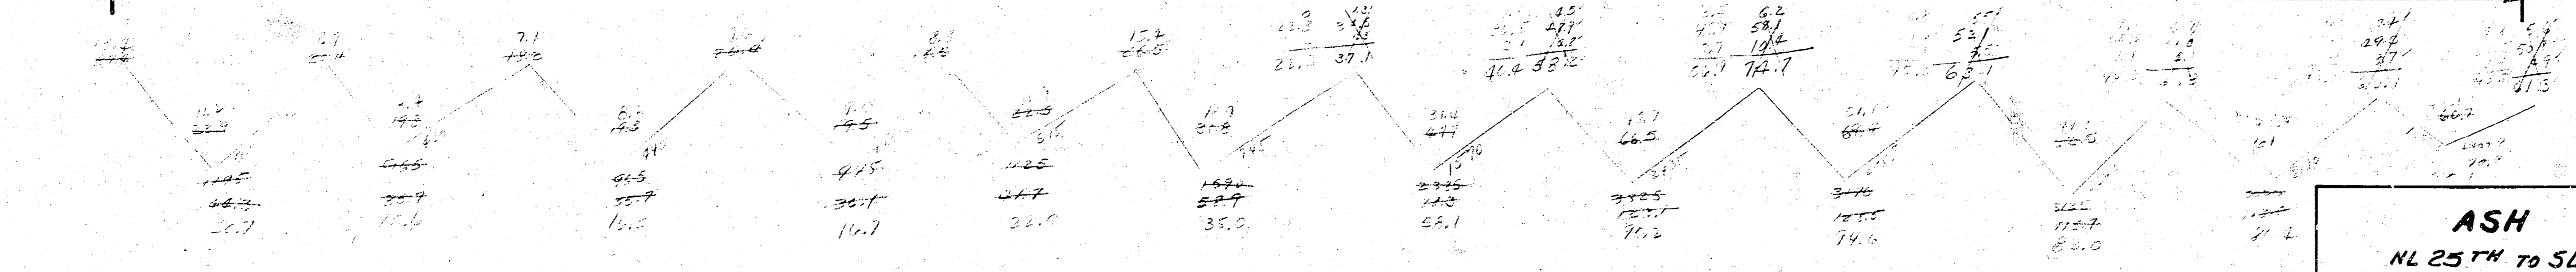

ASH
 NL 25TH TO SL 26TH
 26 - 2-30 A.C.
 CITY OF WICHITA KANSAS
 L.K. WHITE CITY ENGINEER
 JUNE 13 1952 PROJ. NO. CII-336