

N


Pro 8

104.3
86.2
113.9
157.0
204.2
241.3
255.2
251.5
214.3
167.3
122.7
64.6

1382.4

2028

176.

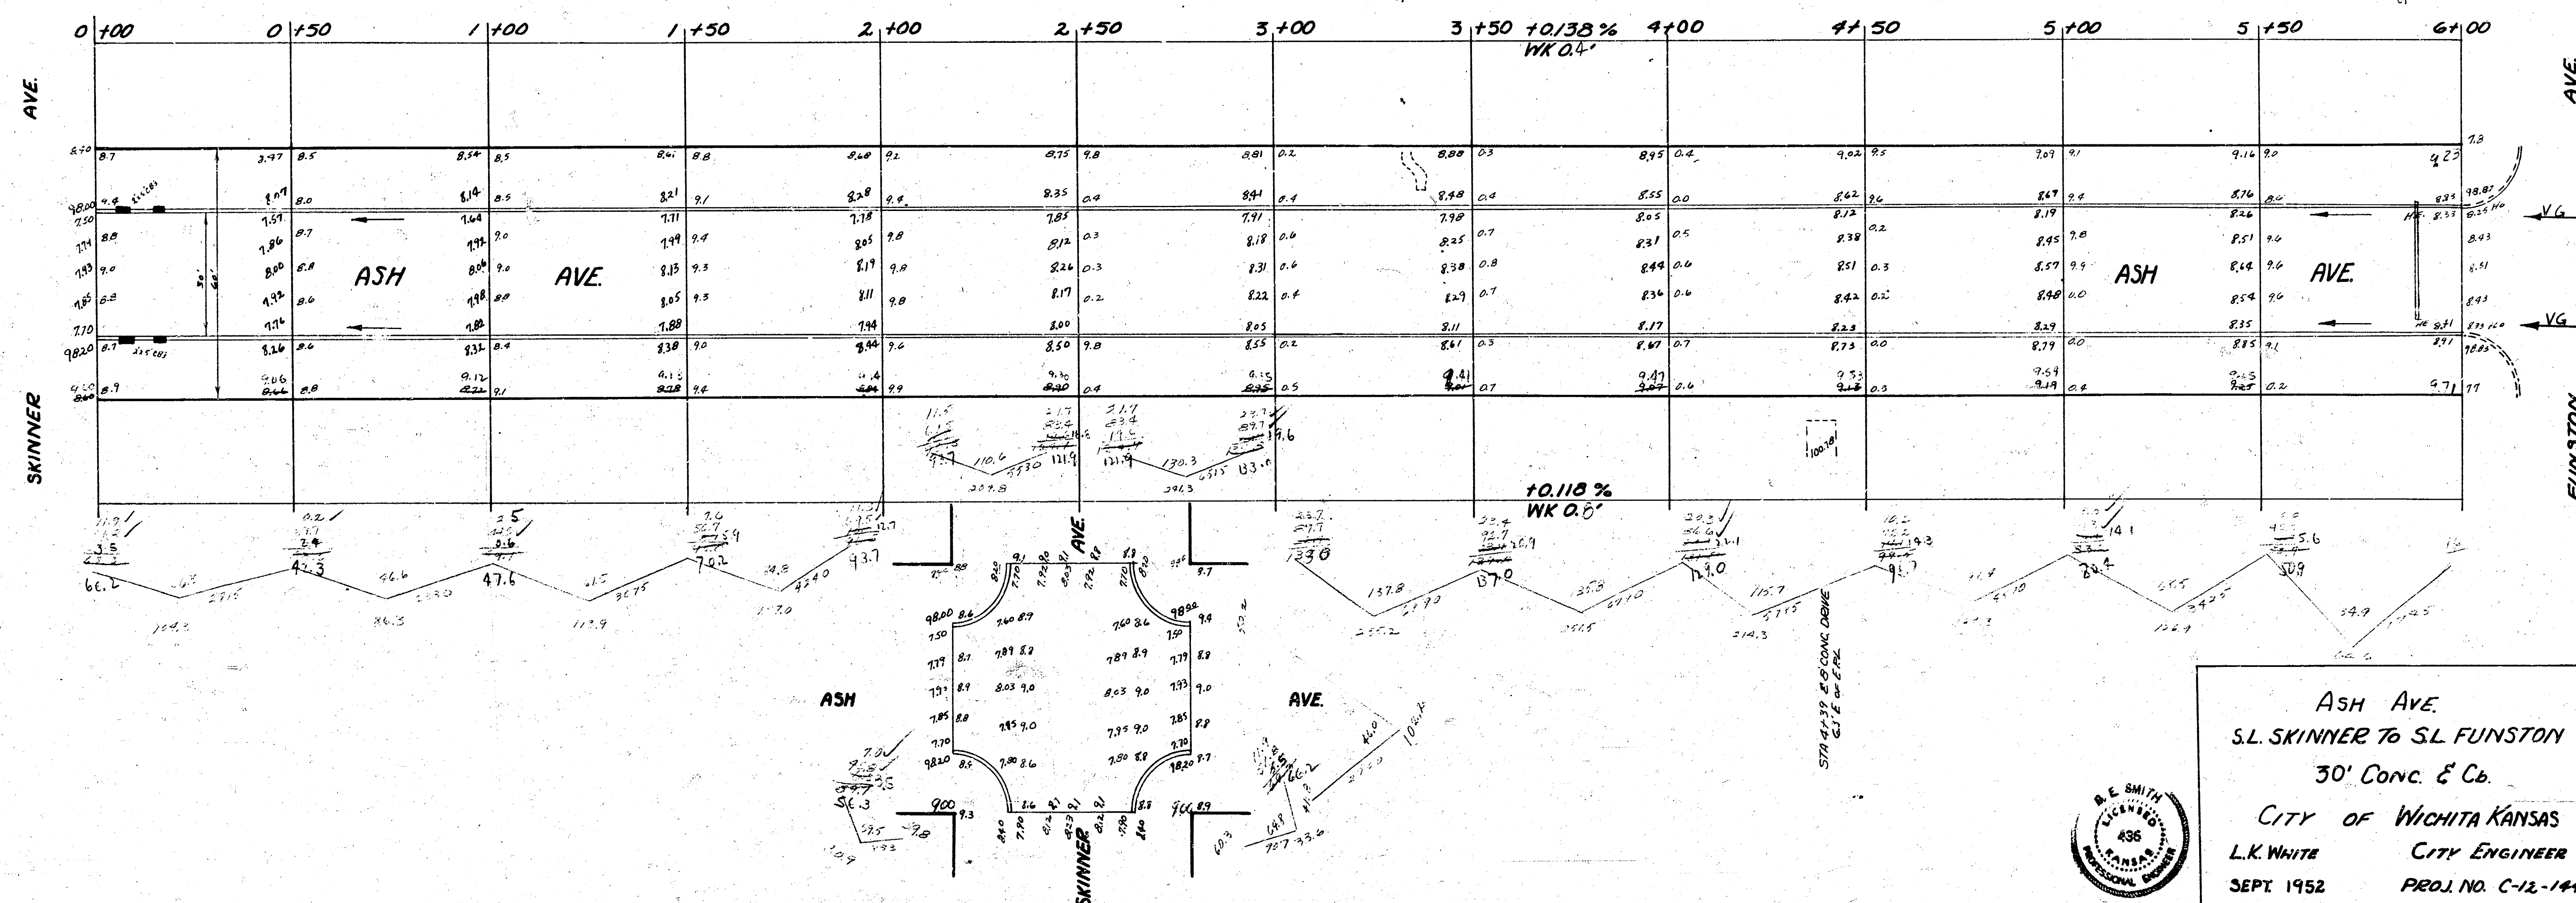

ASH AVE.
S.L. SKINNER TO S.L. FUNSTON
30' CONC. & Cb.
CITY OF WICHITA KANSAS
L.K. WHITE CITY ENGINEER
SEPT 1952 PROJ. NO. C-12-144

