



1942
Ash - S.L. Mesita to N.L. Harry
30' Conc. - Ini. Cb.

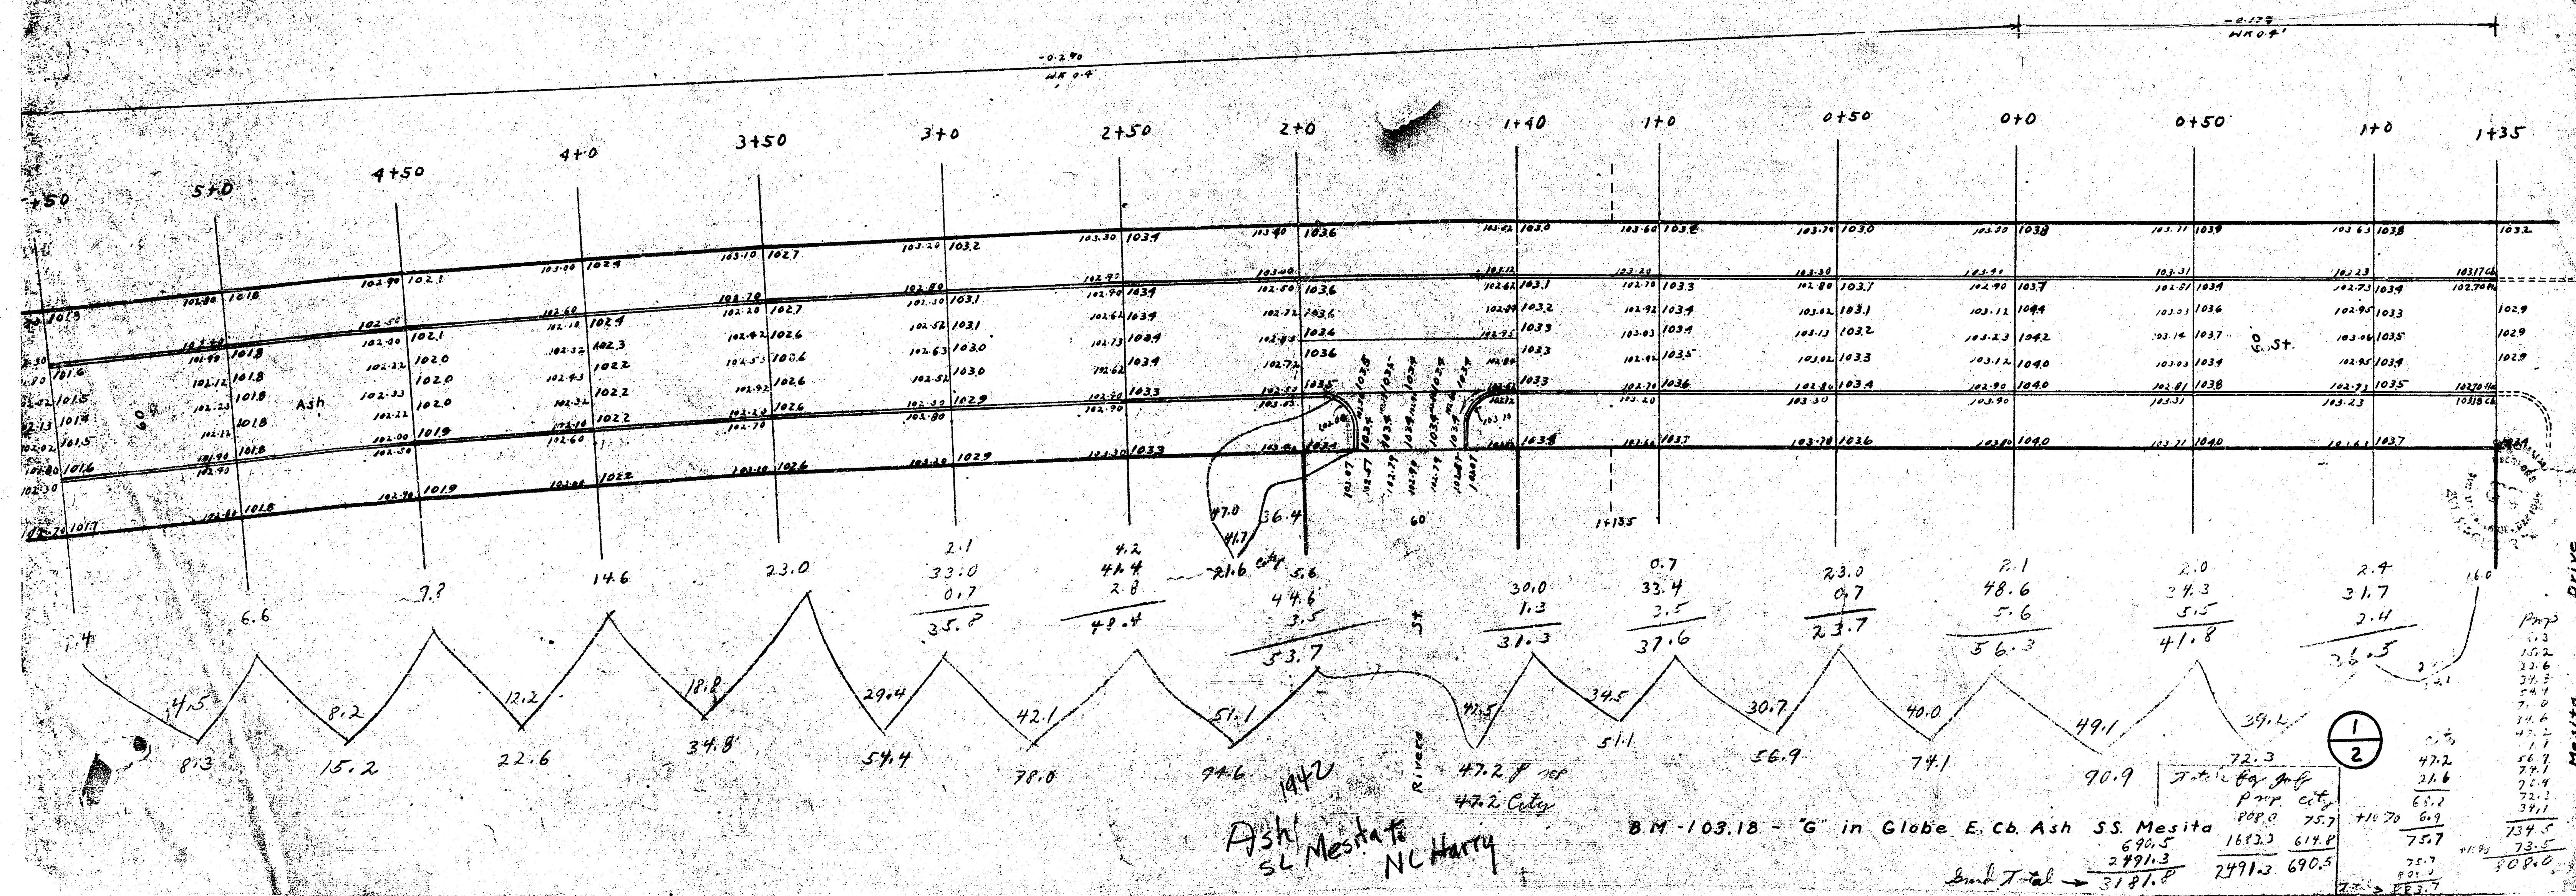

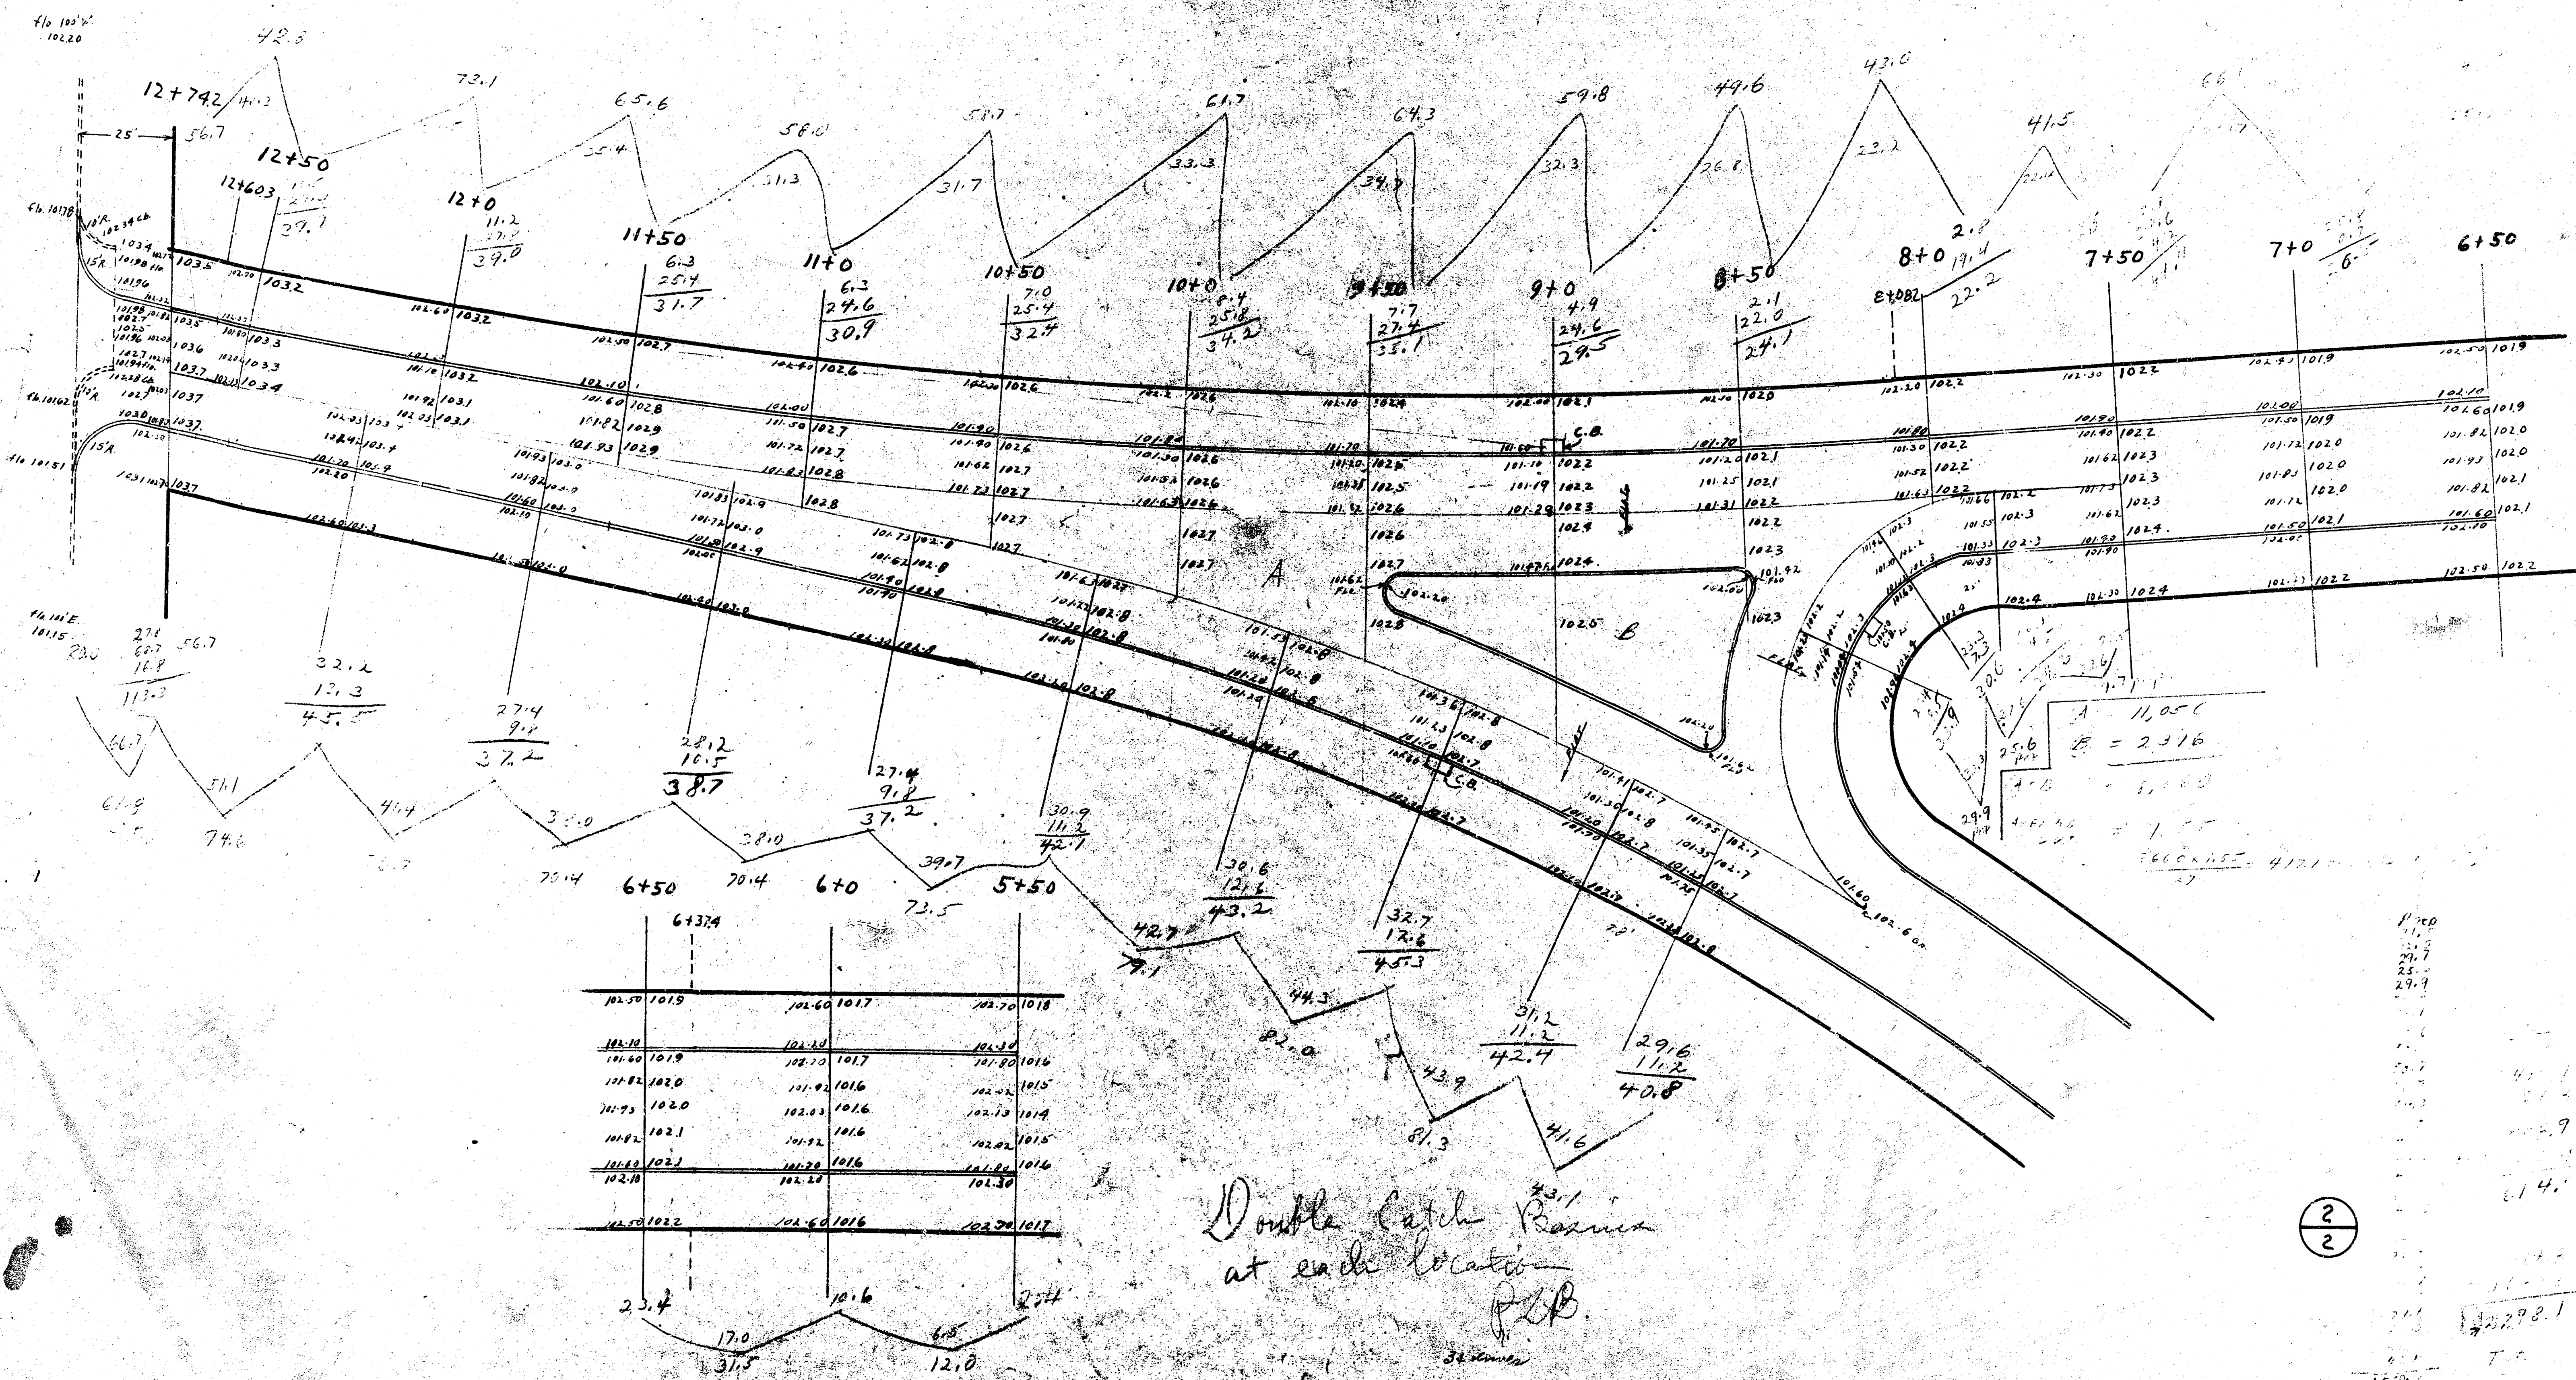

2
2