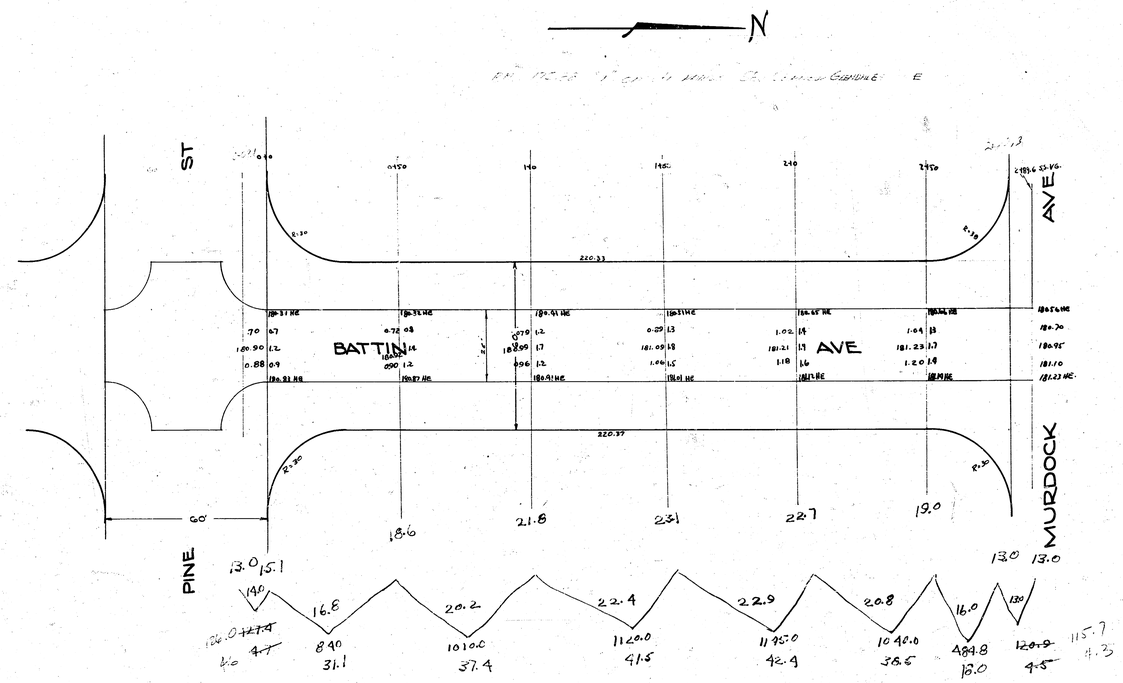

City
4.7
4.5
9.2

Property
31.1
37.4
41.5
42.9
38.5
18.0
Total 208.9

BATTIN AVE.
S.L. PINE to S.L. MURDOCK
26' CONC.
CITY OF WICHITA, KANSAS
L.K. WHITE ~ CITY ENGINEER
APRIL 1947