B.M. 105.08 Iron in thimble E Laura & Bayley
B.M. 105.98 "G" in Globe Top cb E.S. Lulu-N.S. Bayley

AVE.

AVE.

SCALE 1"=20'

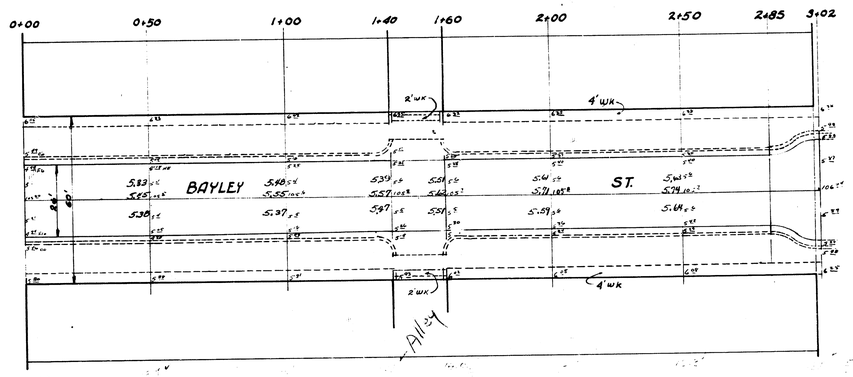

BAYLEY ST.
E. LAURA AVE. TO W. L. PATTIE AVE.
26' Conc.

CITY OF WICHITA, KANSAS.
L.K. WHITE CITY ENGINEER
OCT. 1951 PROJ. NO. C-11-152

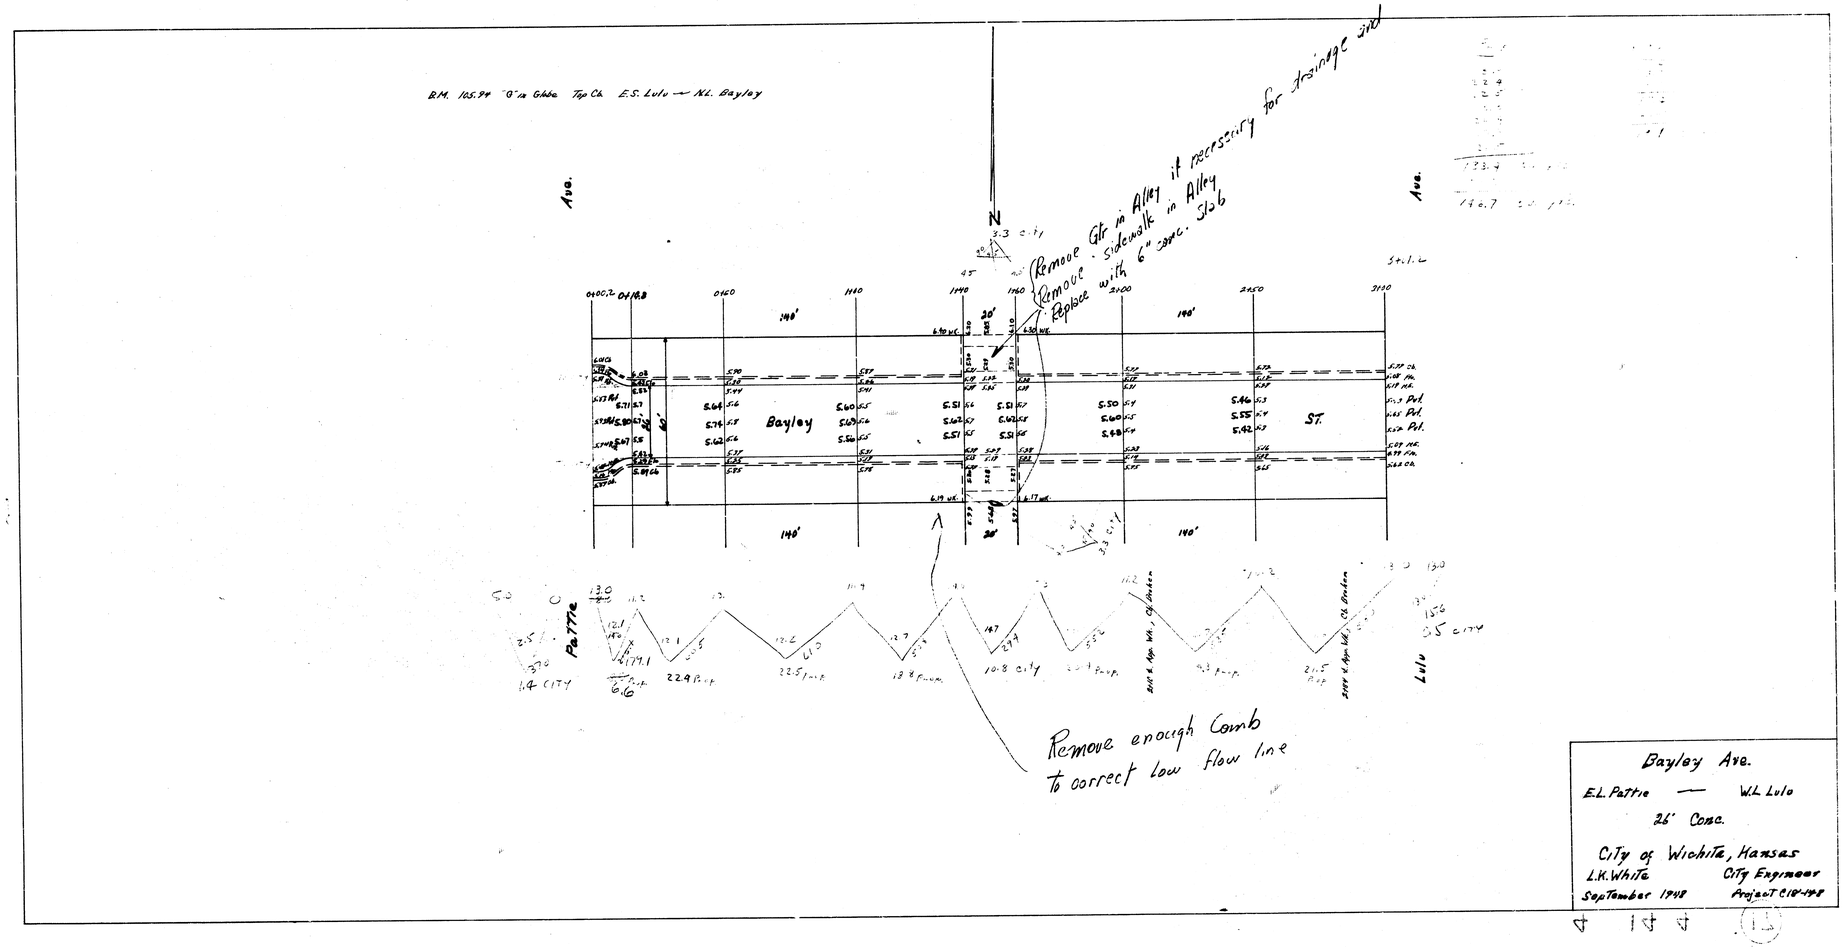
B.M. 105.94 "G" in Globe Top Ch. E.S. Lulu — N.L. Bayley
Ave.
Ave.
N
Remove Gtr in Alley if necessary for drainage and
Remove sidewalk in Alley
Replace with 6" conc. Slab
Bayley
ST.
Pattie
Lulu
Remove enough Comb
to correct low flow line
Bayley Ave.
E.L. Pattie — W.L. Lulu
26' Conc.
City of Wichita, Kansas
L.K. White
City Engineer
September 1948
Project C18-148