


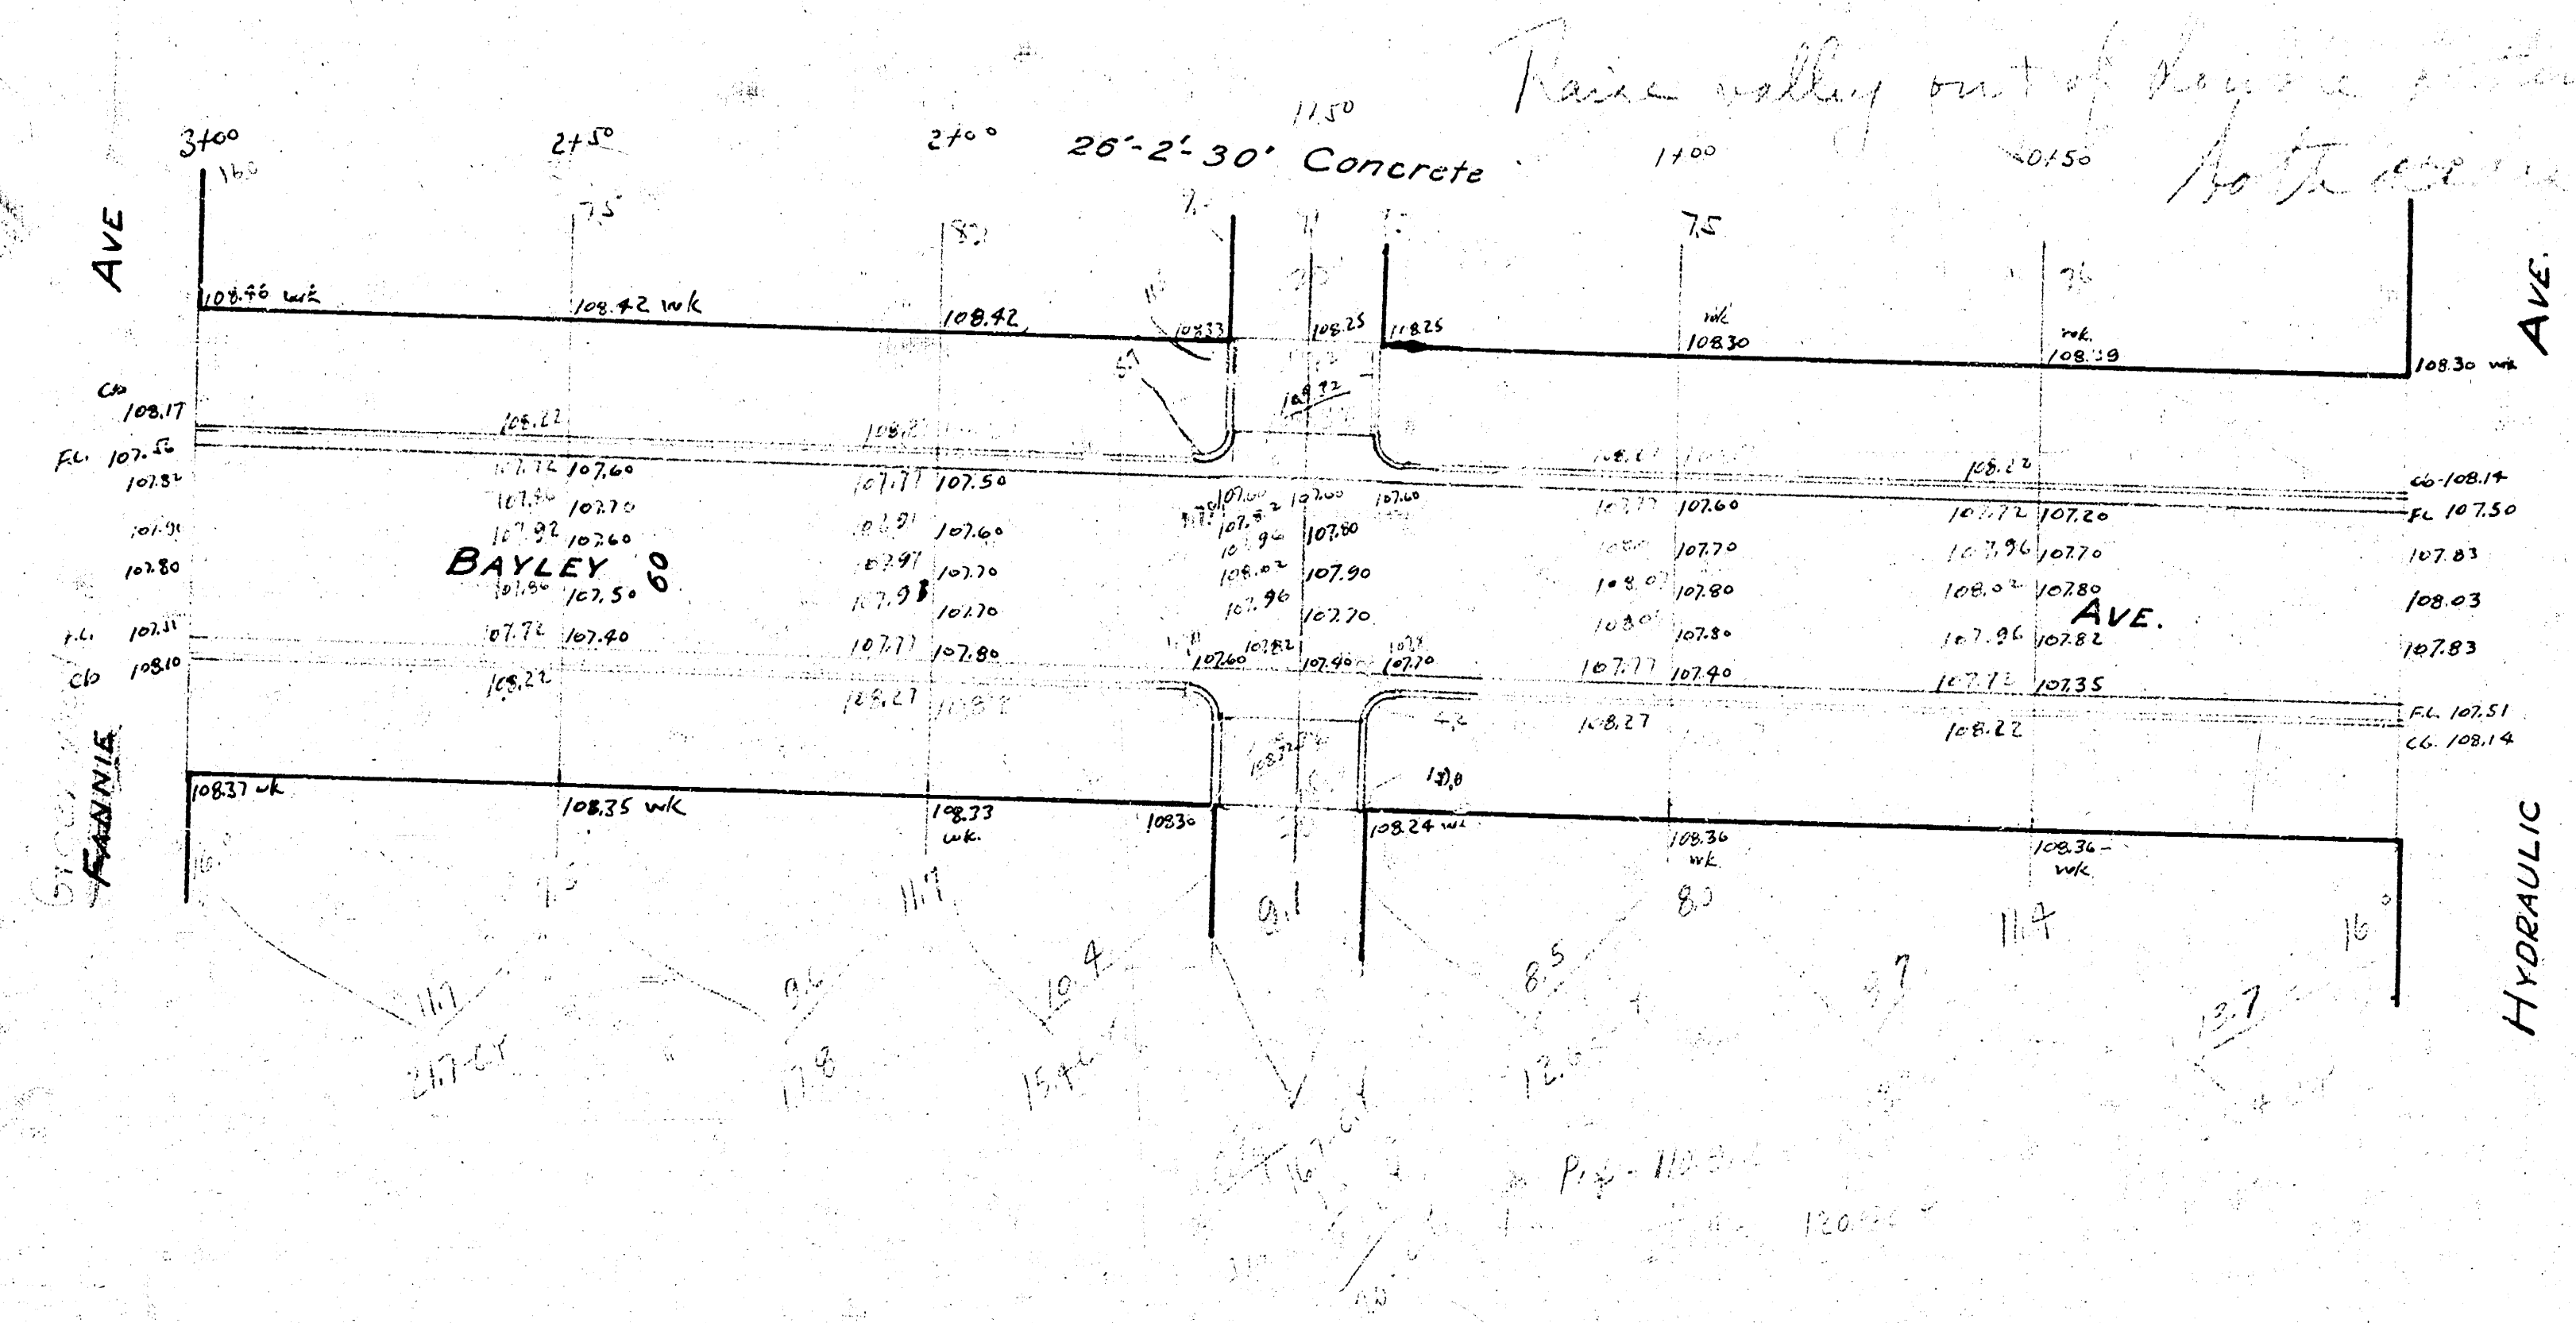

Design Plan
Bayley
L.P.
W.L. Hydraulic