


B.M. 153.00 S.W. COR. CONC. PORCH HO. # 858 So. LEAVOLA

NOTE: STATIONING IS ON S.P.L.

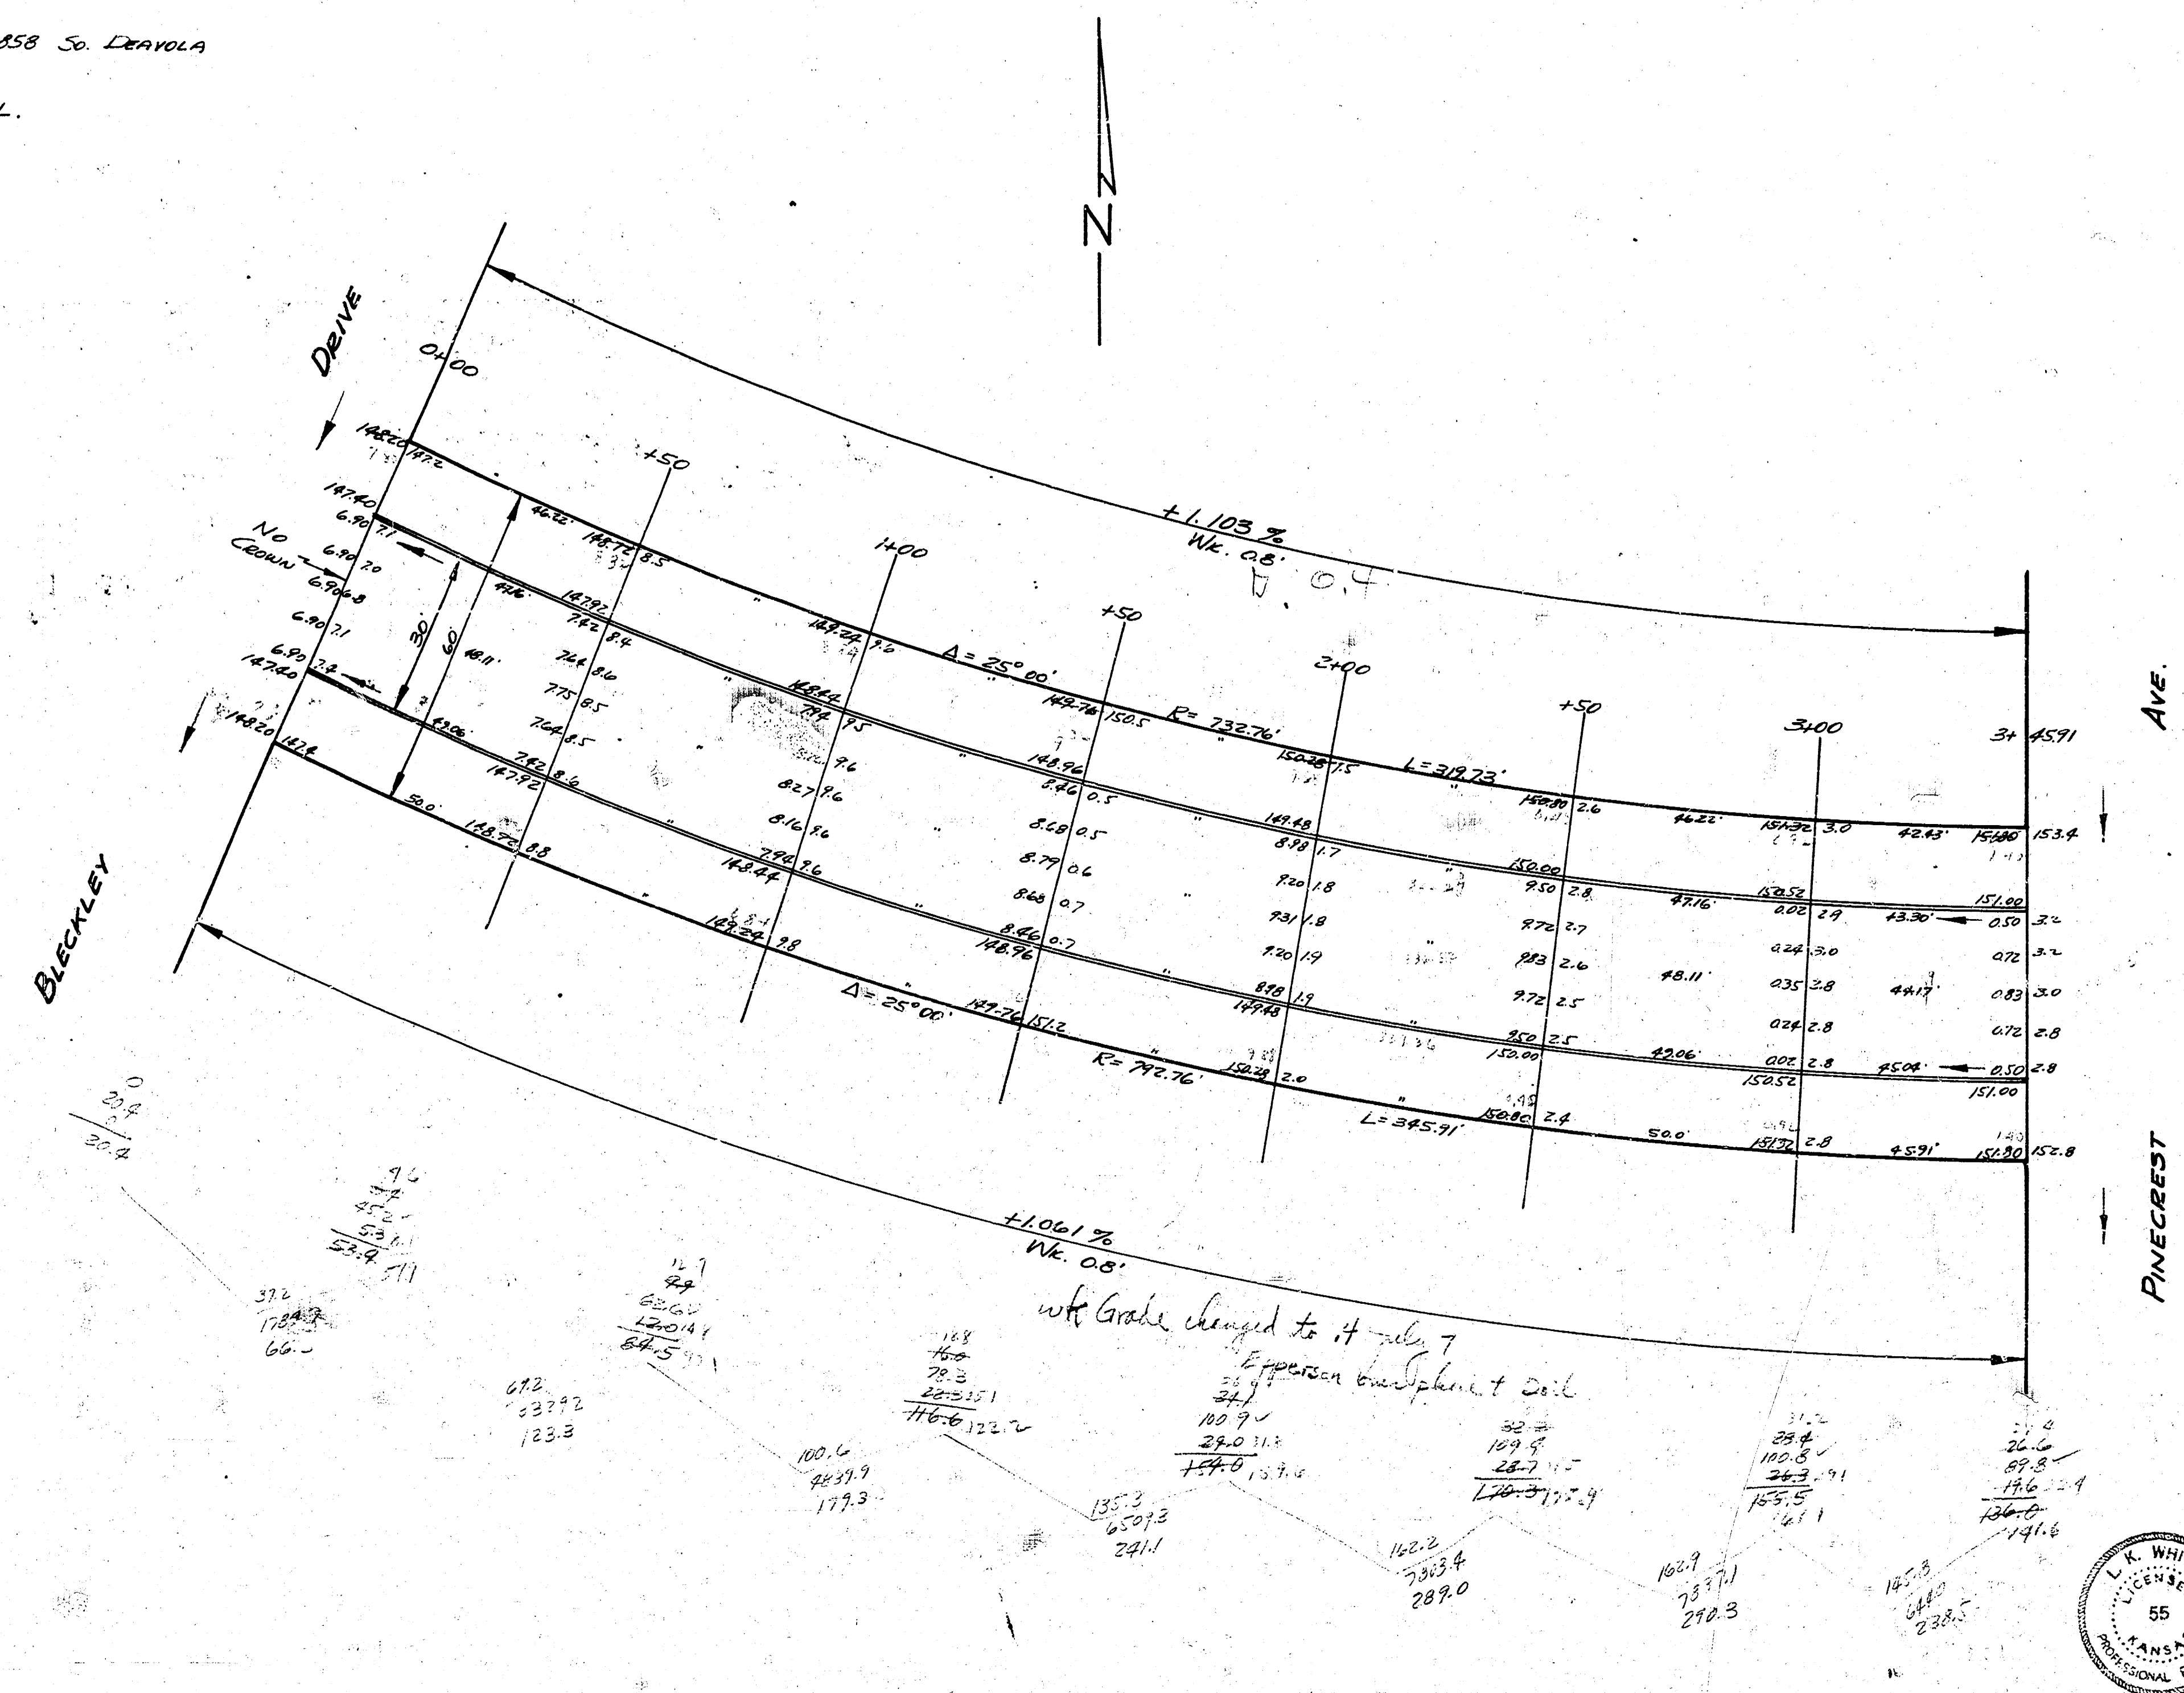

BAYLEY ST.
W.L. PINECREST TO E.L. BLECKLEY
30' CONC. & CO.
CITY OF WICHITA, KANSAS
L. K. WHITE CITY ENGINEER
SEPT. 1951 PROJ. C-11-54