



B.M. 155.91 "R" in Ritchie E.L. Capri S. Co. Bayley

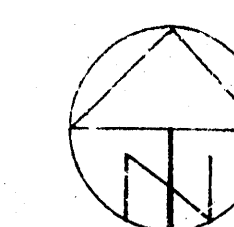

Private Job	
Units	Quantities
S.Y.	Pavement 755
L.F.	Crumb Out Gr. 520
Lbs.	Rein. Steel 2125
CY	Excavation 320
CY	Comp. Fill 15

Final Quantities	
Units	Quantities
S.Y.	Pavement 751.4
L.F.	Crumb Out Gr. 510.2
Lbs.	Rein. Steel 2035
CY	Excav. 320.4
CY	Comp. Fill 10.6

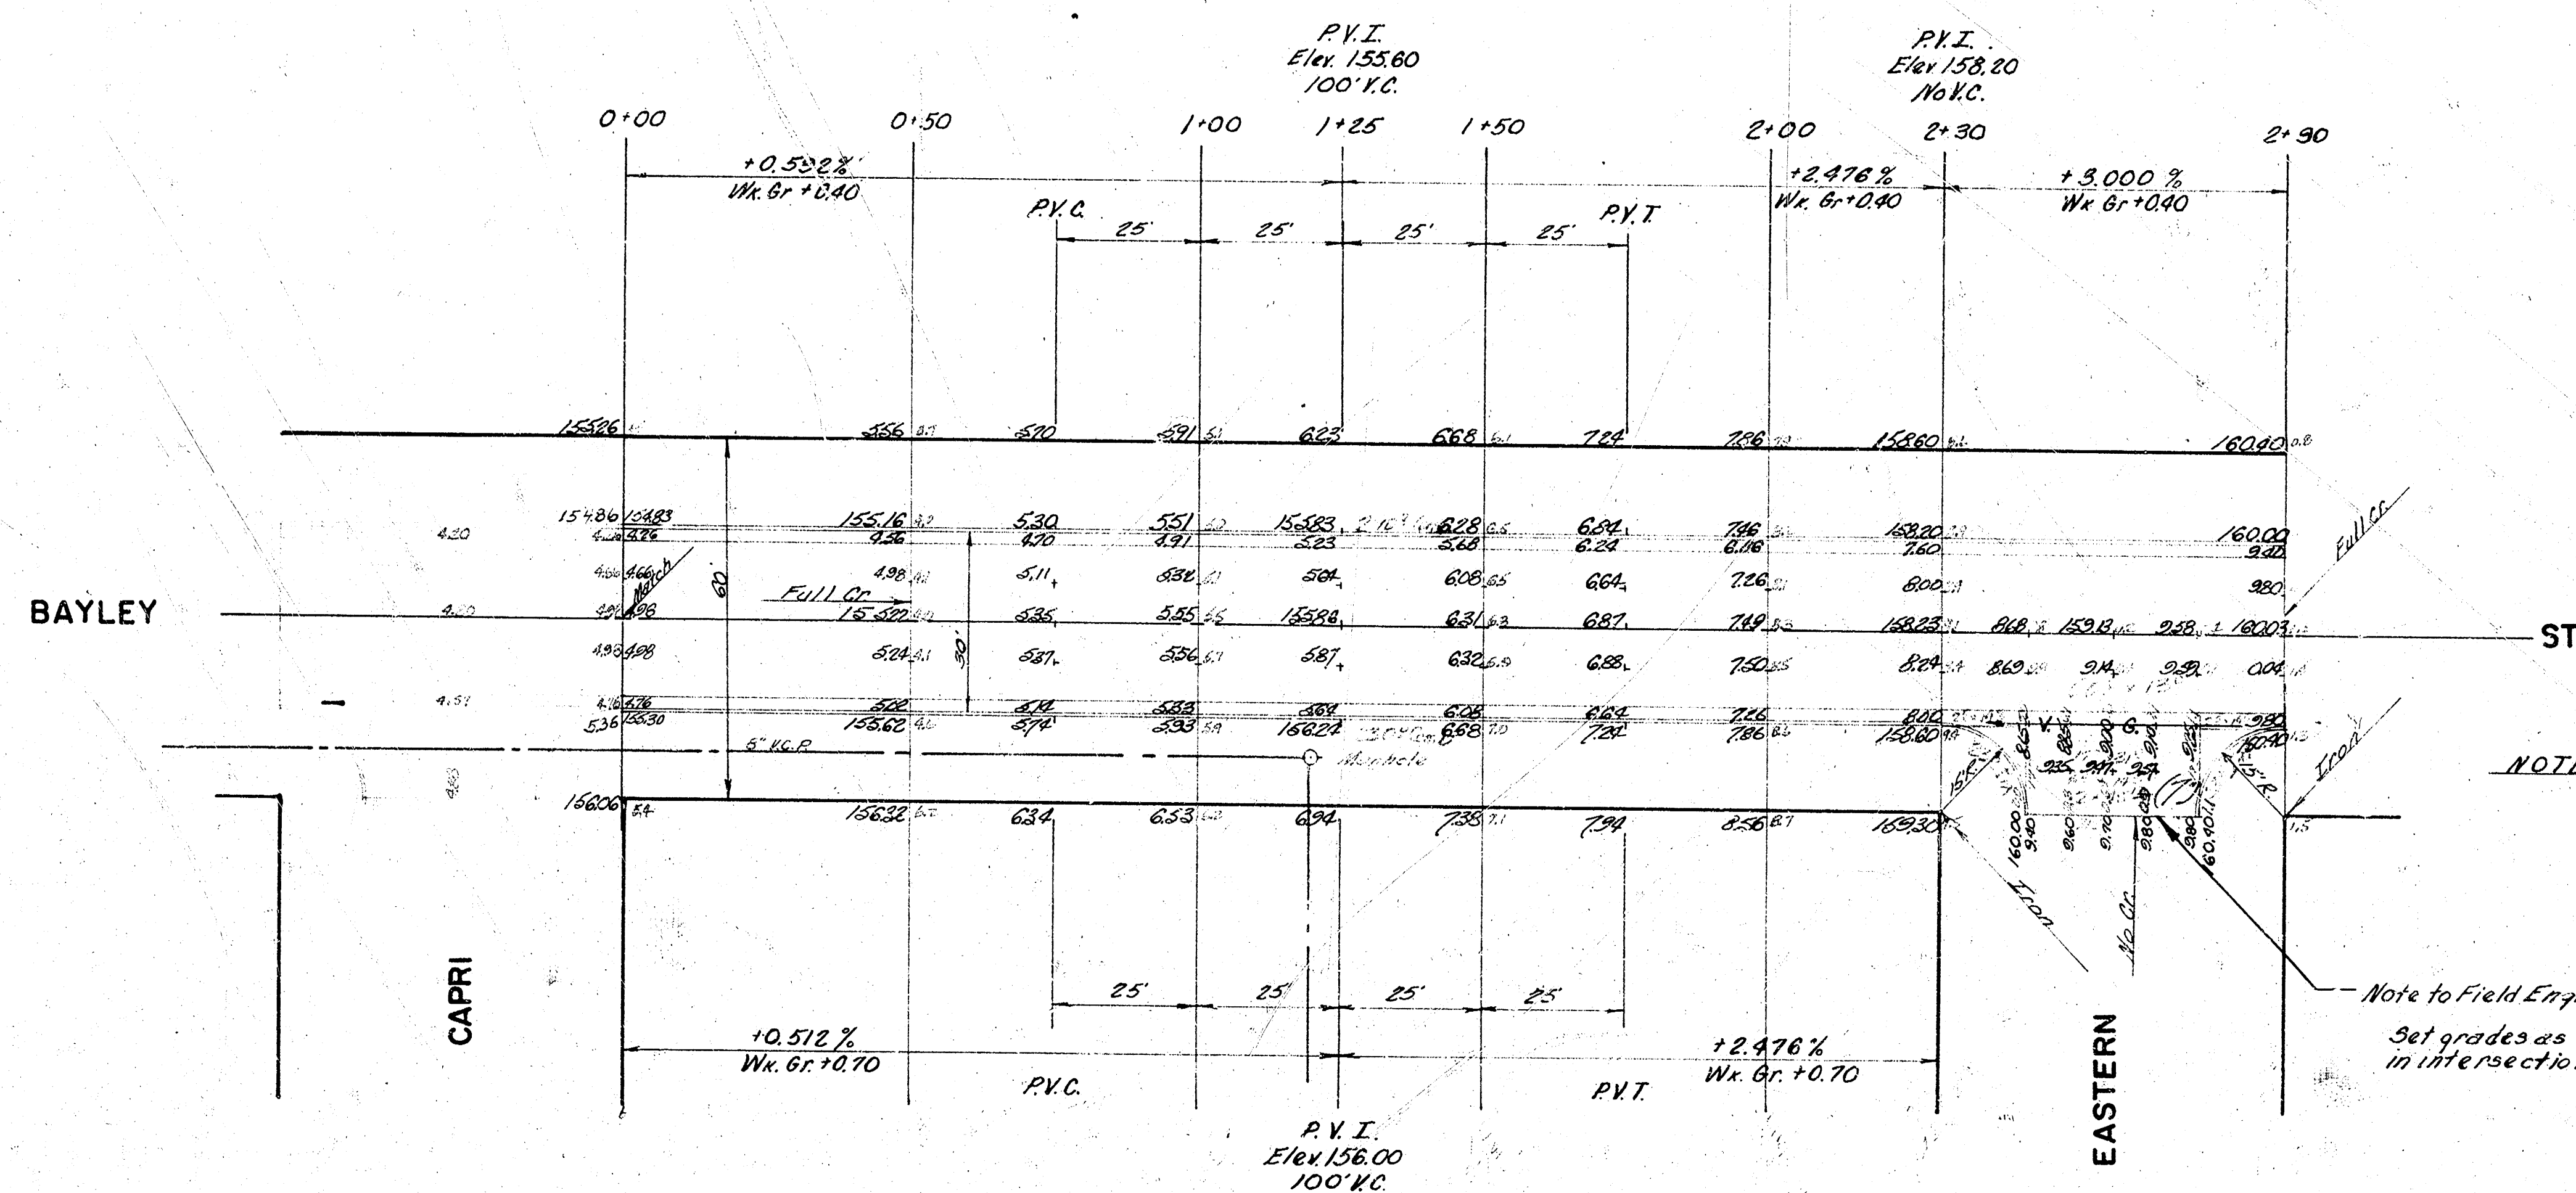

INTERSECTION BAYLEY & EASTERN A.C. CITY OF WICHITA, KANSAS B.E. SMITH CITY ENGINEER DATE PROJ. C14-8		BAYLEY ST. E.L. CAPRI TO E.L. EASTERN 26' - 2' - 30' A.C. CITY OF WICHITA, KANSAS B.E. SMITH CITY ENGINEER DATE PRIVATE JOB	
---	--	--	--