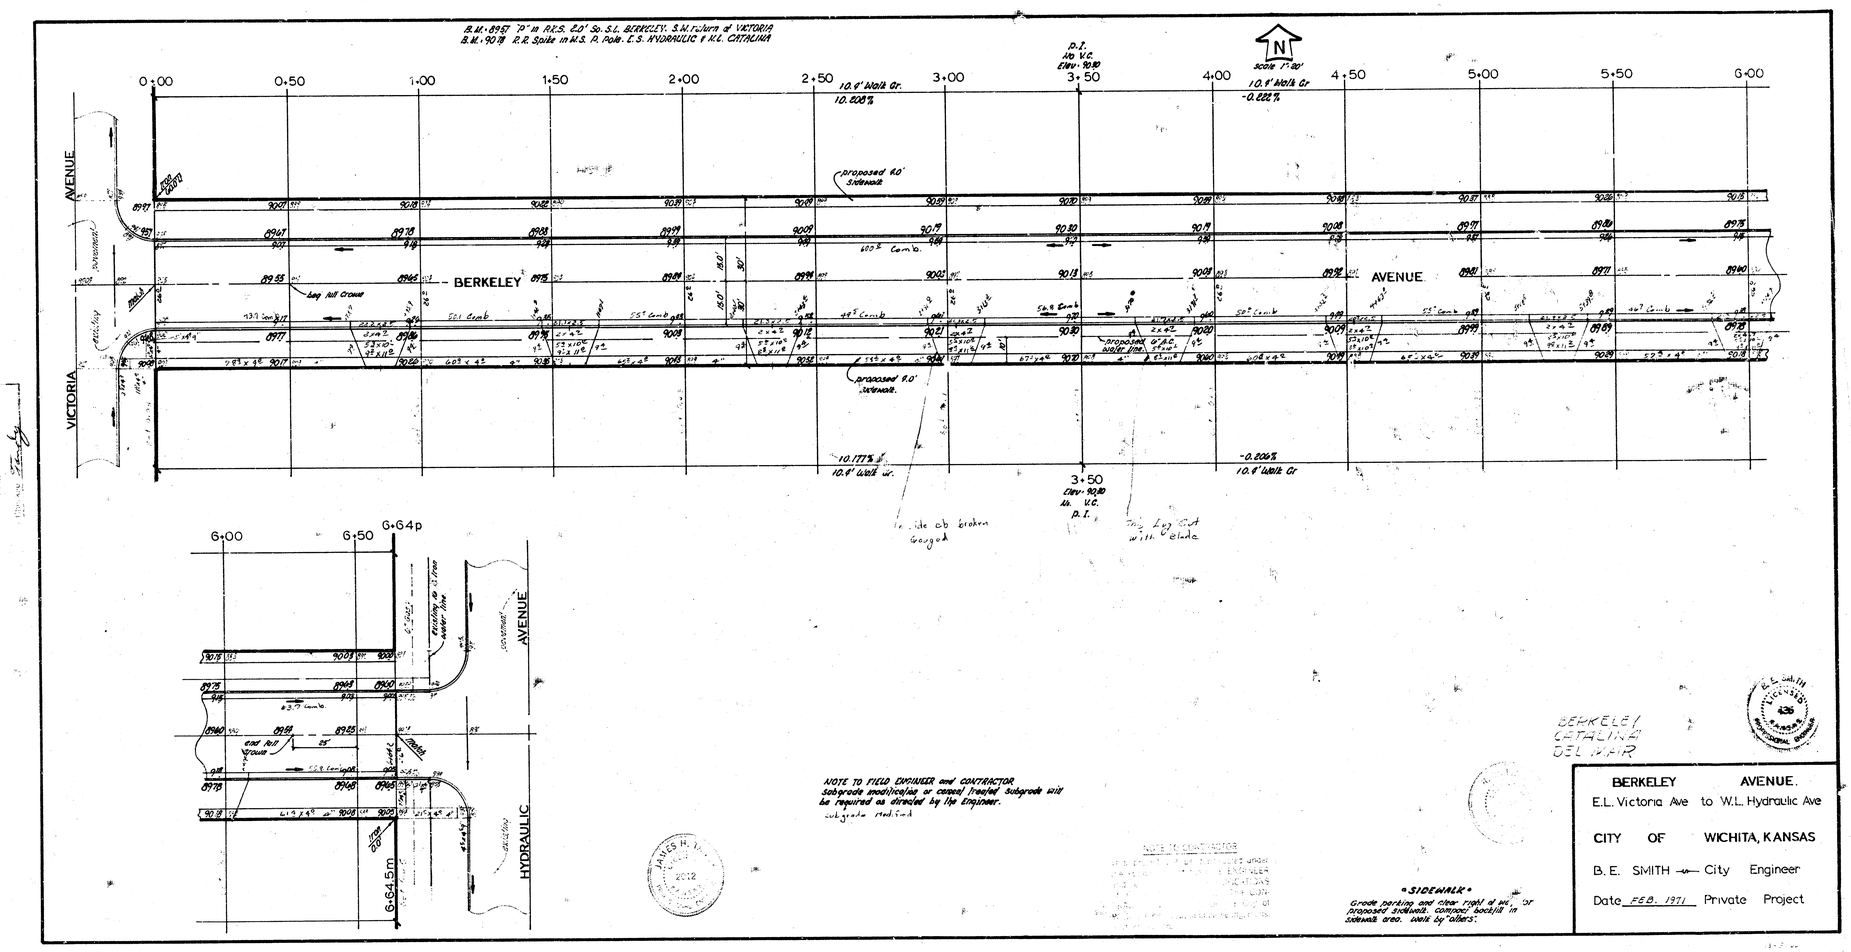

NOTE TO FIELD ENGINEER and CONTRACTOR
Subgrade modification or consol treated subgrade will be required as directed by the Engineer.
subgrade medium

SIDEWALK
Grade parking and other areas at 2" or proposed sidewalk, contour backfill in sidewalk area. work by others.

BERKELEY	AVENUE.
E.L. Victoria Ave	to W.L. Hydraulic Ave
CITY OF	WICHITA, KANSAS
B. E. SMITH — City	Engineer
Date FEB. 1971	Private Project