
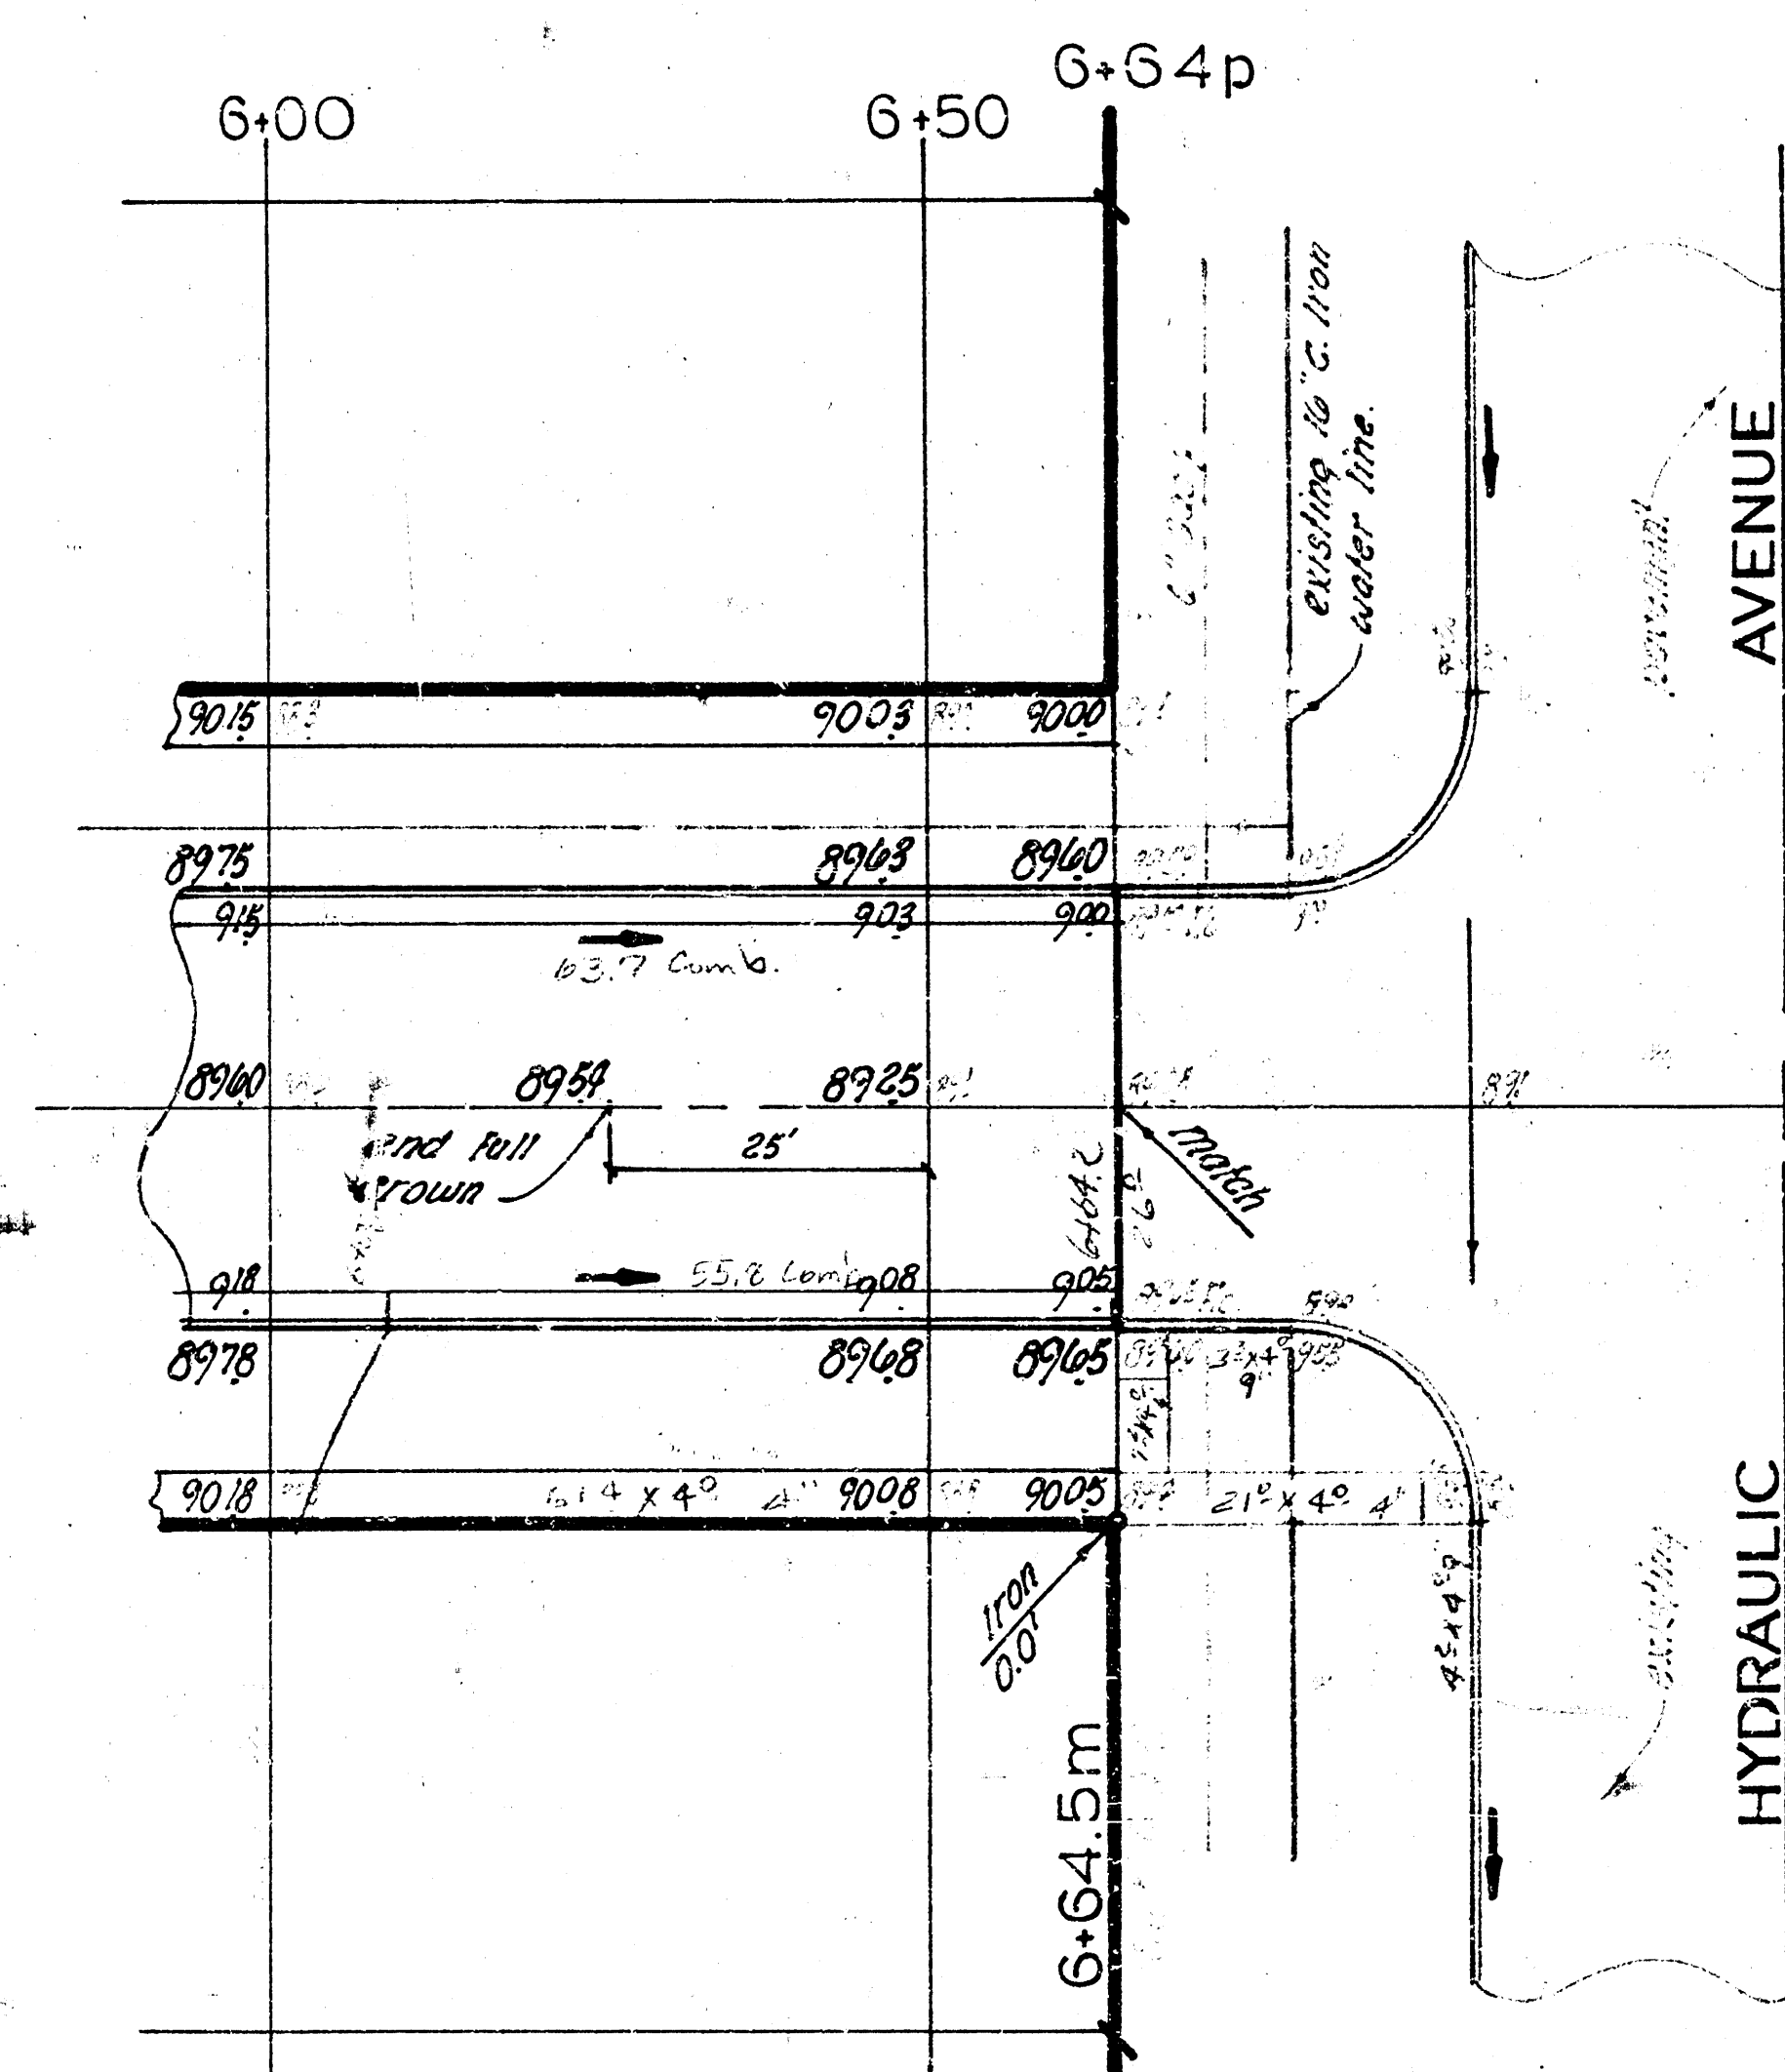



B.M. 8957 17' in P.K.S. 20' So. S.L. BERKELEY. S.W. return of VICTORIA
B.M. 9078 R.R. Spike in M.S. P. Pole. E.S. HYDRAULIC & N.L. CATHACINA

AVENUE

VICTORIA

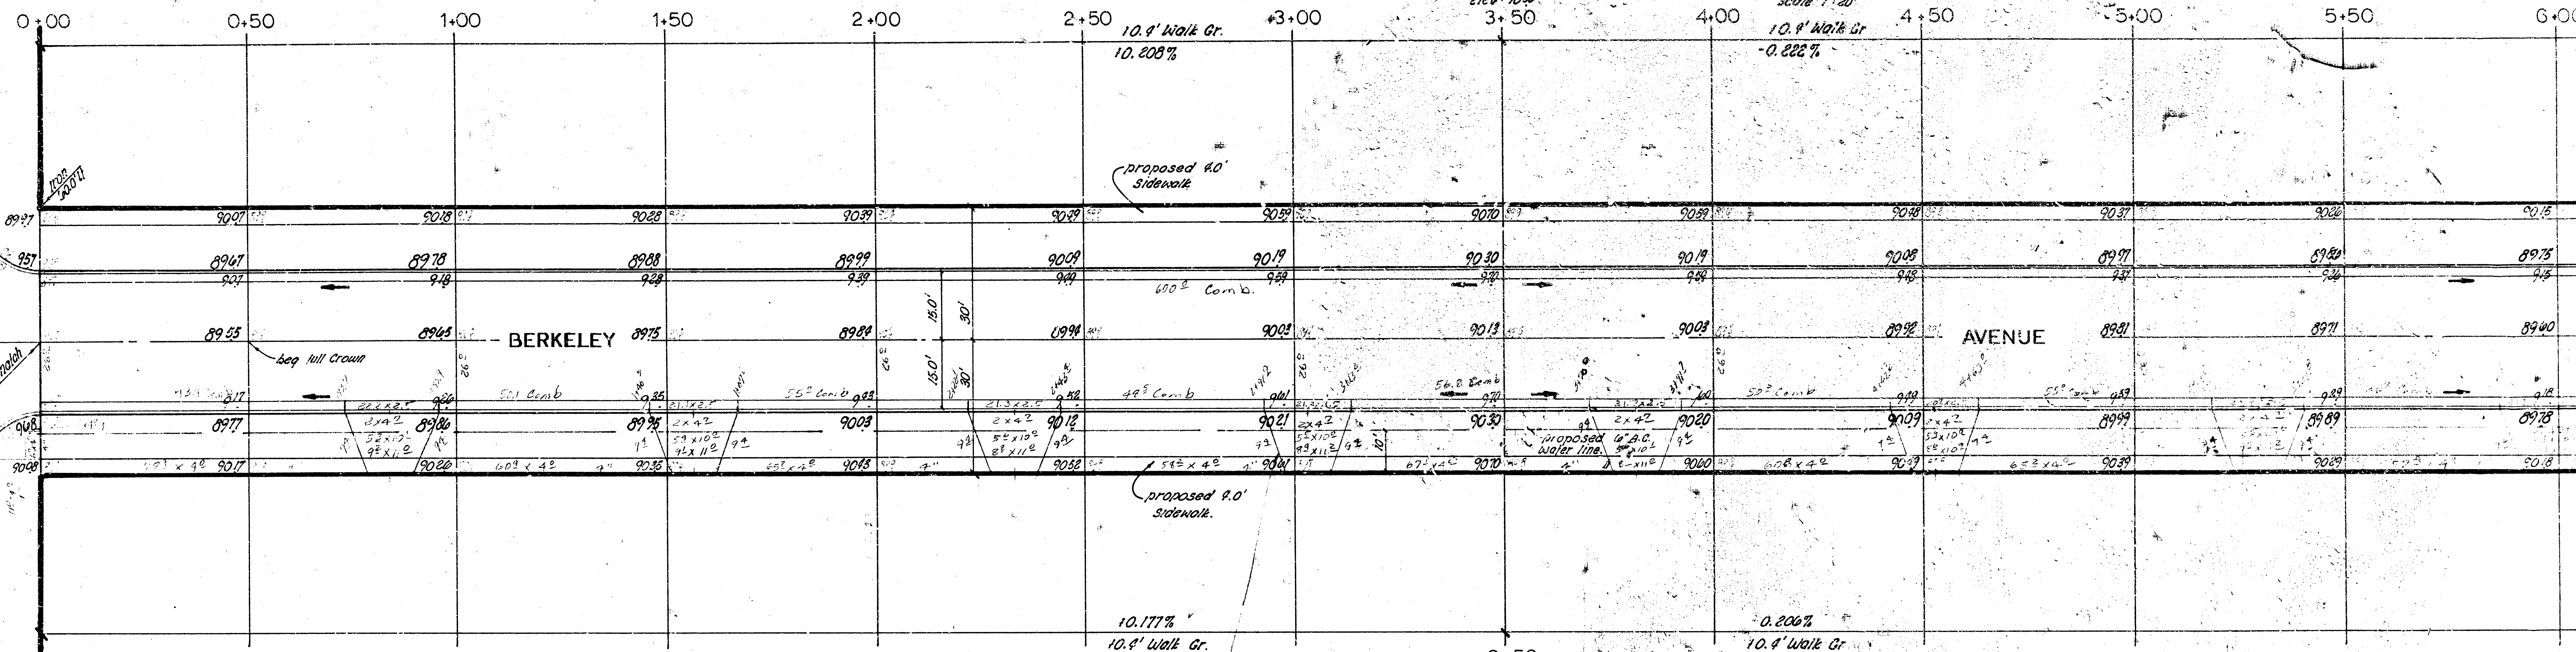

NOTE TO FIELD ENGINEER and CONTRACTOR
Subgrade modification or cement treated subgrade will
be required as directed by the Engineer.
Subgrade modified

 

SIDEWALK
Grade parking and clear right of way for
proposed sidewalk. compact backfill in
sidewalk area. Walk by others.

BERKELEY AVENUE
Ed. Victoria Ave. to W.L. Hydraulics
CITY OF WICHITA, KANSAS
B.E. SMITH City Engineer
Date FEB. 1971 Private Project