

4-48

10300 10700 S.W.

1/4 SEC. 17, TWP. 27S, R.1W.


4-48

1000

(103 rd. ST. W.)

700

700

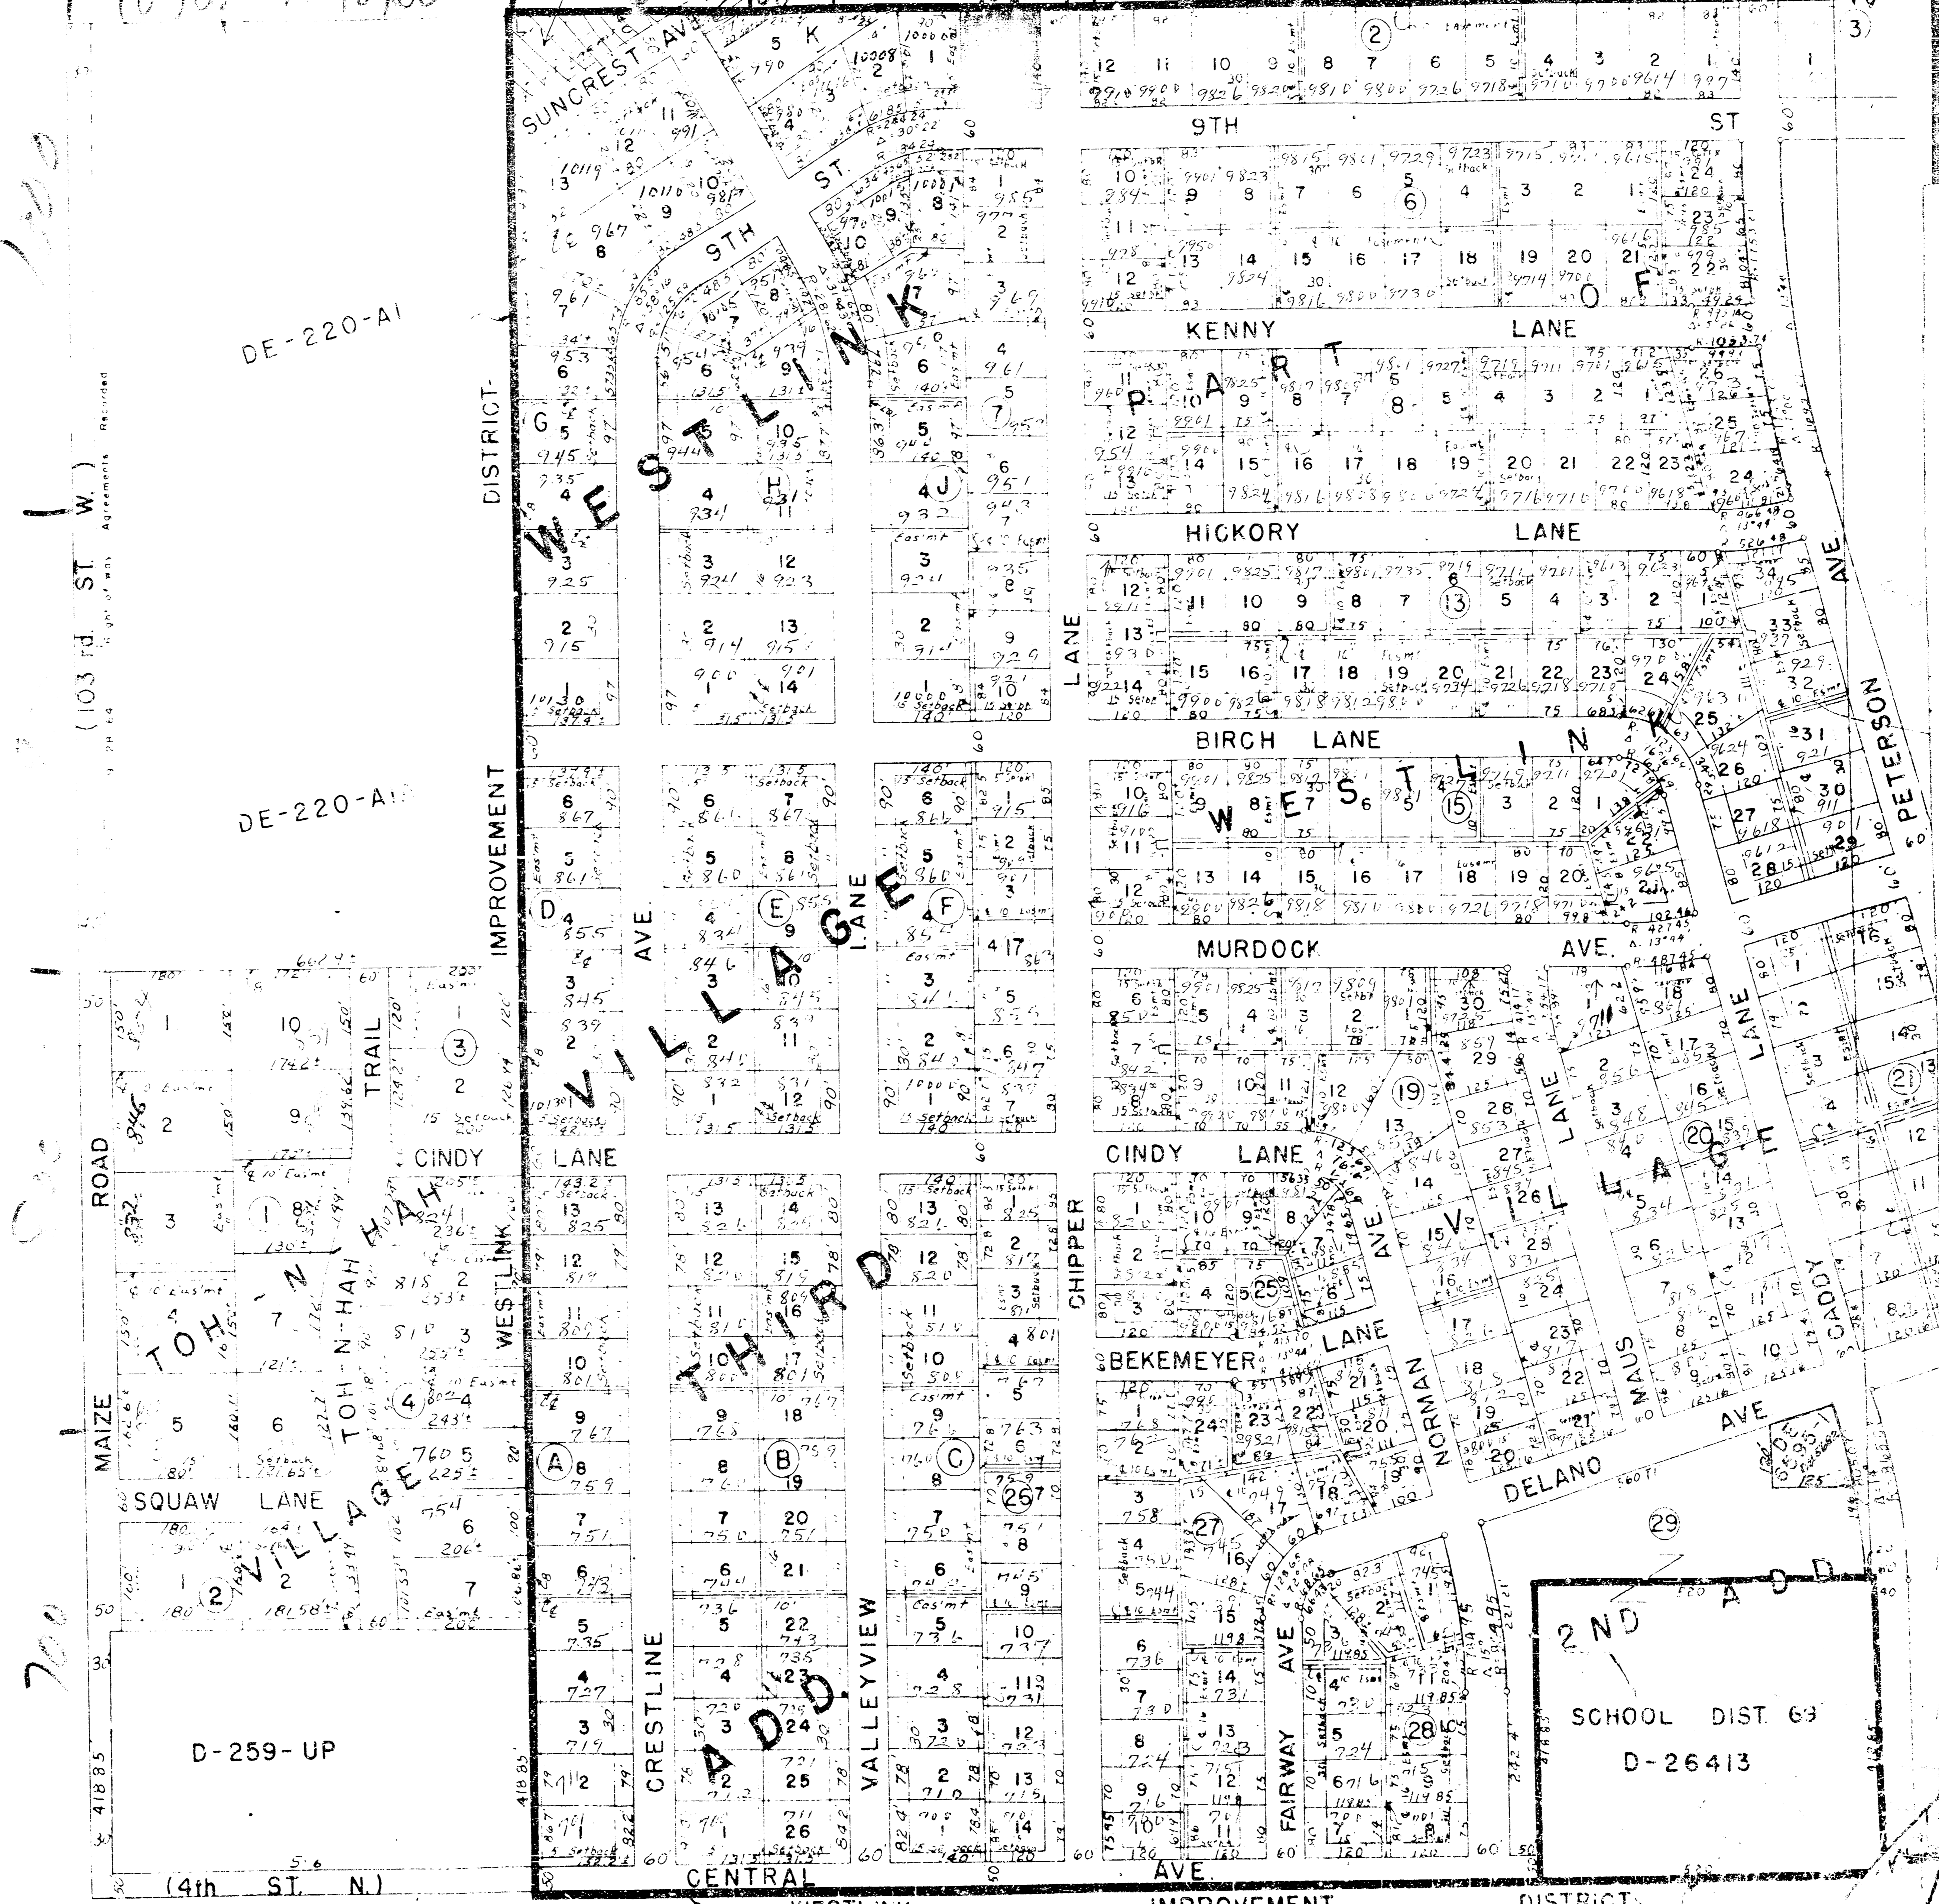

DE-220-A1

DE-220-A1

D-259-UP