


# N.E. 1/4 SEC 17, TWP 27S, RI.W.

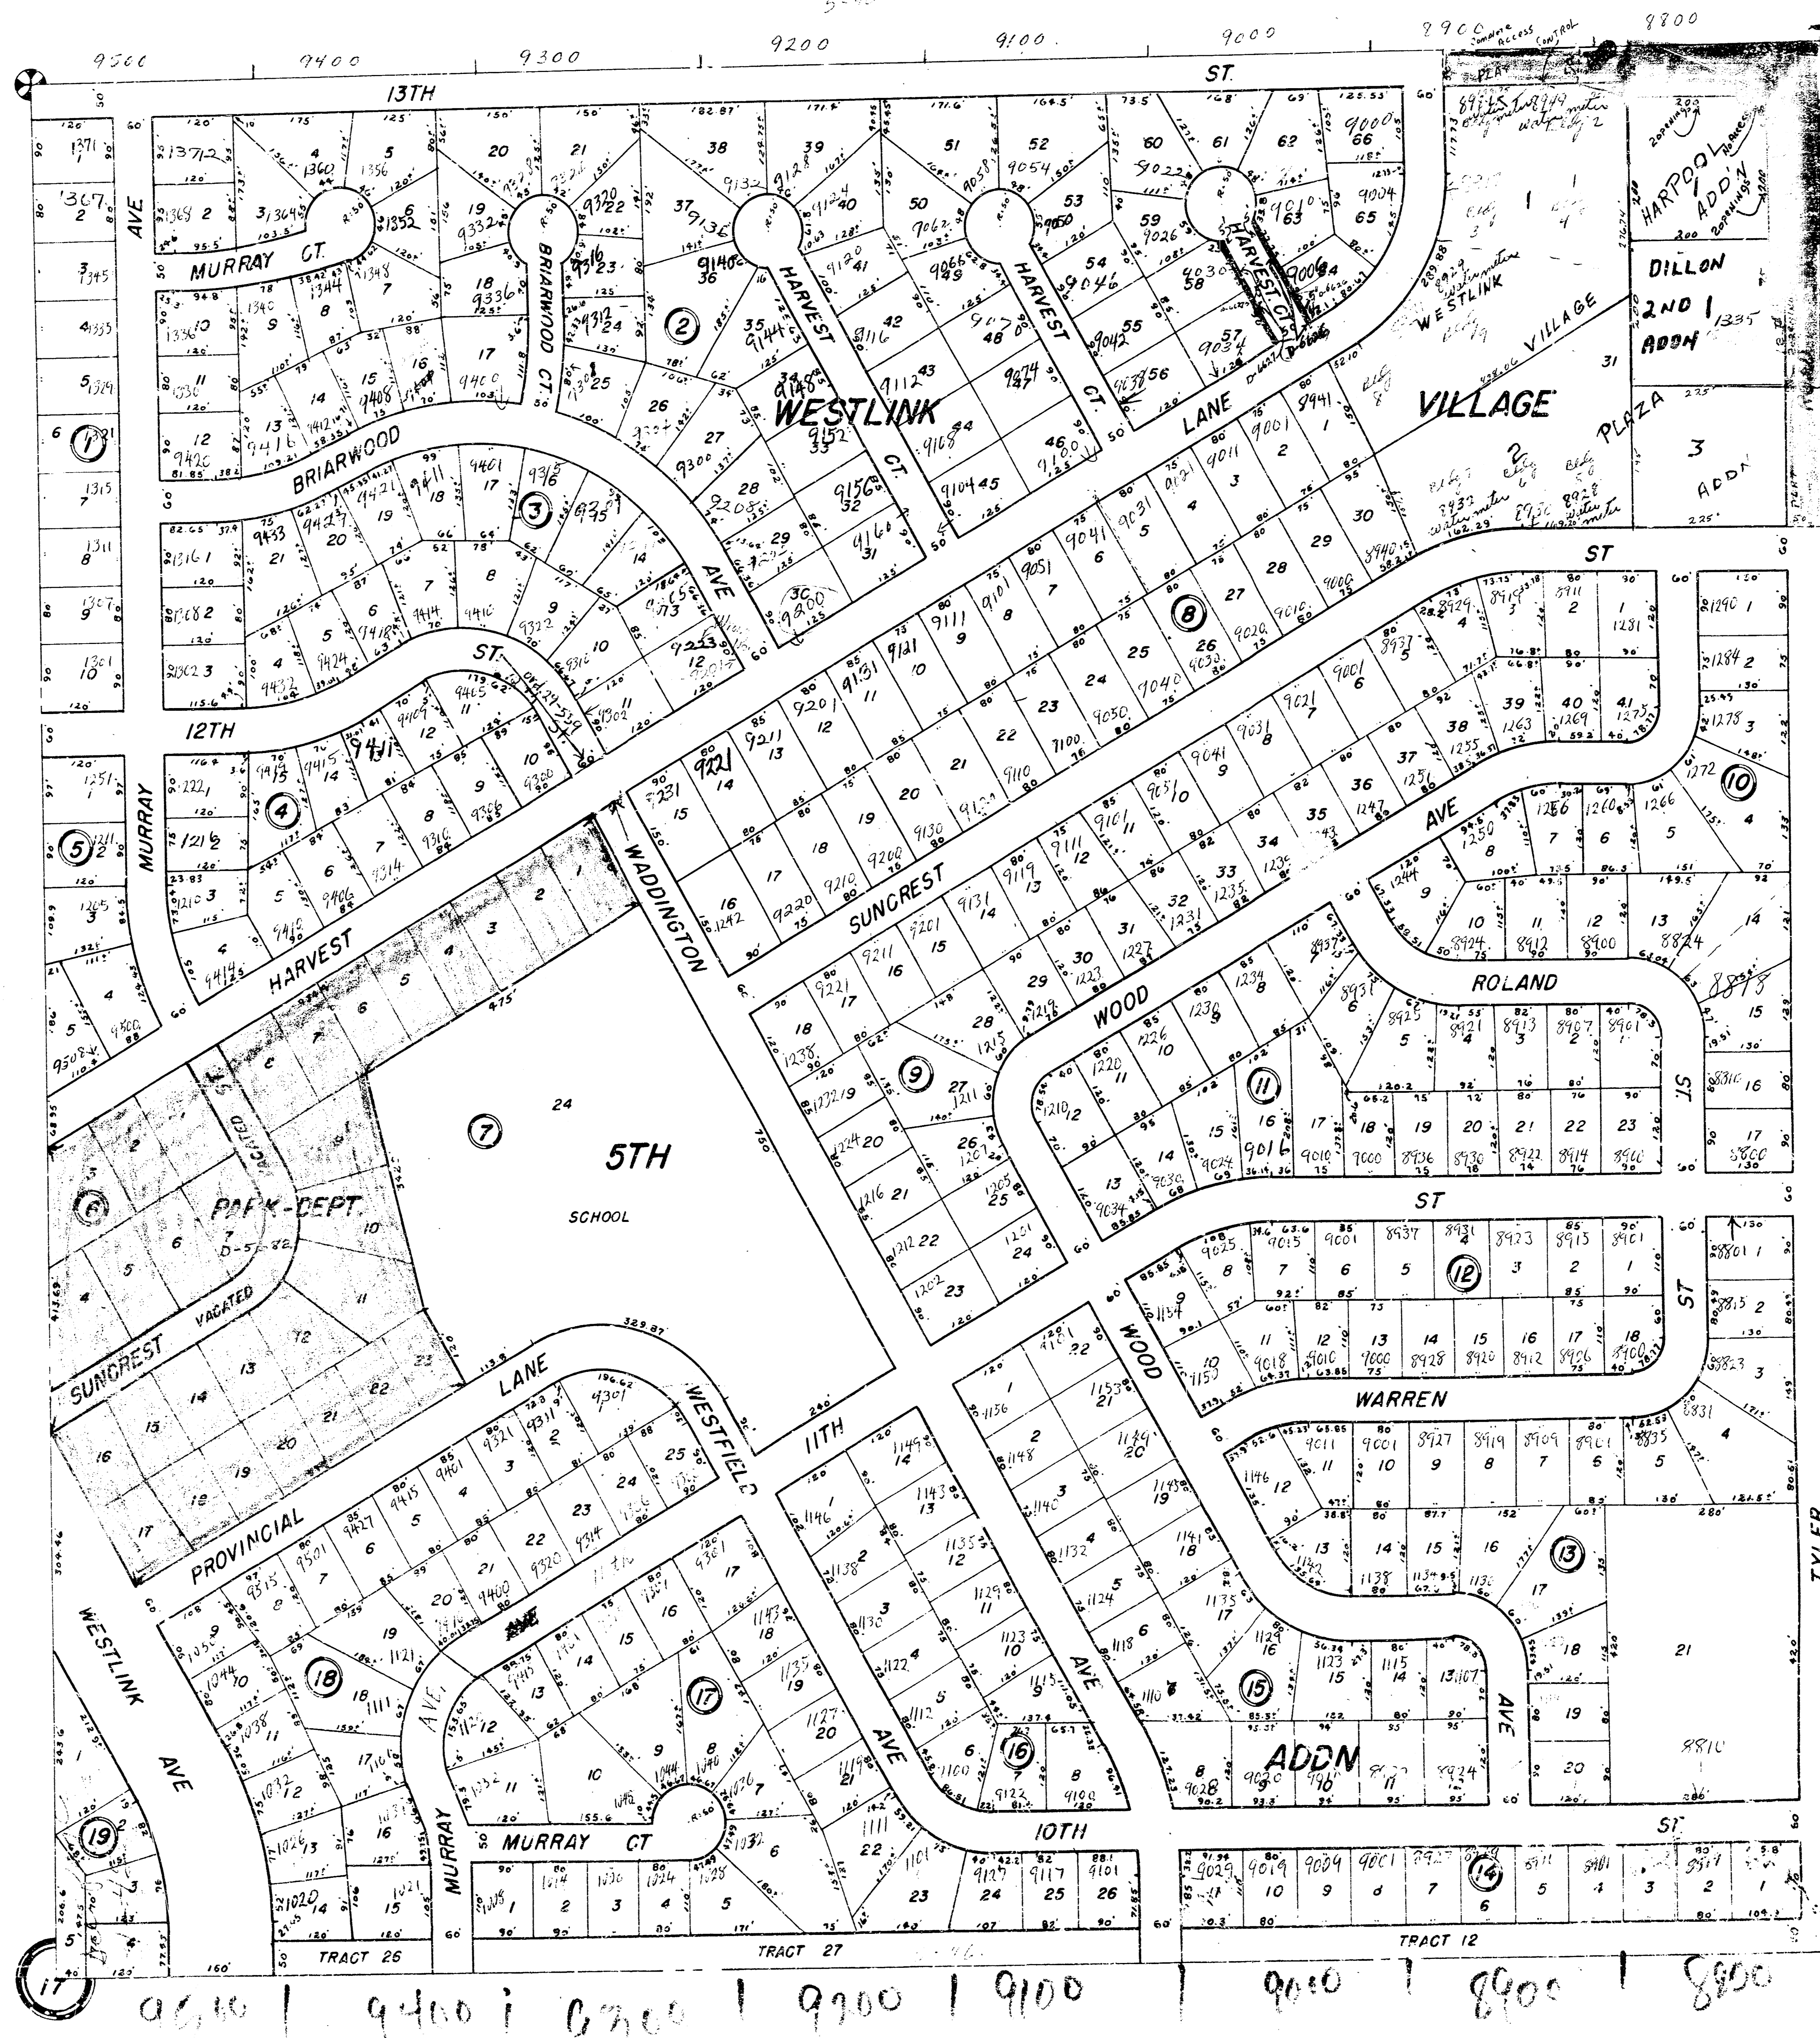

9500 | 9400 | 9300 | 9200 | 9100 | 9000 | 8900 | 8800