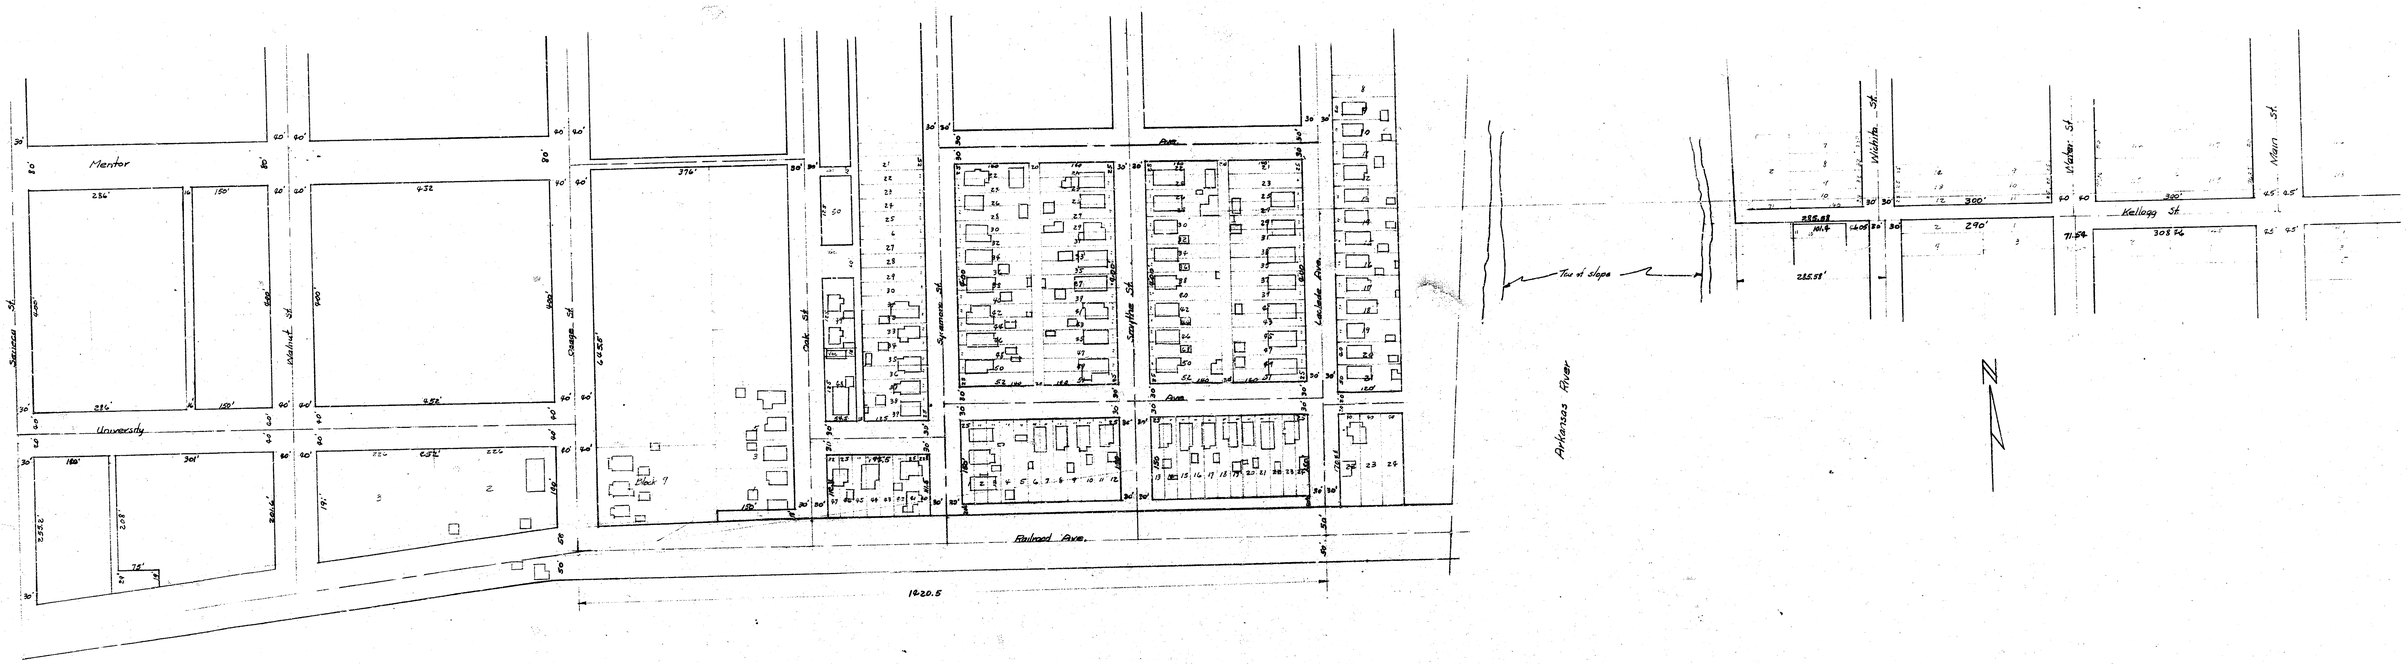
Mentor
University
Walnut St.
Sycamore St.
Wichita St.
Water St.
Main St.
Kellogg St.
Alley
Ave.
Railroad Ave.
Arkansas River
Tos of slope

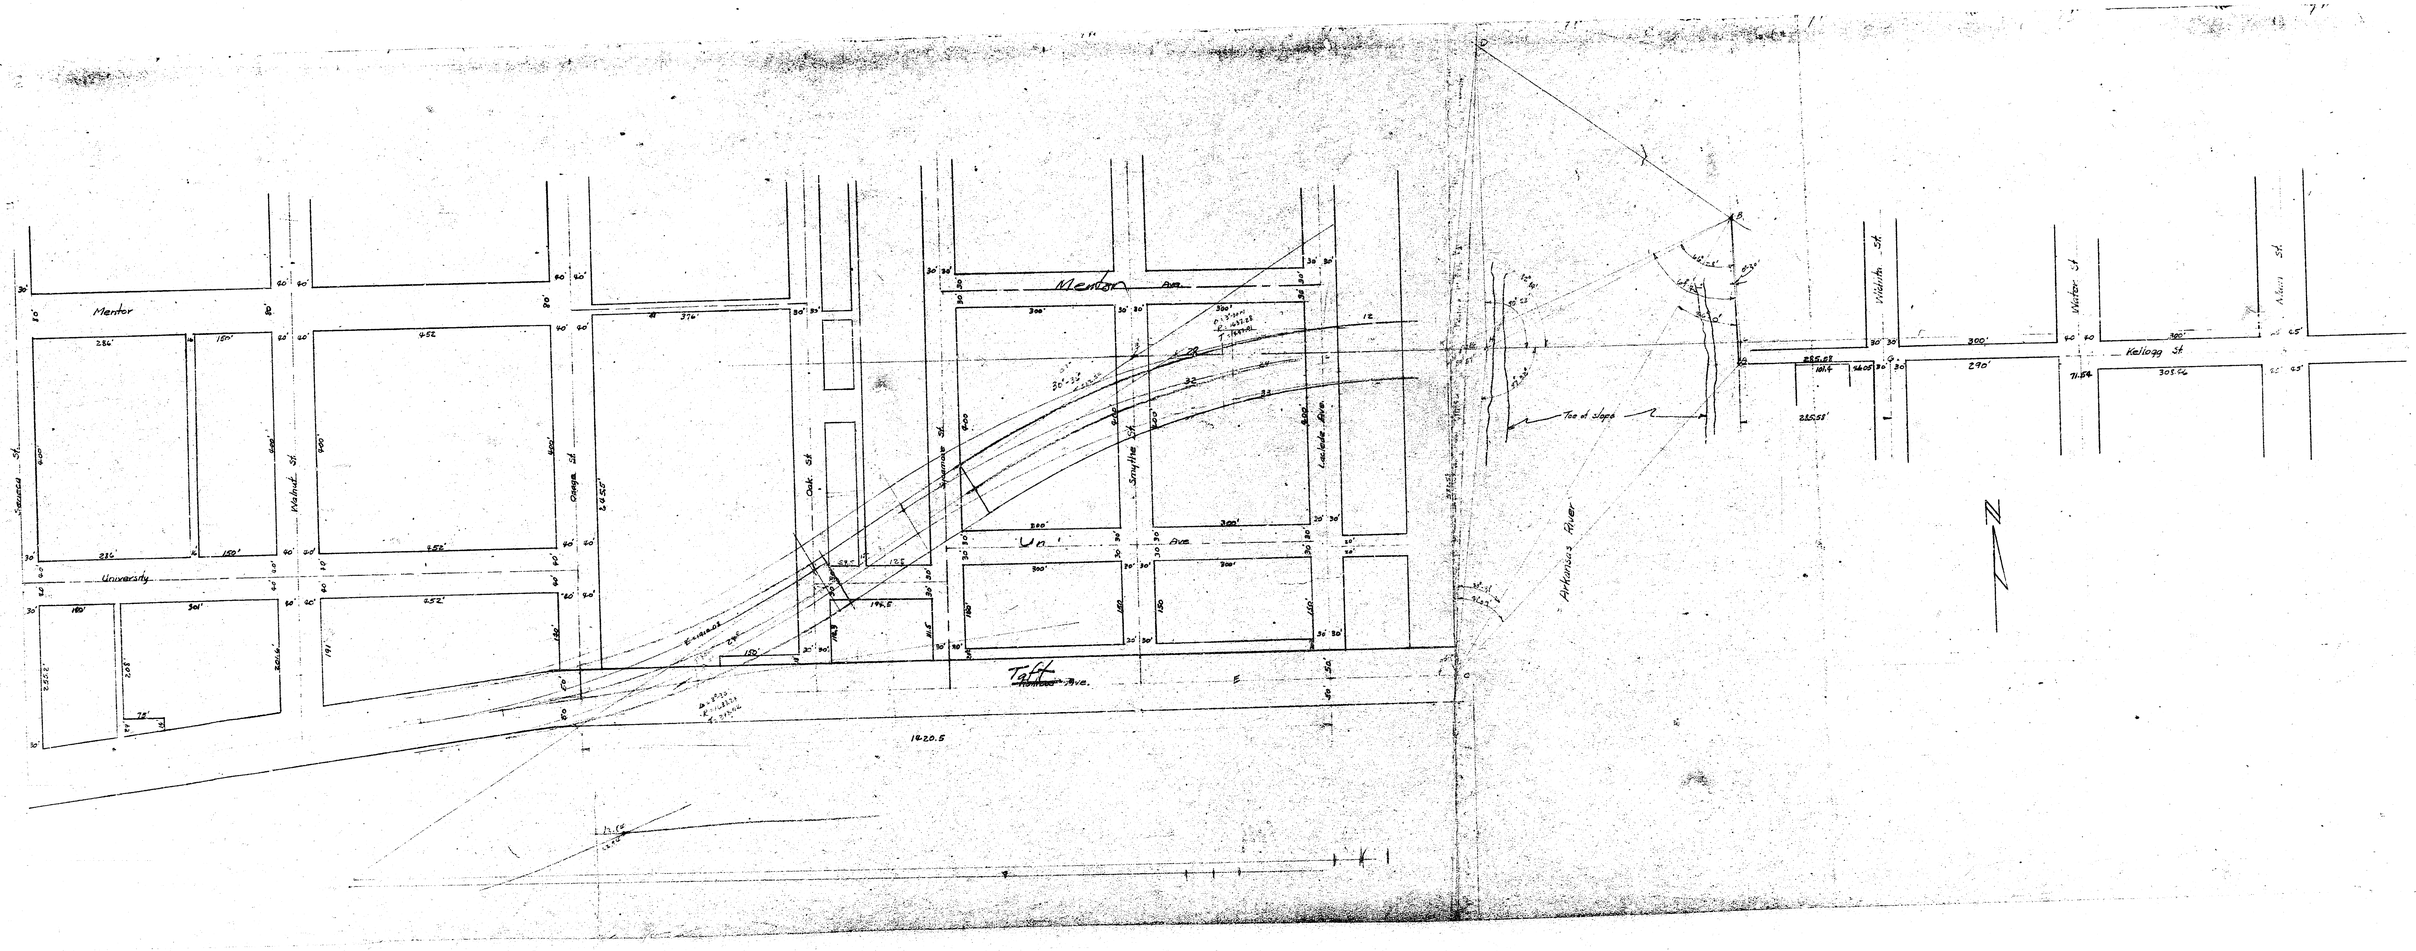
Mentor
Mentor Ave.
University
Taft Ave.
Walnut St.
Oak St.
Smythe St.
Arkansas River
Toe of Slope
Walter St.
Kellogg St.
N
1620.5