


1/10 (2-5)

FLOOR PLAN OF CITY HALL
WICHITA, KANSAS
SOUTH HALF OF THIRD FLOOR
CITY ENGINEERS OFFICE DEC. 7.1917

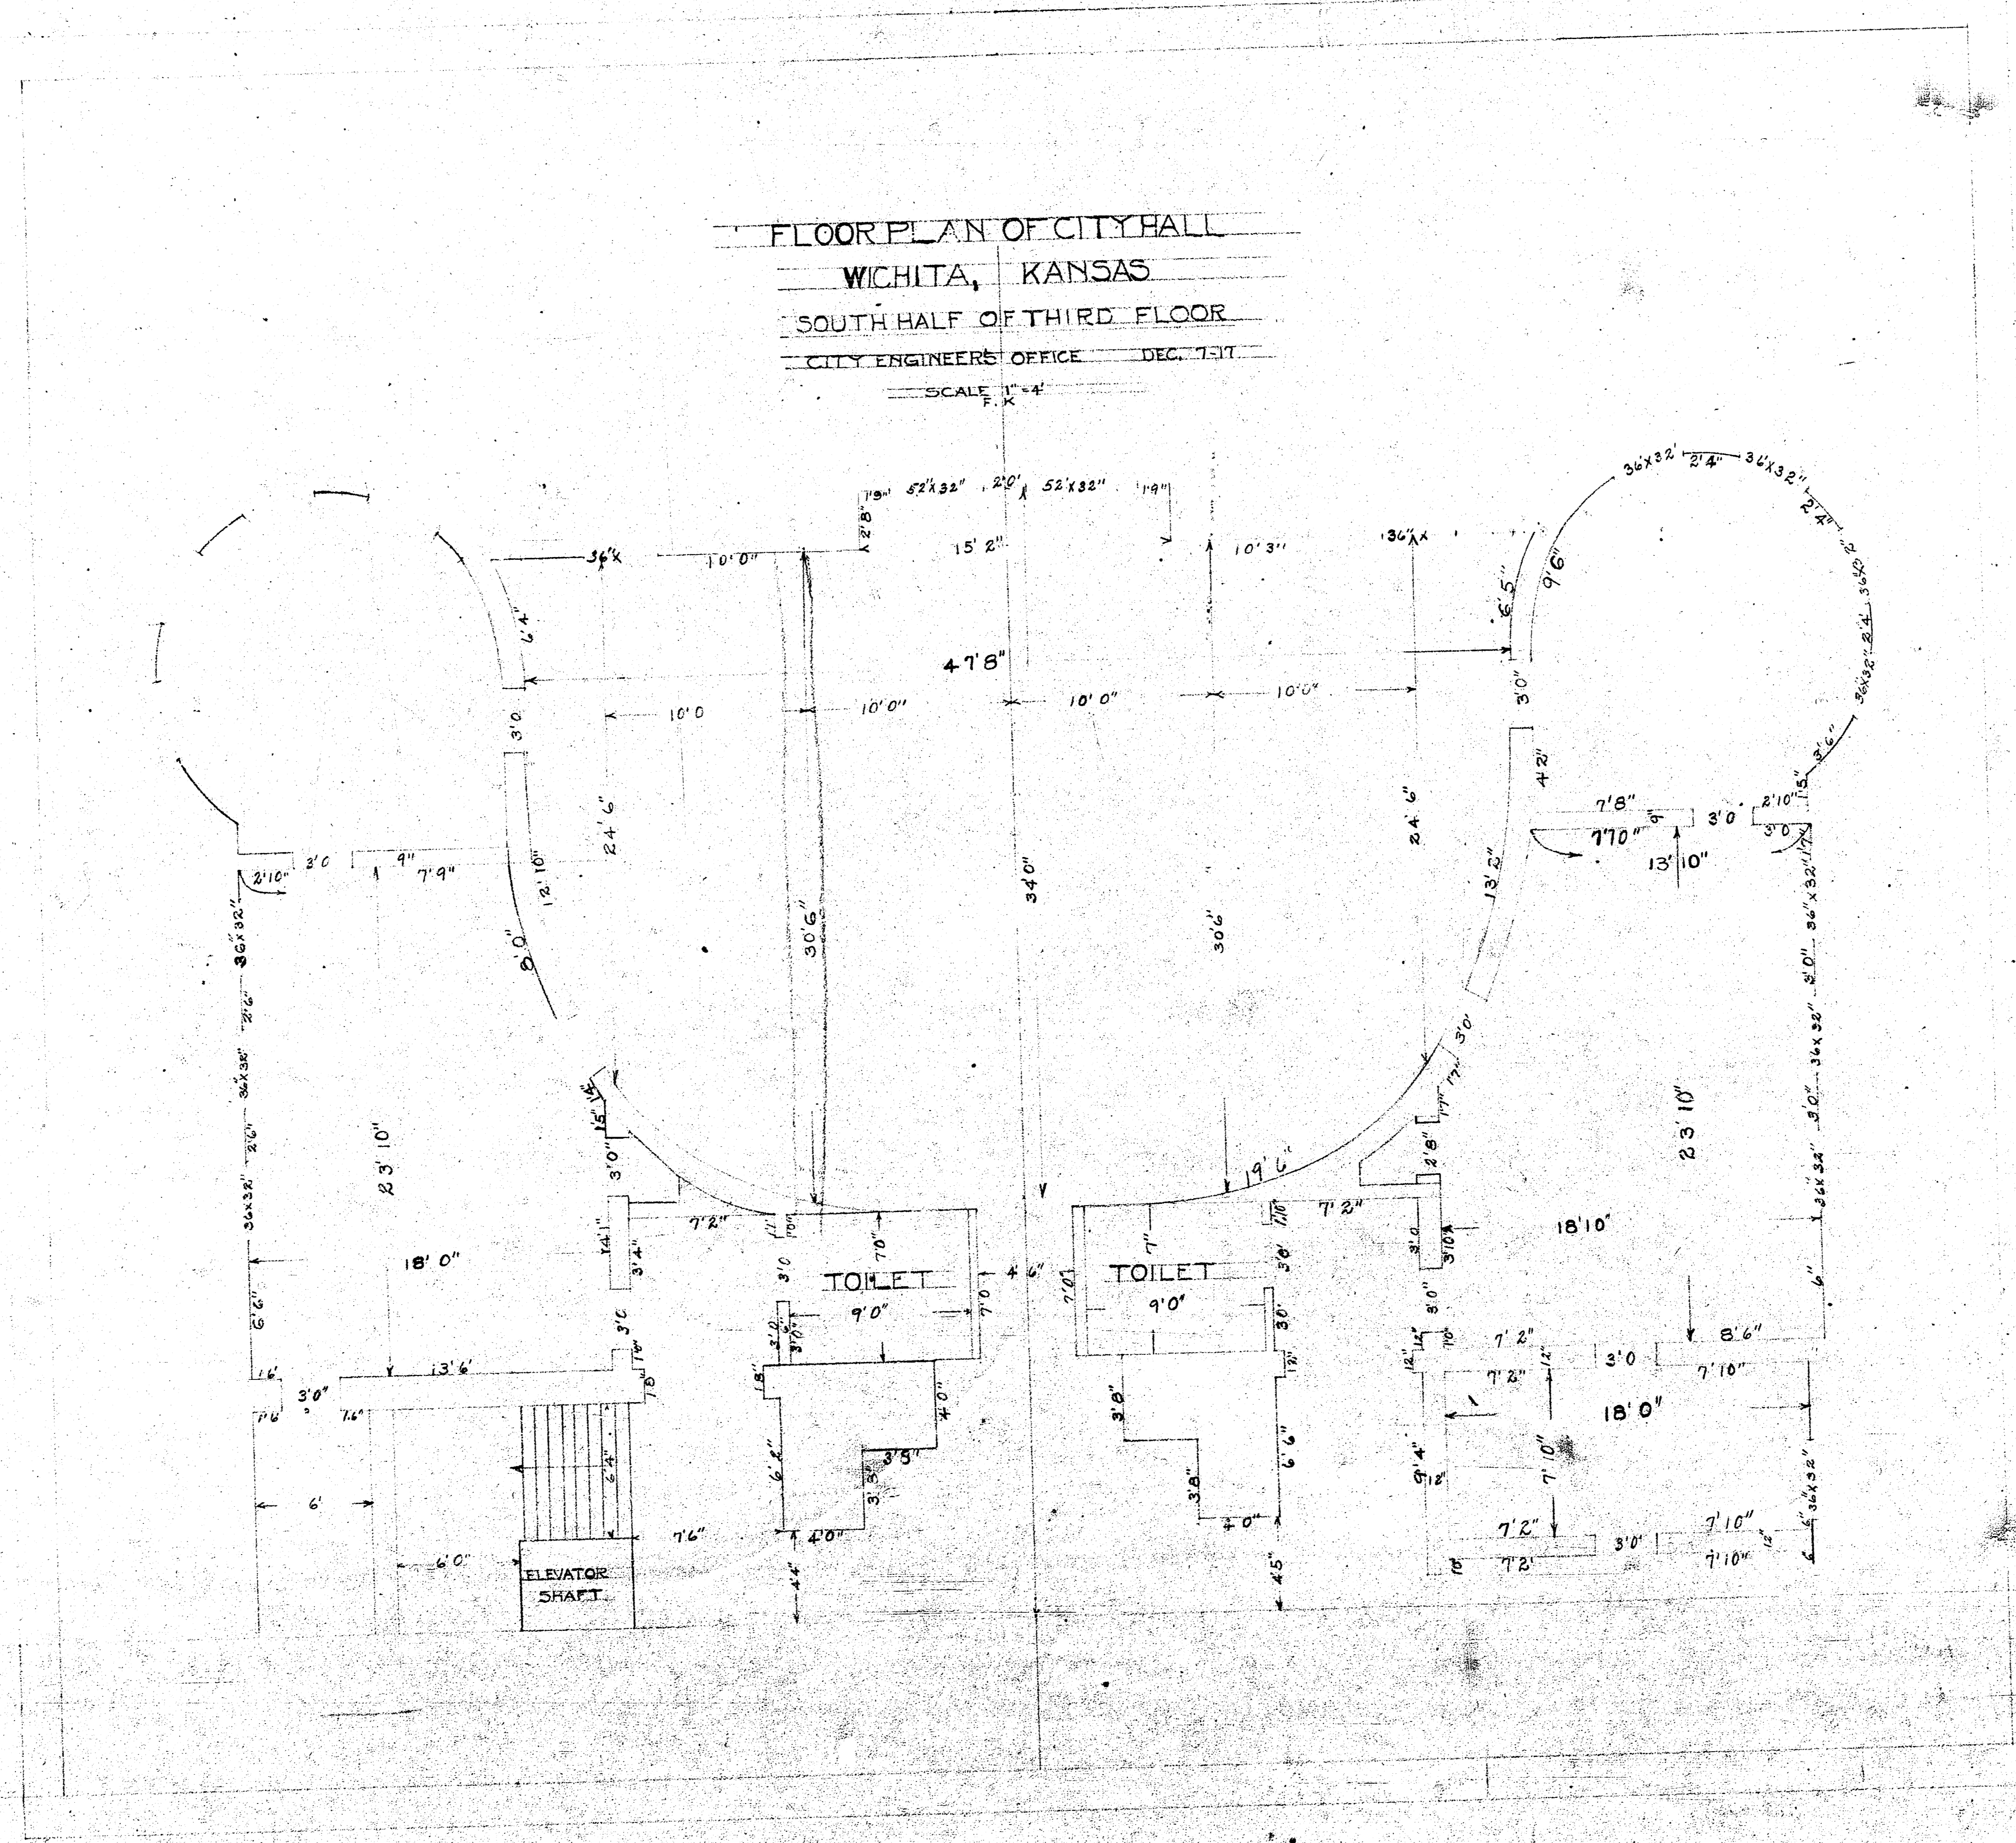

1/10

FLOOR PLAN OF CITY HALL

WICHITA, KANSAS

SOUTH HALF OF SECOND FLOOR

CITY ENGINEERS OFFICE DEC 8/11

SCALE 1"=4'

F.K.

