

FLOOR PLAN OF CITY HALL
WICHITA, KANSAS
SOUTH HALF OF THIRD FLOOR
CITY ENGINEERS OFFICE DEC. 7-17
SCALE 1" = 4'

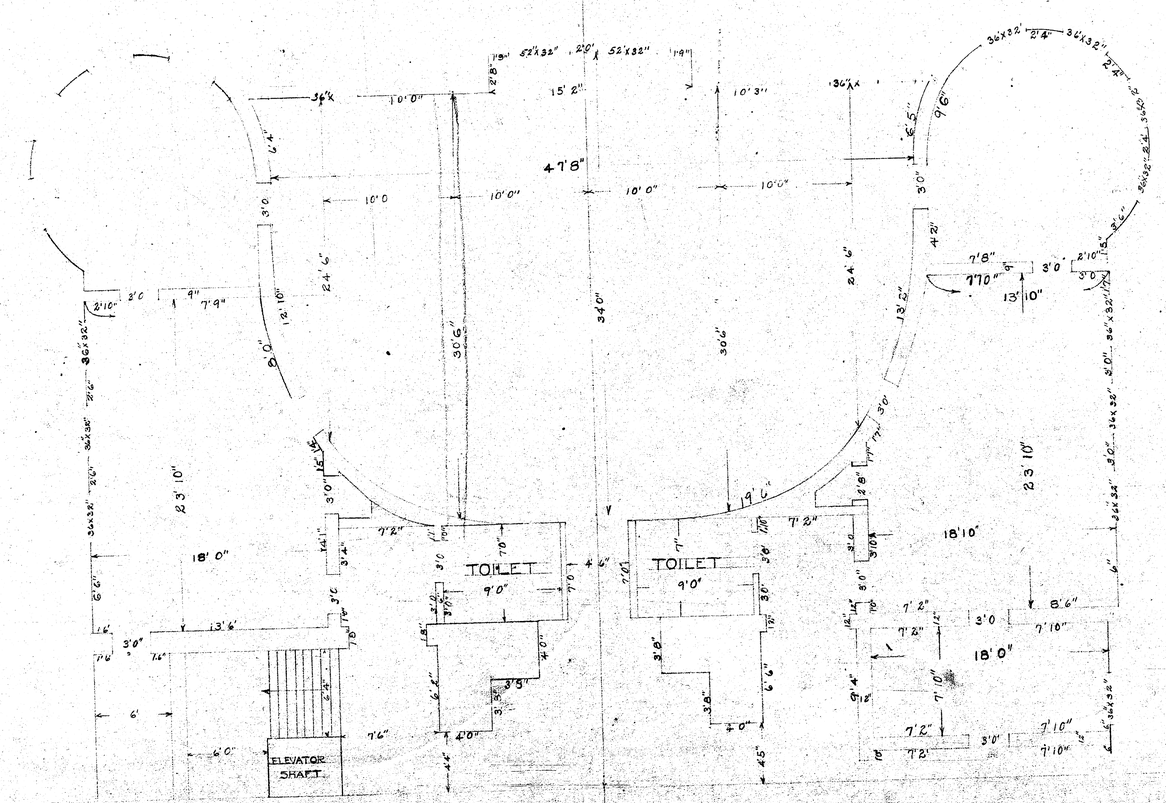



FLOOR PLAN OF CITY HALL
WICHITA, KANSAS
SOUTH HALF OF FOURTH FLOOR
CITY ENGINEERS OFFICE DEC.10-17
SCALE 1"=4'
F.K.

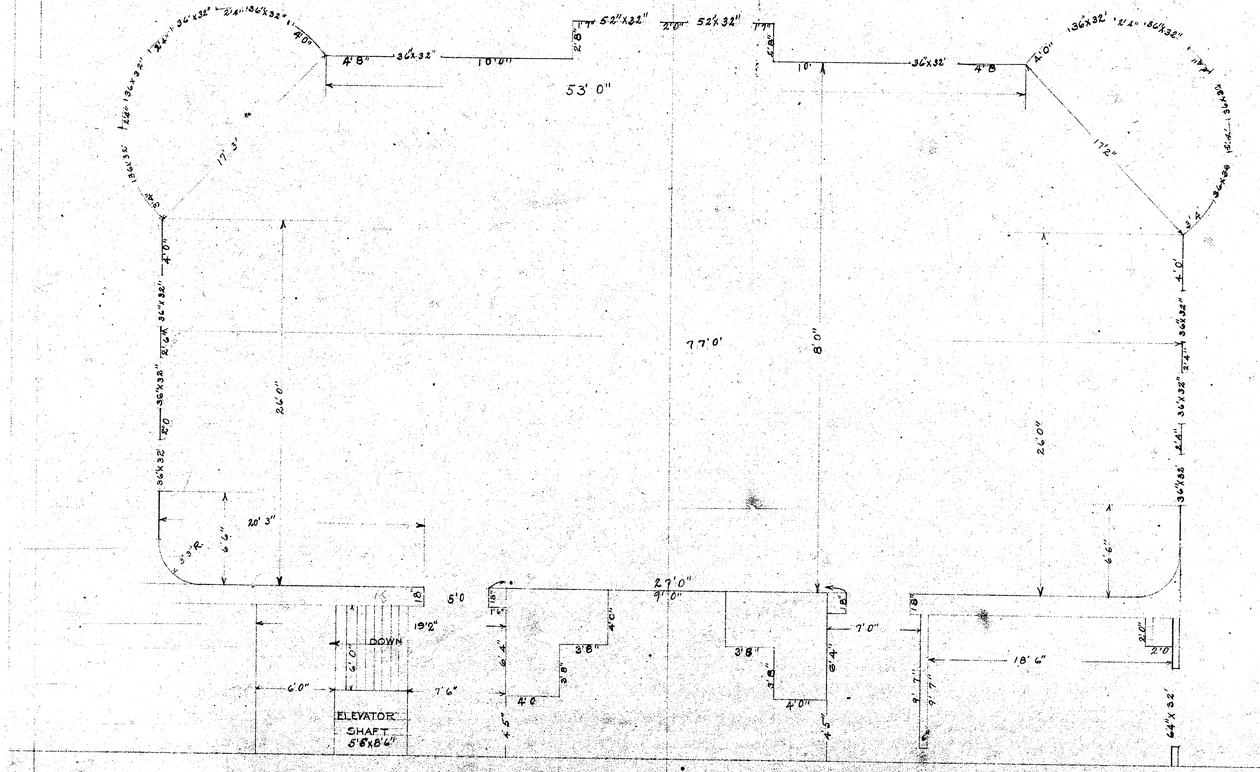

FLOOR PLAN OF CITY HALL
WICHITA, KANSAS

SOUTH HALF OF SECOND FLOOR
CITY ENGINEERS OFFICE DEC. 8-11
SCALE 1"=4'
F K

