

KOCH BUILDING

DOUGLAS AVENUE

PROPERTY LINE

check elevations

? part of Douglas prop?

FOUNTAIN DET. VNF.

TERRACE

TERRACE RAMP (4.11)

MANHOLE DET. RES.

PLANTER

RAMP

SIDEWALK

MICHIGAN PACIFIC RAILROAD RIGHT OF WAY

AREA DRAIN DET. RES.

AREA DRAIN DET. RES.


DET. RES. (11.65 (TYP.))

MATCH LINE


MATCH LINE

PLAN # 1

CIVIC CULTURAL CENTER
CITY OF WICHITA, KANSAS

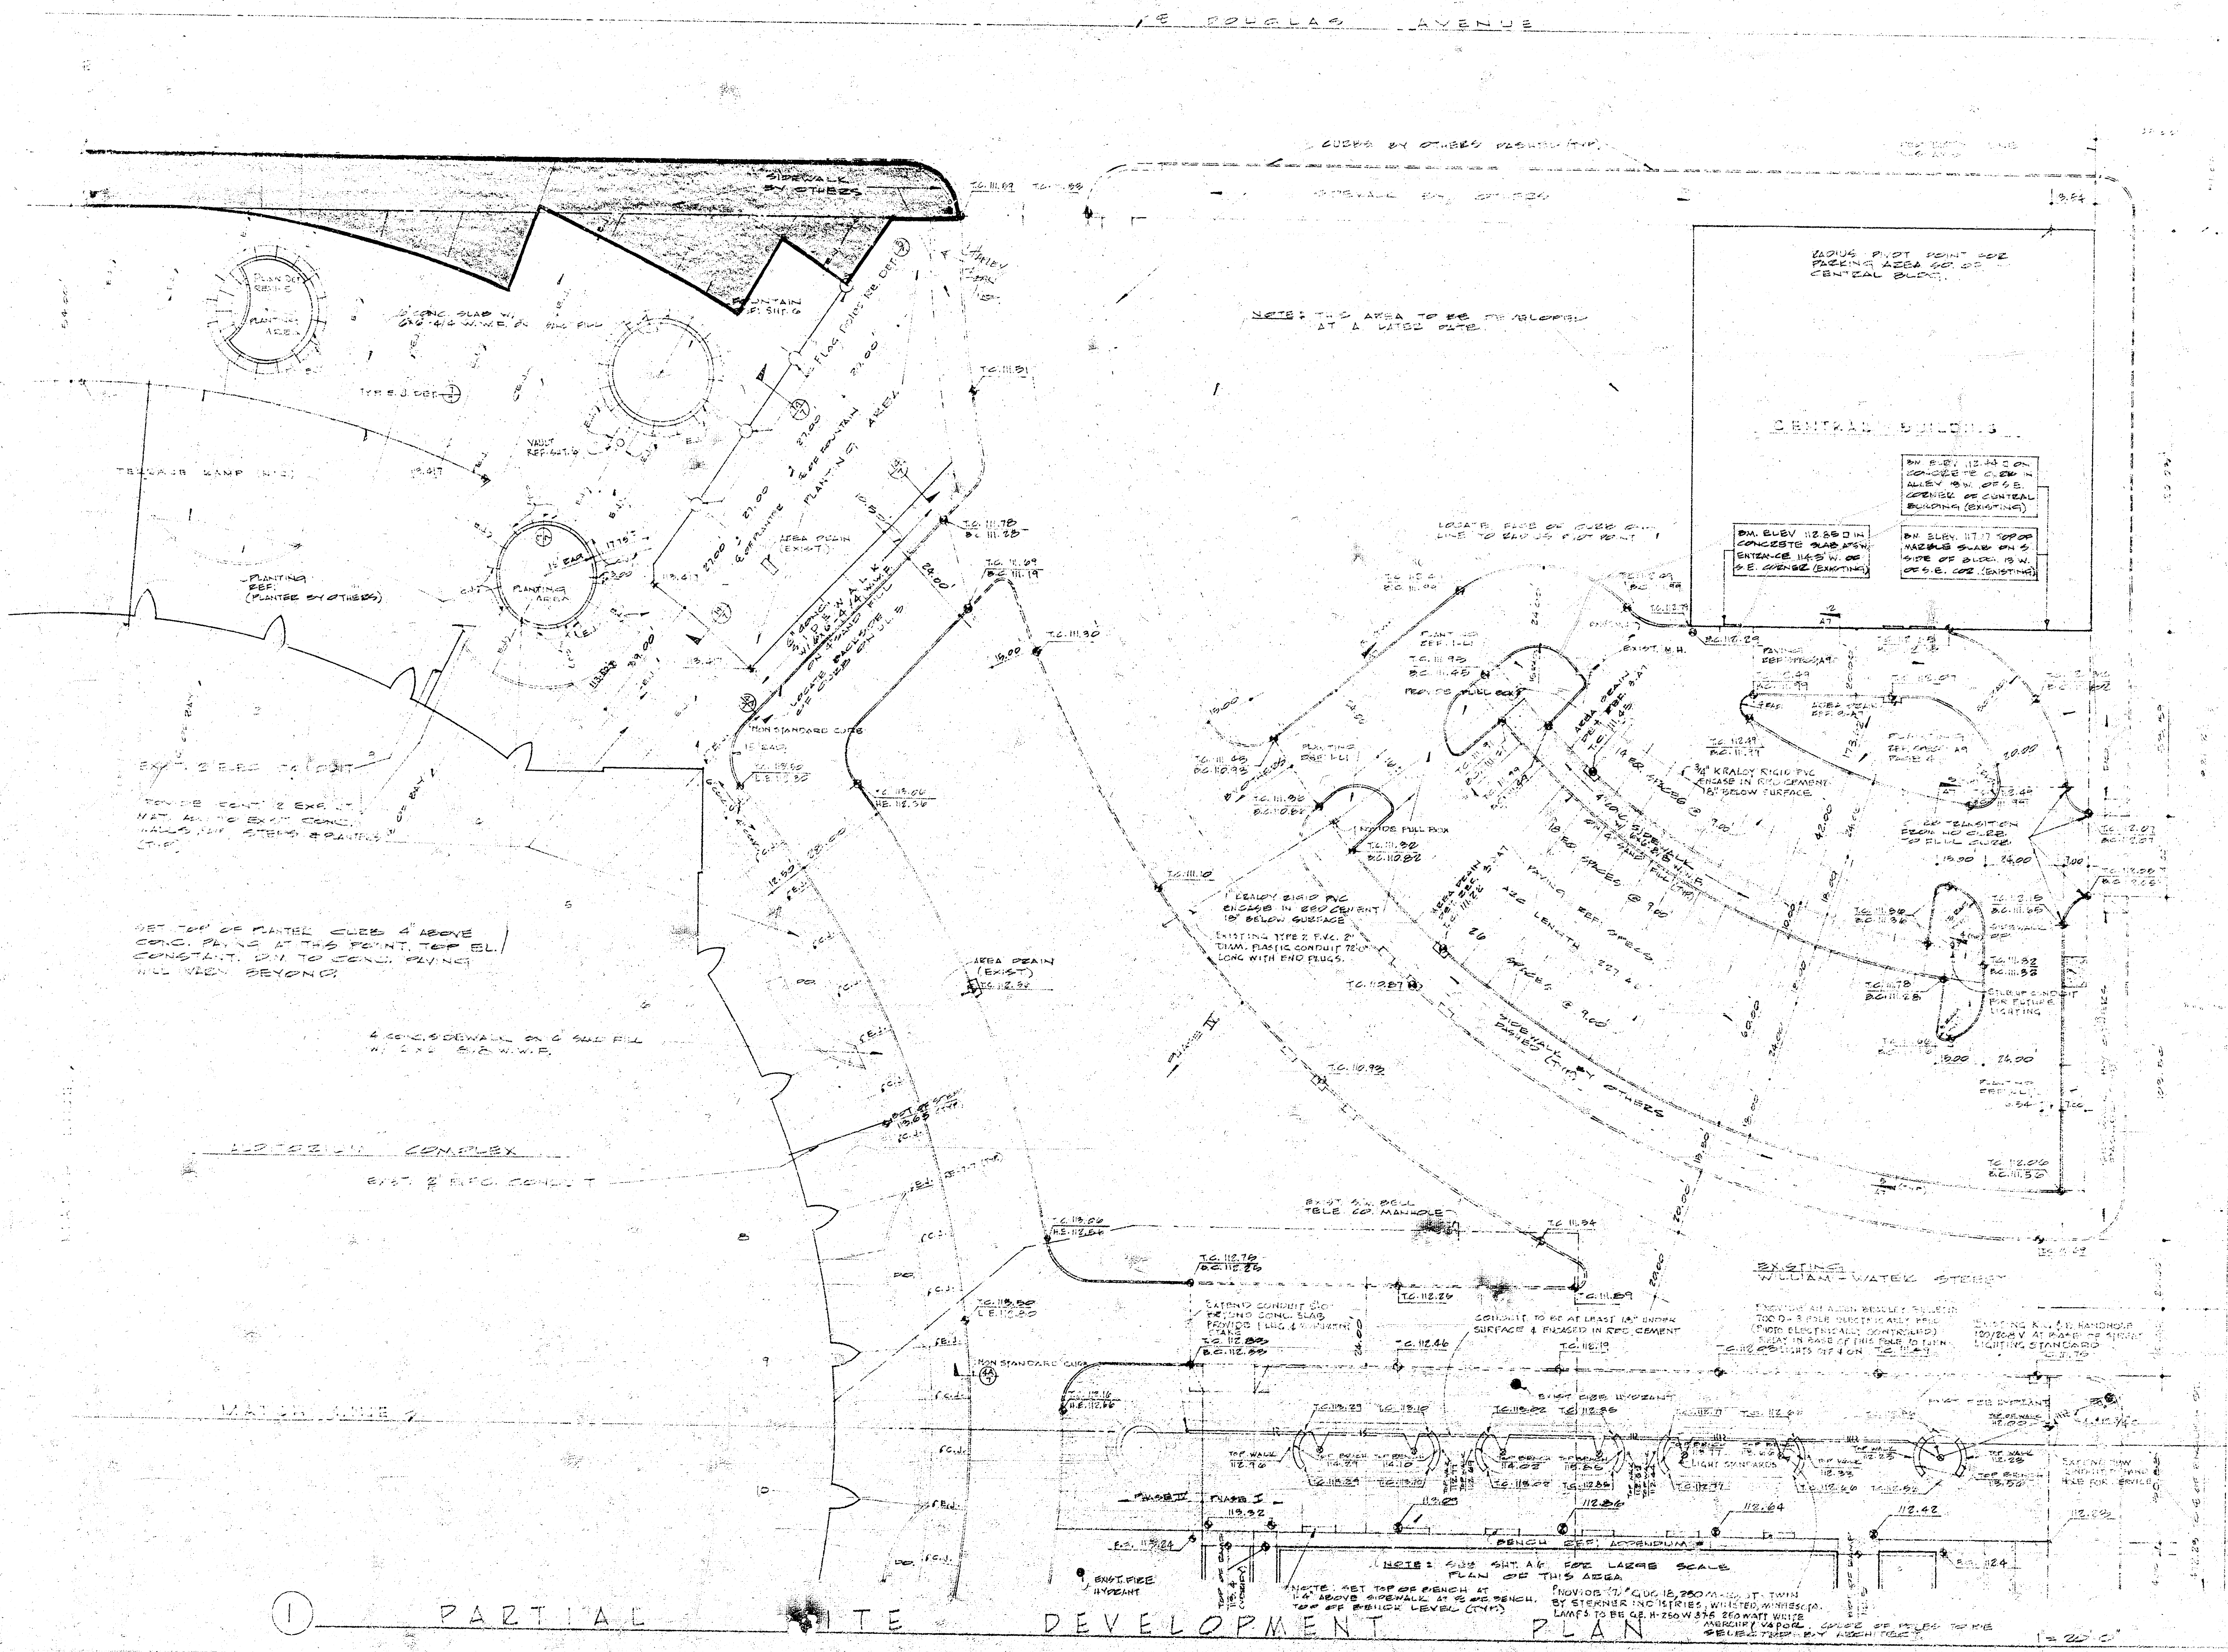

PROGRESS PRINT

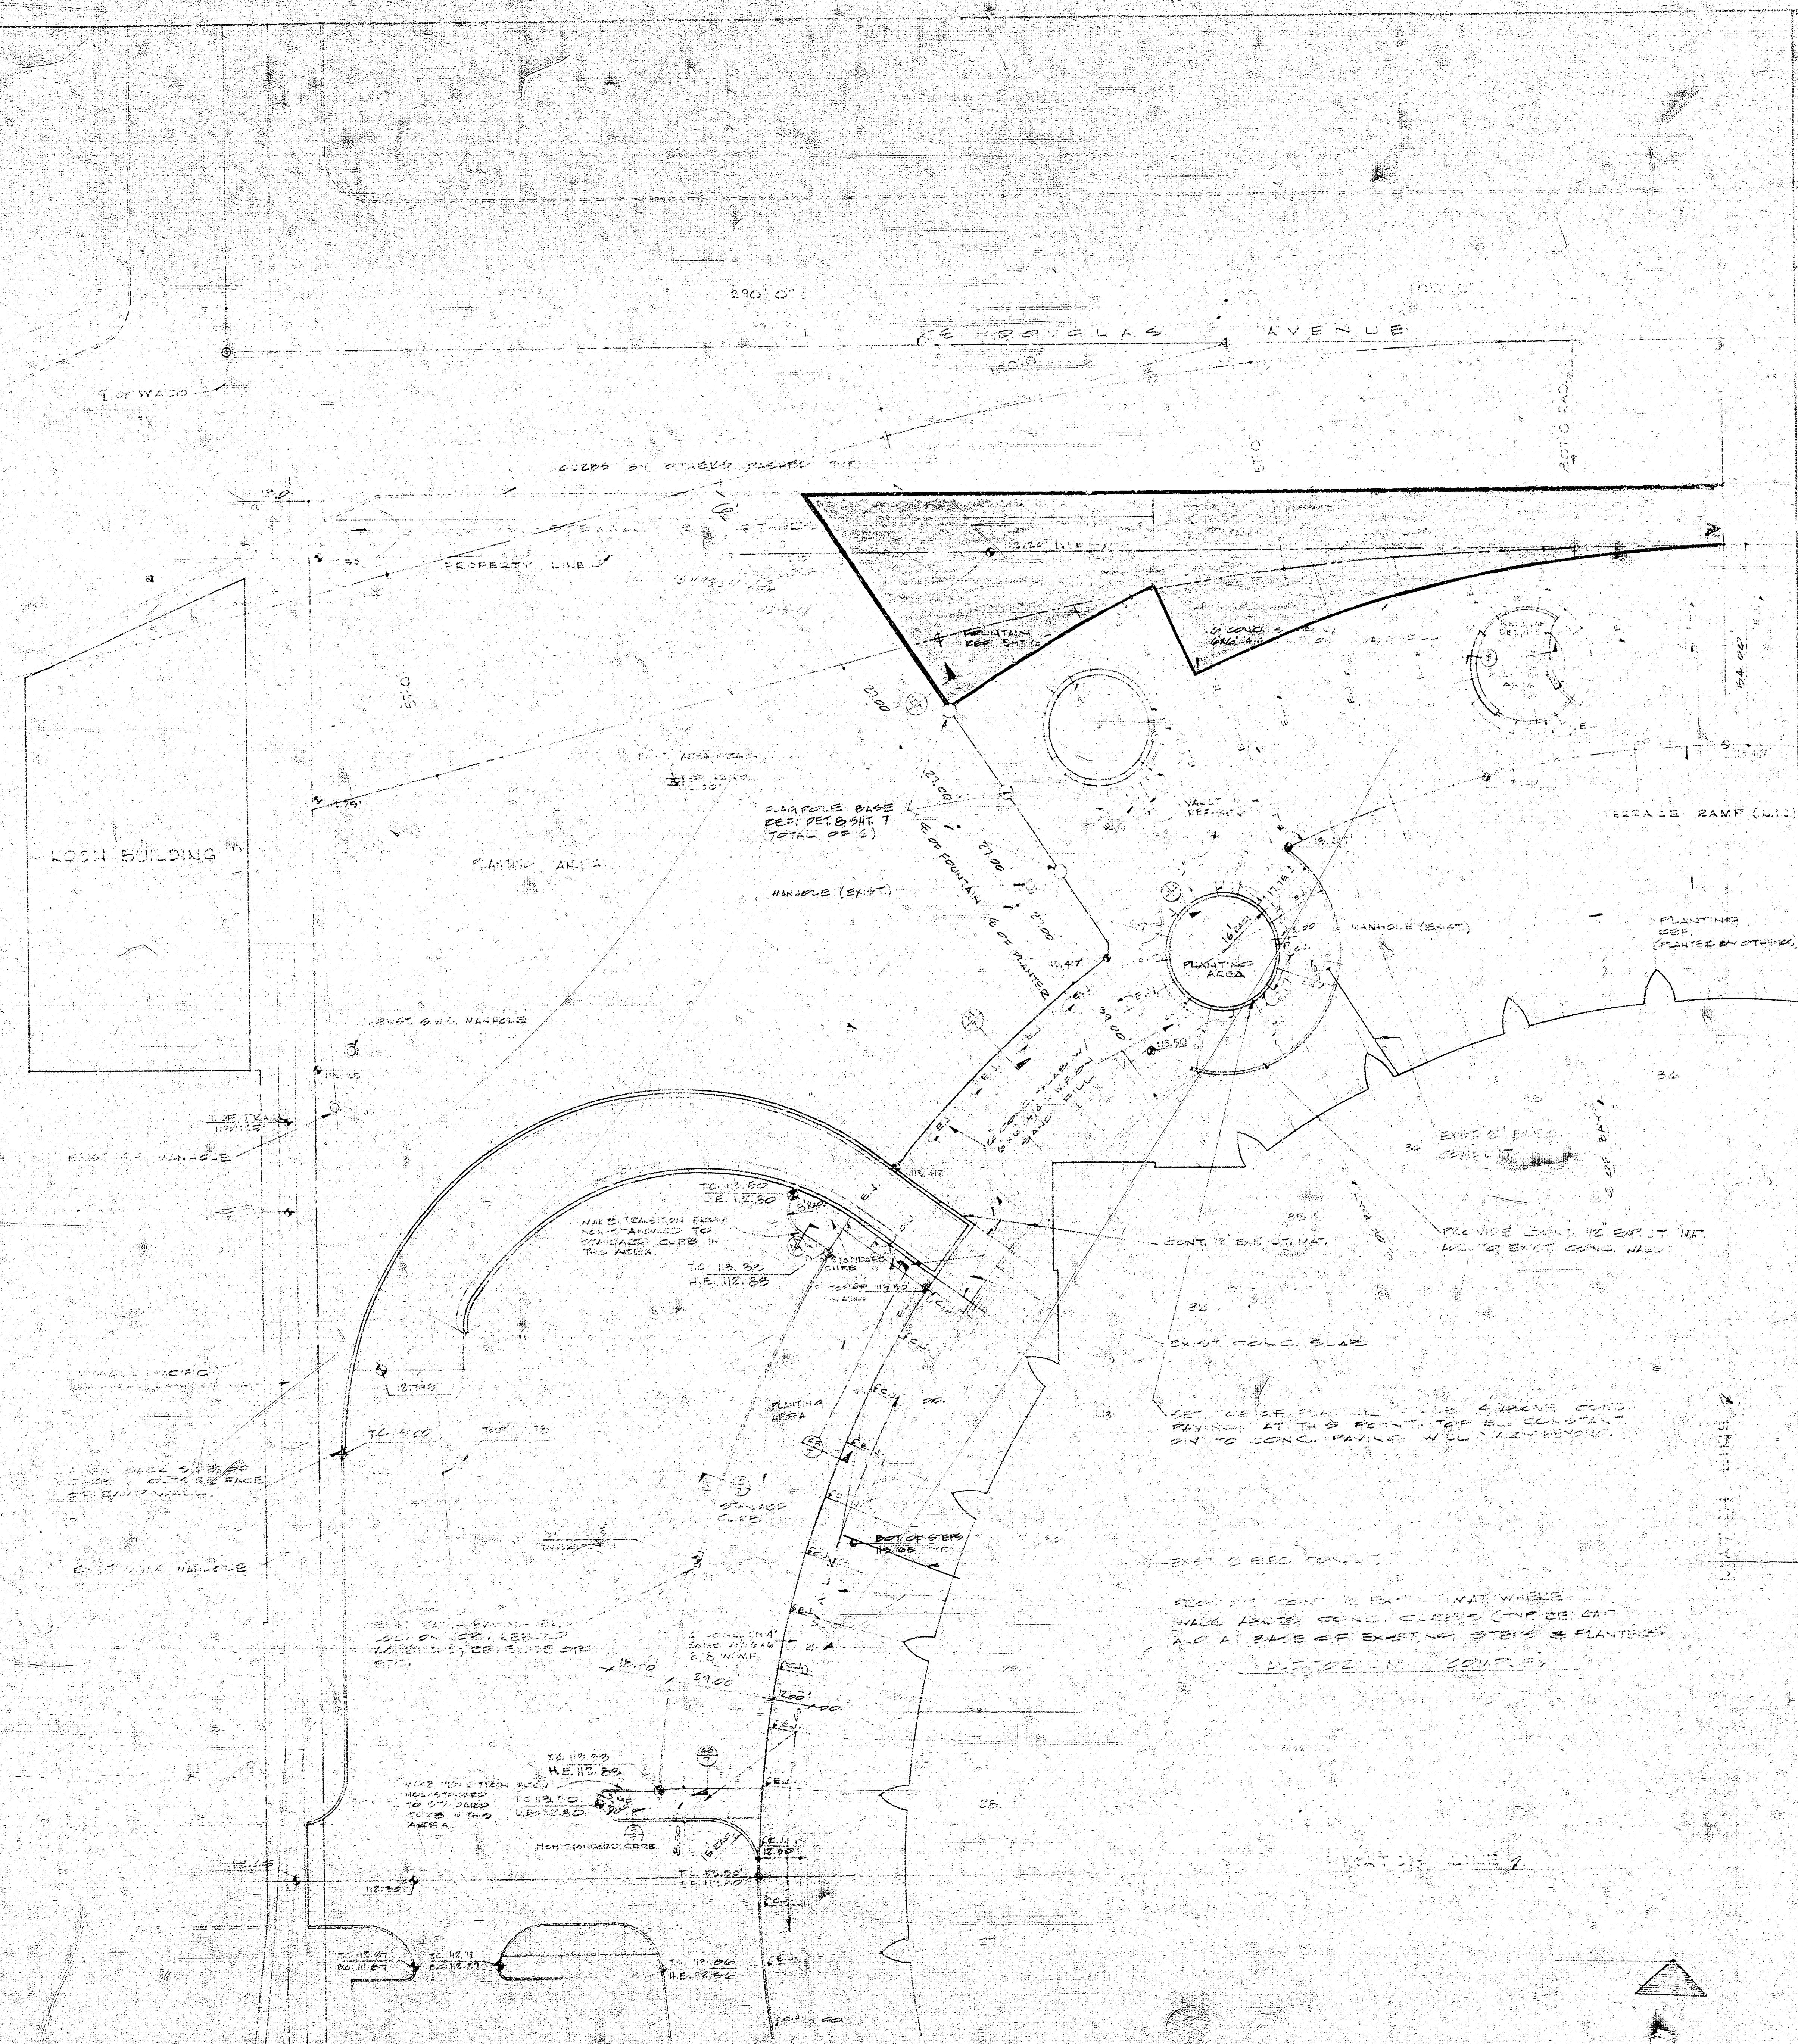

progres print

CIVIC CULTURAL CENTER
CITY OF WICHITA, KANSAS

DATE	4/10/19
REVISION	16