FIN FL GROUND LEVEL ELEV 100.0

DEFINITE

4:1 SLOPE

ROOF BLDG

CENTRAL BLDG

DOCK

TRANSFER CO.

TO BE REVISED

GROUND EL 101.5

SECURITY EL 105.0

SEE 1"=30' DRAWING


NOTE:
ELEVATION SHOWN ARE TENTATIVE
EXCEPT WHERE NOTED DEFINITE

ELEV SHOWN ARE CITY DATUM

PROGRESS PRINT

SITE PLAN
SITE DEVELOPMENT

AUDITORIUM COMPLEX
CIVIC CULTURAL CENTER
CITY OF WICHITA, KANSAS

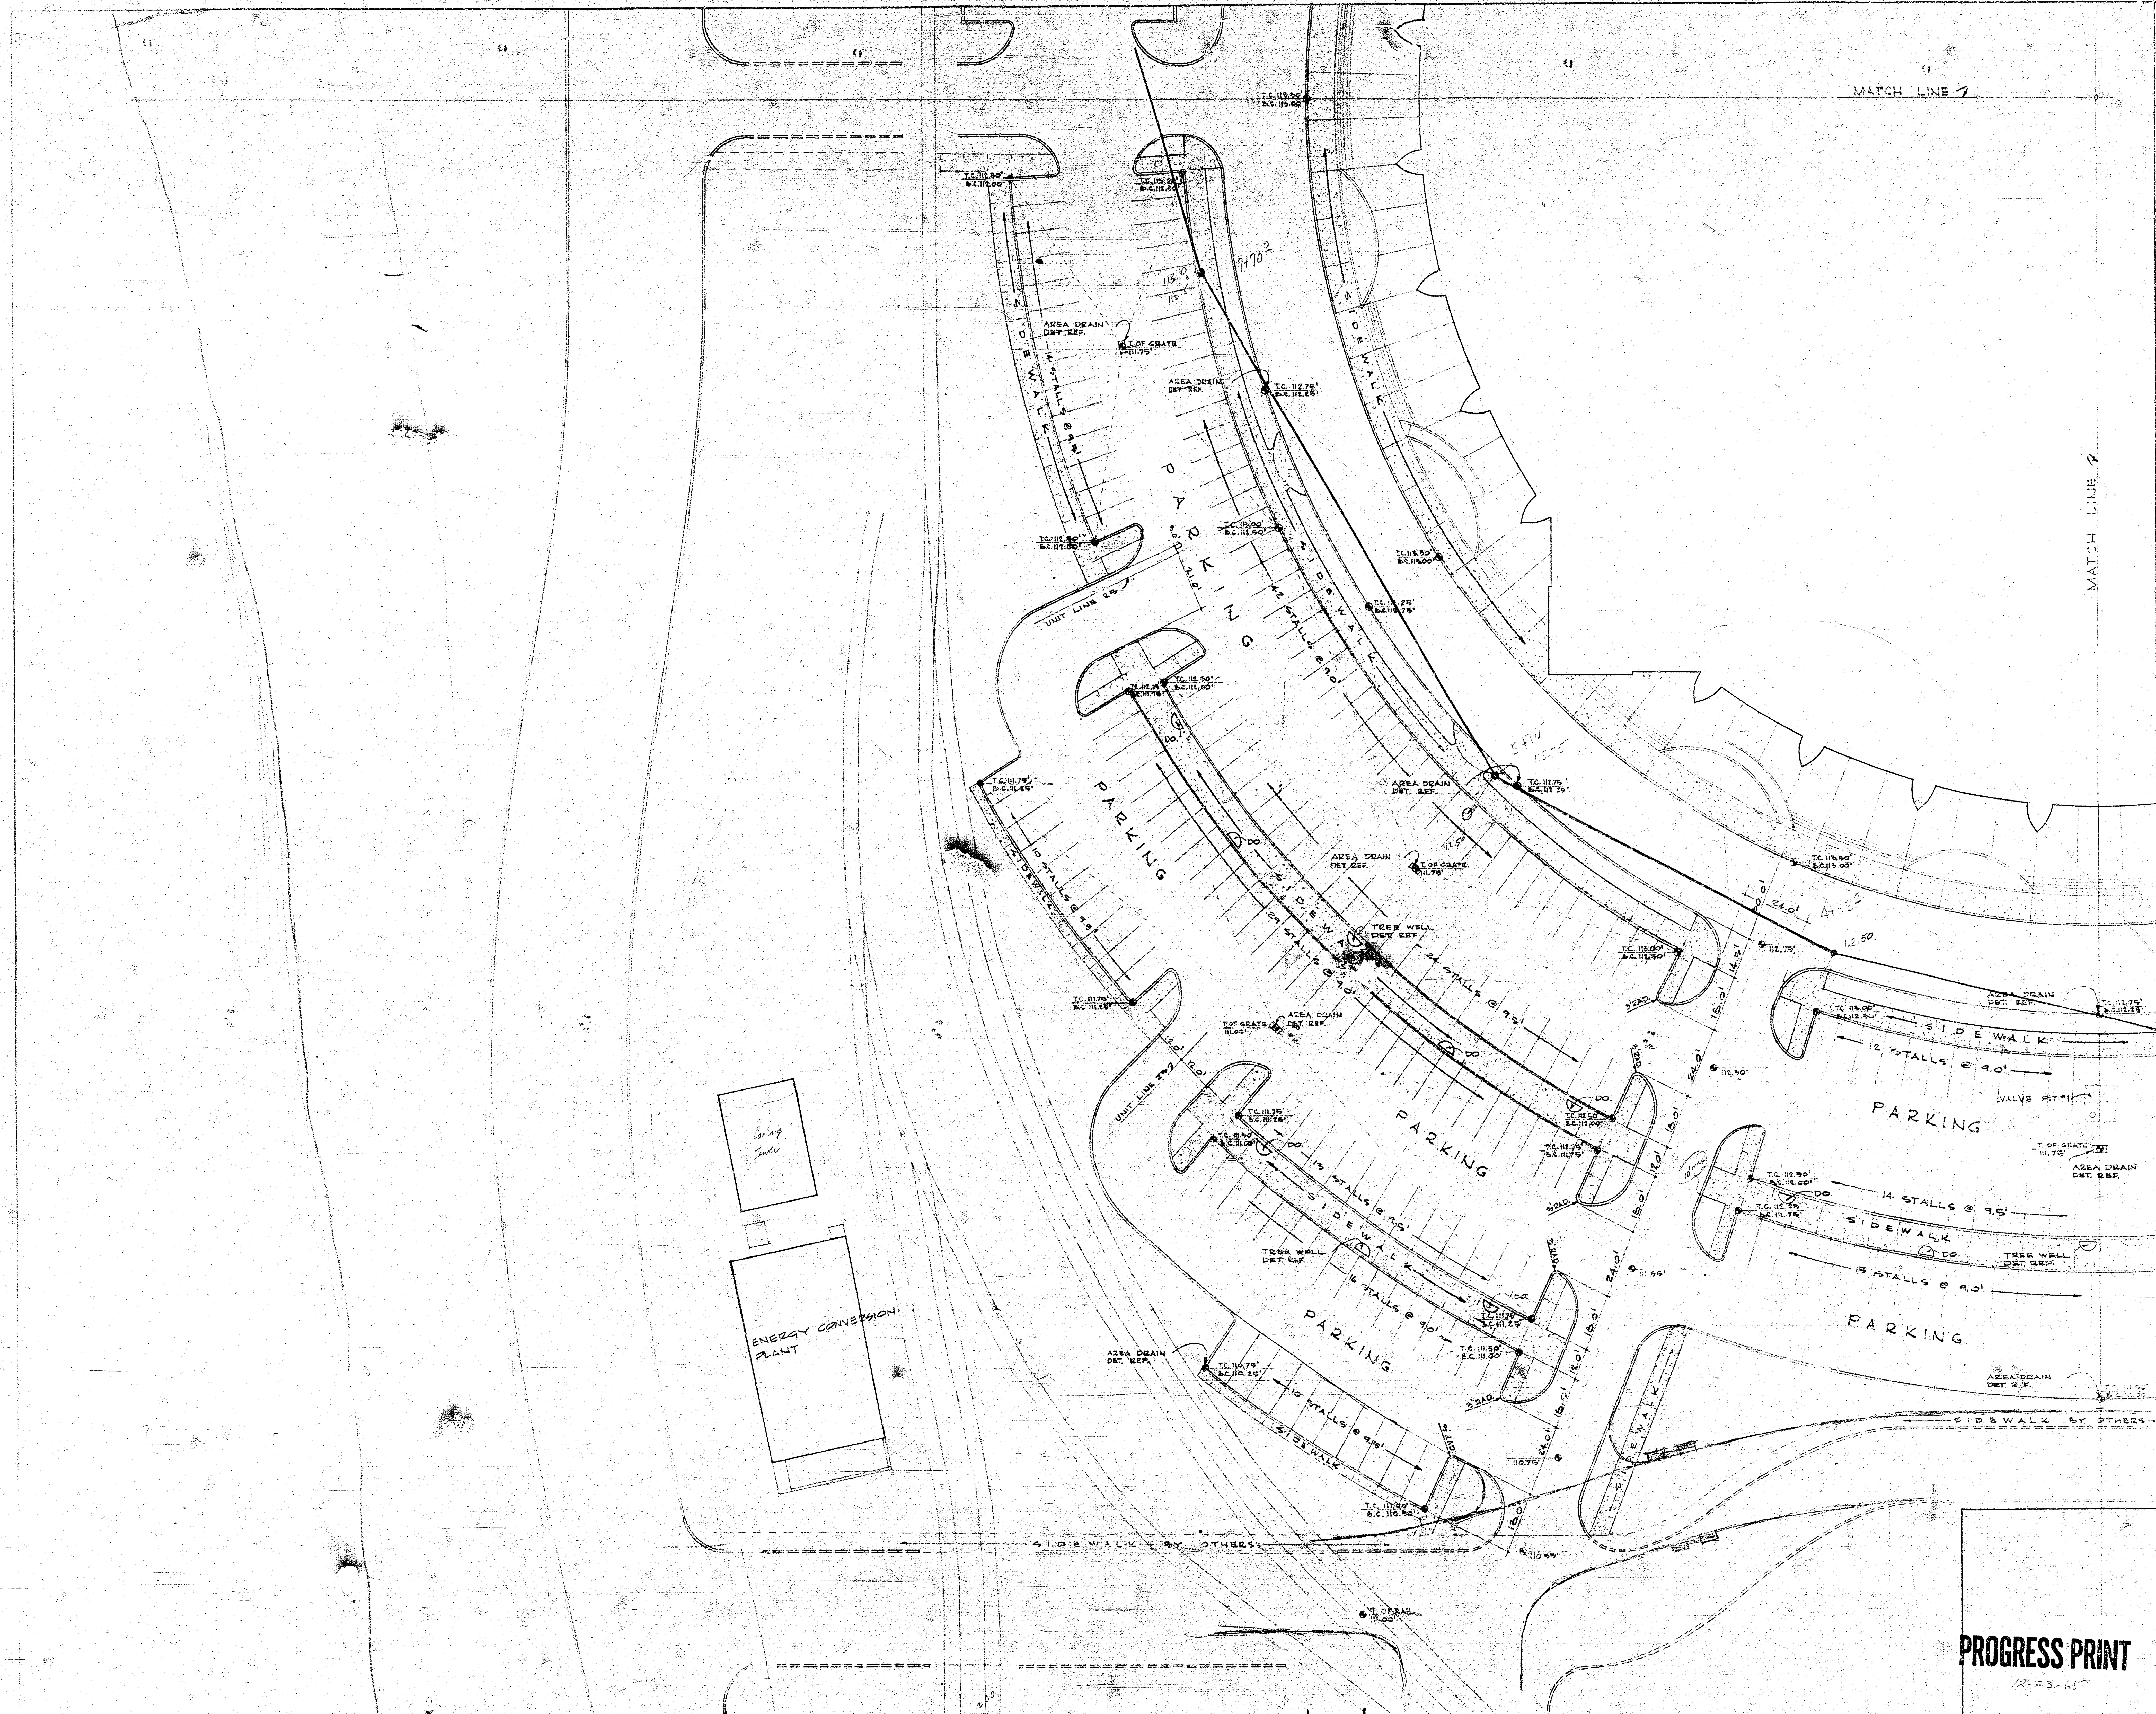

JOHN M. HICKMAN, ASSOCIATES
ROY K. VARENHORST
PROJECT ARCHITECT
KRUSE ROBERTS SMITH
ASSOCIATE ARCHITECTS

CIVIC CULTURAL CENTER
CITY OF WICHITA, KANSAS

DATE | REVISIONS

SHEET NO.

PROGRESS PRINT
12-23-68