


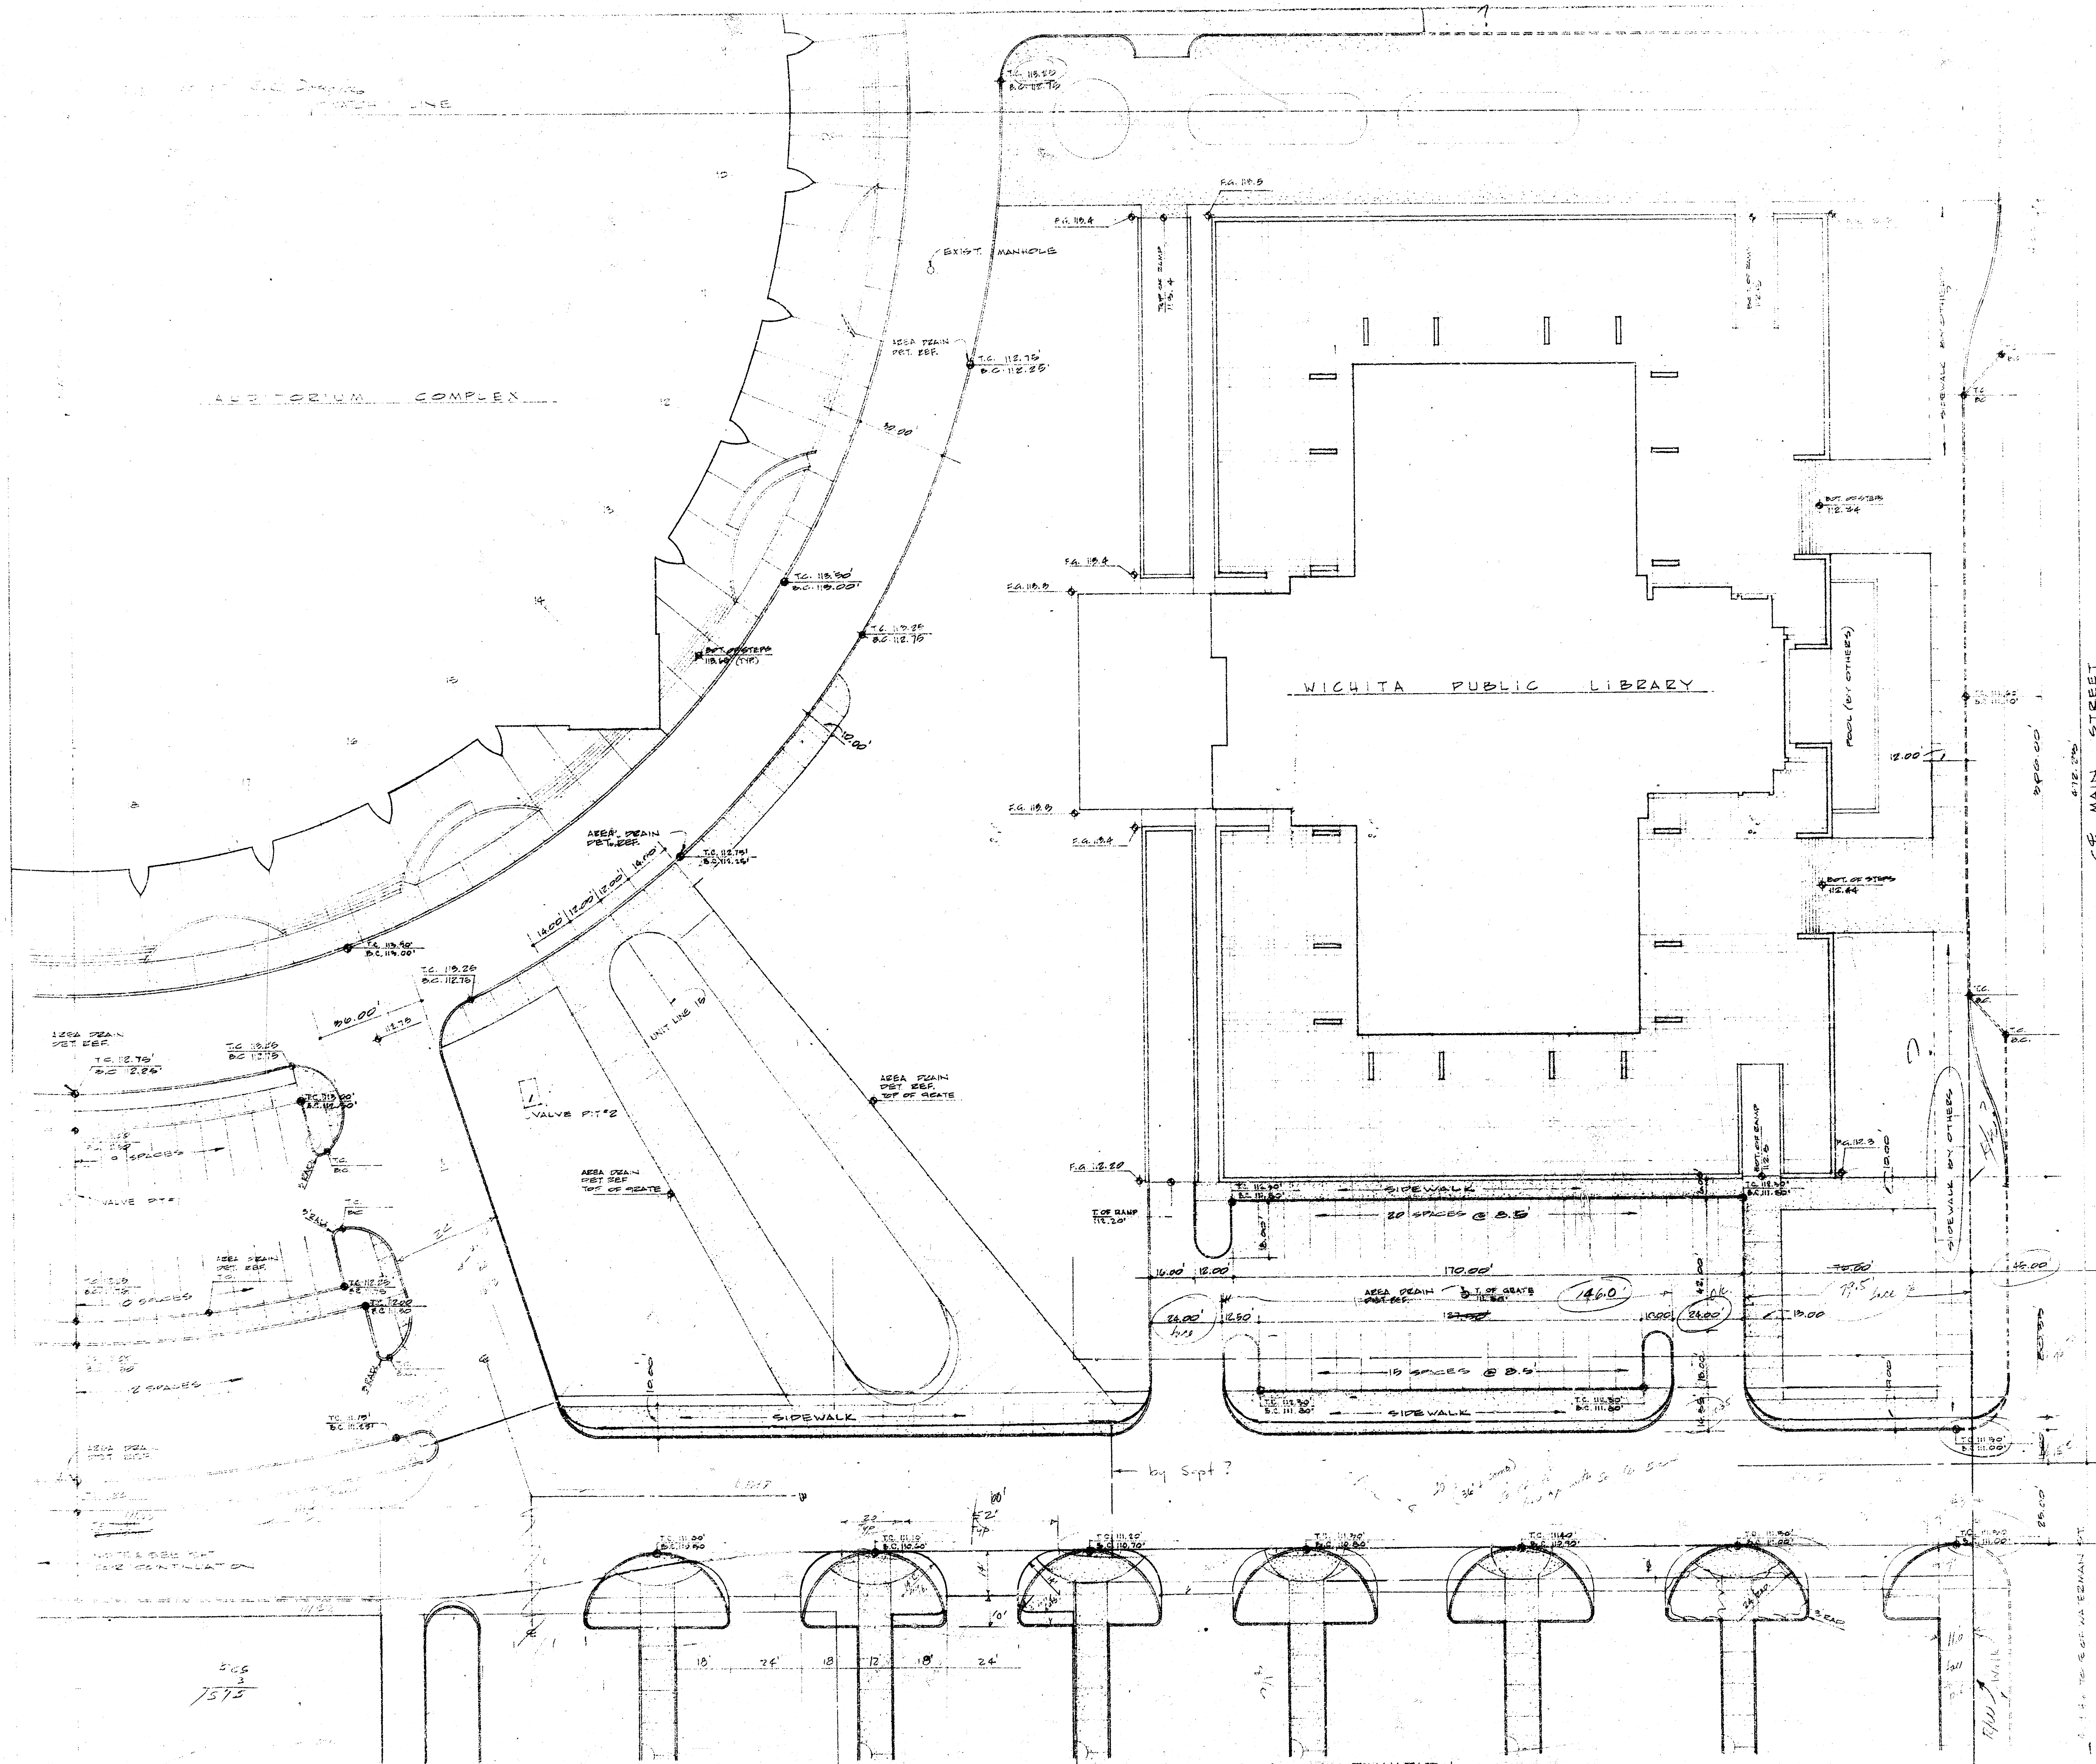

PLAN



