

KOCH BUILDING

6 DOUGLAS AVENUE

PROPERTY LINE

check elevations

FOUNTAIN DET REF

TERRACE RAMP (UN)

VANHOUE DET REF

MANHOLE DET REF

PLANTER

TO RAMP

TO RAMP

AREA OF CONC DET REF


AREA OF CONC DET REF

DET OF CONC DET REF

MATCH LINE 2

PLAN # 1

ST. LOUIS  
CENTRAL  
ST. LOUIS  
CENTRAL  
ST. LOUIS  
CENTRAL

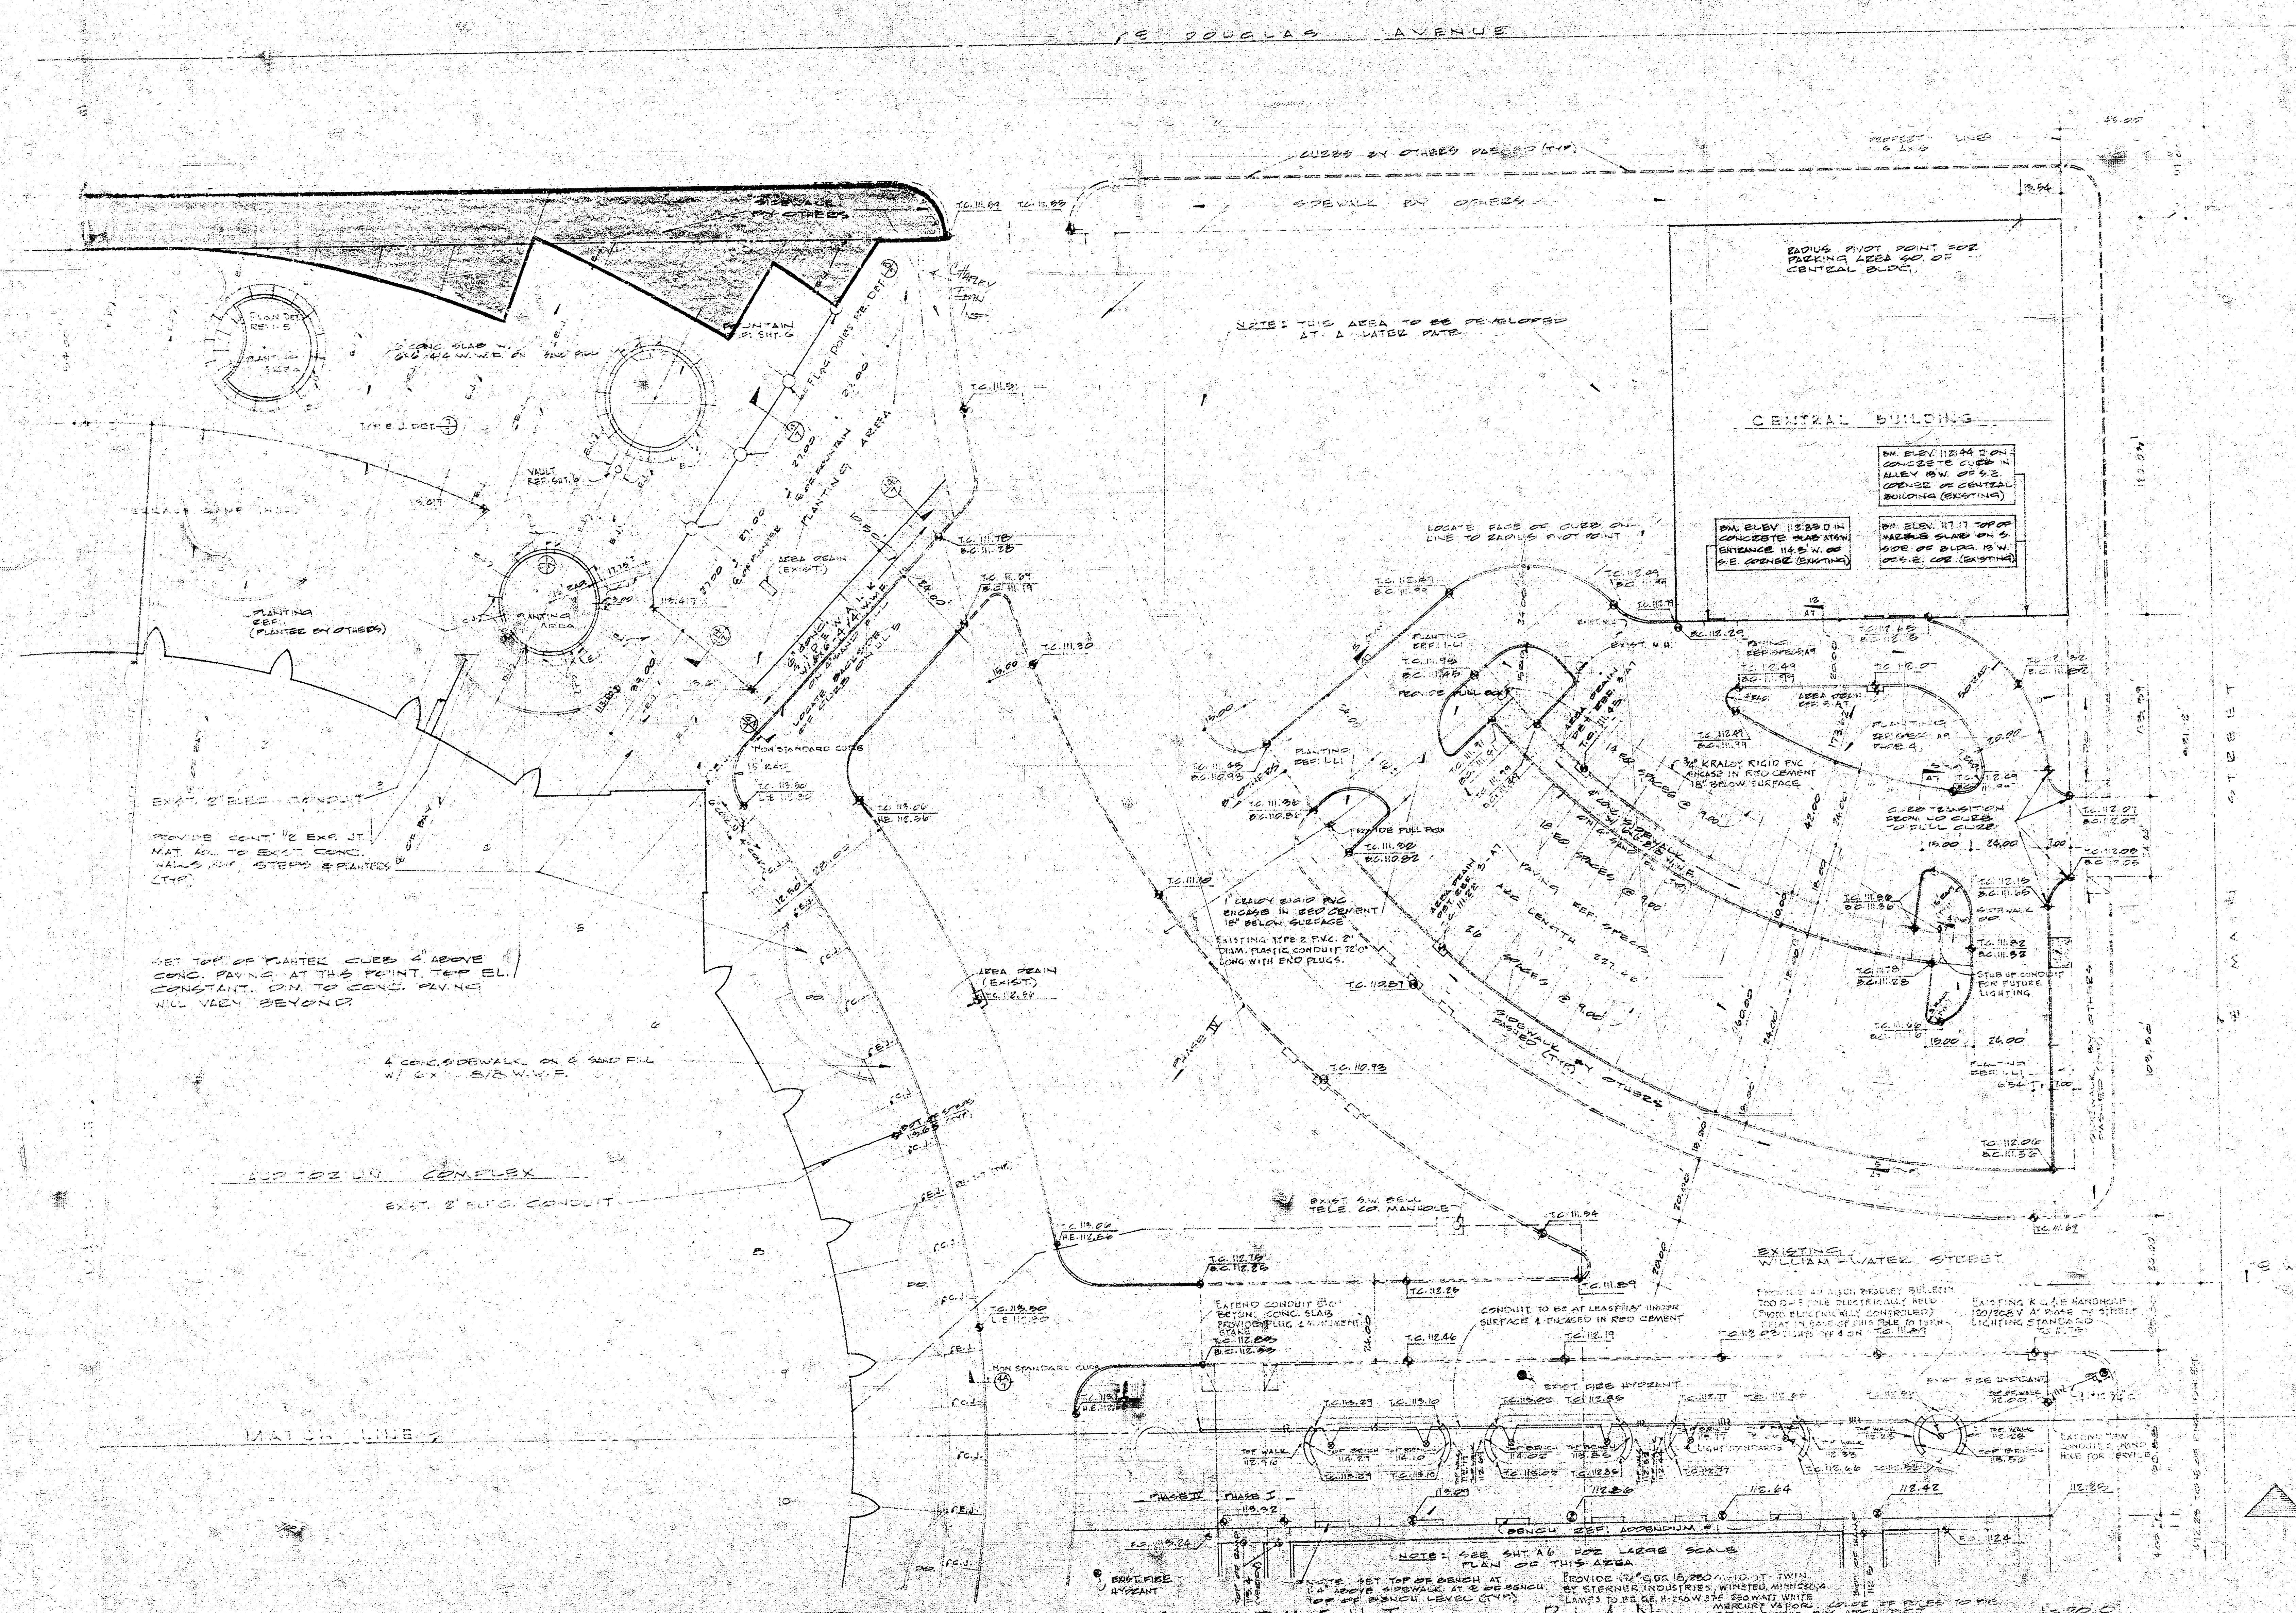

① PARTIAL SITE DEVELOPMENT PLAN

PROGRESS PRINT

THE DEVELOPMENT OF WICHITA, KANSAS

# PARTIAL SITE DEVELOPMENT PLAN

1"=20'-0"

PROCESS PAINT

CIVIC CULTURAL CENTER  
CITY OF WICHITA, KANSAS

| SHEET | DATE    | REVISIONS |
|-------|---------|-----------|
| R-57  | 4-10-60 |           |

ROCK BUILDING

PLANTING AREA

PLANTING AREA

TERACE RAMP (U.I.C.)

PLANTING AREA (EXIST.)

PROVIDE CONTING. EXIST. UT.


EXIST. CONC. SLAB

SEE TOP OF PLANTING AREA & HAVE CONC. PLANTING AT 12.0' POINT. TOP BL. CONSTANT PIN TO CONC. PAVING WILL VARY PERMANENTLY.

EXIST. CONC. SLAB

REMOVE CONC. SLAB THAT WHERE WALK WENTS CONC. SLAB (12' X 12' 6") AND AT EXIST. EXISTING STEPS & PLANTING AND CONC. PLANTING.

WATCH LINE 2

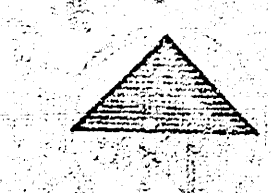

Q. of WAGO

E. DOUGLAS AVENUE

CURBS BY OTHERS PLISHED (TYP)

PROPERTY LINE

PLANTING AREA

MANHOLE (EXIST.)

MANHOLE (EXIST.)

MANHOLE (EXIST.)

EXIST. CONC. SLAB

PROVIDE CONTING. EXIST. UT.

PROVIDE CONTING. EXIST. UT.

