



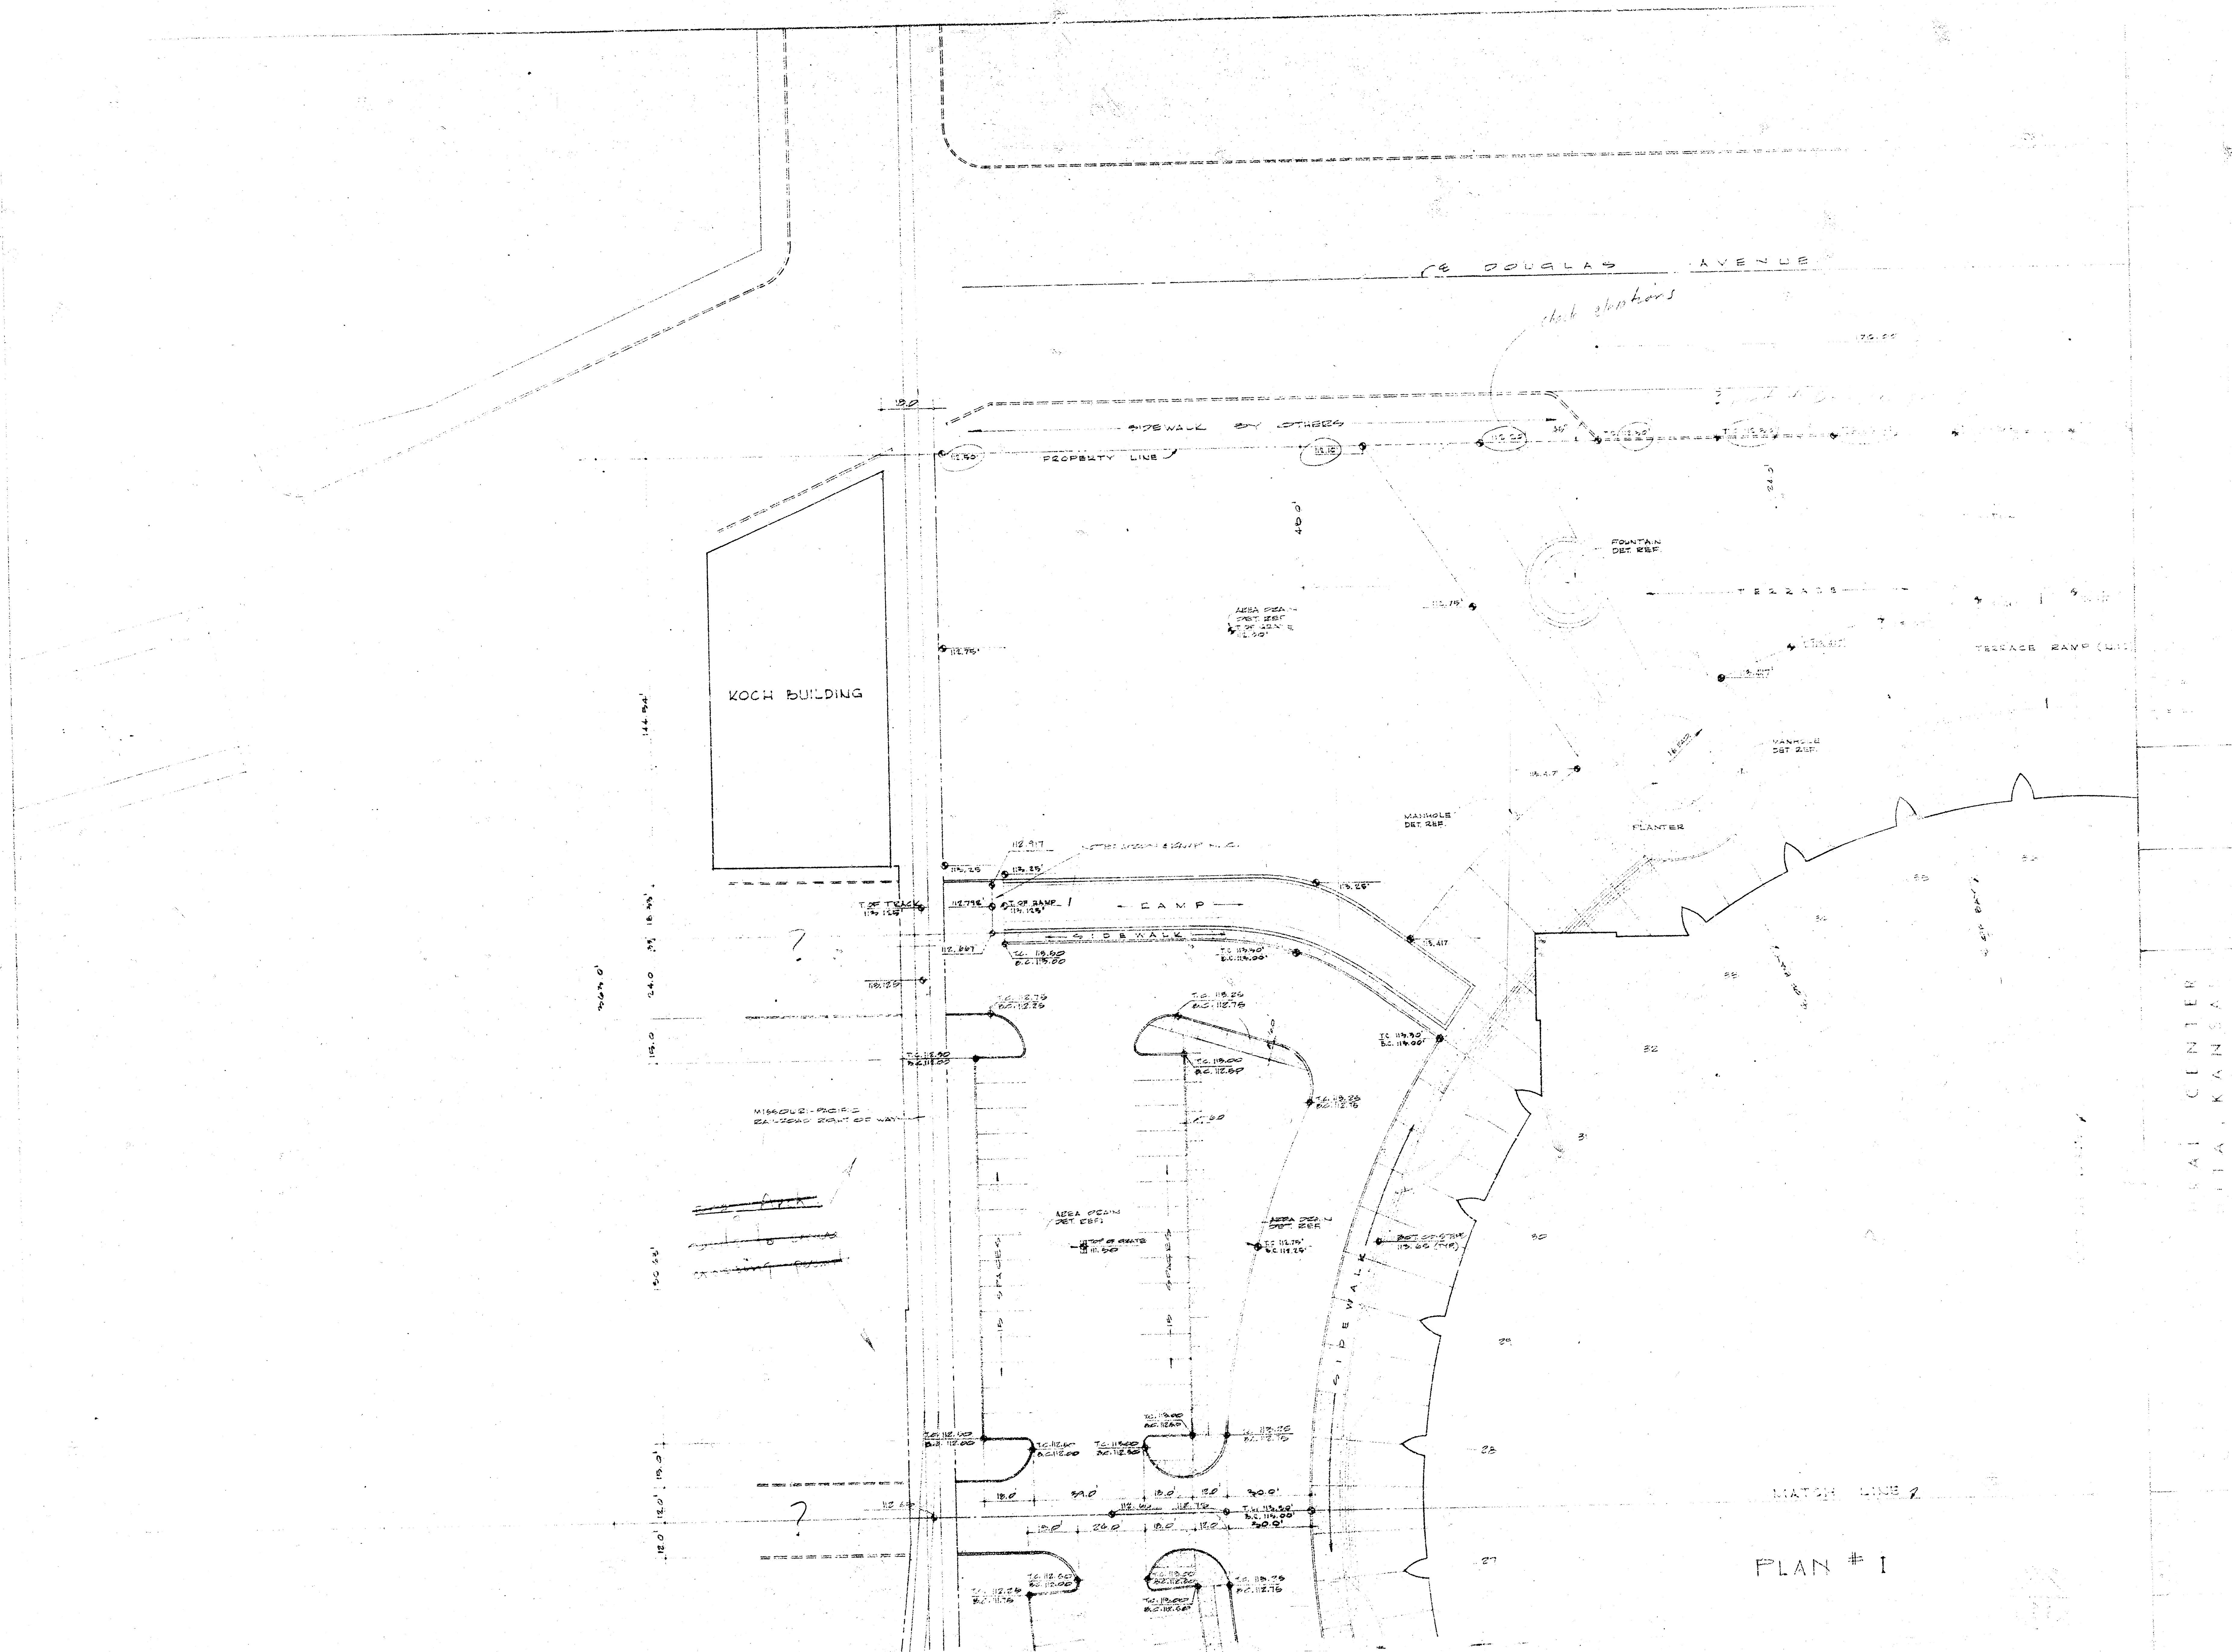

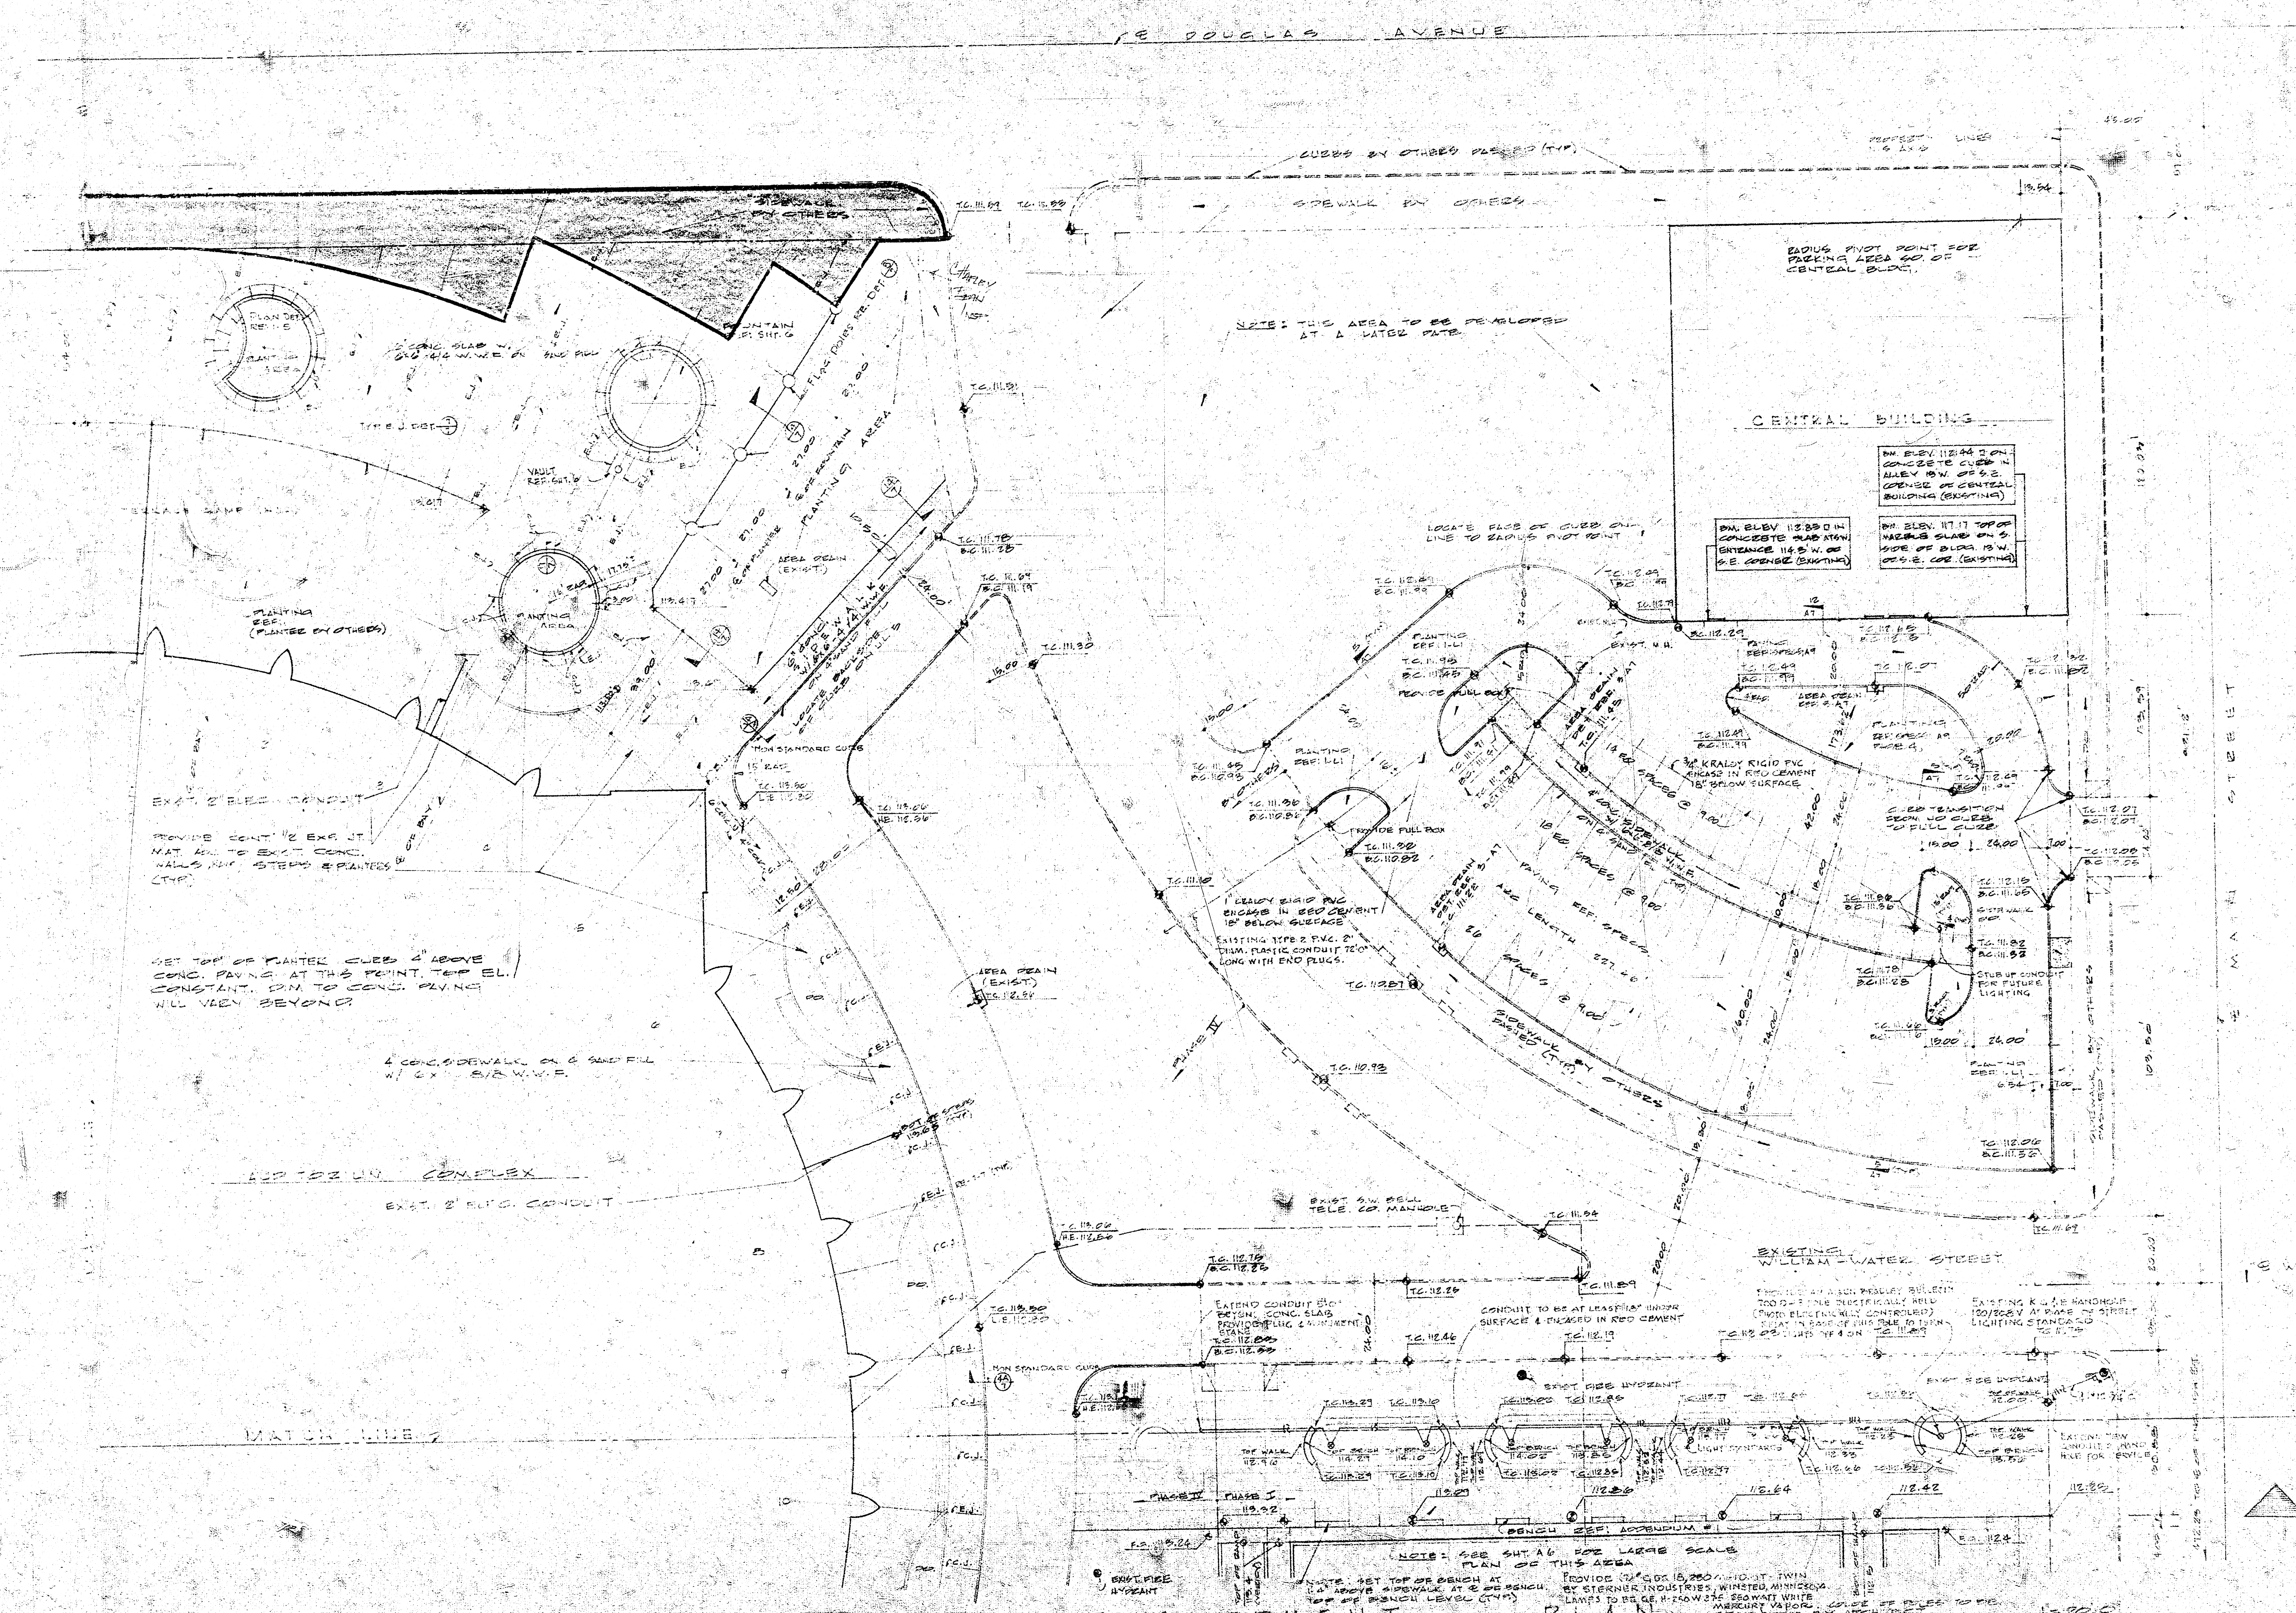

① PARTIAL SITE DEVELOPMENT PLAN

PROGRESS PRINT

CITY OF WICHITA, KANSAS

PARTIAL SITE DEVELOPMENT PLAN

1"=20'-0"

PROCESS PAINT

CIVIC CULTURAL CENTER
CITY OF WICHITA, KANSAS

SHEET	DATE	REVISIONS
R-57	4-10-60	


PLANTING AREA

PLANTING AREA

TERACE RAMP (U.I.C.)

PLANTING AREA (EXIST.)

PROVIDE CONTINGENT EXIST. UT.

EXIST. CONC. SLAB


SEE TOP OF PLANTING AREA & HAVE CONC. PLANTING AT 1.0' POINT. TOP BL. CONSTANT PIN TO CONC. PAVING WILL VARY PERMANENTLY.

EXIST. CONC. SLAB

REMOVE CONC. SLAB THAT WHERE WALK WALKS CONC. SLAB (TOP OF SLAB) AND AT EXIST. EXISTING STEPS & PLANTING.

ADD CONC. SLAB

WATER LINE 2'

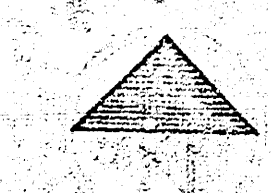


E. DOUGLAS AVENUE

CURBS BY OTHERS PLISHED (TYP)

PROPERTY LINE

PLANTING AREA

MANHOLE (EXIST.)

MANHOLE (EXIST.)

EXIST. CONC. SLAB

PROVIDE CONTINGENT EXIST. UT.

PROVIDE CONTINGENT EXIST. UT.

