

CENTRAL AVENUE DAM- WICHITA, KANSAS.

SCALE 1"=10'

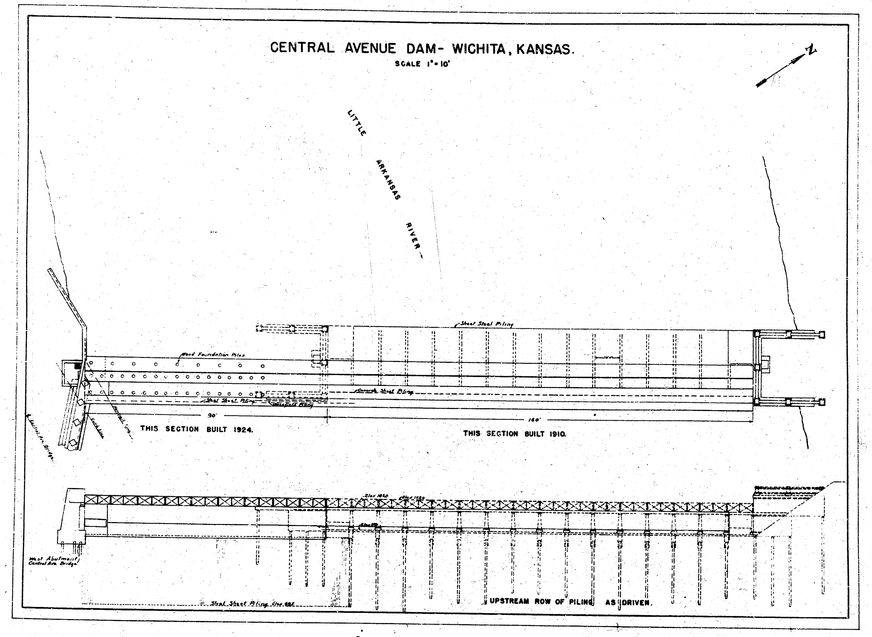


CENTRAL AVENUE DAM- WICHITA, KANSAS.

SCALE 1"=10'

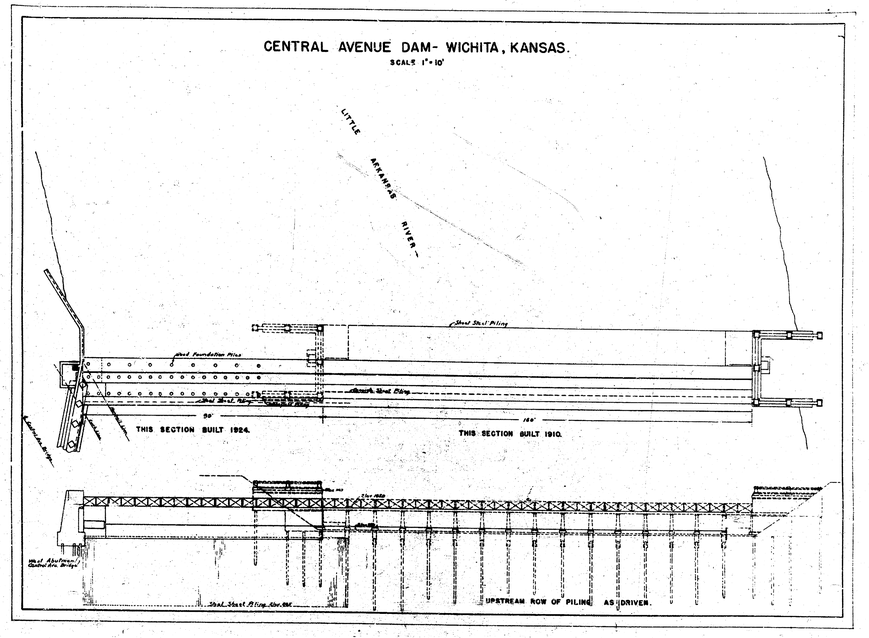


CENTRAL AVENUE DAM - WICHITA, KANSAS.

SCALE 1"=10'

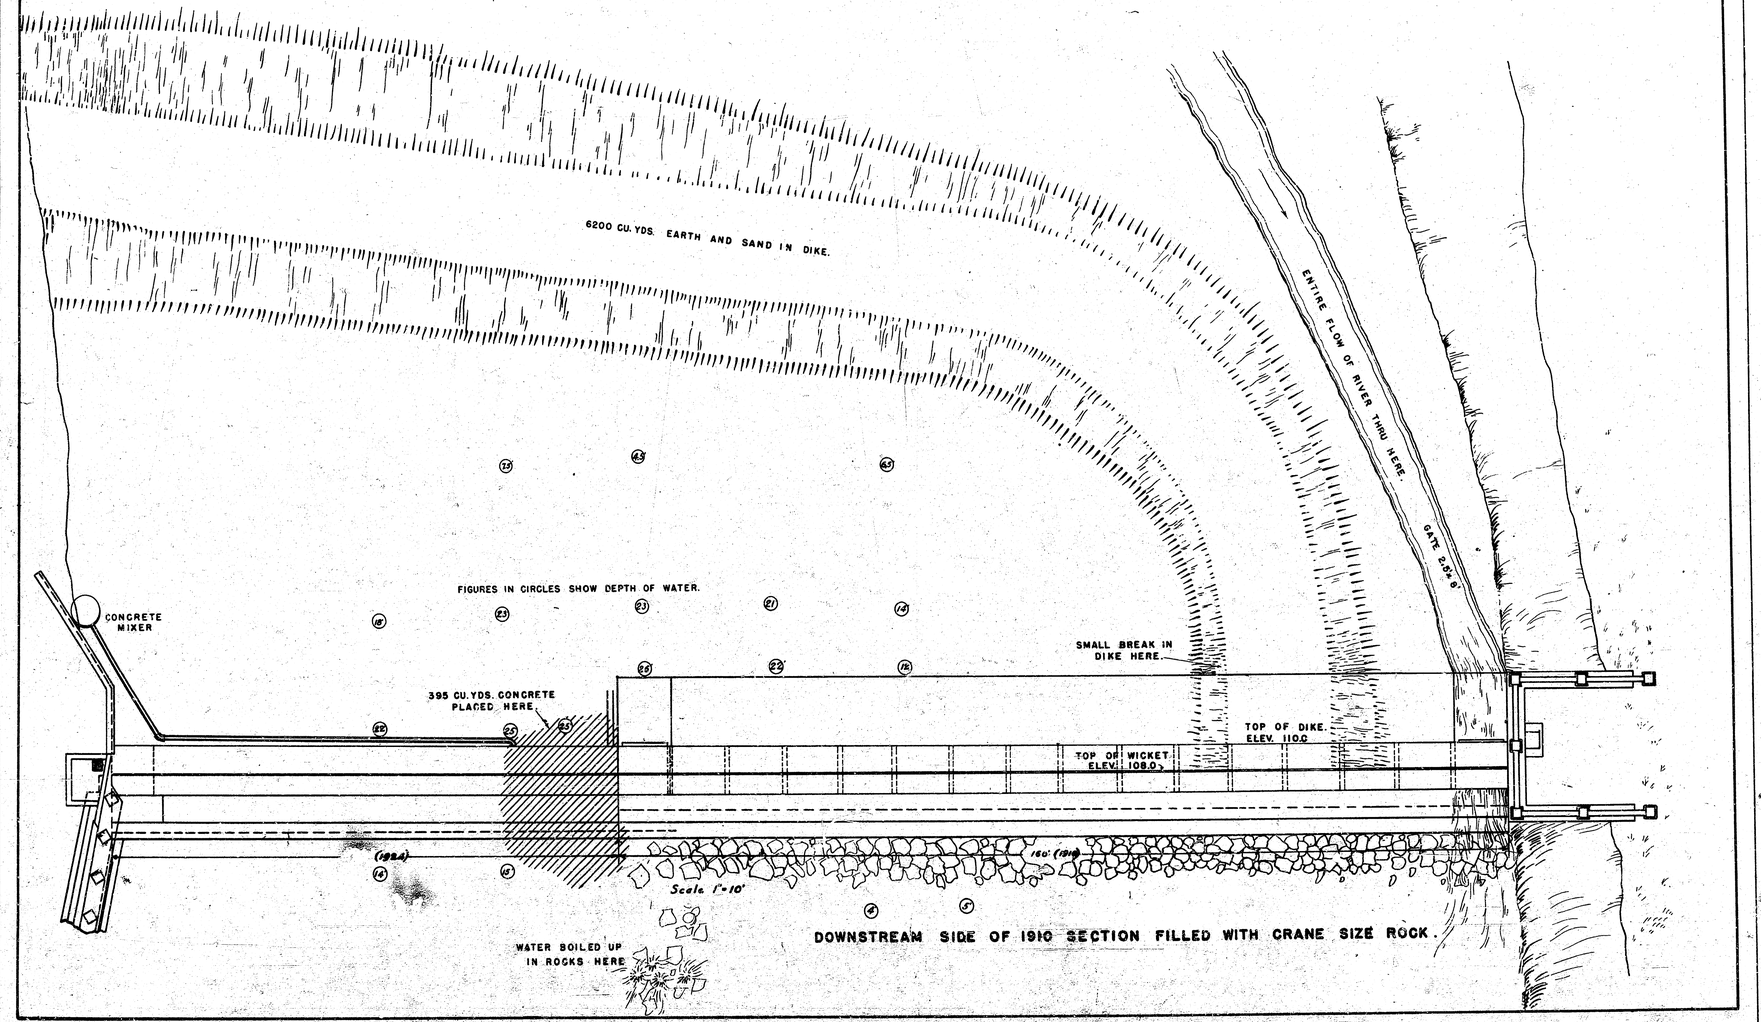

CENTRAL AVENUE DAM - WICHITA, KANSAS.


SCALE 1"=10'

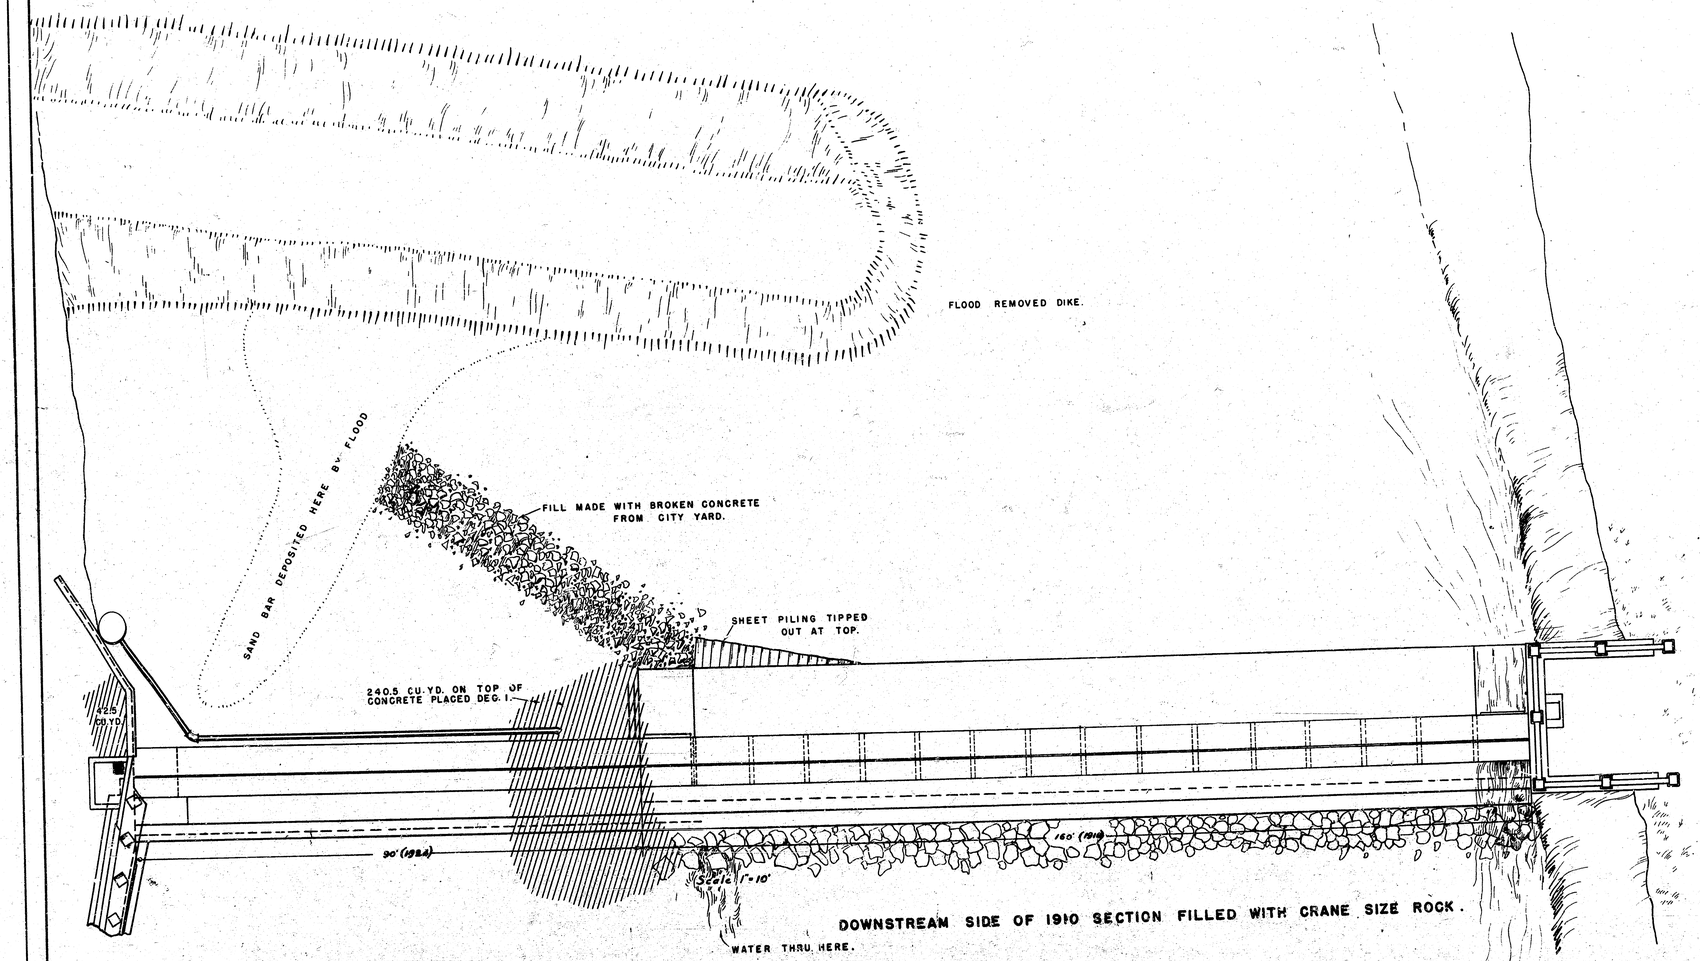


DOWNSTREAM SIDE OF 1910 SECTION FILLED WITH CRANE SIZE ROCK.

CENTRAL AVENUE DAM - WICHITA, KANSAS.

SCALE 1"=10'

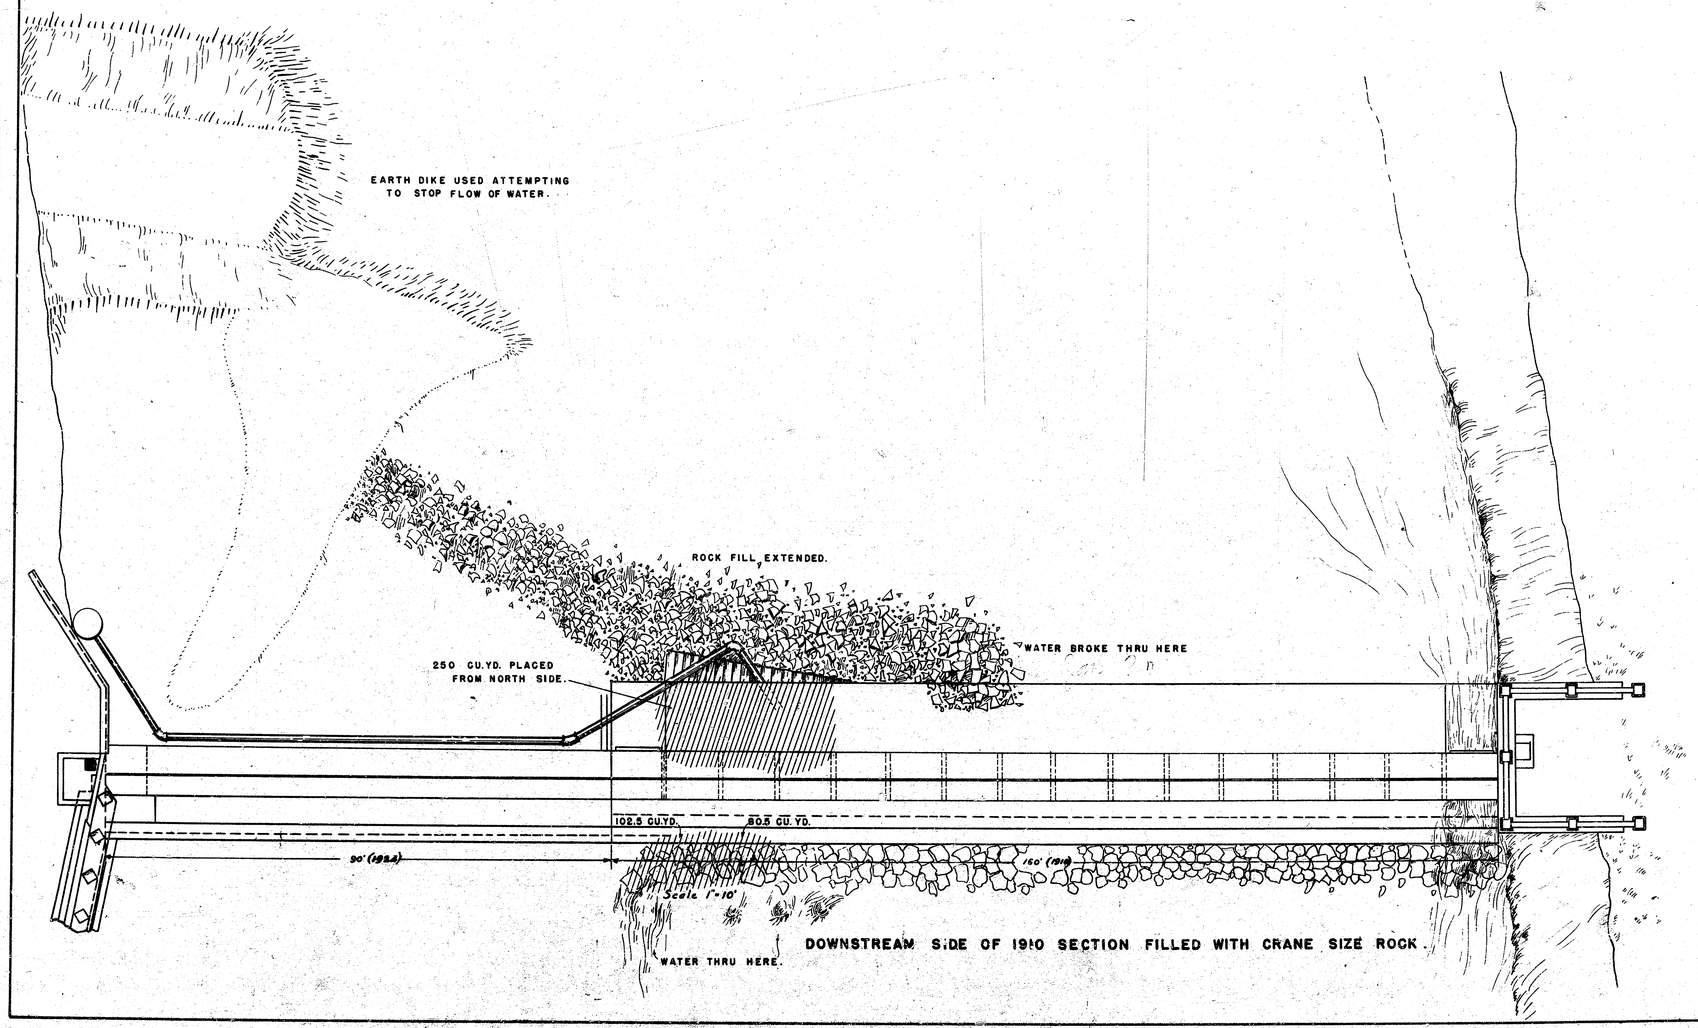


DOWNSTREAM SIDE OF 1910 SECTION FILLED WITH CRANE SIZE ROCK.

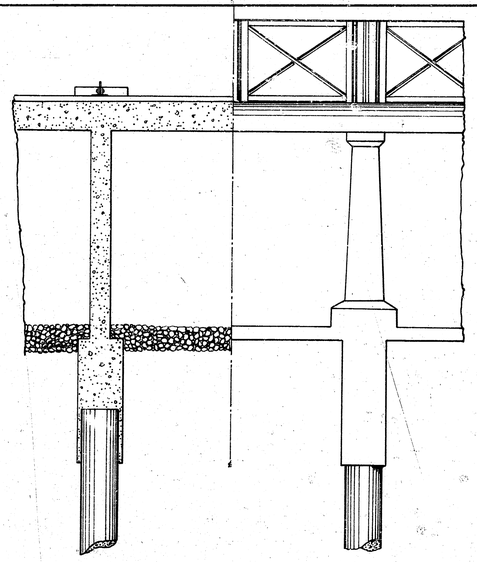

ELEVATION & SECTION - DOWNSTREAM SIDE.
BUILT 1910.

CENTRAL AVENUE DAM - WICHITA, KANSAS.

SCALE ½" = 1'

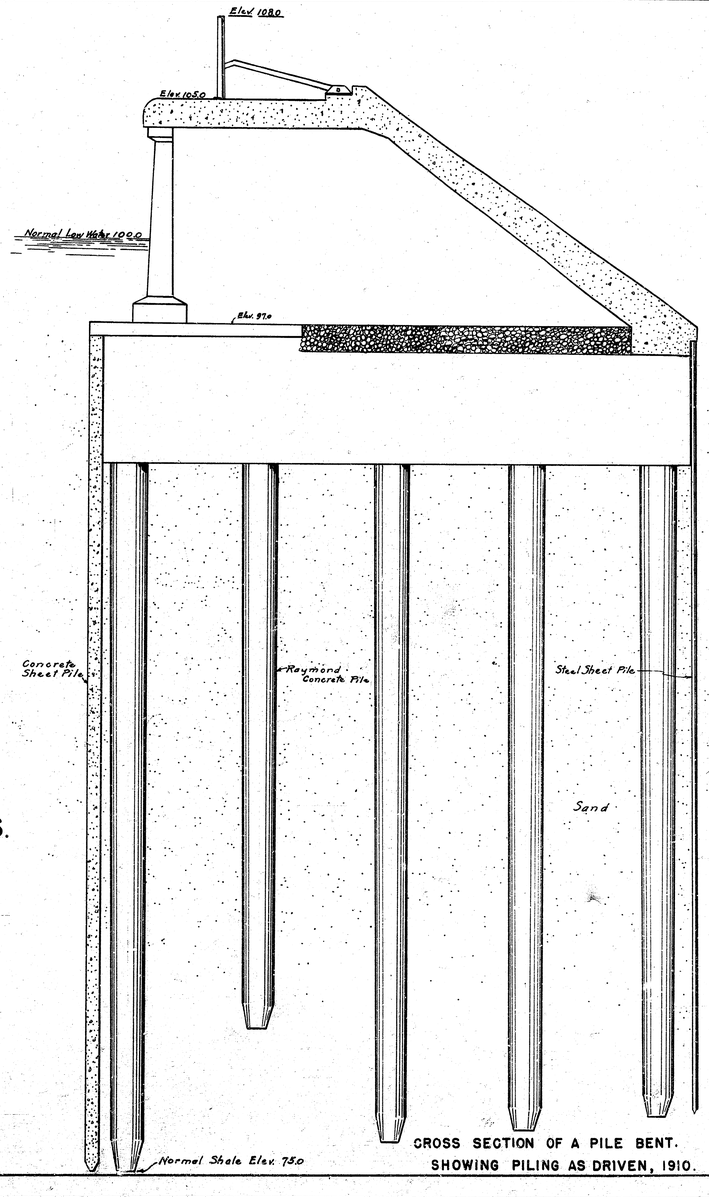


CROSS SECTION OF A PILE BENT.
SHOWING PILING AS DRIVEN, 1910.

Elevations and Section Downstream side
1911


Cross Section of a Pile Bent showing piling as driven

CENTRAL AVENUE DAM - WICHITA, KANSAS.

SCALE $\frac{1}{4}$" = 1'

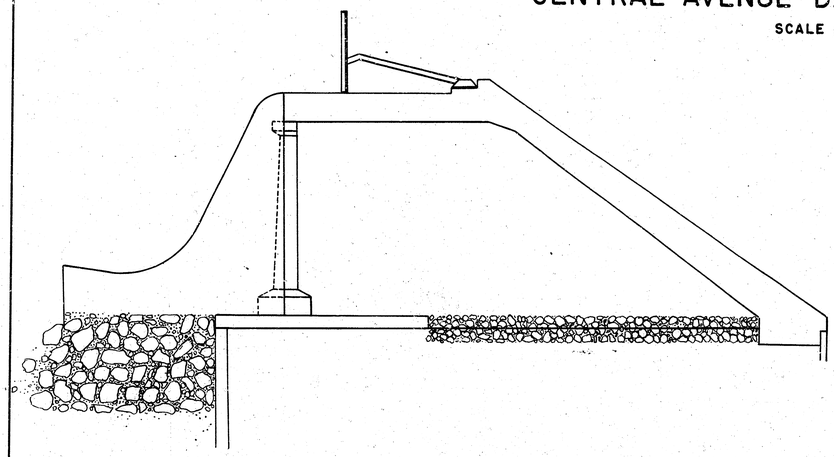


CROSS SECTION OF OGEE SECTION ADDED TO FIRST SECTION IN 1924.

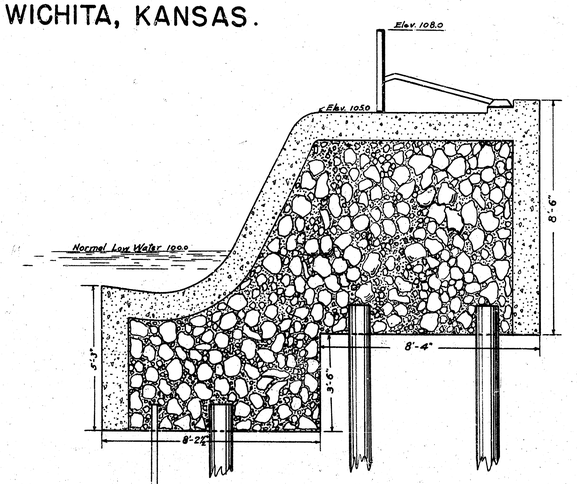

CROSS SECTION 1924 ADDITION.

CENTRAL AVENUE DAM - WICHITA, KANSAS.


SCALE 1"=10'

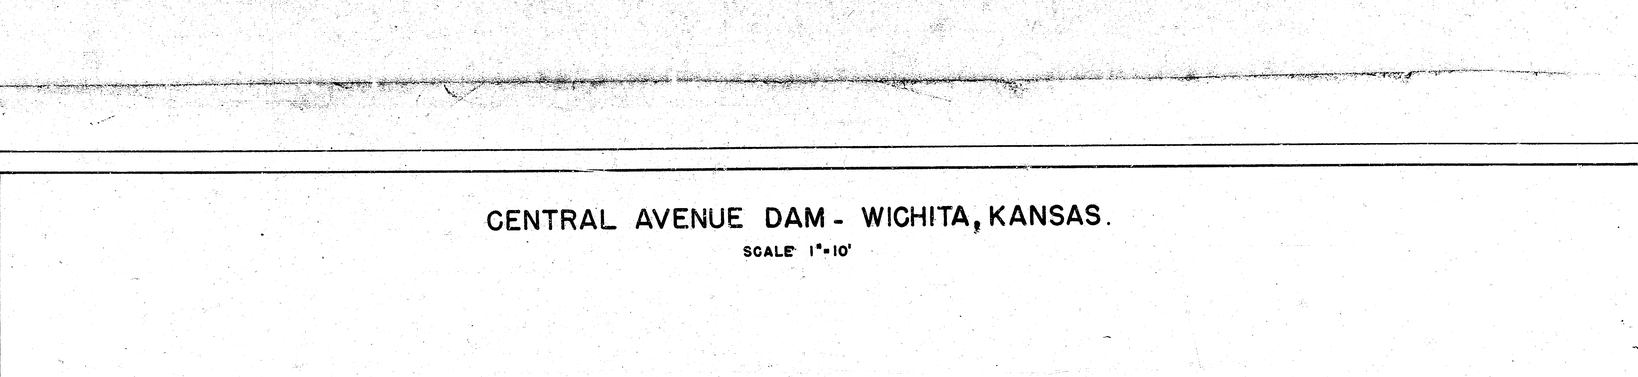

DOWNSTREAM SIDE OF 1910 SECTION FILLED WITH CRANE SIZE ROCK.


CENTRAL AVENUE DAM- WICHITA, KANSAS.

SCALE 1"=10'

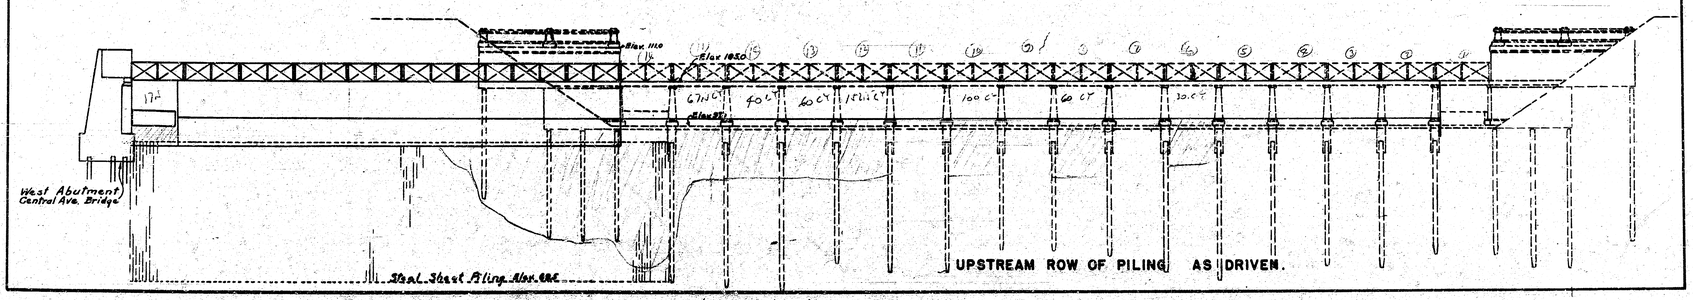

CENTRAL AVENUE DAM - WICHITA, KANSAS.

SCALE 1"=10'

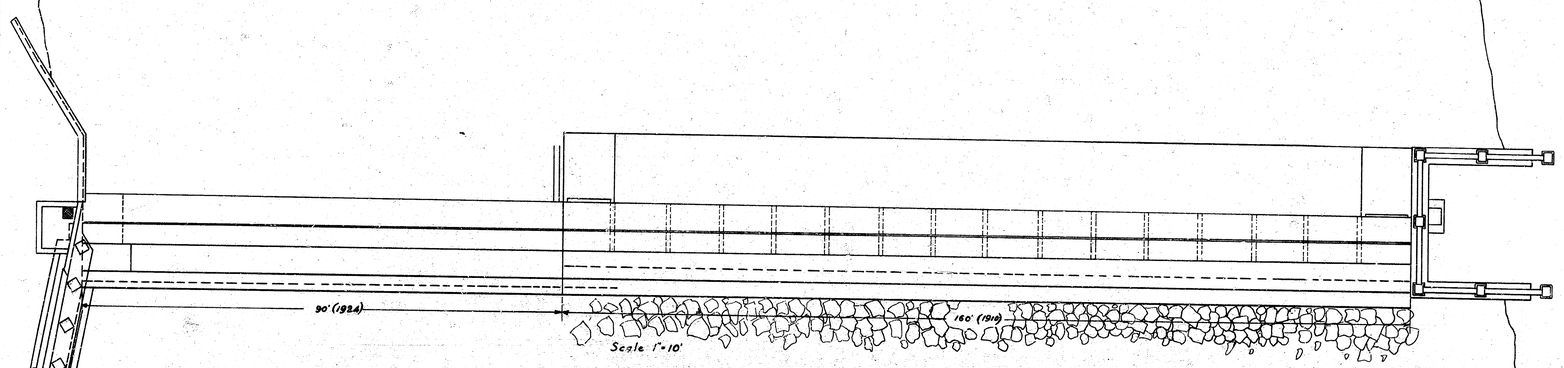


DOWNSTREAM SIDE OF 1910 SECTION FILLED WITH CRANE SIZE ROCK.

CENTRAL AVE DAM - WICHITA, KANSAS


CENTRAL AVENUE DAM- WICHITA, KANSAS.

SCALE 1" = 10'

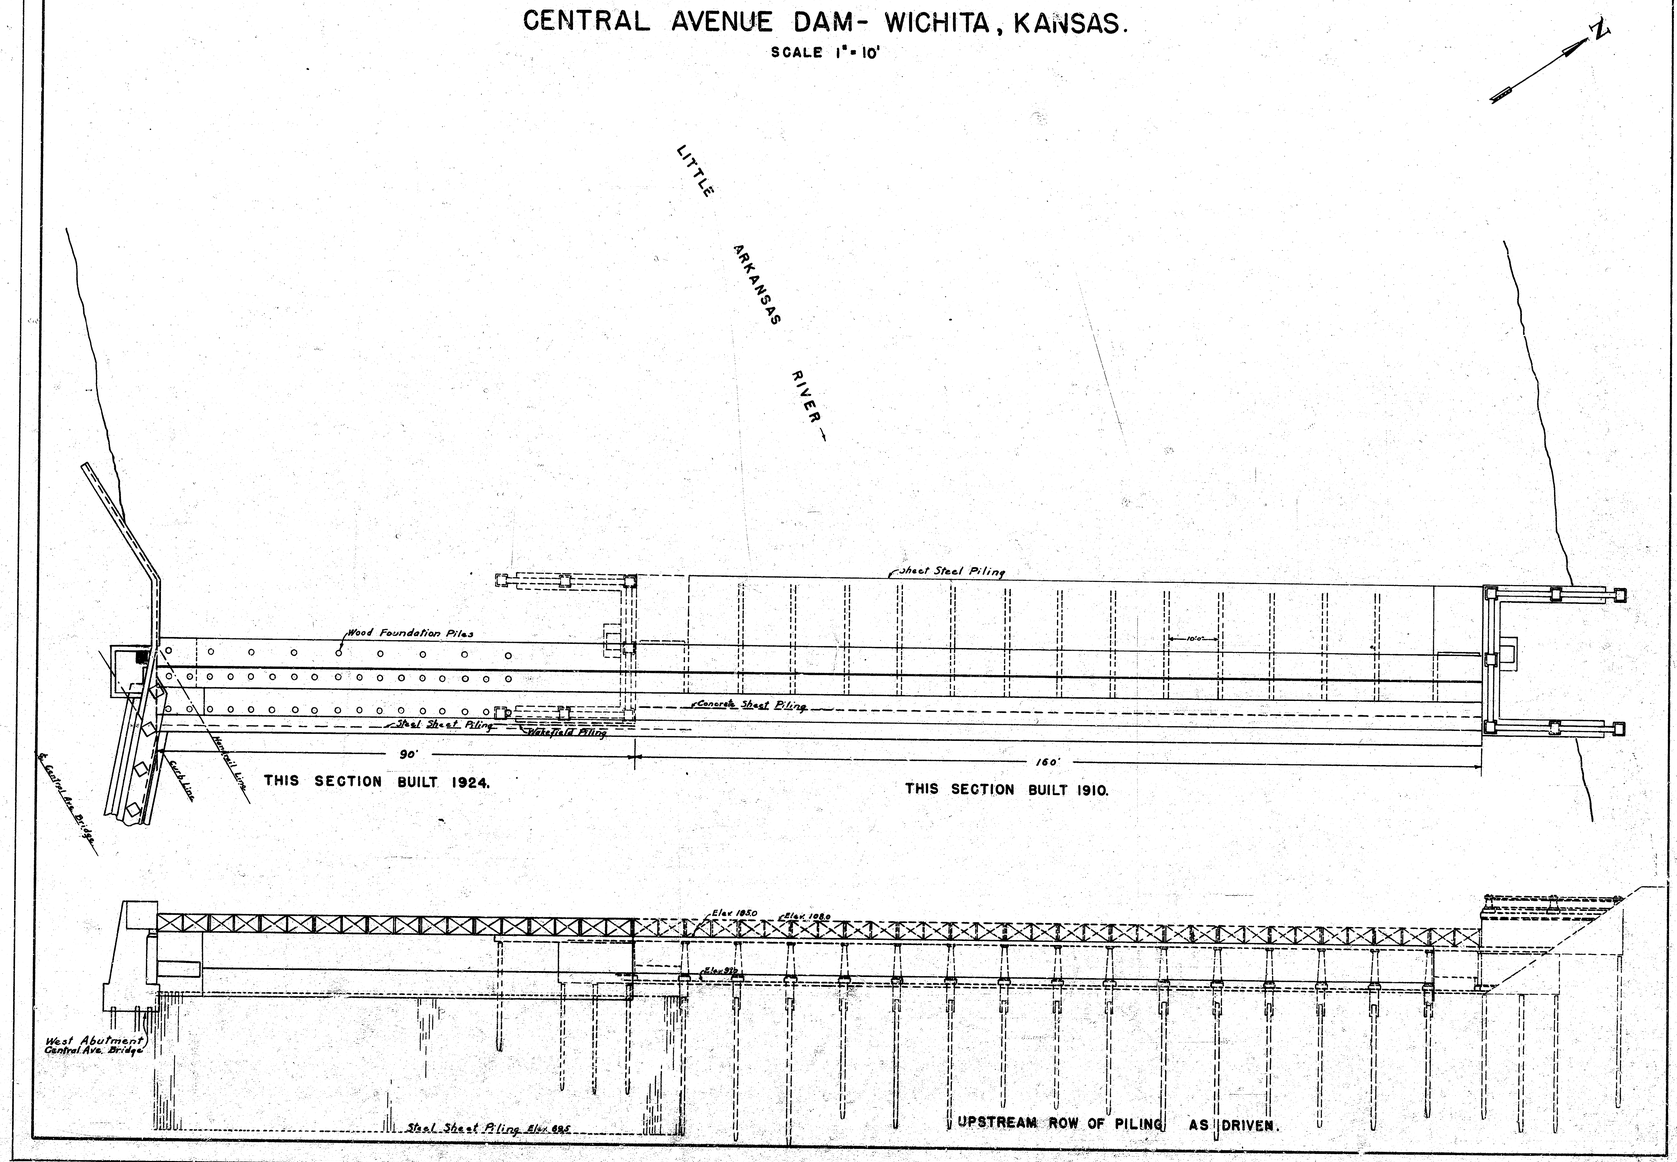

CENTRAL AVENUE DAM - WICHITA, KANSAS.

SCALE 1"=10'

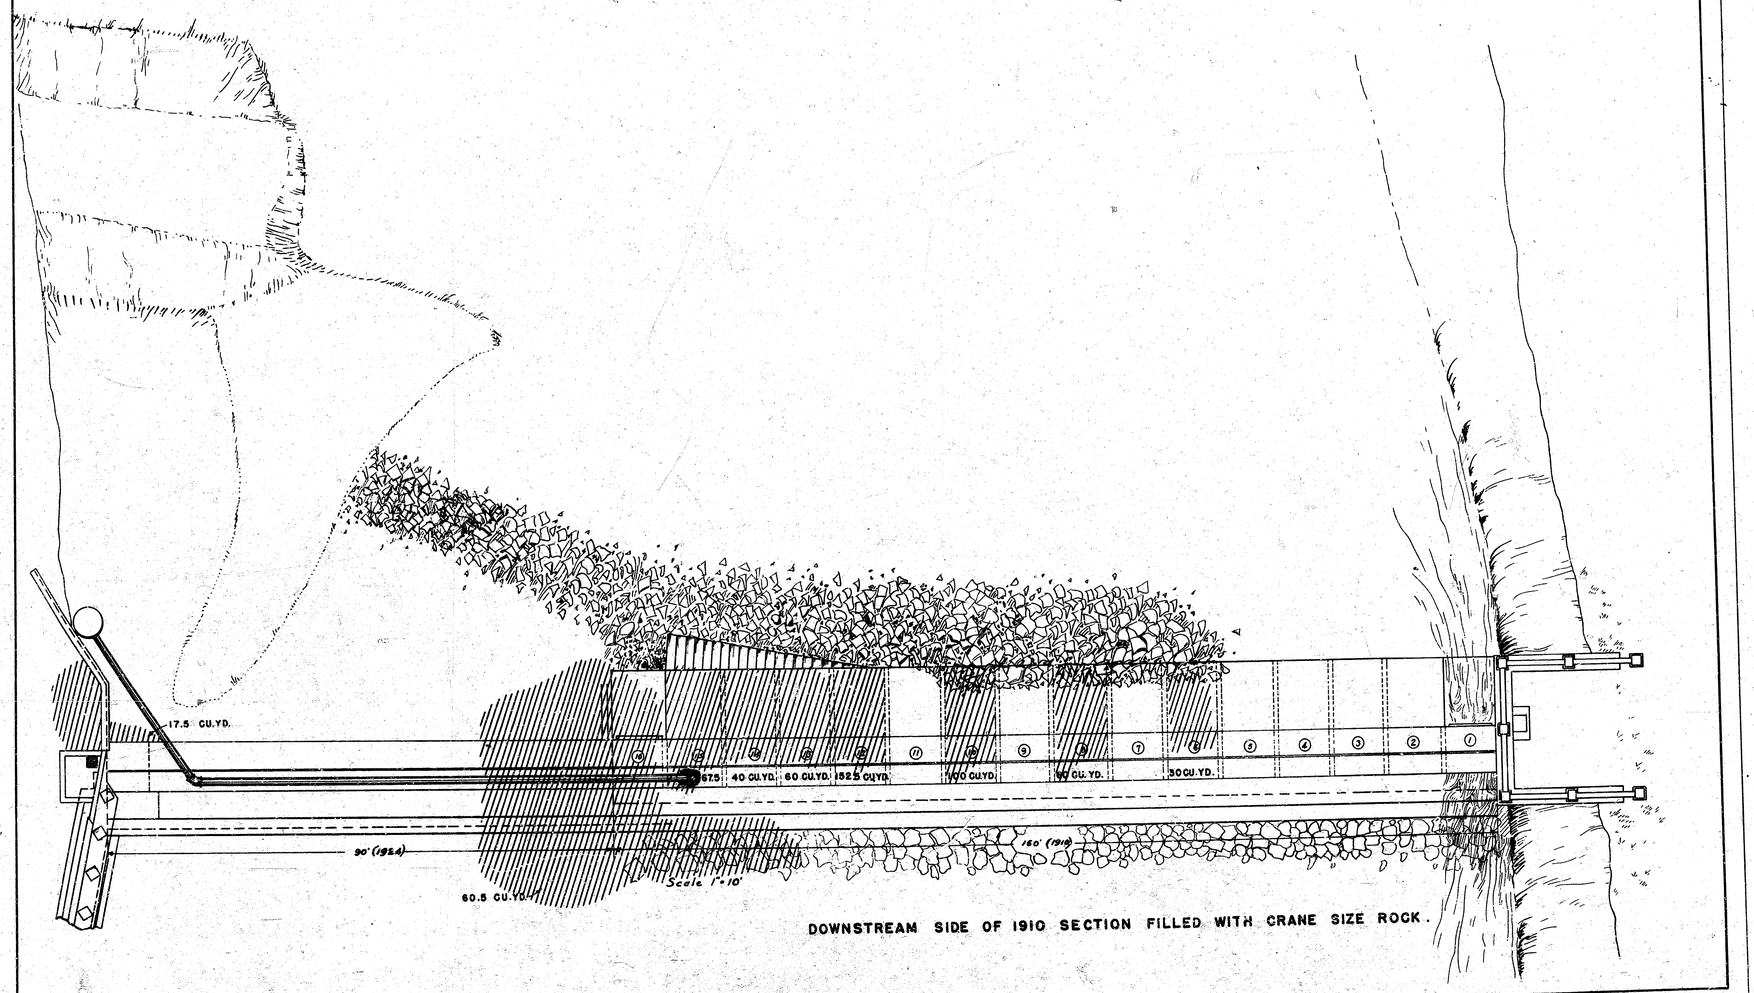

DOWNSTREAM SIDE OF 1910 SECTION FILLED WITH CRANE SIZE ROCK.