



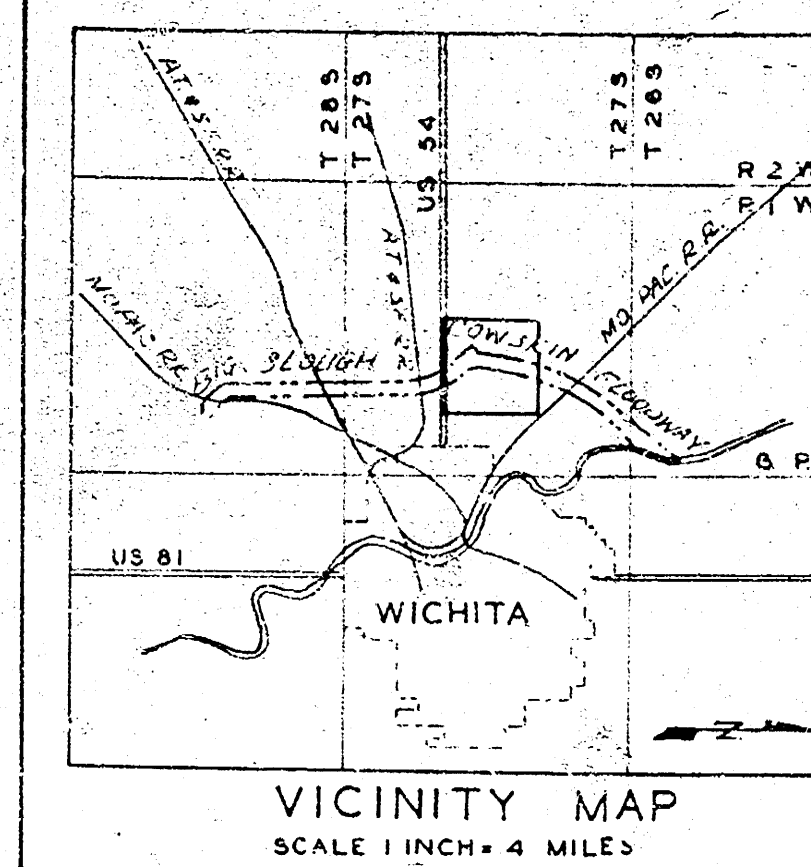

RIW

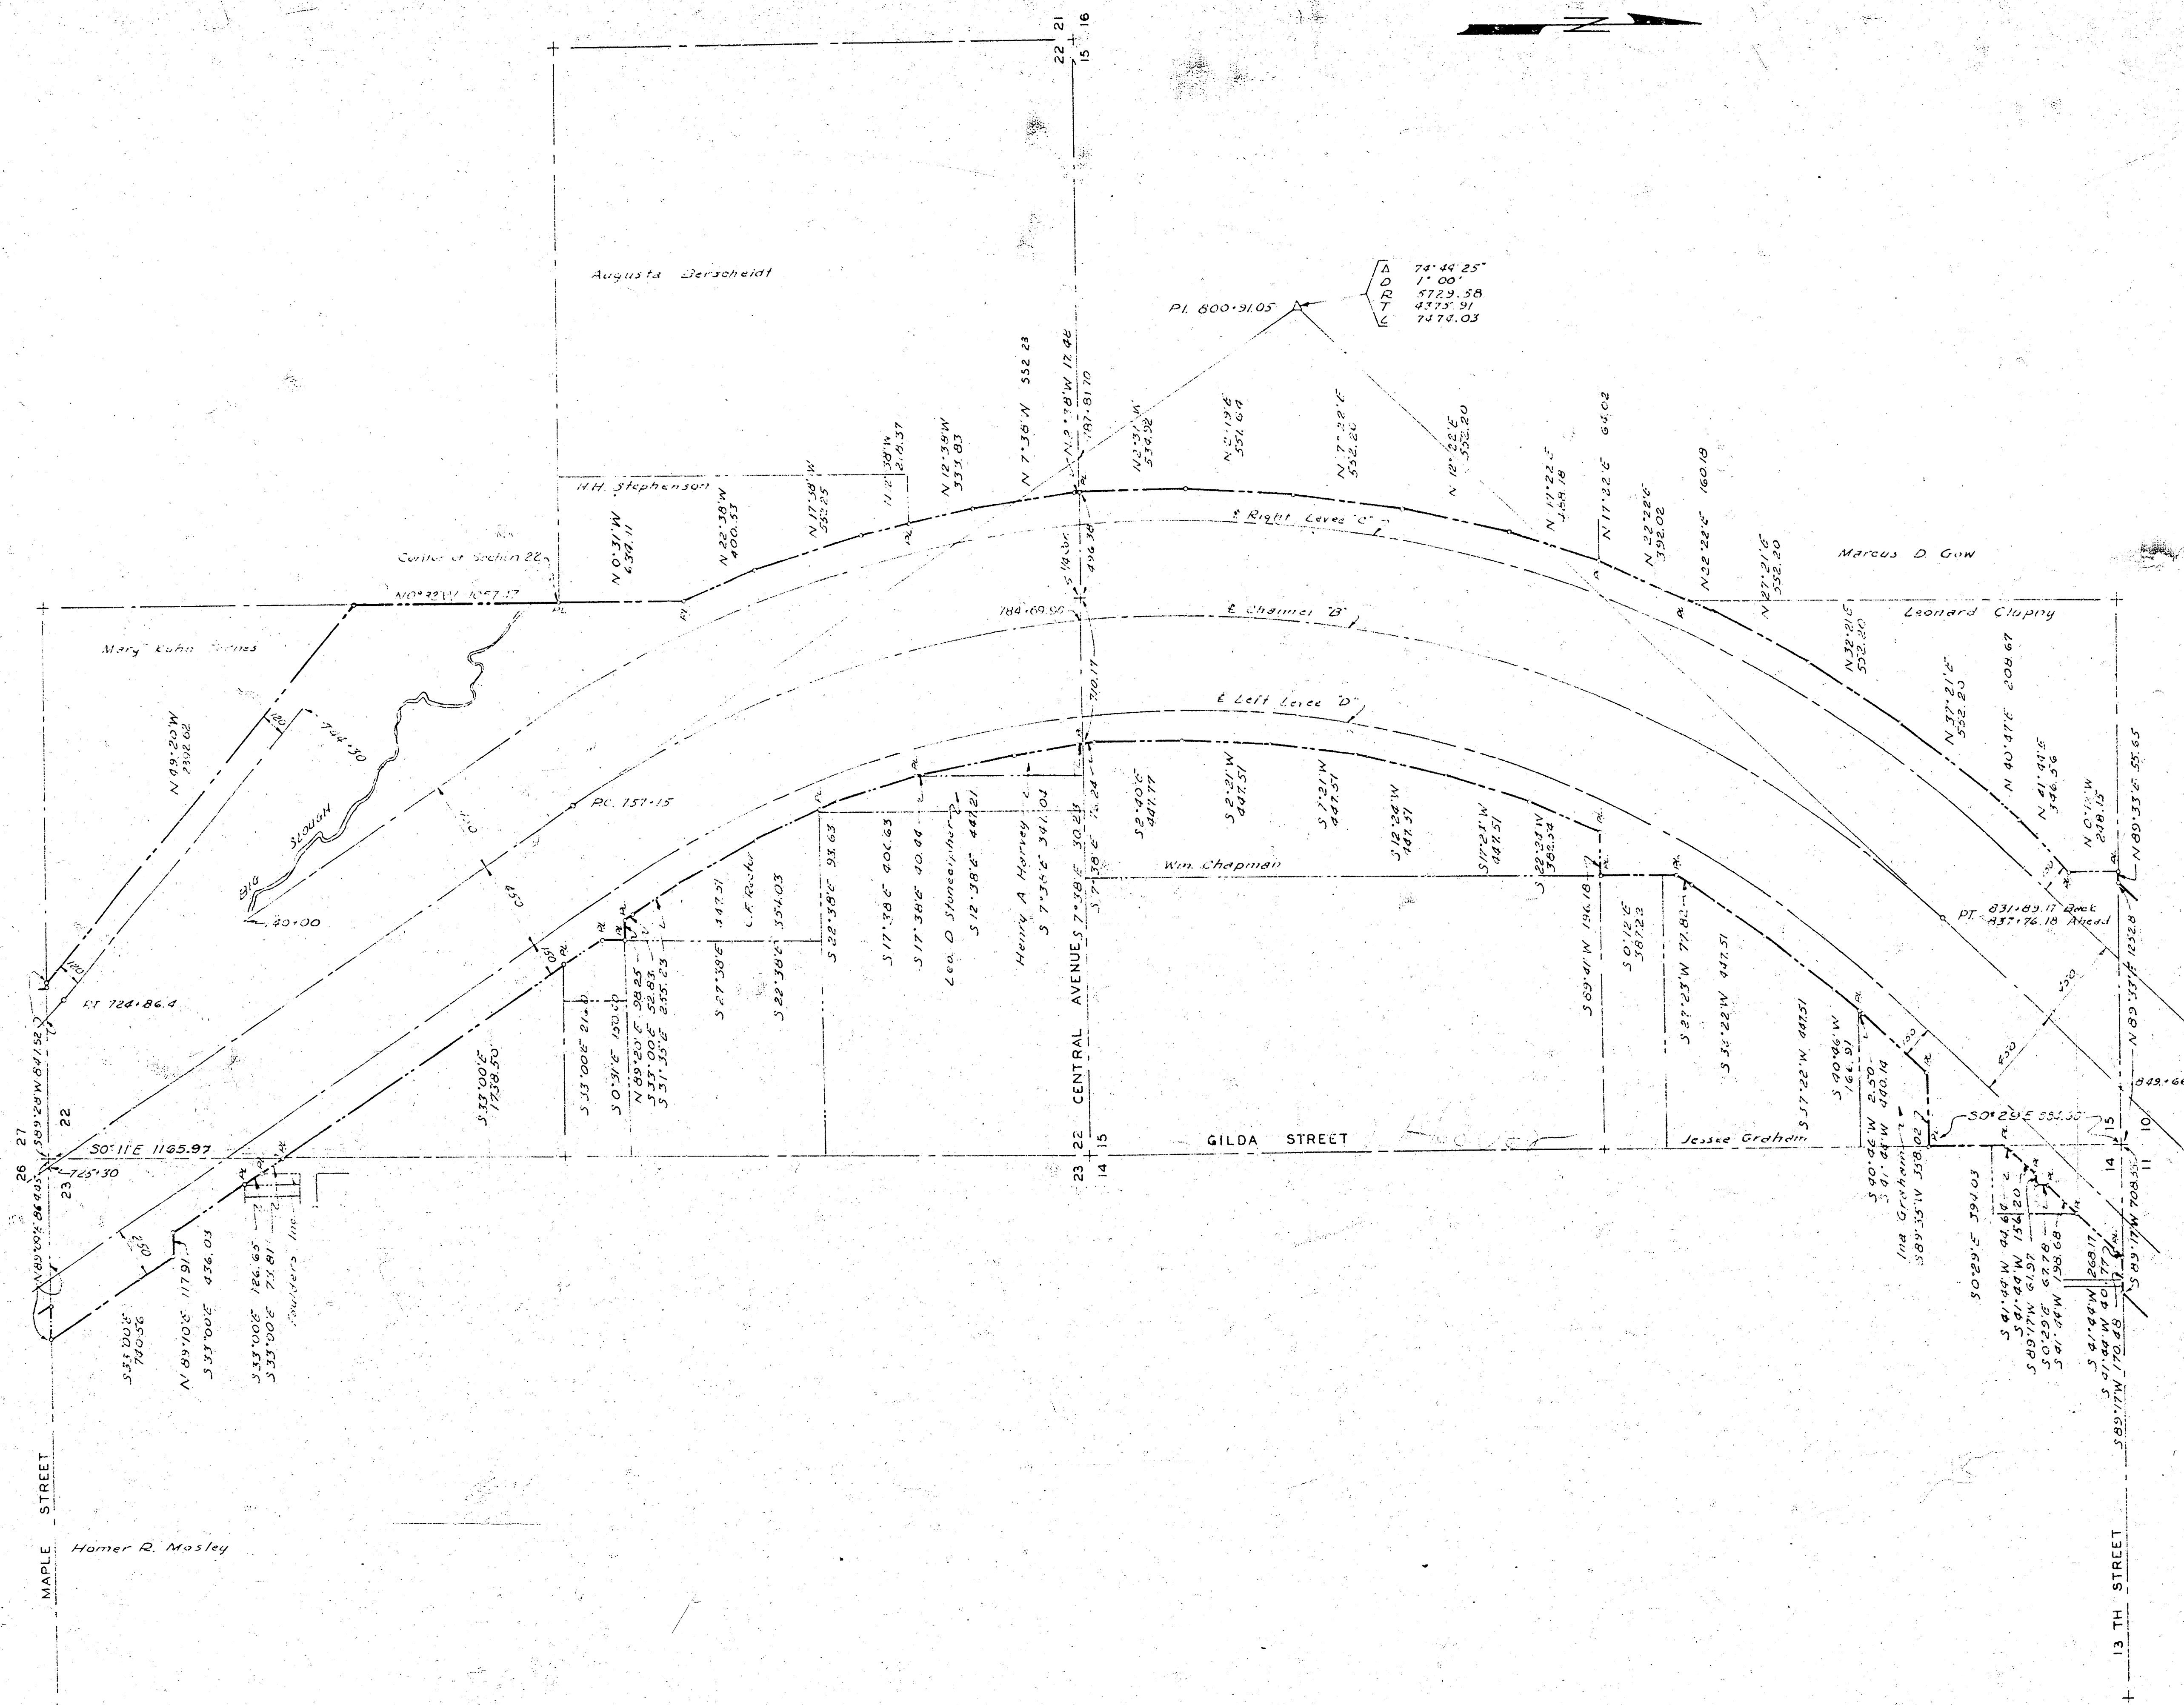

T 27 S

LEGEND

- CONCRETE MONUMENTS
- △ P.I. OF CURVES
- CENTER LINES OF LEVEES & CHANNELS
- PROPERTY LINES
- RIGHT OF WAY LIMITS



KANSAS RIVER BASIN
WICHITA AND VALLEY CENTER
FLOOD CONTROL PROJECT
BIG SLOUGH-COWSKIN CREEK FLOODWAY
PARCEL "B" PART I & II
RIGHT OF WAY PLAN

SCALE: 1 INCH = 400 FEET
CITY-COUNTY ENGINEER OFFICE, WICHITA, KANSAS

APPROVED:
Conrad
ENGINEER IN CHARGE

DATE	DESCRIPTION	CHKD	REC	APPR	DRAWN	TRACED	CHECKED
1/31/50	Recreation of Right of Way in Terms property	JAS					
REVISIONS							

SHEET 3 OF 4 SHEETS

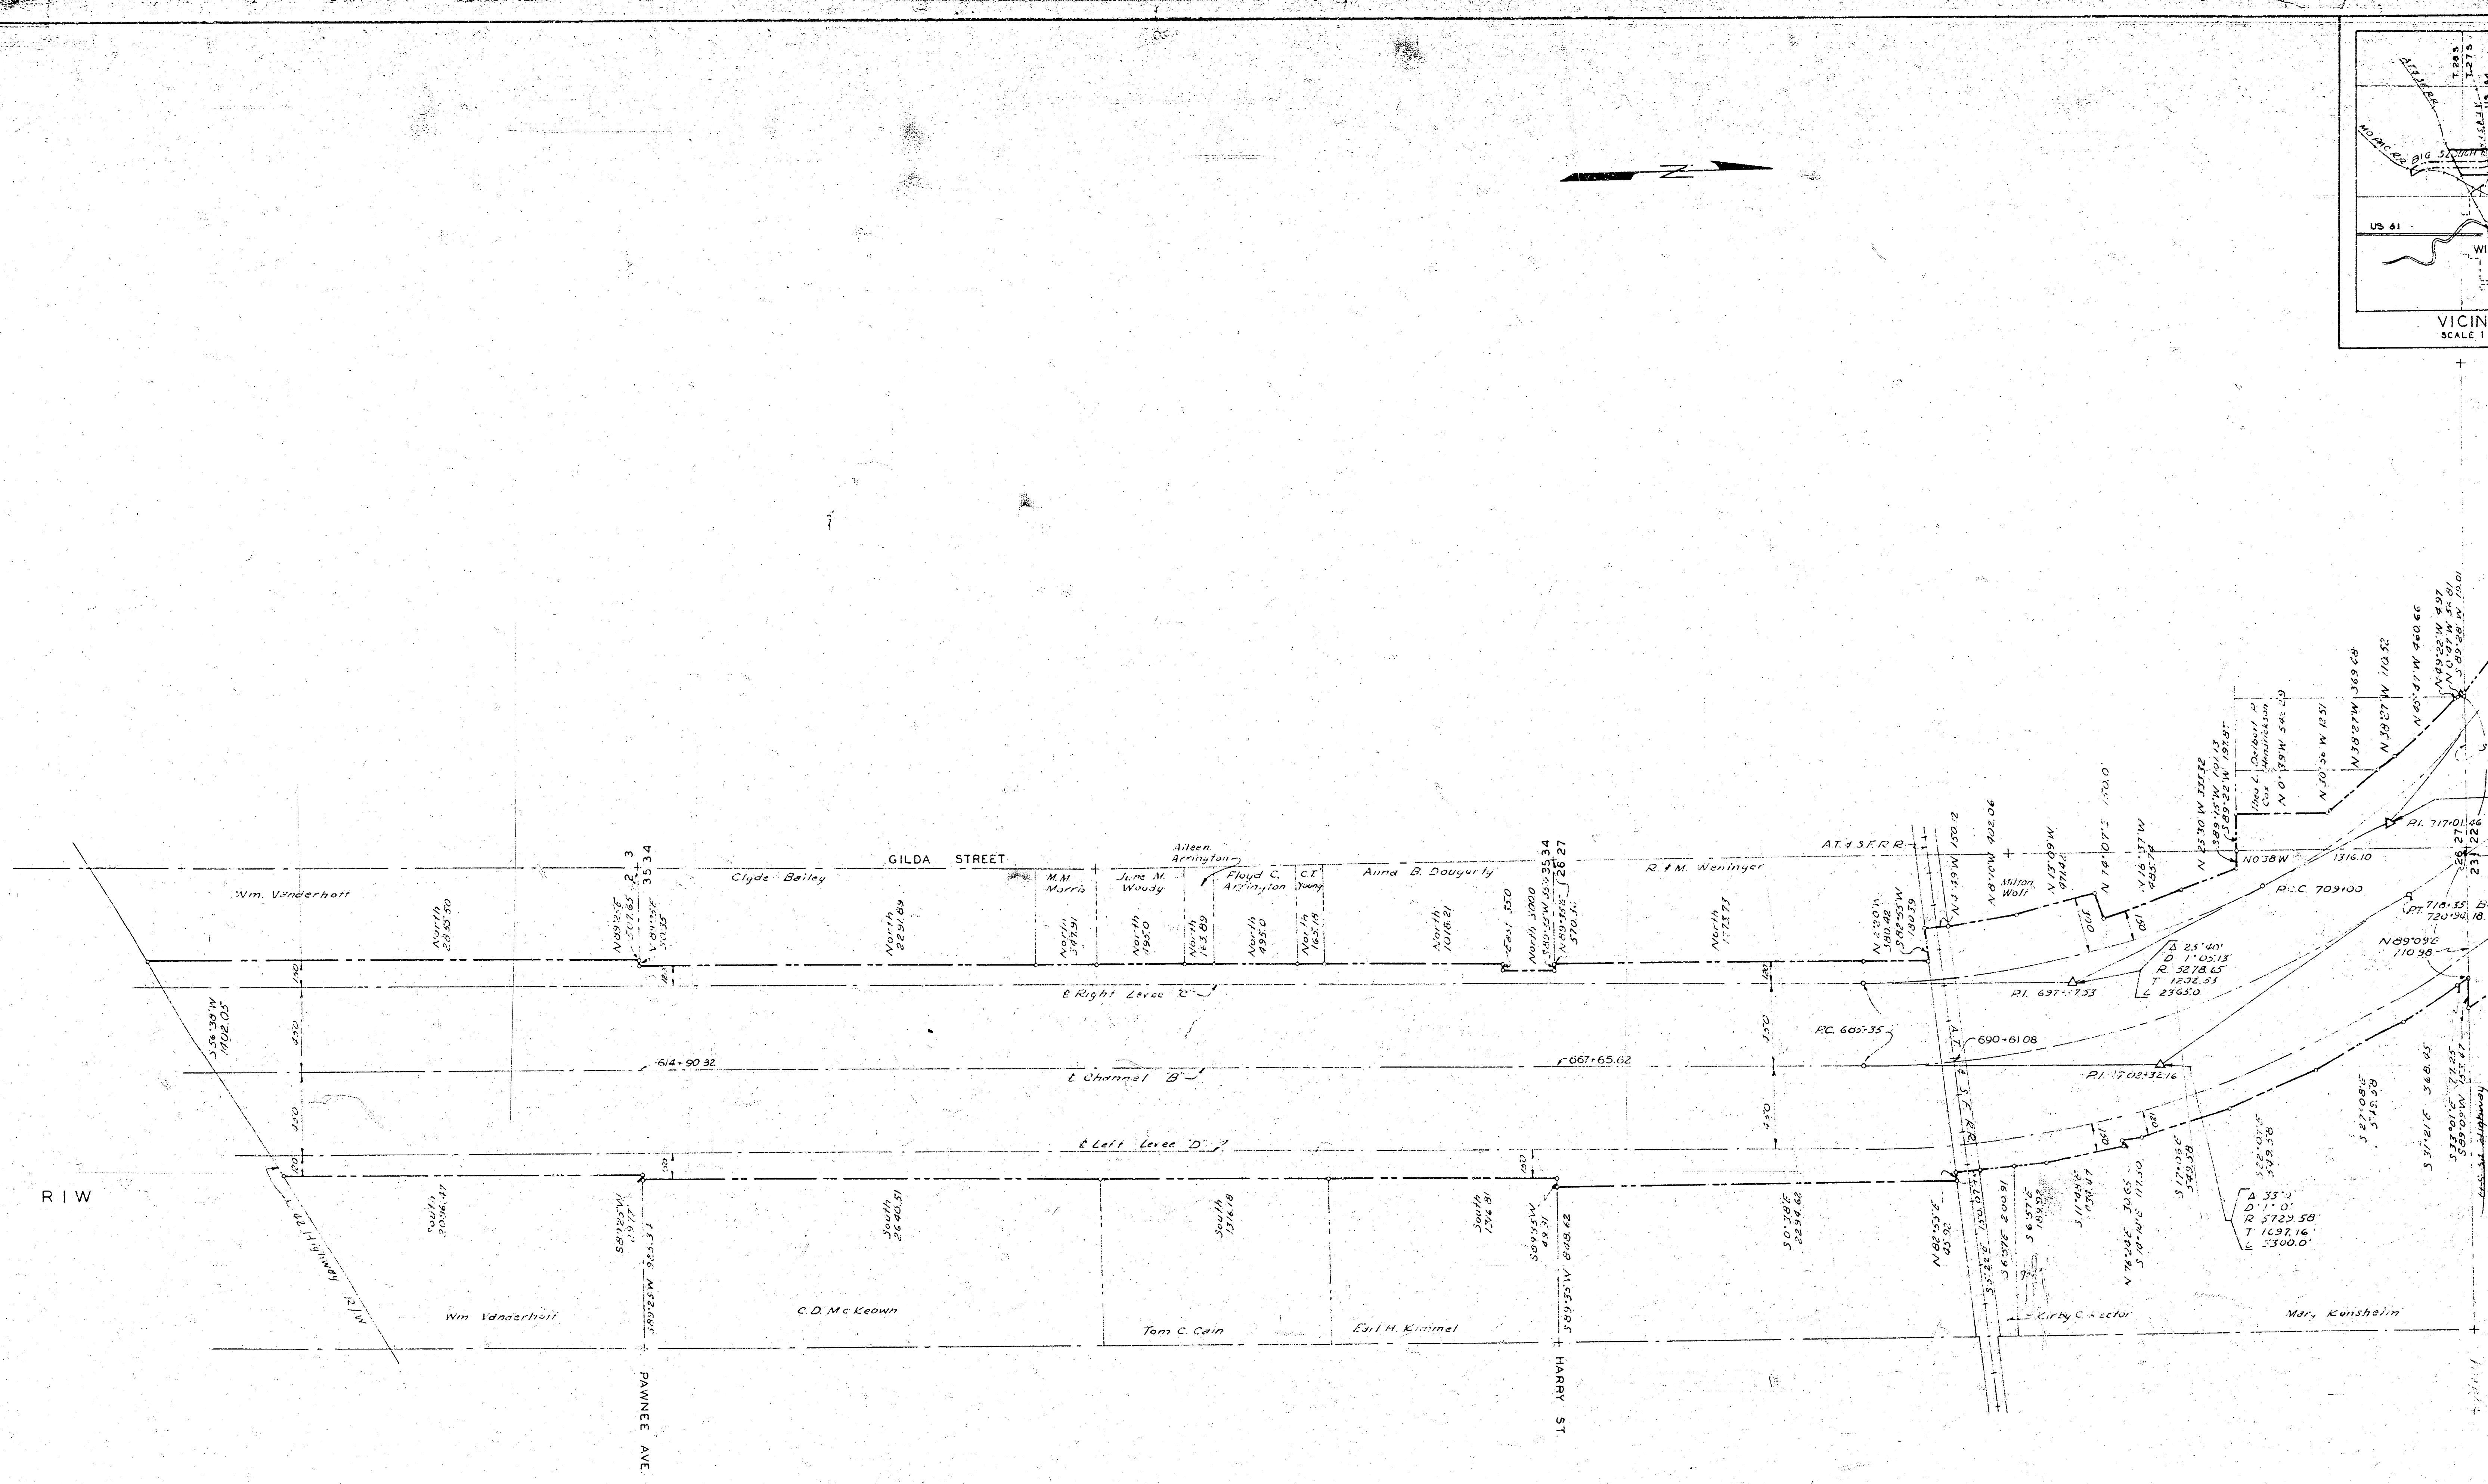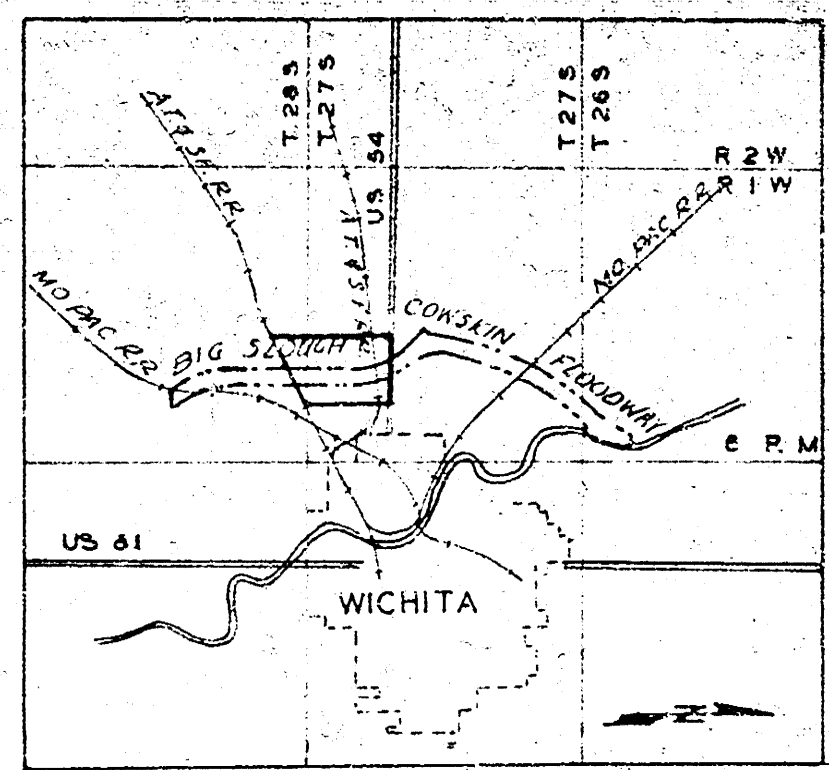

LEGEND

- CONCRETE MONUMENTS
- P.I. OF CURVES
- CENTER LINES OF LEVEES & CHANNELS
- PROPERTY LINES
- RIGHT OF WAY LIMITS

ARKANSAS RIVER BASIN
WICHITA AND VALLEY CENTER
FLOOD CONTROL PROJECT
BIG SLOUGH-COWSKIN CREEK FLOODWAY
PARCEL "B" PART I & II
RIGHT OF WAY PLAN



SCALE: 1 INCH = 400 FEET
CITY-COUNTY ENGINEER OFFICE, WICHITA, KANSAS

DATE	DESCRIPTION	CHKD.	REC.	APPR.

APPROVED:
ENGINEER IN CHARGE

DRAWN BY: [Signature]
CHECKED BY: [Signature]
SHEET 2 OF 4 SHEETS


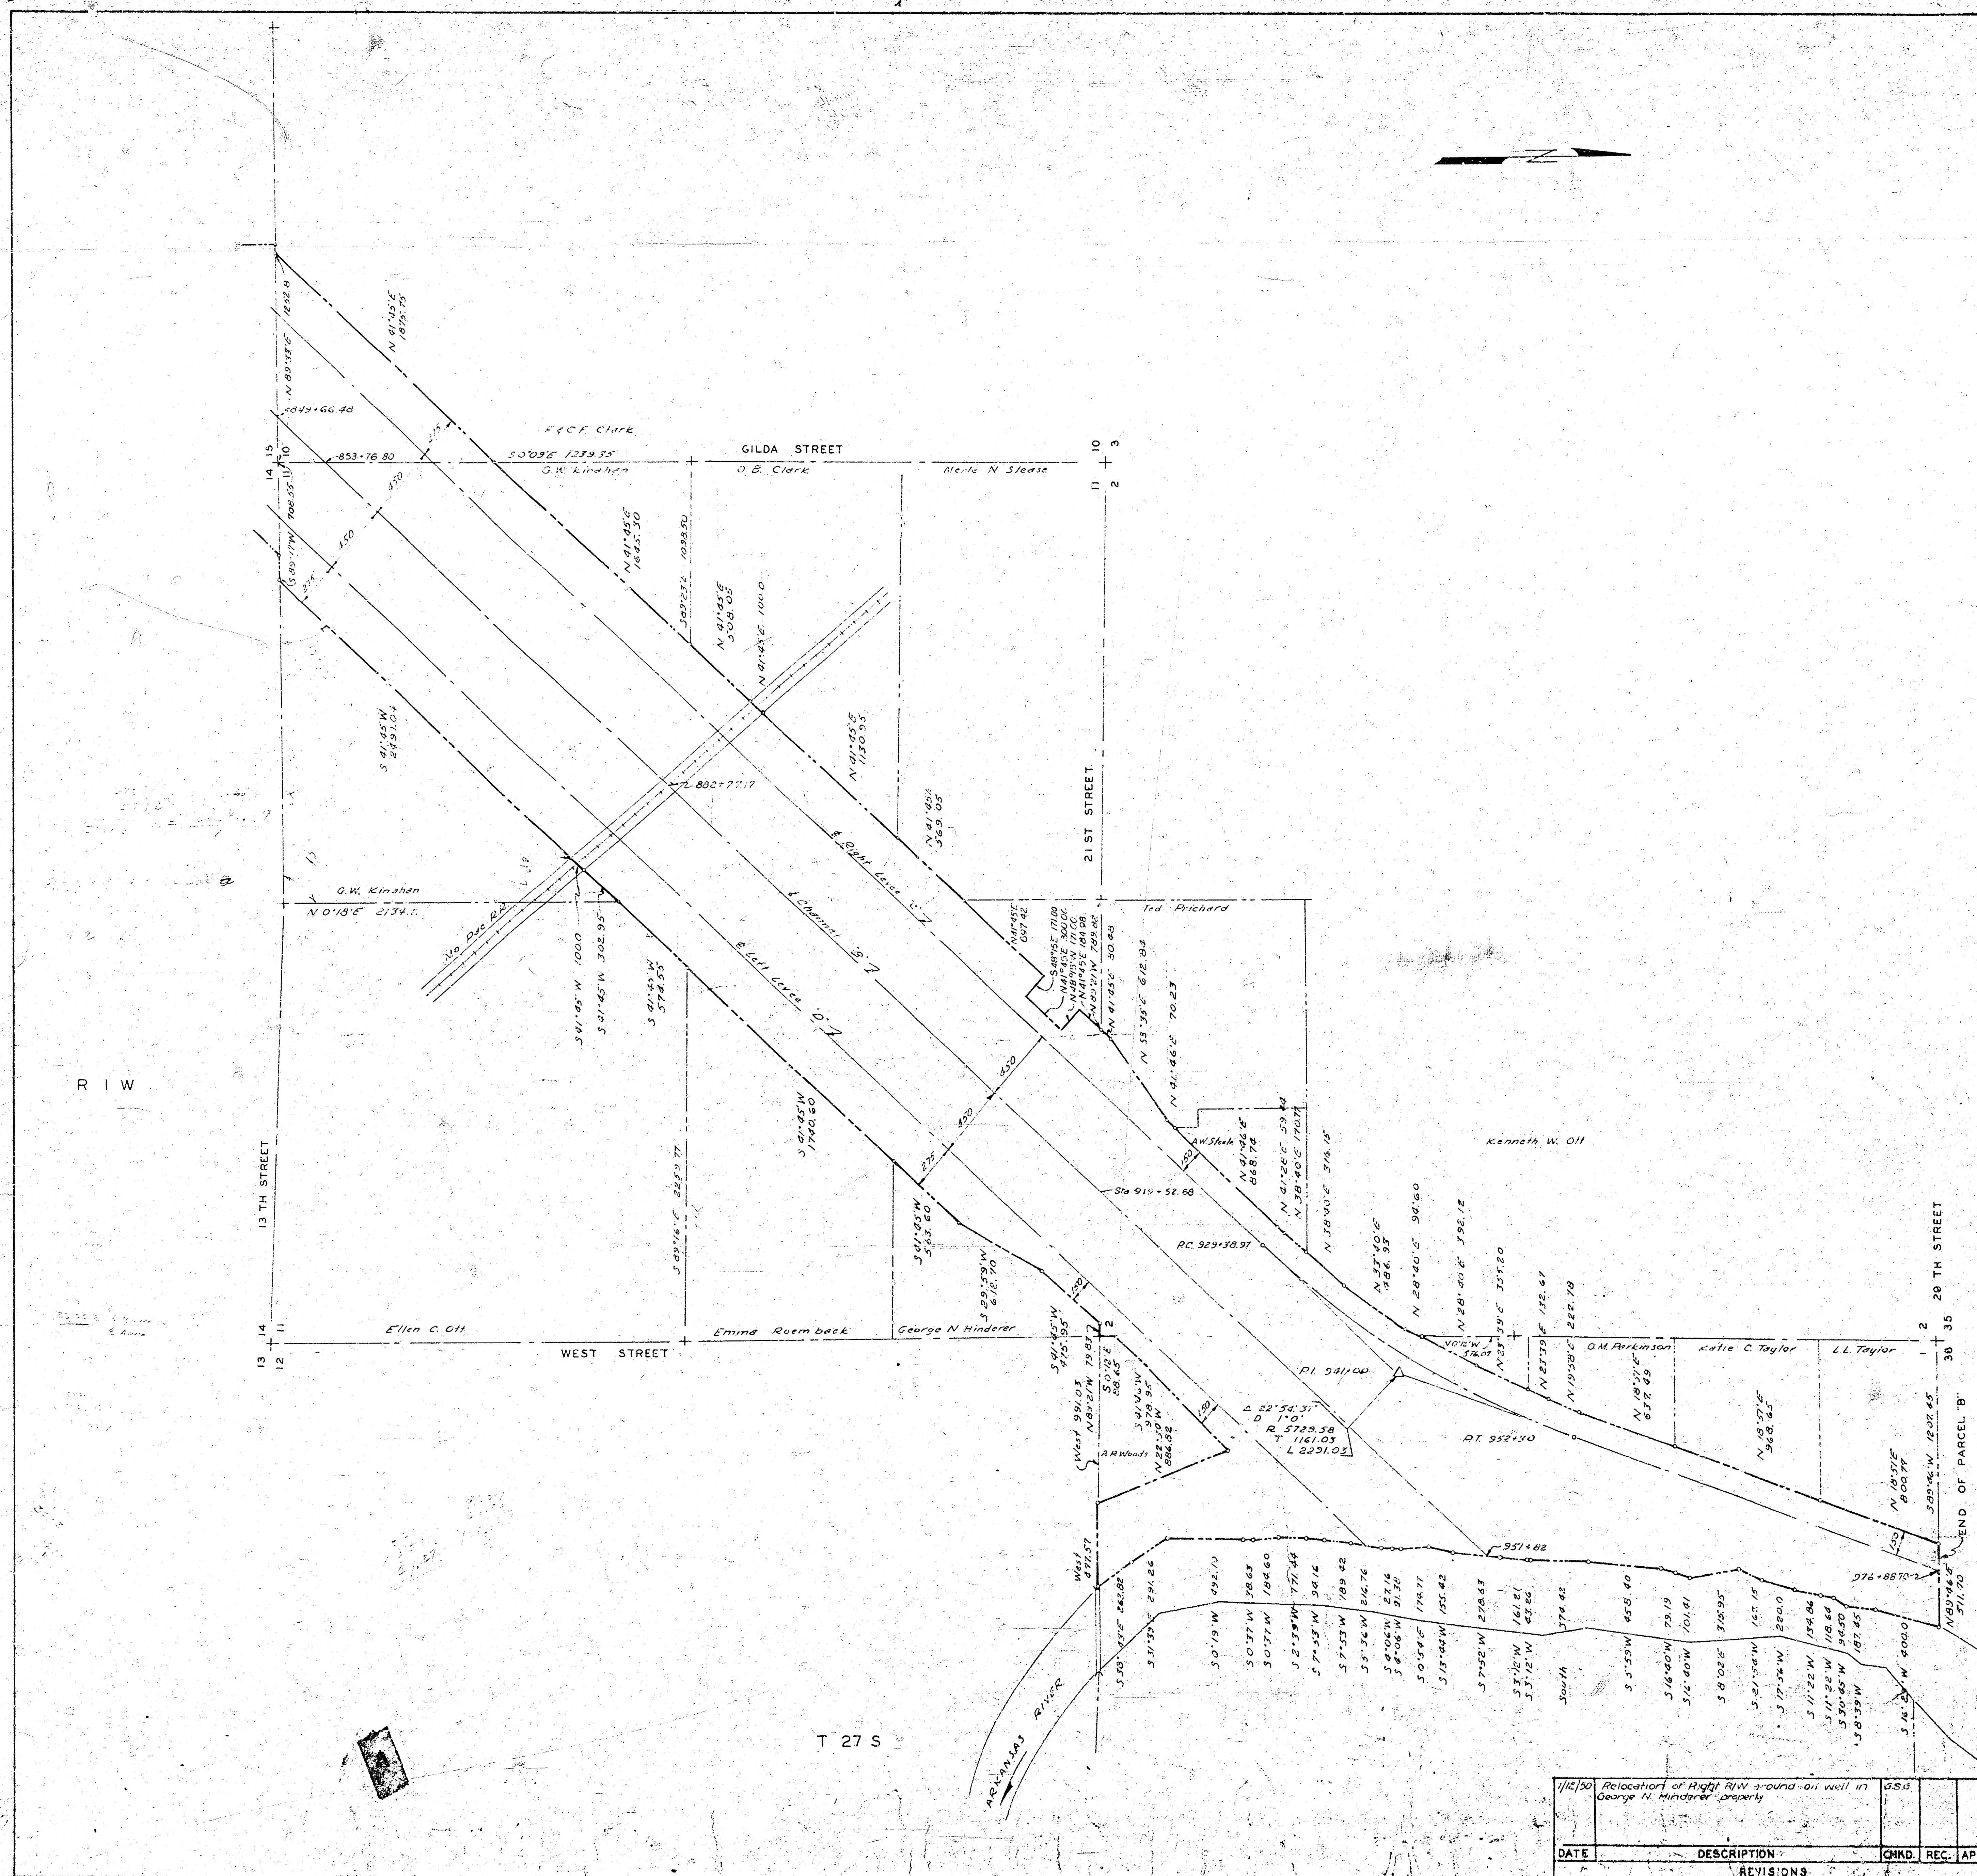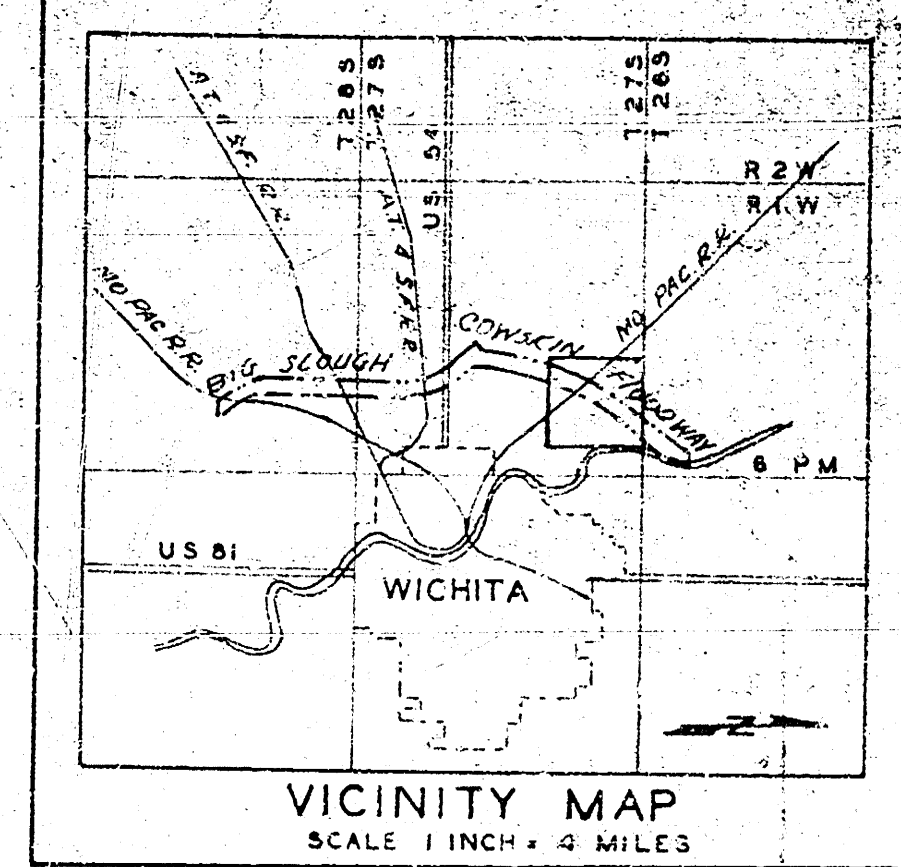

LEGEND

- CONCRETE MONUMENTS
- △ P.I. OF CURVES
- CENTER LINES OF LEVEES & CHANNELS
- PROPERTY LINES
- RIGHT OF WAY LIMITS

ARKANSAS RIVER BASIN
WICHITA AND VALLEY CENTER
FLOOD CONTROL PROJECT
BIG SLOUGH-COWSKIN CREEK FLOODWAY
PARCEL "B" PART I & II
RIGHT OF WAY PLAN

SCALE: 1 INCH = 400 FEET
CITY/COUNTY ENGINEER OFFICE, WICHITA, KANSAS

11/12/50	Relocation of Right of Way around an well in George N. Hindler property	USE
DATE	DESCRIPTION	CHKD. REC. APPR.
	REVISIONS:	

APPROVED: *[Signature]*
ENGINEER
DRAWN: *[Signature]*
CHECKED: *[Signature]*
HEET 4 OF 4 SHEETS