
Field Notes of Survey of Mill Pond in Little Arkansas river in Sec. 29 Township 26 South Range 1 East of 6 P.M. Beg. at S.W. cor. of S.E.¼ S.W.¼ Sec 29 Township 26 South Range 1 East of 6th P.M.

Thence North	00.10 E	293.3 feet	
N 57°	46 E	22.5 ft	to N bank of Mill race
N 11°	27 W	135 feet	Little Ark river
N 55°	53 E	255	with meanders of river
N 34°	35 E	243	"
N 47°	38 E	117	"
N 61°	48 E	277	"
N 37°	33 E	66	"
N 13°	58 E	168	"
N 22°	58 E	600	"
N 61°	18 E	117 feet	
N 13°	51 E	132	" to the ledge.
N 38°	34 W	190	"
N 12°	04 W	65	"
N 33°	24 W	180	"
N 60°	24 W	230	"
N 31°	24 W	136	"
N 52°	44 W	568	"
N 24°	44 W	190	"
N 64°	24 W	535	"
N 15°	36 E	725	"
N 9°	51 E	412	"
N 6°	09 W	230	"
N 45°	31 E	82	"
N 8°	54 W	268	"
N 22°	14 W	283	" 2210 feet on this run then with bearing
S 79°	09 E	1315 feet	to ¼ Sec Cor. on N. line Sec. 29
N 41°	44 W	418	"
N 54°	14 W	260	"
S 79°	31 W	410	"
S 10°	29 E	75	"
N 76°	31 E	372	"
S 48°	14 E	252	"
S 41°	04 E	291	"
S 19°	04 E	287	"
S 6°	49 E	610	"
S 13°	56 W	430	"
S 38°	11 W	215	"
S 11°	21 W	528	"
S 64°	39 E	666	"
S 0°	21 W	290	"
S 29°	09 E	113	"
S 57°	19 E	845	"
S 5°	21 W	796	"
S 27°	56 W	241	"
S 73°	16 W	188	"
S 45°	16 W	336	"
S 63°	41 W	355	" to the W line of S.E.¼ S.W.¼ 29.26.
Thence South		1545 ft	to point 293.3 North of beginning.

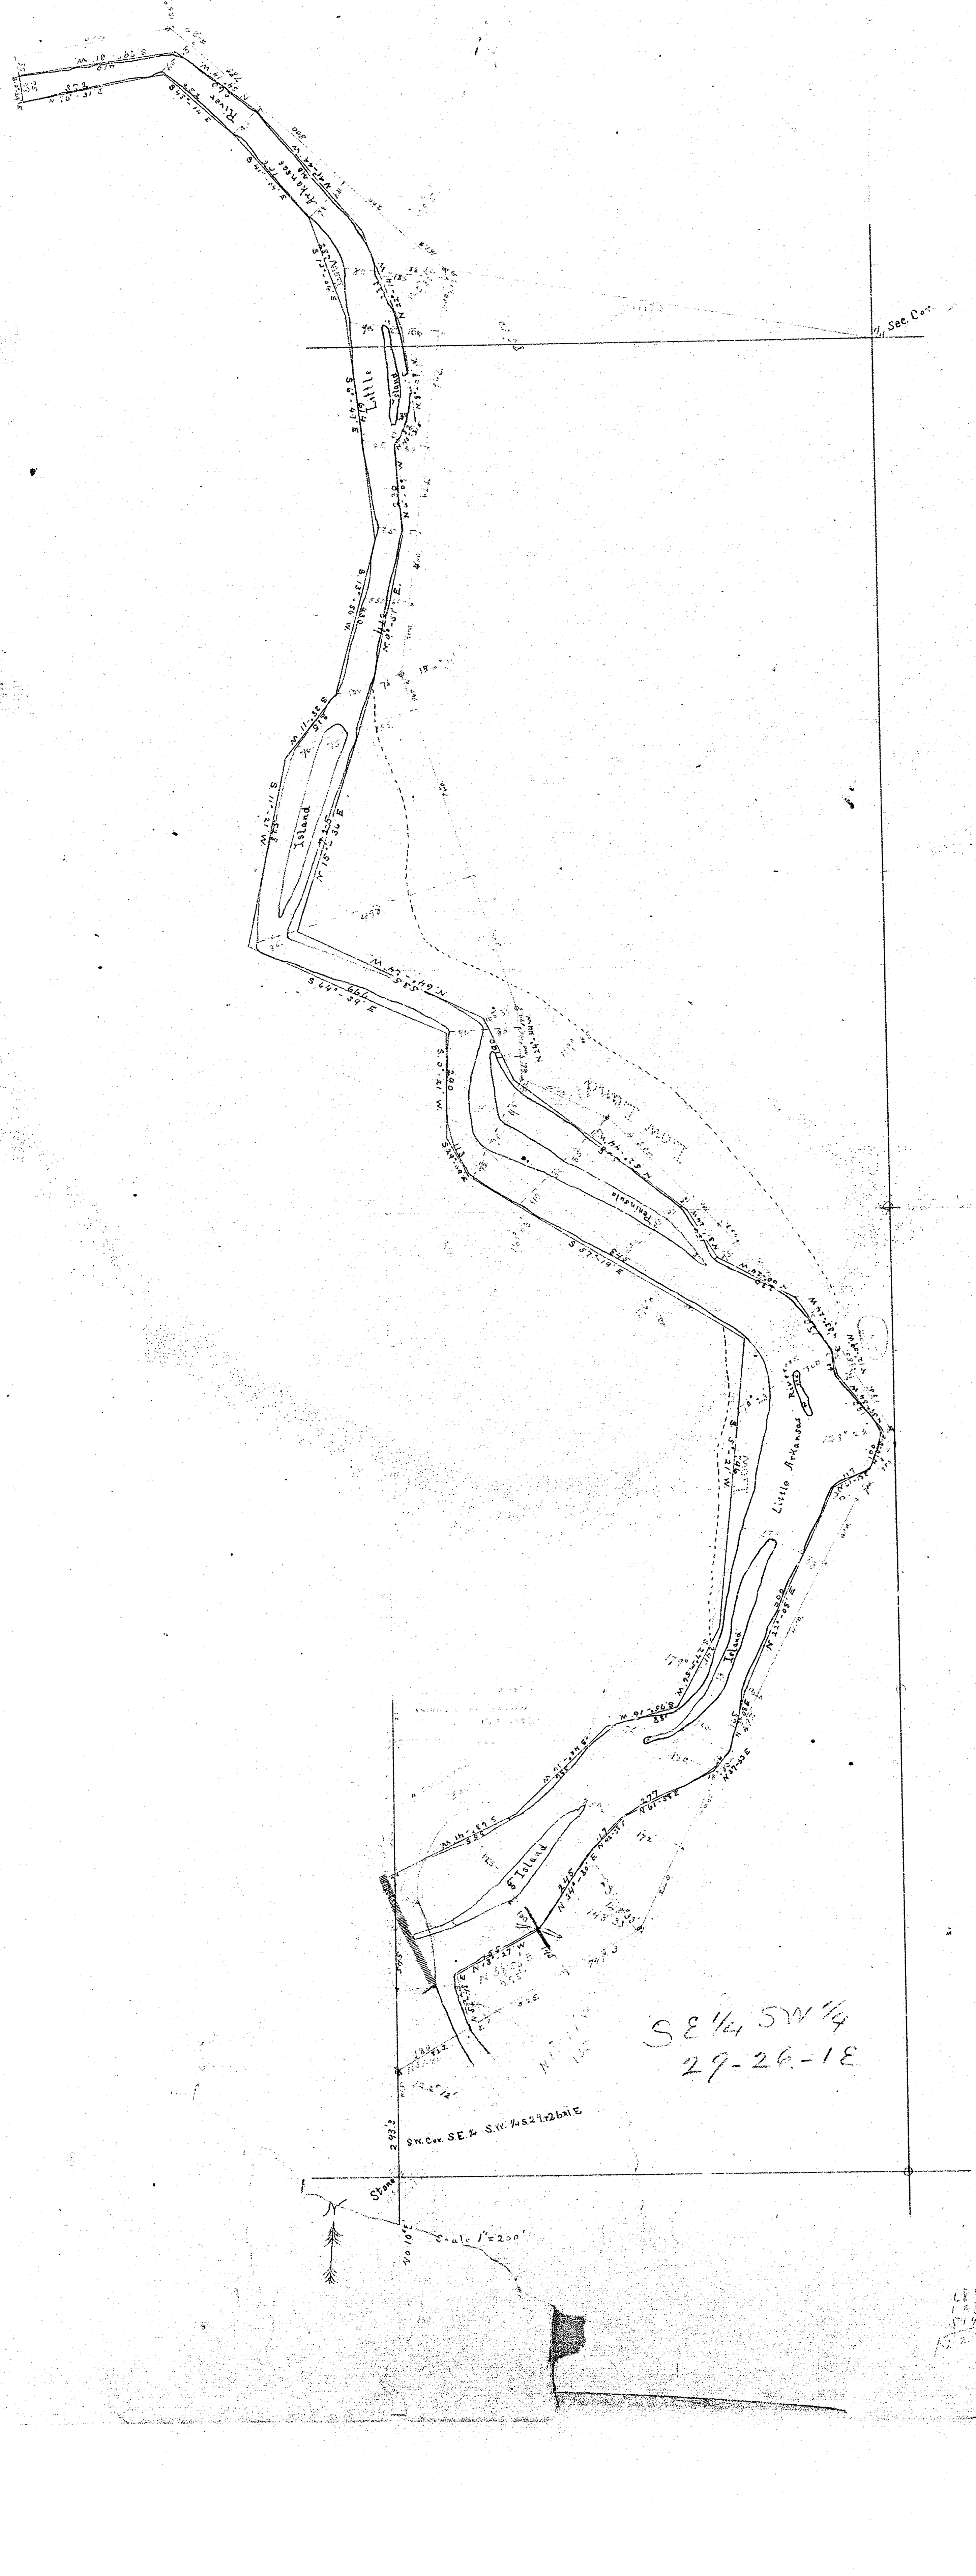


Map of Mill Pond
and
Little Arkansas River
North from the Dam.
in Sec. 29. Tows. 26 S. Range 1 E. of 6 P.M.

Field Notes of Survey of Mill Pond in Little Arkansas River in Sec. 29 Township 26 South Range 1 East of 6 P.M. Beg at S W Cor of S E ¼ S W ¼ Sec 29 Township 26 South Range 1 East of 6th P.M.

Thence North [illegible] 293.3 feet

N	[illegible]	[illegible] E	[illegible]	[illegible]
N	[illegible]	27 W	[illegible]	[illegible]
N	35°	33 E	255	with meander of river
N	34°	36 E	[illegible]	"
N	15°	38 E	[illegible]	"
N	61°	53 E	[illegible]	"
N	37°	33 E	60	"
N	13°	02 E	166	"
N	28°	03 E	600	"
N	61°	18 E	117 feet	to the hedge
N	12°	51 E	[illegible]	"
N	38°	34 W	190	"
N	12°	09 W	65	"
N	33°	24 W	110	"
N	60°	24 W	230	"
N	37°	24 W	136	"
N	35°	[illegible] W	368	"
N	24°	[illegible] W	190	"
N	64°	24 W	535	"
N	15°	36 E	225	"
N	9°	51 E	417	"
N	6°	00 E	230	"
N	45°	3 E	[illegible]	"
N	8°	59 W	[illegible]	"
N	22°	10 W	283	2?? feet on line run then on the bearing
S	74°	49 E	1315 feet	to ¼ Sec Cor on N line Sec 29
N	81°	44 W	[illegible]	"
N	54°	14 W	260	"
S	79°	31 W	412	"
S	10°	29 E	15	"
S	76°	31 E	372	"
S	46°	10 E	252	"
S	41°	04 E	291	"
S	14°	04 E	287	"
S	6°	44 E	610	"
S	13°	56 W	830	"
S	38°	11 W	215	"
S	11°	21 W	528	"
S	64°	39 E	666	"
S	0°	21 W	290	"
S	29°	07 E	113	"
S	57°	19 E	845	"
S	5°	21 W	796	"
S	27°	56 W	241	"
S	75°	16 W	138	"
S	45°	16 W	336	"
S	63°	11 W	355	to the N line of S E ¼ S W ¼ 29.26.

Thence South 540 ft to point 293.3 North of beginning.

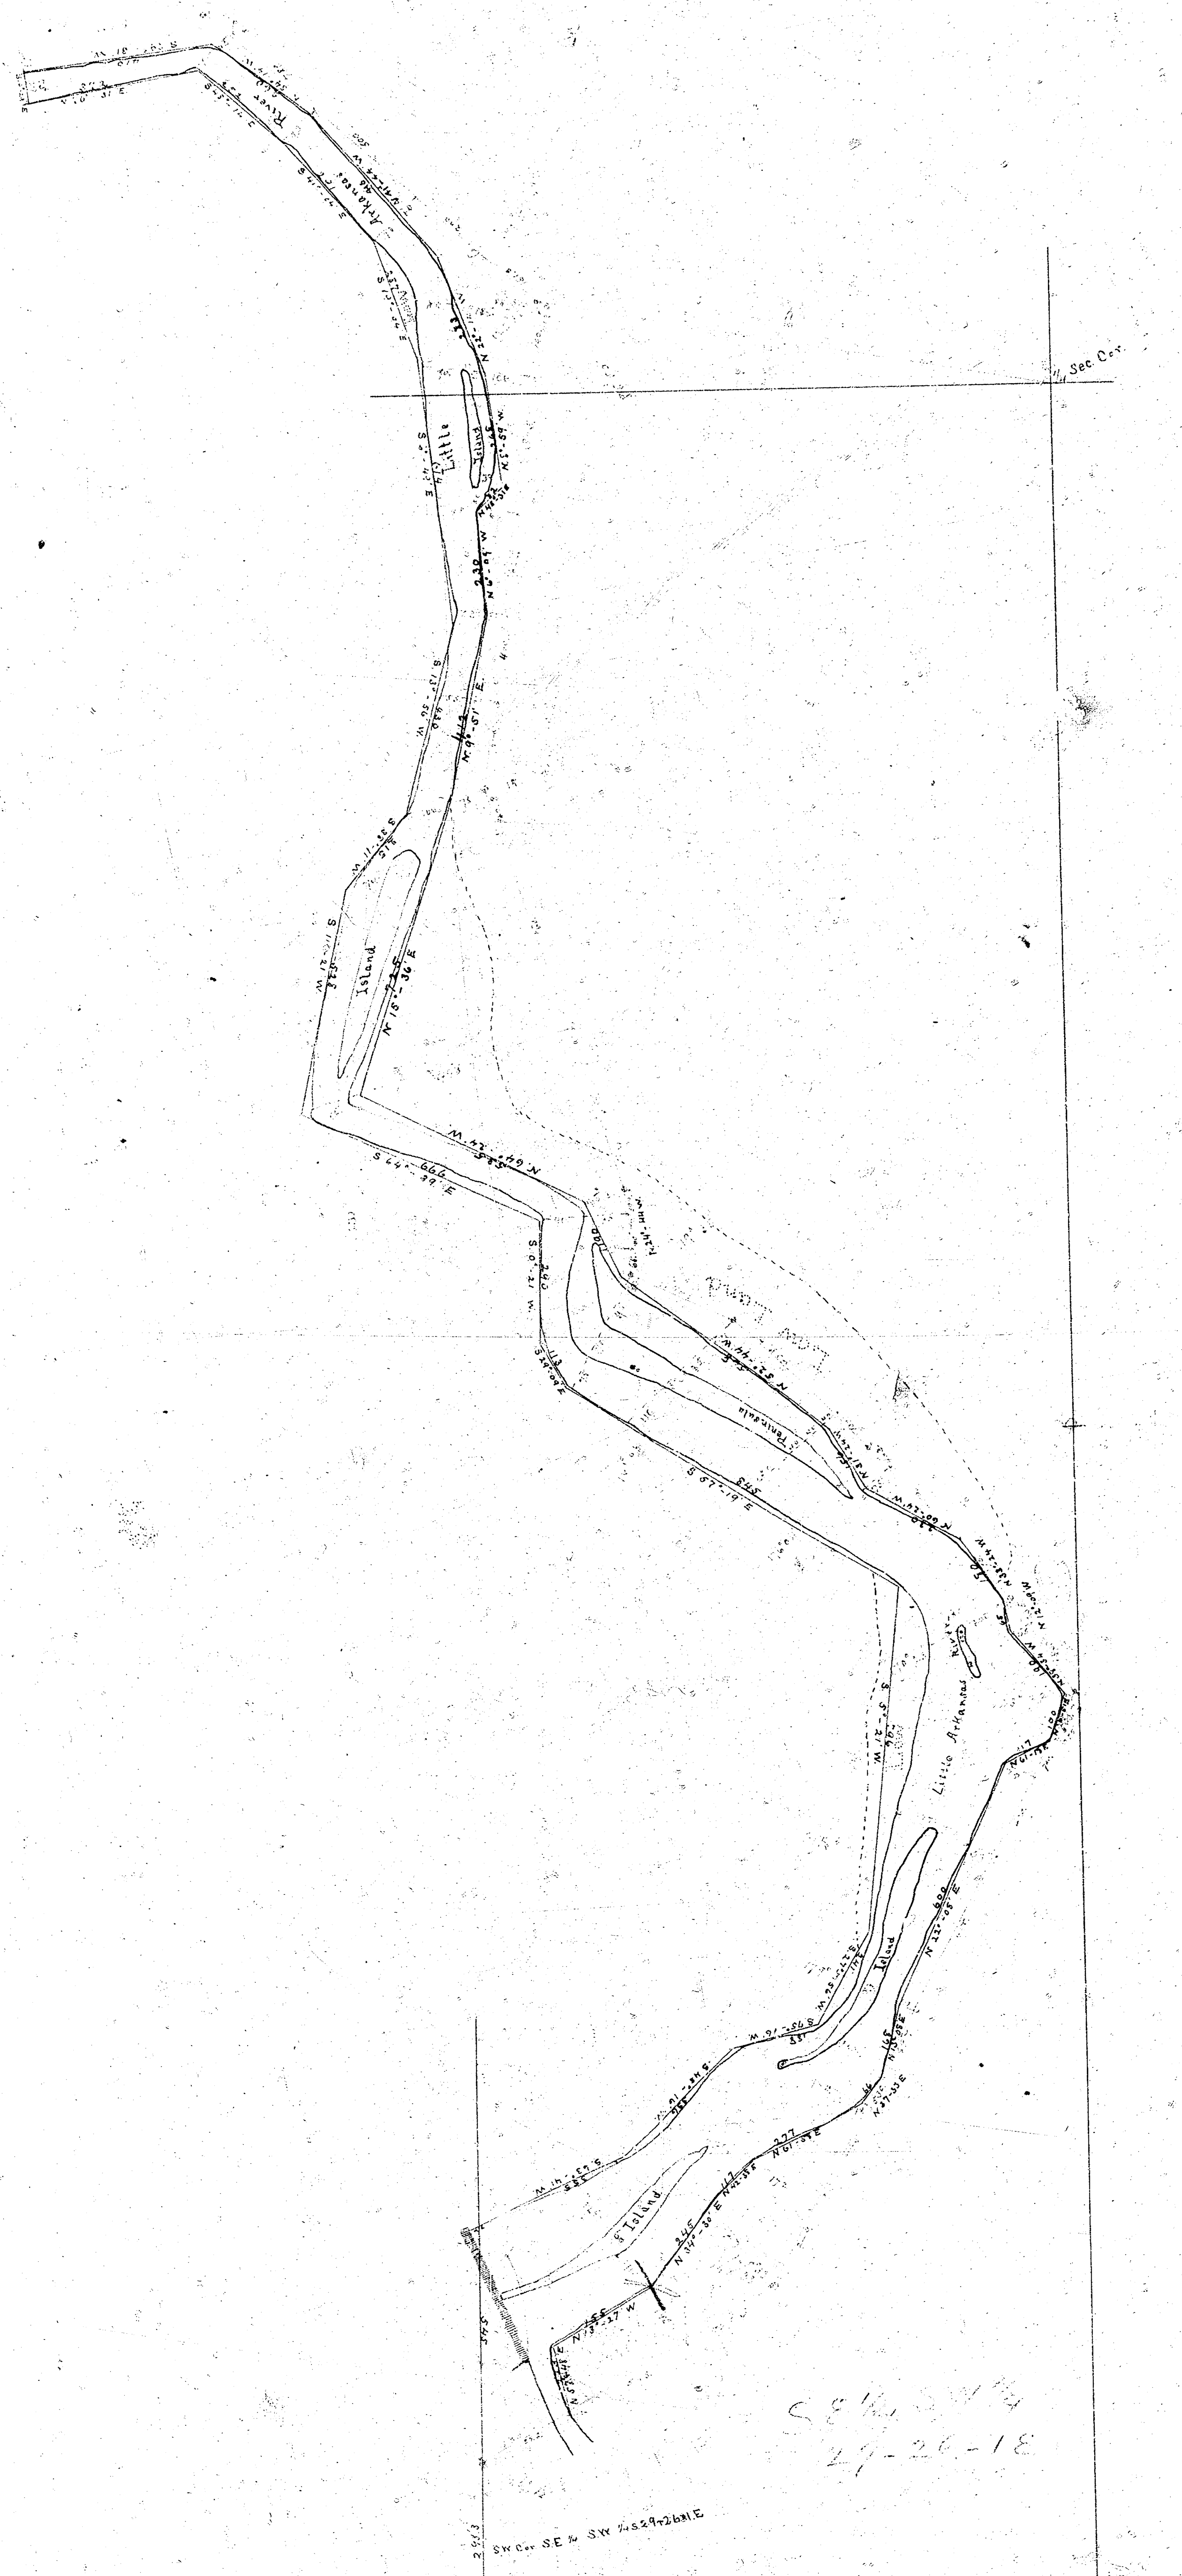

Map of Mill Pond
and
Little Arkansas River
North from the Dam
in Sec. 29. Tow. 26 S. Range 1. E of 6 P.M.