

Field Notes of Survey of Mill Pond and Little Arkansas River
in Sec. 29, T. 26 S., R. 1 E., 6 P.M.

Map of Mill Pond
 and
 Little Arkansas River
 North from the Dam
 in Sec. 29, T. 26 S., R. 1 E., 6 P.M.

SE 1/4 SW 1/4
 29-26-1E


Field Notes of Survey of Mill Pond and Little Arkansas River North from the Dam in Sec. 29, Tows. 26.5, Range 1 E. 96 P.M.

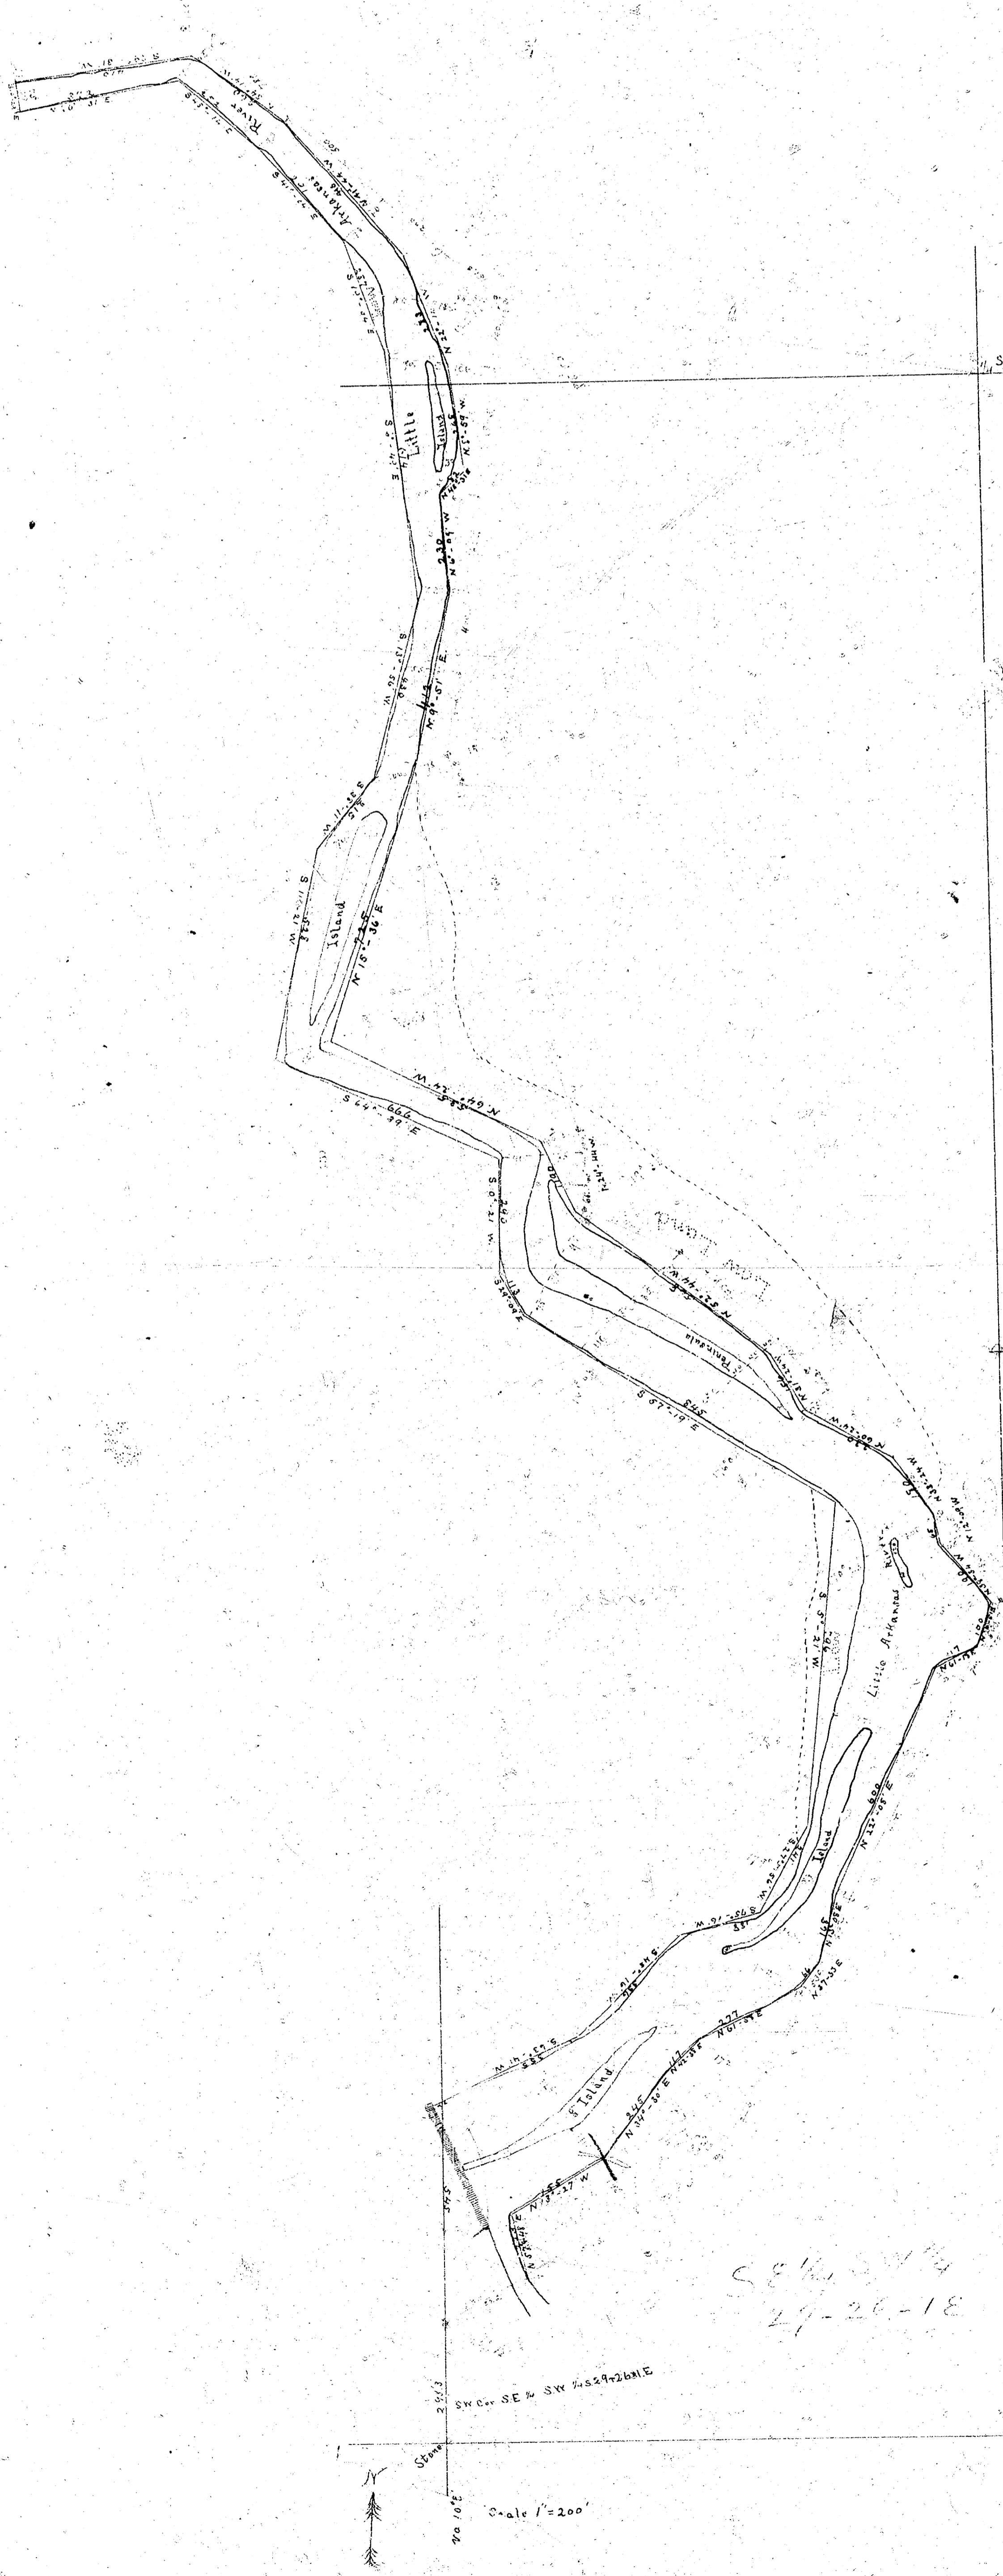

Map of Mill Pond and Little Arkansas River North from the Dam in Sec. 29, Tows. 26.5, Range 1 E. 96 P.M.

C. E. ...

Scale 1" = 200'