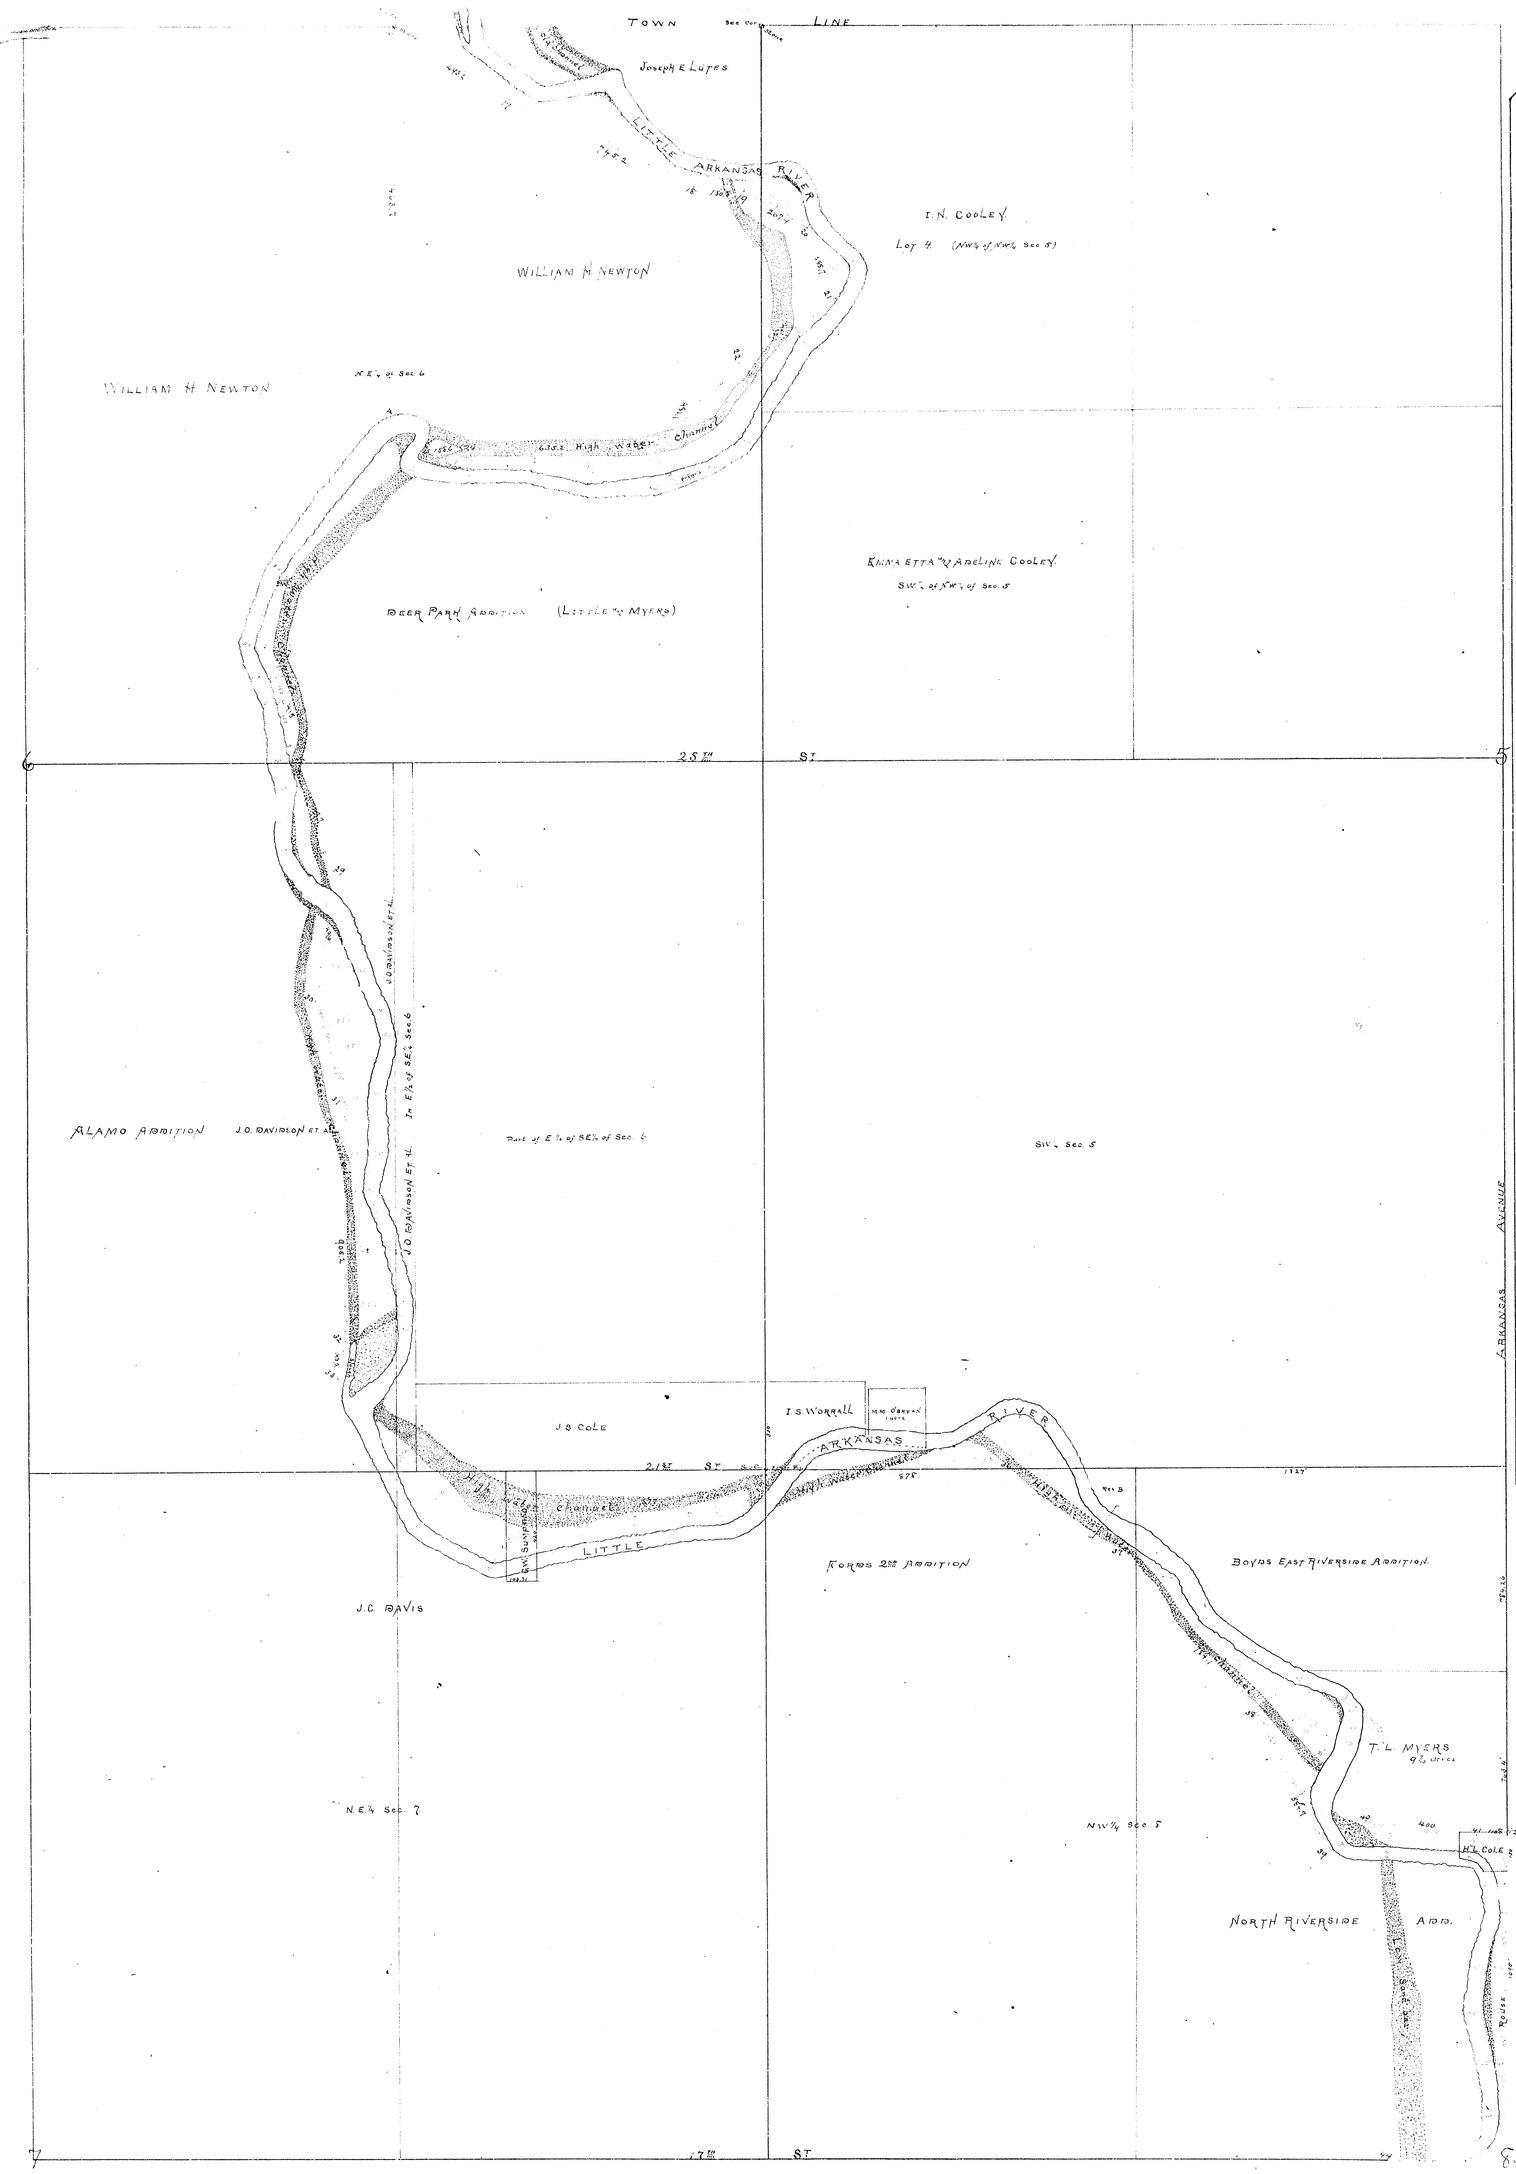

Variance	Course	Distance
S 17° E	37° E	605 feet
S 32° E	17° E	267
N 75° E	36° E	77
S 21° E	83° E	7.
S 5° E	46° E	14.
S 14° E	55° E	98
S 77° E	36° E	334
N 15° E	63° E	138
S 42° E	88° E	87
S 15° E	36° E	140
S 38° E	58° E	245
S 5° E	84° E	77
S 39° E	72° W	198
S 17° E	47° W	275
S 30° E	74° W	467
S 79° E	33° W	209
S 69° E	53° W	171
S 38° E	15° W	234
N 76° E	88° W	261
S 89° E	86° W	216
N 11° E	54° W	146
N 67° E	82° W	33
N 5° E	17° W	51
N 24° E	55° E	131
S 76° E	41° W	55
S 37° E	25° W	647
S 18° E	21° W	233
S 24° E	85° E	127
S 13° E	46° E	411
S 1° E	17° W	254
S 33° E	44° E	113
S 34° E	36° E	167
S 20° E	53° E	471
S 10° E	36° E	144
S 12° E	45° W	187
S 5° E	54° E	334
S 13° E	24° W	158
S 35° E	97° E	162
S 13° E	13° E	334
S 2° E	43° E	156
S 7° E	13° W	149
S 30° E	37° W	258
S 19° E	16° E	193
S 46° E	12° E	241
S 29° E	10° E	280
N 77° E	85° E	359
N 82° E	29° E	481
N 83° E	13° E	114
N 53° E	86° E	121
N 76° E	33° E	286
N 62° E	07° E	154
S 38° E	05° E	377
N 25° E	75° E	272
S 53° E	06° E	117
S 45° E	05° E	72
S 30° E	57° E	166
S 21° E	57° E	137
S 40° E	44° E	309
S 11° E	52° E	205
S 27° E	37° E	143
S 56° E	30° E	332
S 06° E	26° E	232
S 33° E	61° E	106
S 6° E	57° W	131
S 24° W	54° W	237
S 2° W	42° E	42
S 24° W	07° E	113
S 54° W	33° E	403
S 45° W	43° E	32
S 7° W	22° E	182
S 13° W	42° W	235
S 5° W	14° W	132
S 18° W	15° E	324
S 3° W	04° W	147
S 35° W	21° W	53
S 29° W	28° W	94
	Wed	130
N 64° W	57° E	170
N 1° W	59° E	169
N 12° W	08° W	293
N 9° W	13° E	282
N 12° W	57° E	192
N 15° W	41° W	162
N 85° W	54° W	474
N 53° W	12° W	66
N 26° W	04° W	172
N 0° W	26° E	61
N 29° W	15° E	163
N 13° W	55° E	159
N 31° W	23° W	60
N 69° W	57° W	167
N 57° W	53° W	327
N 27° W	43° W	176
N 29° W	03° W	159
N 53° W	10° W	298
N 43° W	38° W	144
N 17° W	33° W	123
N 31° W	25° W	190
N 47° W	43° W	95
S 33° W	12° W	76
S 38° W	40° W	217
S 8° W	26° W	103
S 80° W	34° W	241
S 71° W	31° W	177
S 37° W	05° W	311
S 58° W	44° W	110
S 87° W	15° W	211
S 77° W	43° W	277
N 61° W	40° W	298
N 14° W	27° W	65
N 28° W	38° W	683
N 51° W	57° E	100
N 23° W	30° E	115
North on 30 Rod line.		226
N 16° W	59° W	226
N 14° W	34° E	283
N 21° W	43° W	473
N 44° W	57° W	337
N 19° W	51° W	159
N 0° W	10° E	217
N 17° W	45° W	181 (P.C. Cooley line on b)
N 4° W	15° W	190 Rod
N 19° W	53° W	387
N 18° W	49° E	326
N 35° W	43° E	644
N 65° W	43° E	111
S 79° W	12° E	91
S 25° W	57° E	44
S 12° W	18° W	127
S 74° W	87° E	113
S 29° W	43° E	230
S 76° W	34° E	217
N 84° W	45° E	257
N 73° W	10° E	176
N 59° W	34° E	100
N 23° W	07° E	401
N 42° W	24° E	157
N 41° W	25° E	131
N 41° W	07° W	220
N 16° W	28° W	140
N 43° W	45° W	67
S 85° W	43° W	170
N 77° W	56° W	241
N 49° W	80° W	287
N 13° W	16° W	101
N 89° W	51° W	243
N 53° W	24° W	117
N 3° W	23° W	92
Back		64

July - 1891.

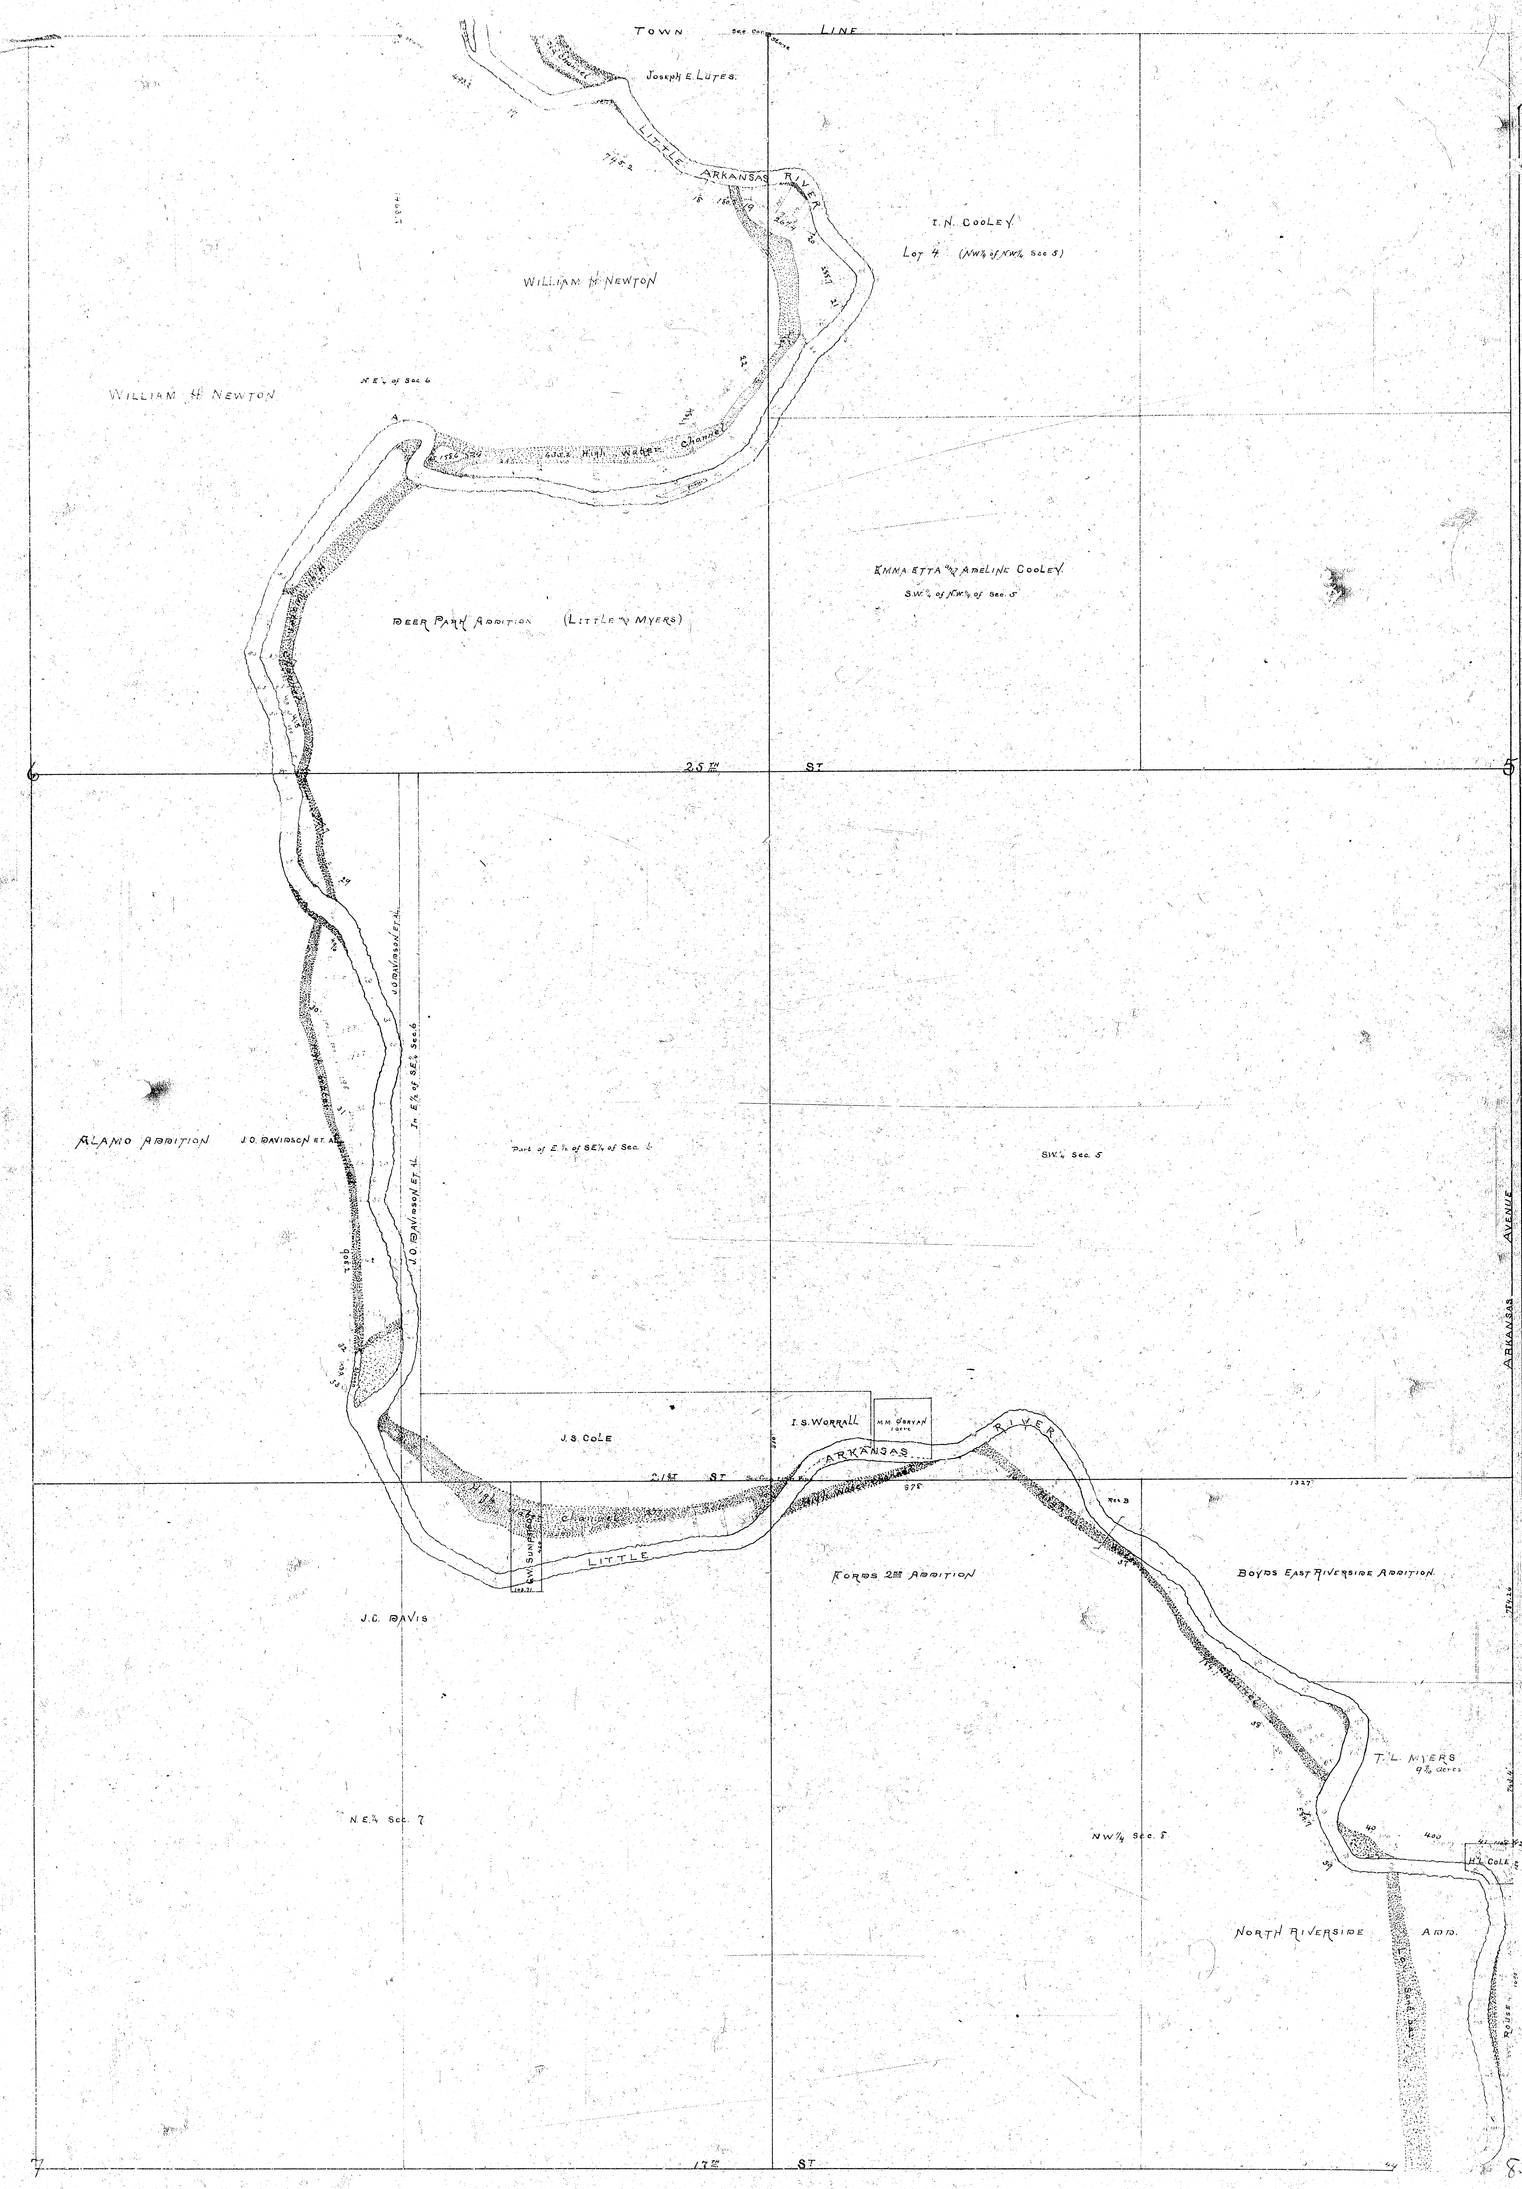

Distance	Bearing	
9.17	27 W	60 F.L.
S 53	12 W	261
N 77	56 E	237
S 31	21 E	7
S 2	41 E	114
S 4	56 E	58
S 77	26 E	254
S 33	43 E	118
S 42	10 E	87
S 15	36 E	140
S 38	53 E	242
S 3	04 E	7
S 29	37 W	144
S 19	47 W	272
18 30	24 W	267
S 57	30 W	207
S 49	23 W	171
S 28	15 W	234
N 76	28 W	281
S 55	46 W	216
N 81	54 W	166
N 67	56 W	50
N 5	17 W	271
N 24	58 E	113
S 70	41 W	55
S 57	22 W	277
S 18	53 W	233
S 29	44 E	137
S 13	44 E	91
S 3	17 W	221
S 33	44 E	113
S 53	36 E	127
S 28	43 W	478
S 10	26 E	104
S 12	42 W	187
S 5	54 E	234
S 13	04 W	153
S 55	09 E	142
S 13	14 E	234
S 3	43 E	104
S 7	12 W	117
S 30	37 W	259
S 19	16 E	192
S 26	12 E	240
S 59	10 E	230
N 77	22 E	190
N 56	29 E	401
N 27	17 E	114
N 47	37 E	121
N 36	33 E	234
N 16	07 E	174
S 34	08 E	377
N 58	42 E	242
S 10	02 E	117
S 40	45 E	53
S 16	39 E	166
S 21	53 E	137
S 65	44 E	209
S 42	23 E	221
S 27	37 E	112
S 60	13 E	330
S 06	20 E	356
S 57	06 E	106
S 16	37 W	132
S 36	40 W	237
S 3	13 E	43
S 34	37 E	118
S 56	38 E	473
S 45	03 E	133
S 77	25 E	281
S 19	42 W	232
S 5	13 W	133
S 18	17 E	310
S 4	04 W	147
S 38	20 W	53
S 59	34 W	90
	Thick	130
N 66	07 E	172
N 7	46 E	149
N 12	46 W	393
N 8	12 E	221
N 74	57 E	132
N 15	43 W	167
N 55	04 W	454
N 53	14 W	64
N 20	04 W	132
N 0	06 E	61
N 29	18 E	163
N 12	55 E	150
N 3	33 W	40
N 49	07 W	147
N 50	51 W	242
N 37	02 W	176
N 37	03 W	110
N 28	16 W	237
N 48	30 W	144
N 17	33 W	173
N 37	32 W	150
N 43	43 W	93
N 33	14 W	76
S 49	42 W	213
N 31	26 W	183
N 84	04 W	511
N 77	32 W	117
N 37	08 W	277
N 28	46 W	110
N 63	43 E	277
N 77	13 W	277
N 61	03 W	276
N 61	03 W	123
N 14	34 W	112
N 42	44 W	67
N 73	36 W	170
N 77	36 W	271
N 49	50 W	238
N 13	14 W	101
N 50	51 W	303
N 23	24 W	117
N 23	23 W	92
	Back	50

July - 1891.