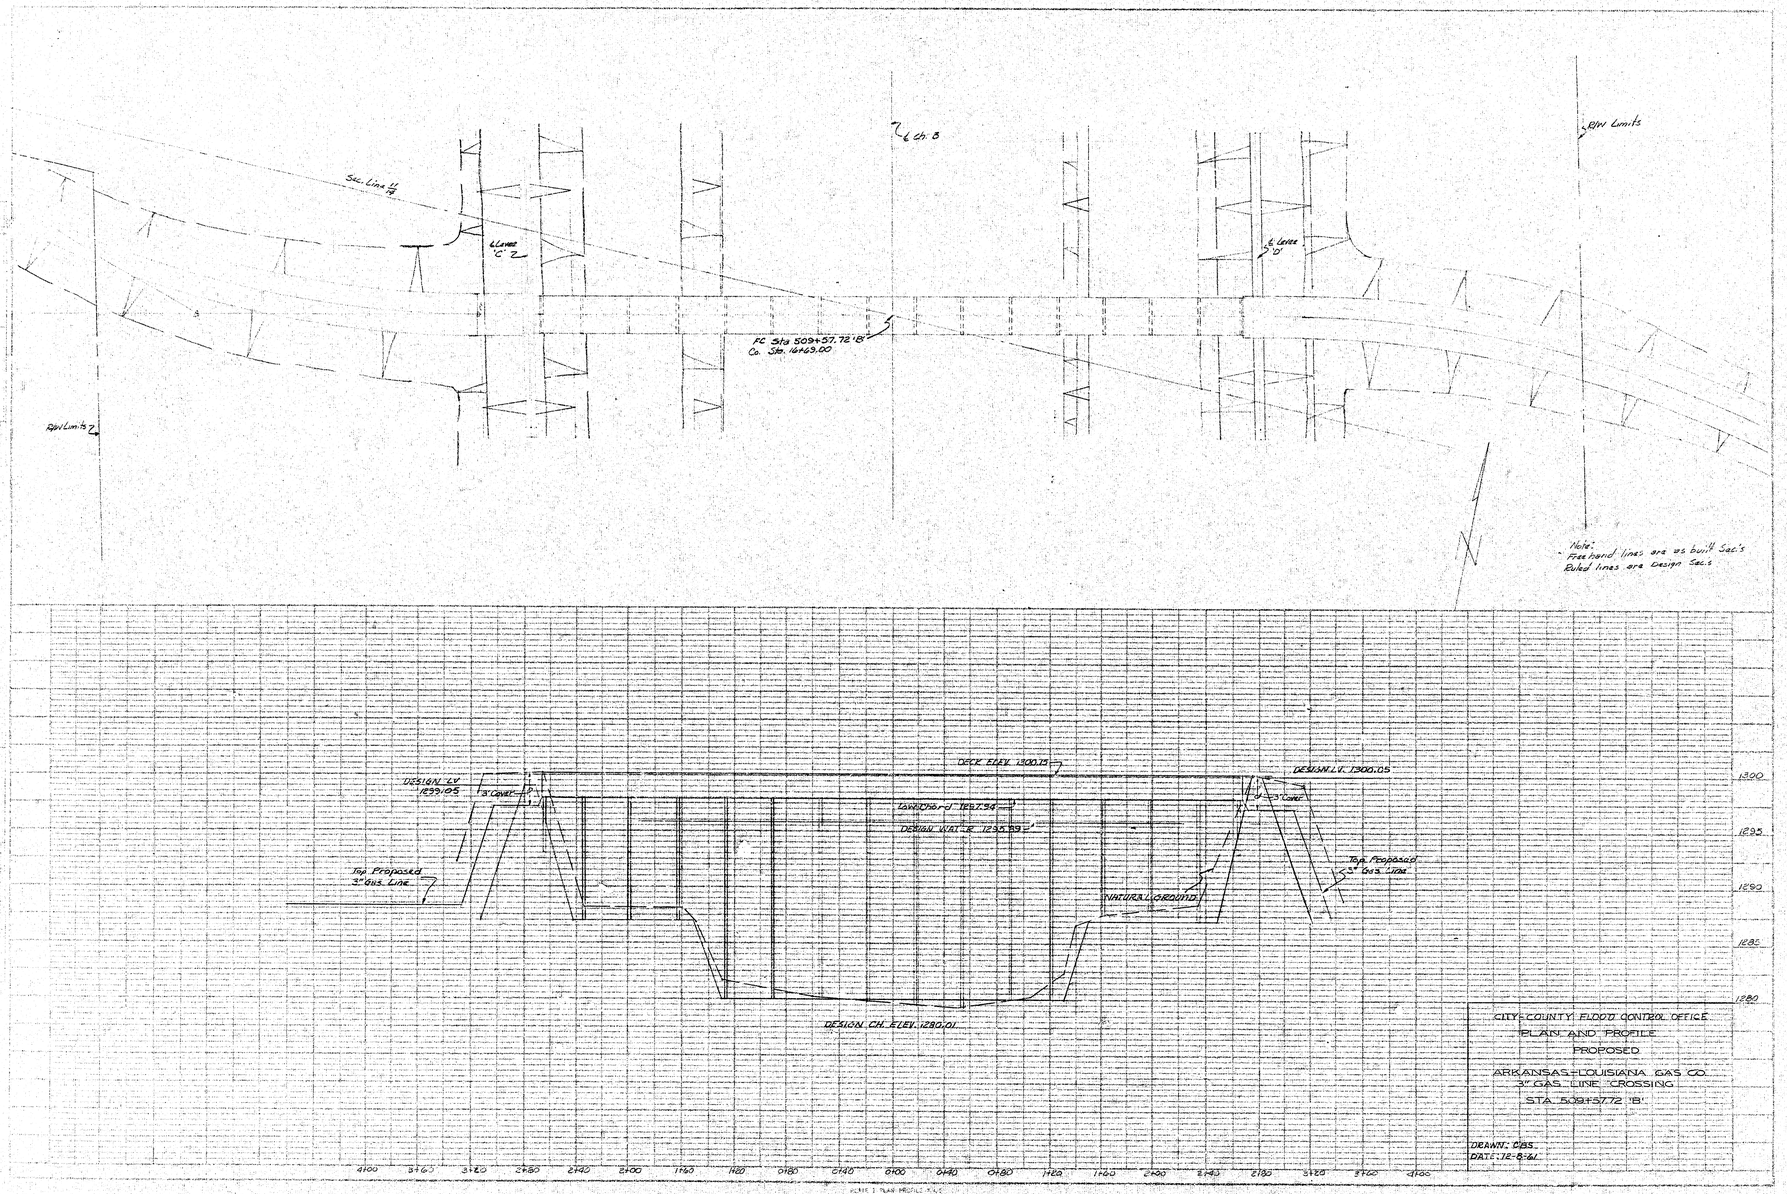

CITY-COUNTY FLOOD CONTROL OFFICE
PLAN AND PROFILE
PROPOSED
ARKANSAS-LOUISIANA GAS CO.
3" GAS LINE CROSSING
STA. 509+57.72 18"

DRAWN: CBS
DATE: 12-84-L