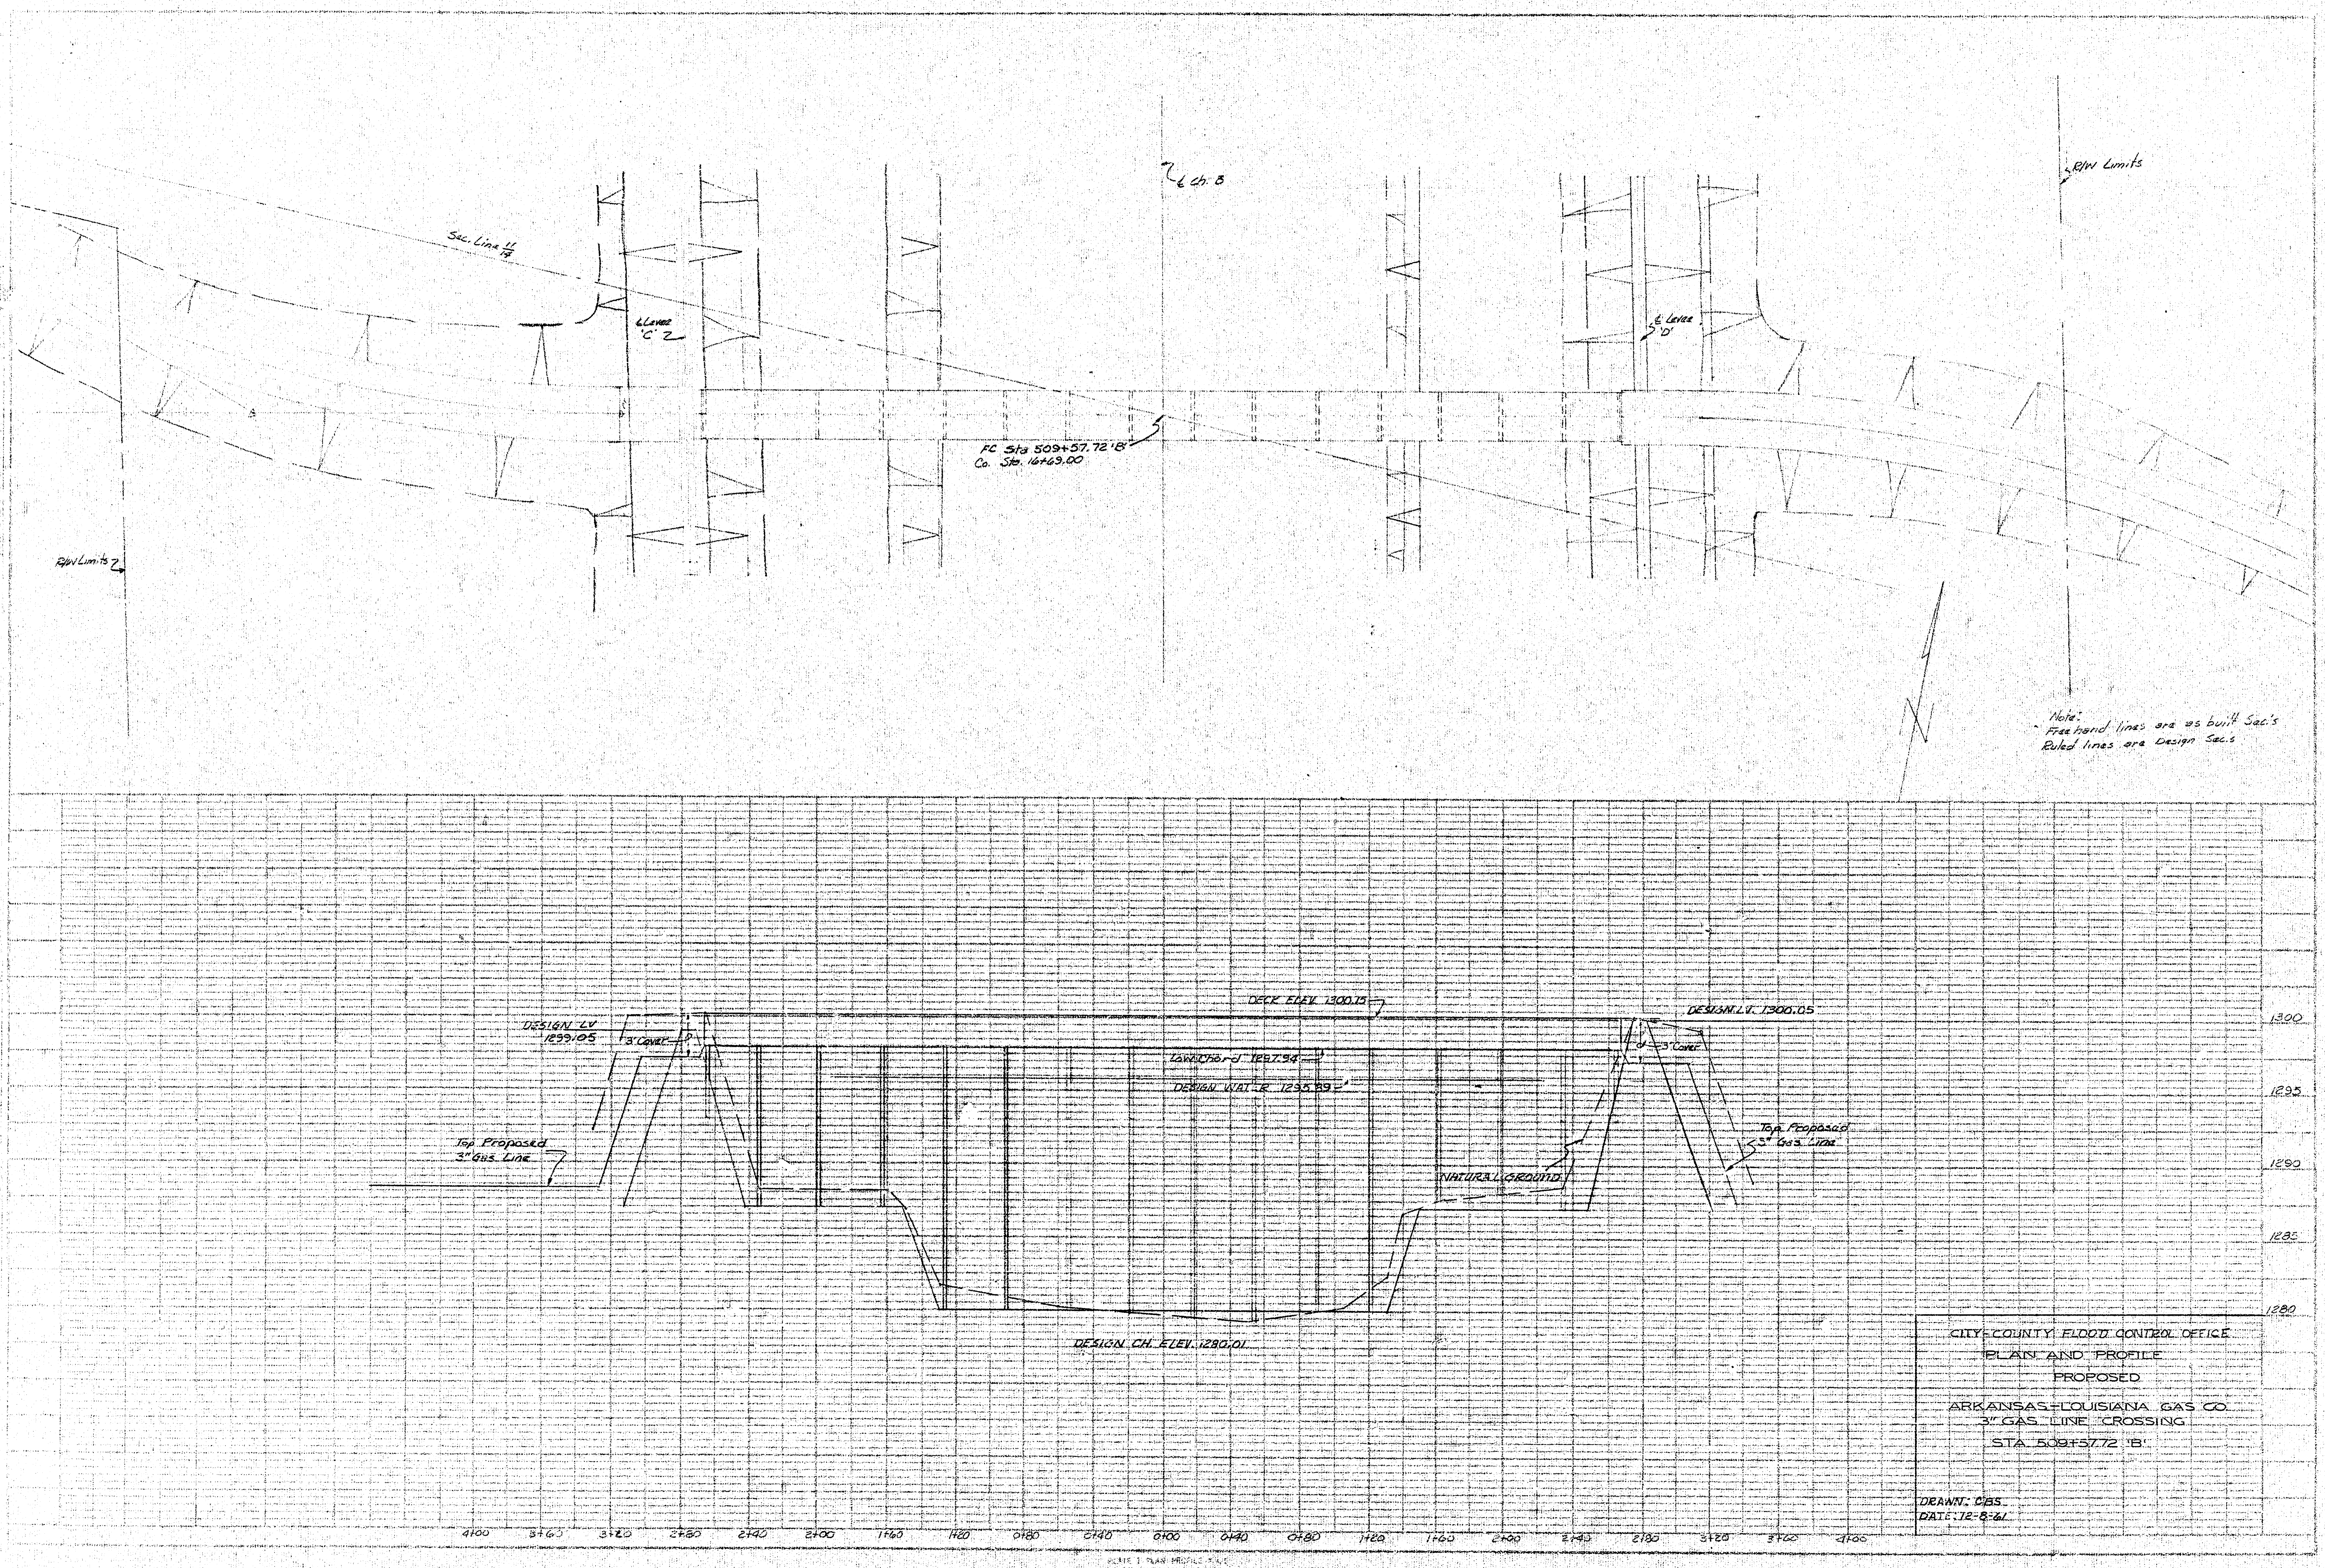
Sec. Line 11/14
℄ Levee 'C'
℄ Ch. B
FC Sta 509+57.72 'B'
Co. Sta. 16+69.00
R/W Limits
℄ Levee 'D'
R/W Limits
DESIGN LV 1299.05
3' Cover
DECK ELEV. 1300.15
DESIGN L.V. 1300.05
3' Cover
Low Chord 1297.94
DESIGN WATER 1295.89
Top Proposed 3" Gas Line
Top Proposed 3" Gas Line
NATURAL GROUND
DESIGN CH. ELEV. 1280.01
1300
1295
1290
1285
1280
4+00
3+60
3+20
2+80
2+40
2+00
1+60
1+20
0+80
0+40
0+00
0+40
0+80
1+20
1+60
2+00
2+40
2+80
3+20
3+60
4+00

Note:
Freehand lines are as built Sec's
Ruled lines are Design Sec's

CITY-COUNTY FLOOD CONTROL OFFICE
PLAN AND PROFILE
PROPOSED

ARKANSAS-LOUISIANA GAS CO.
3" GAS LINE CROSSING
STA. 509+57.72 'B'

DRAWN: CBS.
DATE: 12-8-61