
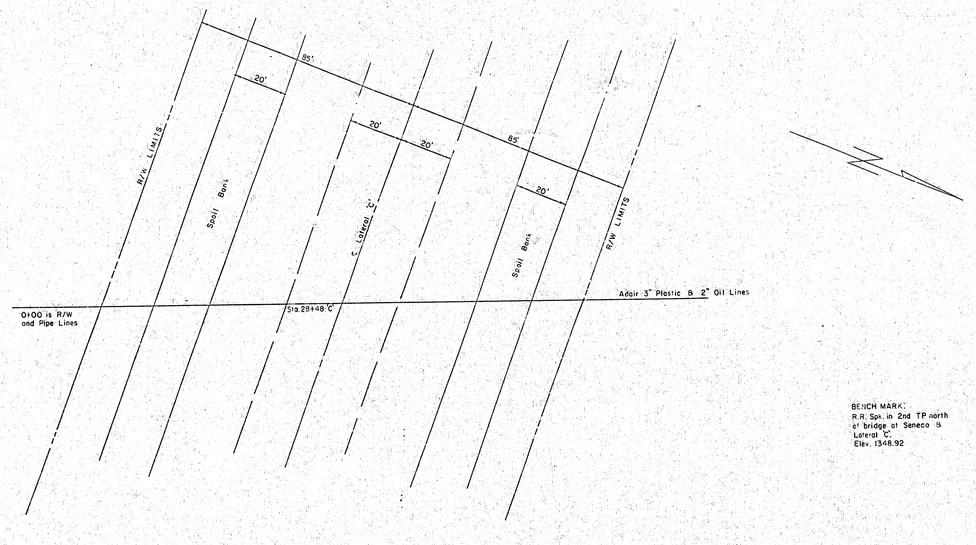


BENCH MARK:
R.R. Spk. in 2nd TP north of bridge at Seneca & Lateral 'C'.
Elev. 1348.92

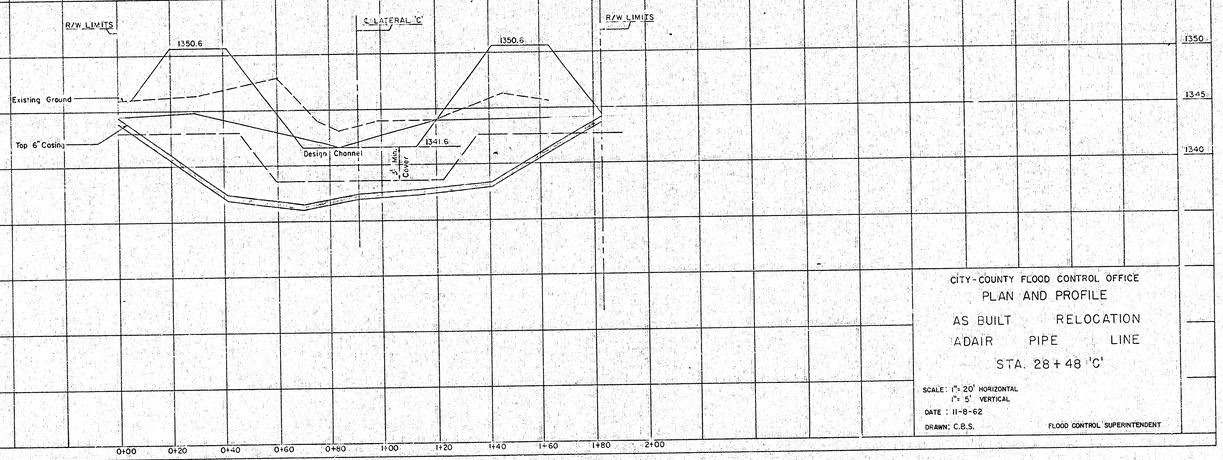

CITY-COUNTY FLOOD CONTROL OFFICE

PLAN AND PROFILE

AS BUILT RELOCATION

ADAIR PIPE LINE

STA. 28+48 'C'

SCALE: 1"= 20' HORIZONTAL
1"= 5' VERTICAL

DATE : 11-8-62

DRAWN: C.B.S.

FLOOD CONTROL SUPERINTENDENT