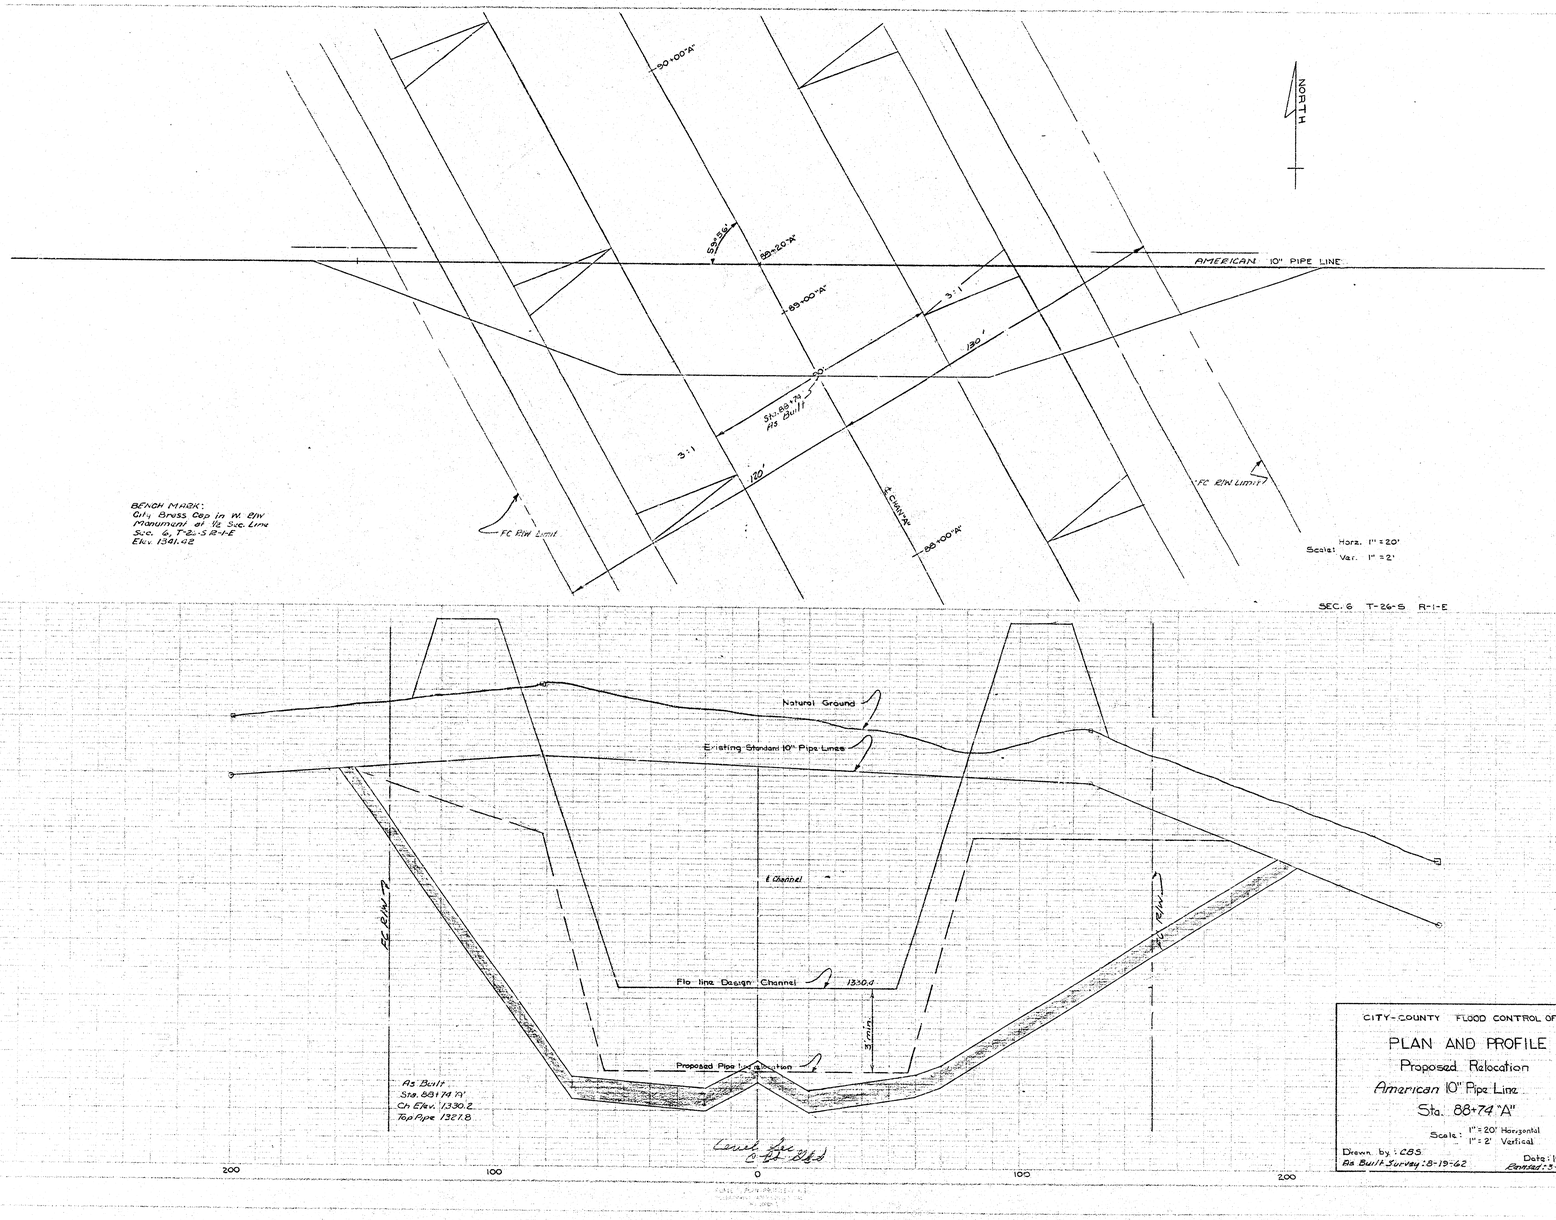


CITY-COUNTY FLOOD CONTROL OFFICE

PLAN AND PROFILE

Proposed Relocation

American 10" Pipe Line

Sta. 88+74 "A"

Scale: 1" = 20' Horizontal
1" = 2' Vertical

Drawn by: CBS Date: 10-23-59

As Built Survey: 8-19-62 Revised: 8-23-62