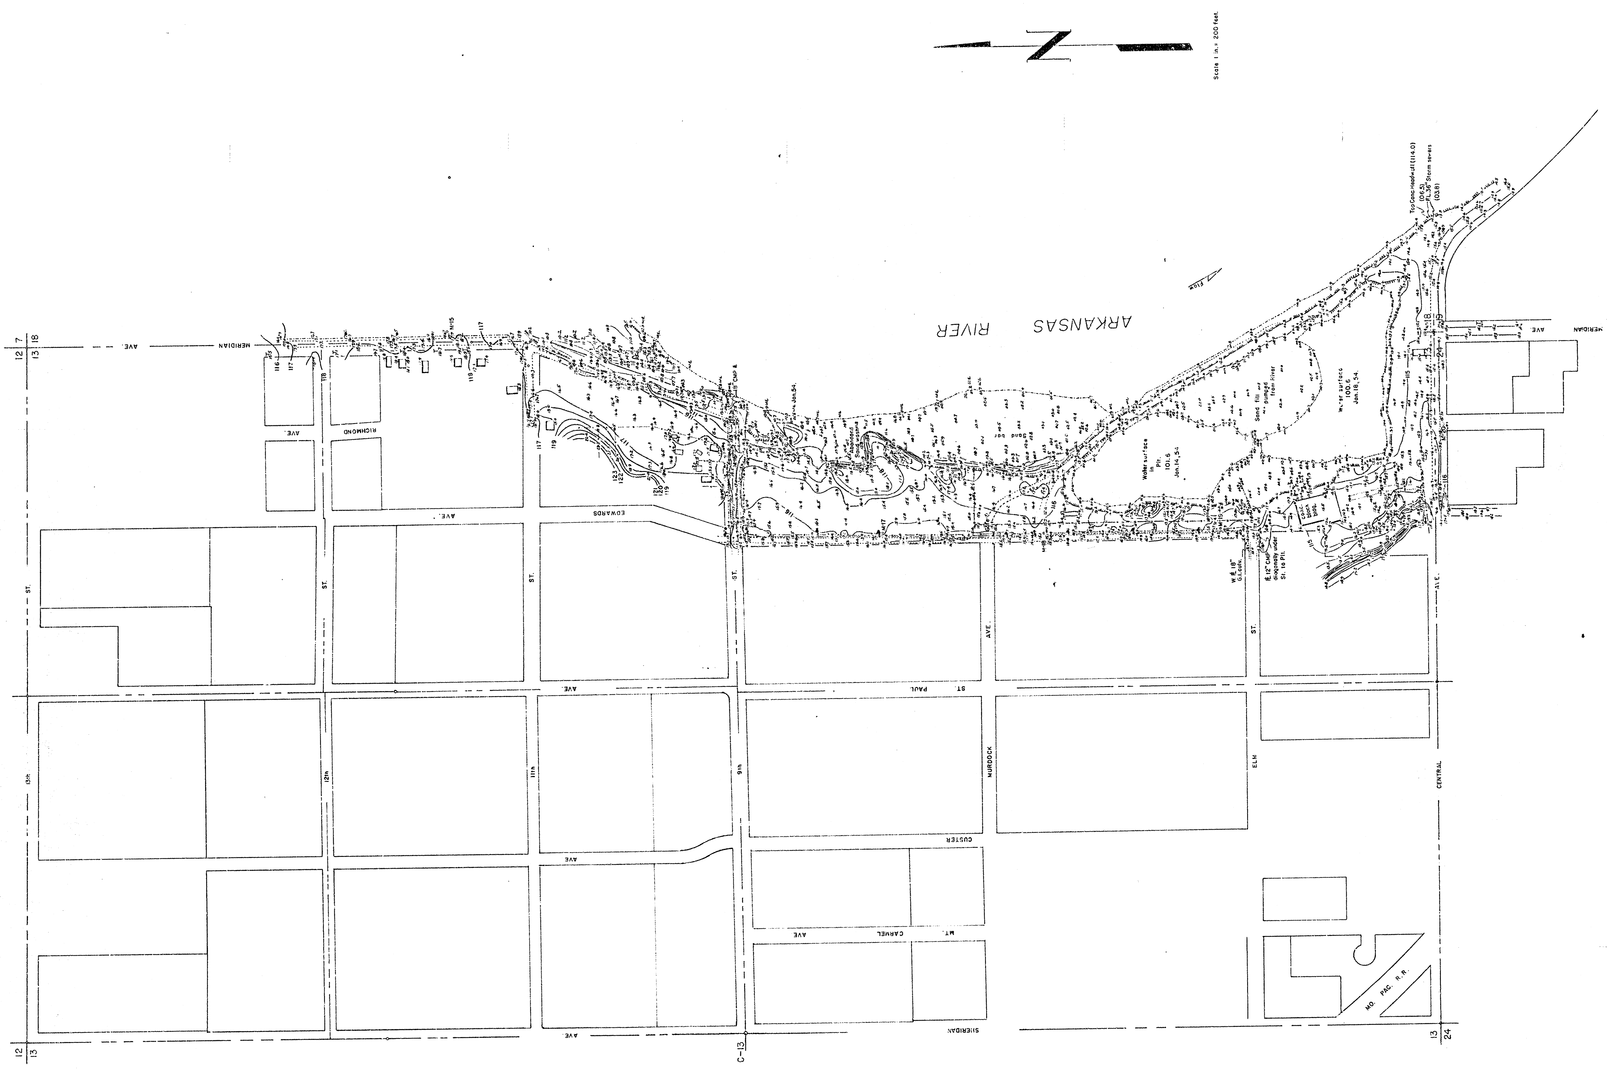
Scale 1 in. = 200 feet.
ARKANSAS RIVER
MERIDIAN AVE.
RICHMOND AVE.
COWANDS AVE.
ST. PAUL AVE.
CUSTER AVE.
CARNEL AVE.
SHERIDAN AVE.
MURDOCK AVE.
ELM ST.
CENTRAL AVE.
MO. PAC. R.R.
12 7
13 18
12 13
13 24
C-13