


NEIGHBORHOOD DEVELOPMENT PLAN BICYCLE PATH IMPROVEMENT PROJECT FOR

URBAN RENEWAL AGENCY
OF THE WICHITA, KANSAS METROPOLITAN AREA

PROJECT NO. KANS. A-5-2

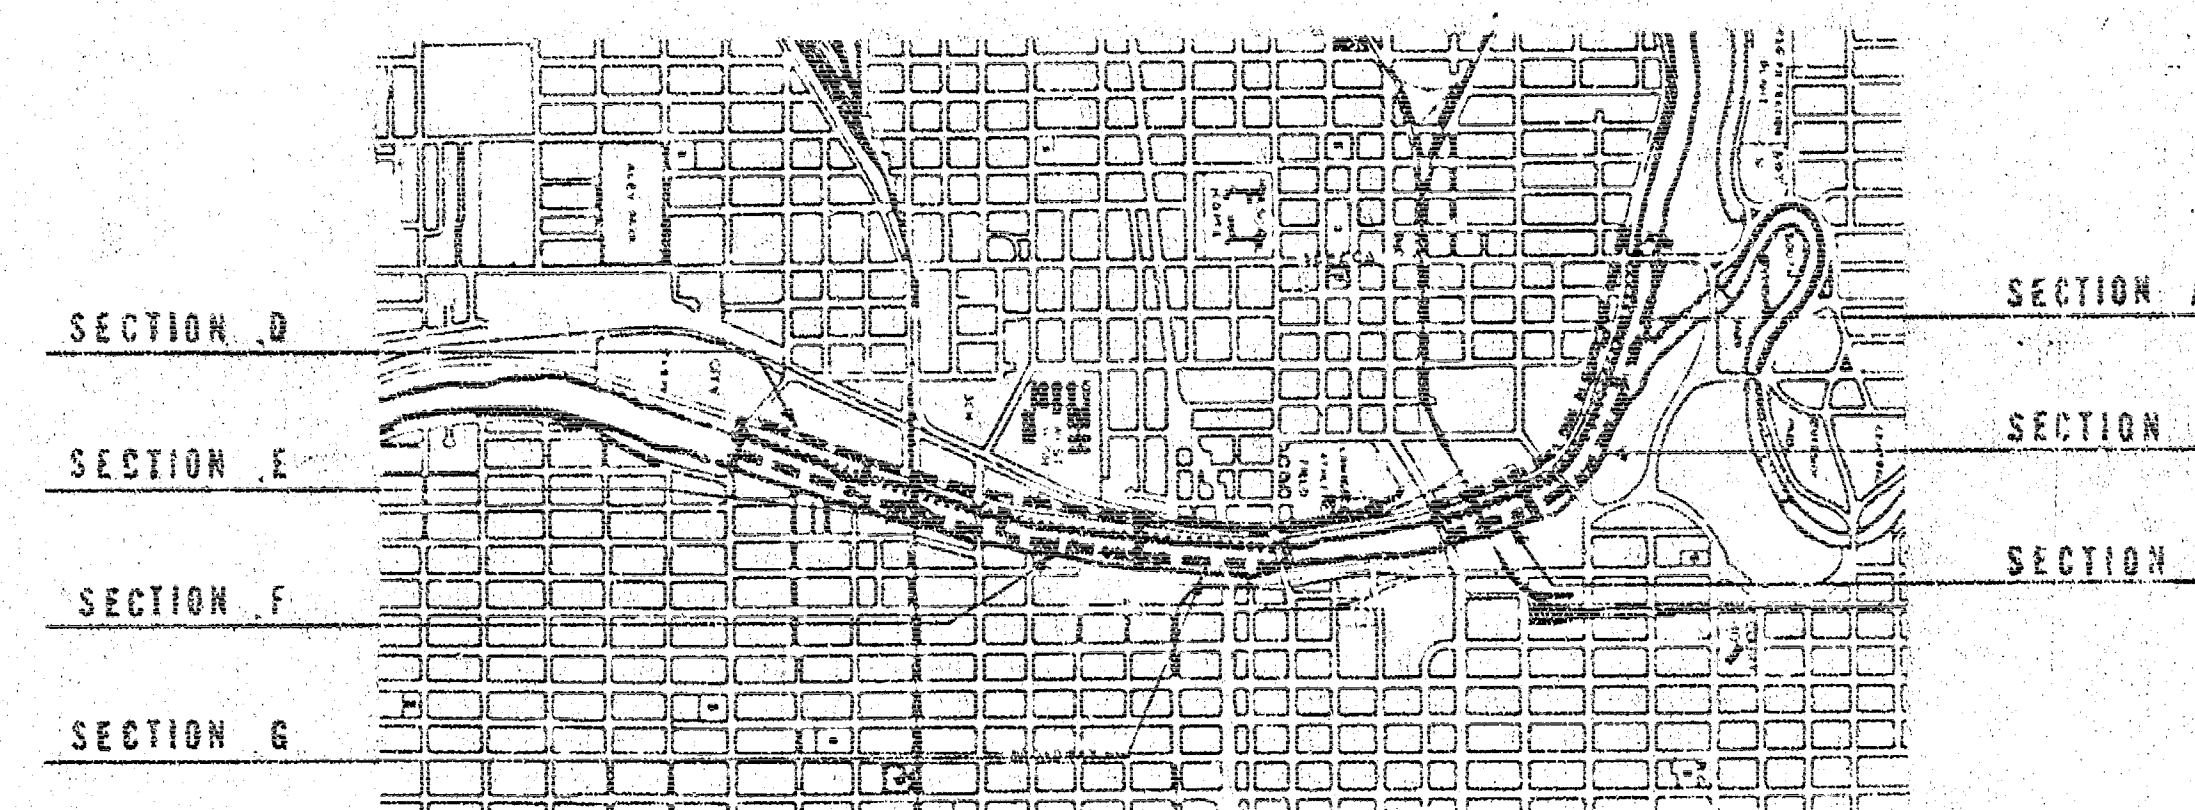

FLOOD CONTROL
OFFICE COPY
BOARD OF COMMISSIONERS

DR. O. H. CURRY
CHAIRMAN

DONALD H. ALLDRITT
COMMISSIONER

WILLIAM D. ANDERSON
COMMISSIONER

JAMES L. GARDNER
COMMISSIONER

ALBERT L. KAMAS
COMMISSIONER

KENNETH H. KITCHEN
EXECUTIVE DIRECTOR


Revised Plans.
(This plan sent to Cof's for Approval.)
2-10-71


JOHN GATES
Architect
805 East National Blvd.
Wichita, Kansas 67203

oblinger-smith
Planning Consultants /
Landscape Architects
1000 East Main Building
Wichita, Kansas

REVISIONS
SHEET TITLE
TITLE SHEET
DATE

PROJECT
BICYCLE PATH
URBAN RENEWAL
KANS A-5-2
SHEET
NUMBER 1 OF 8

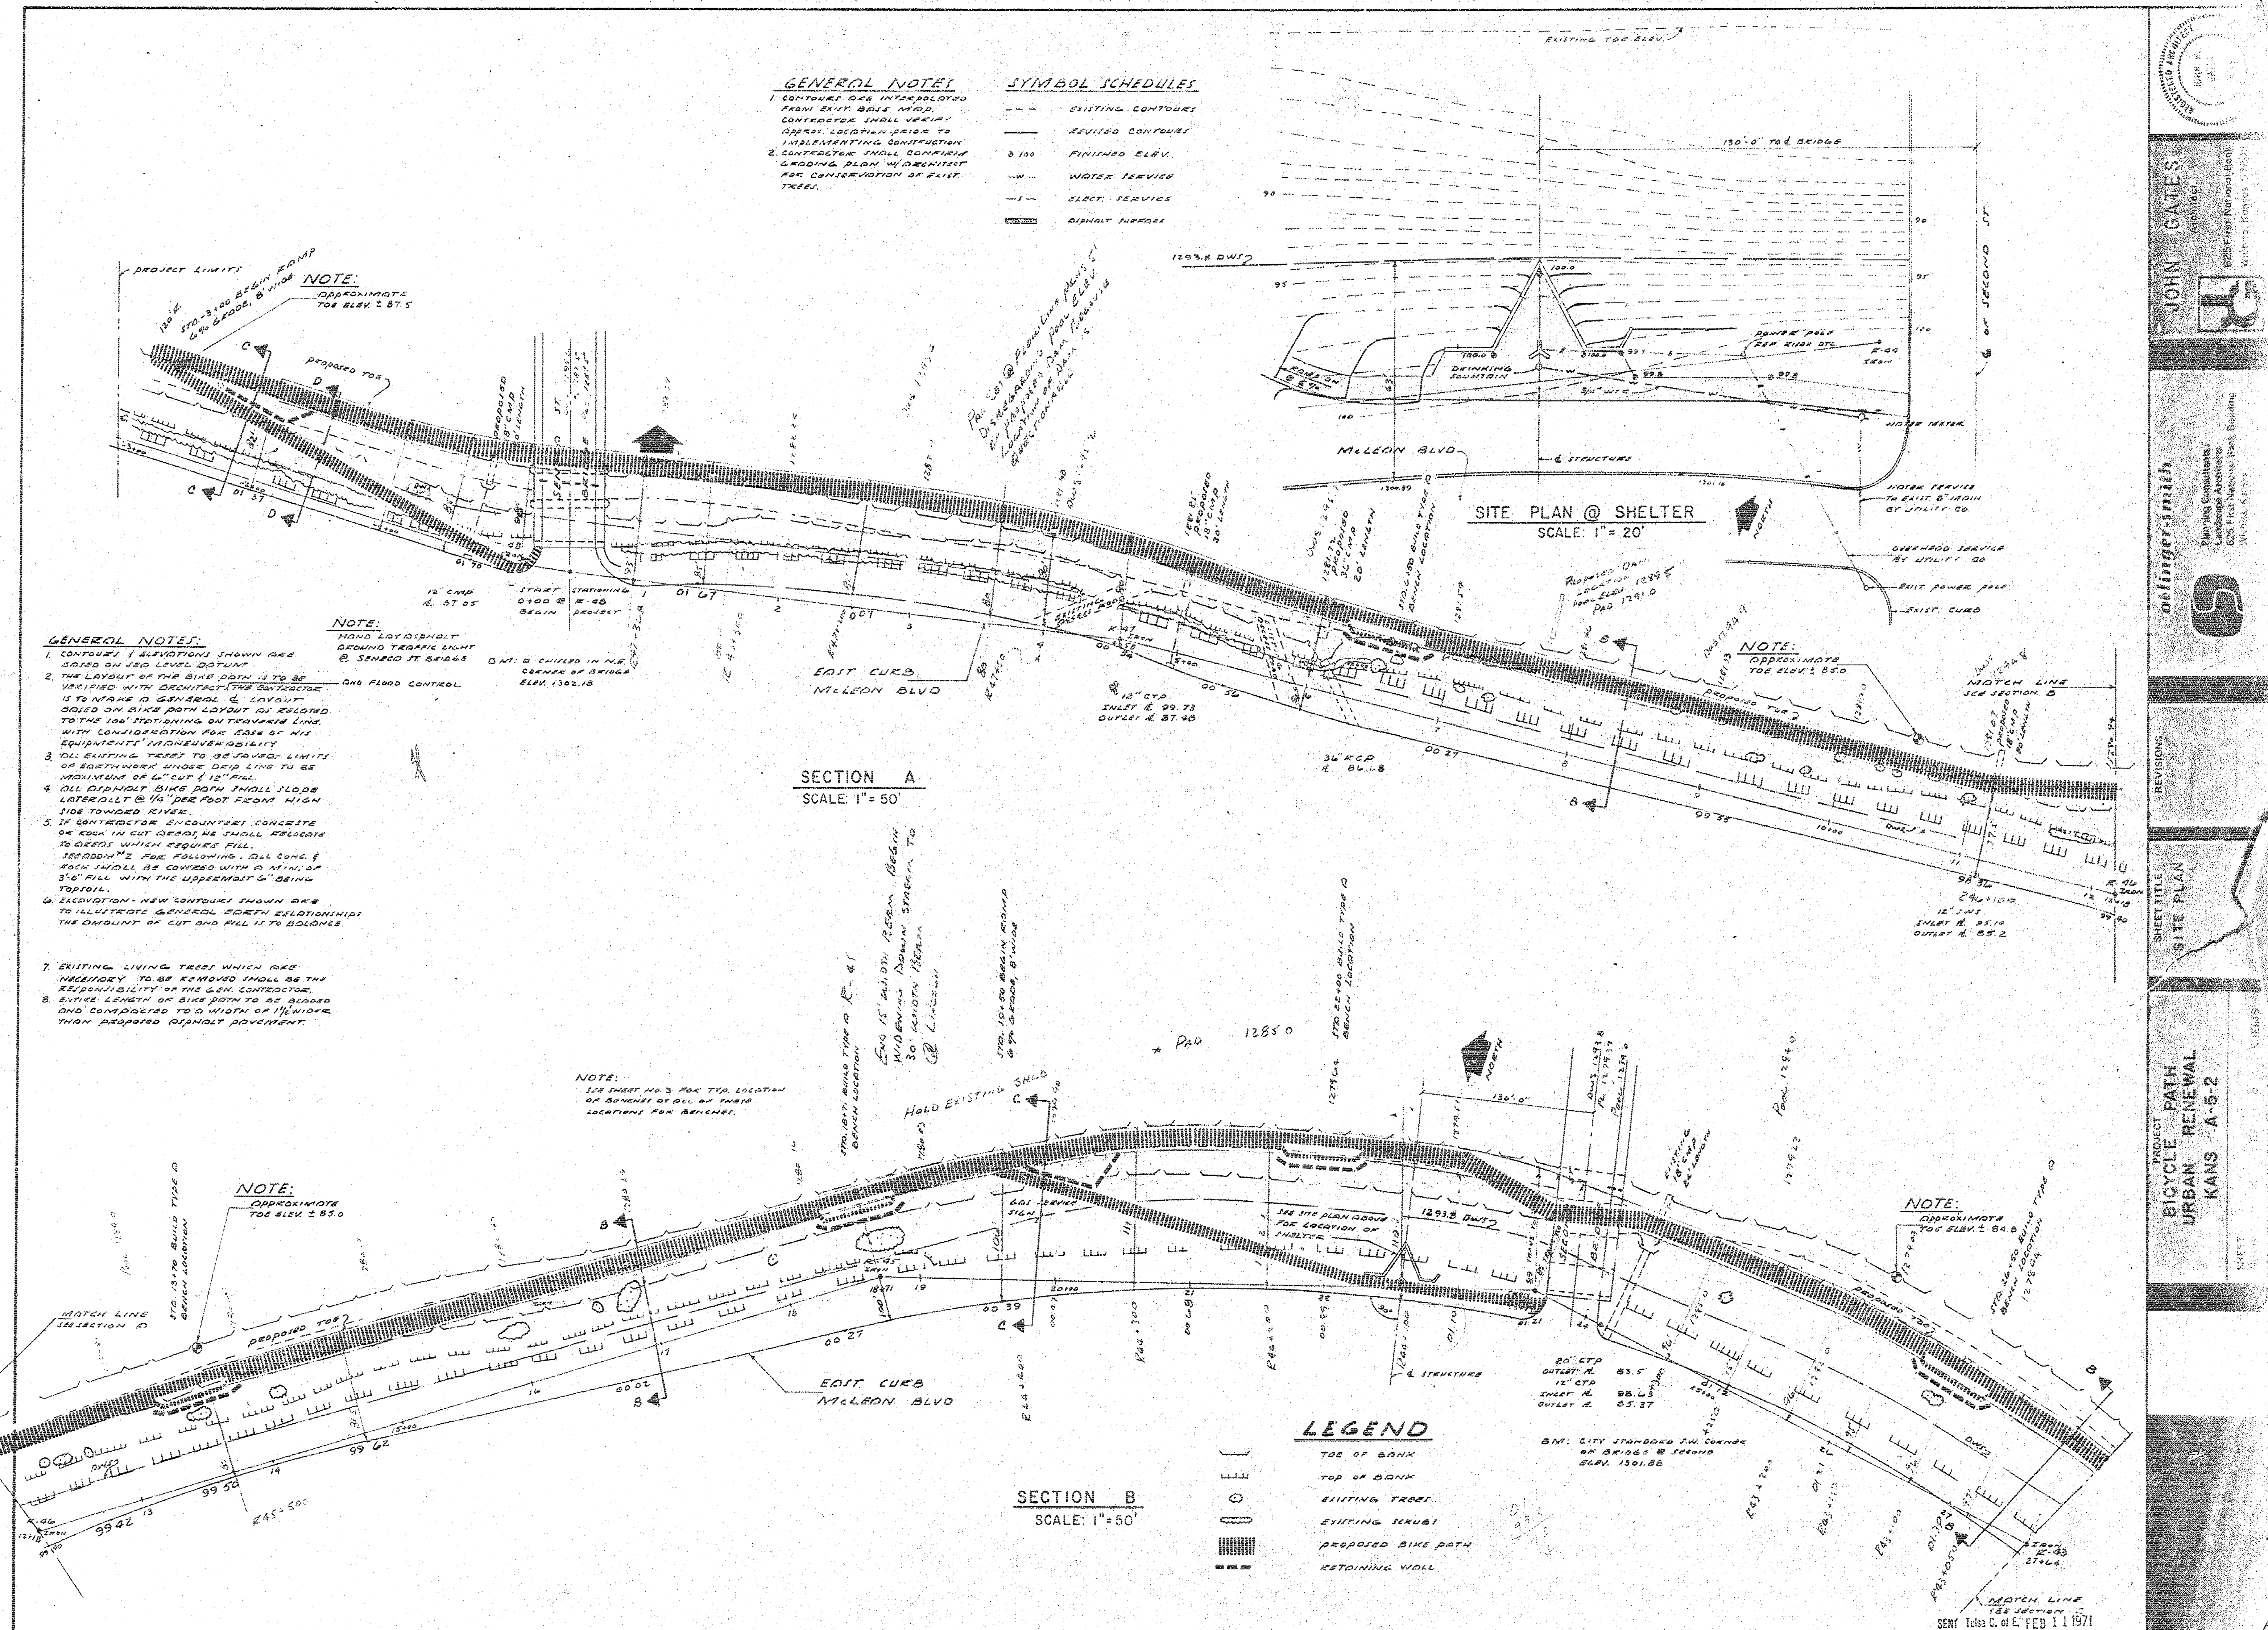

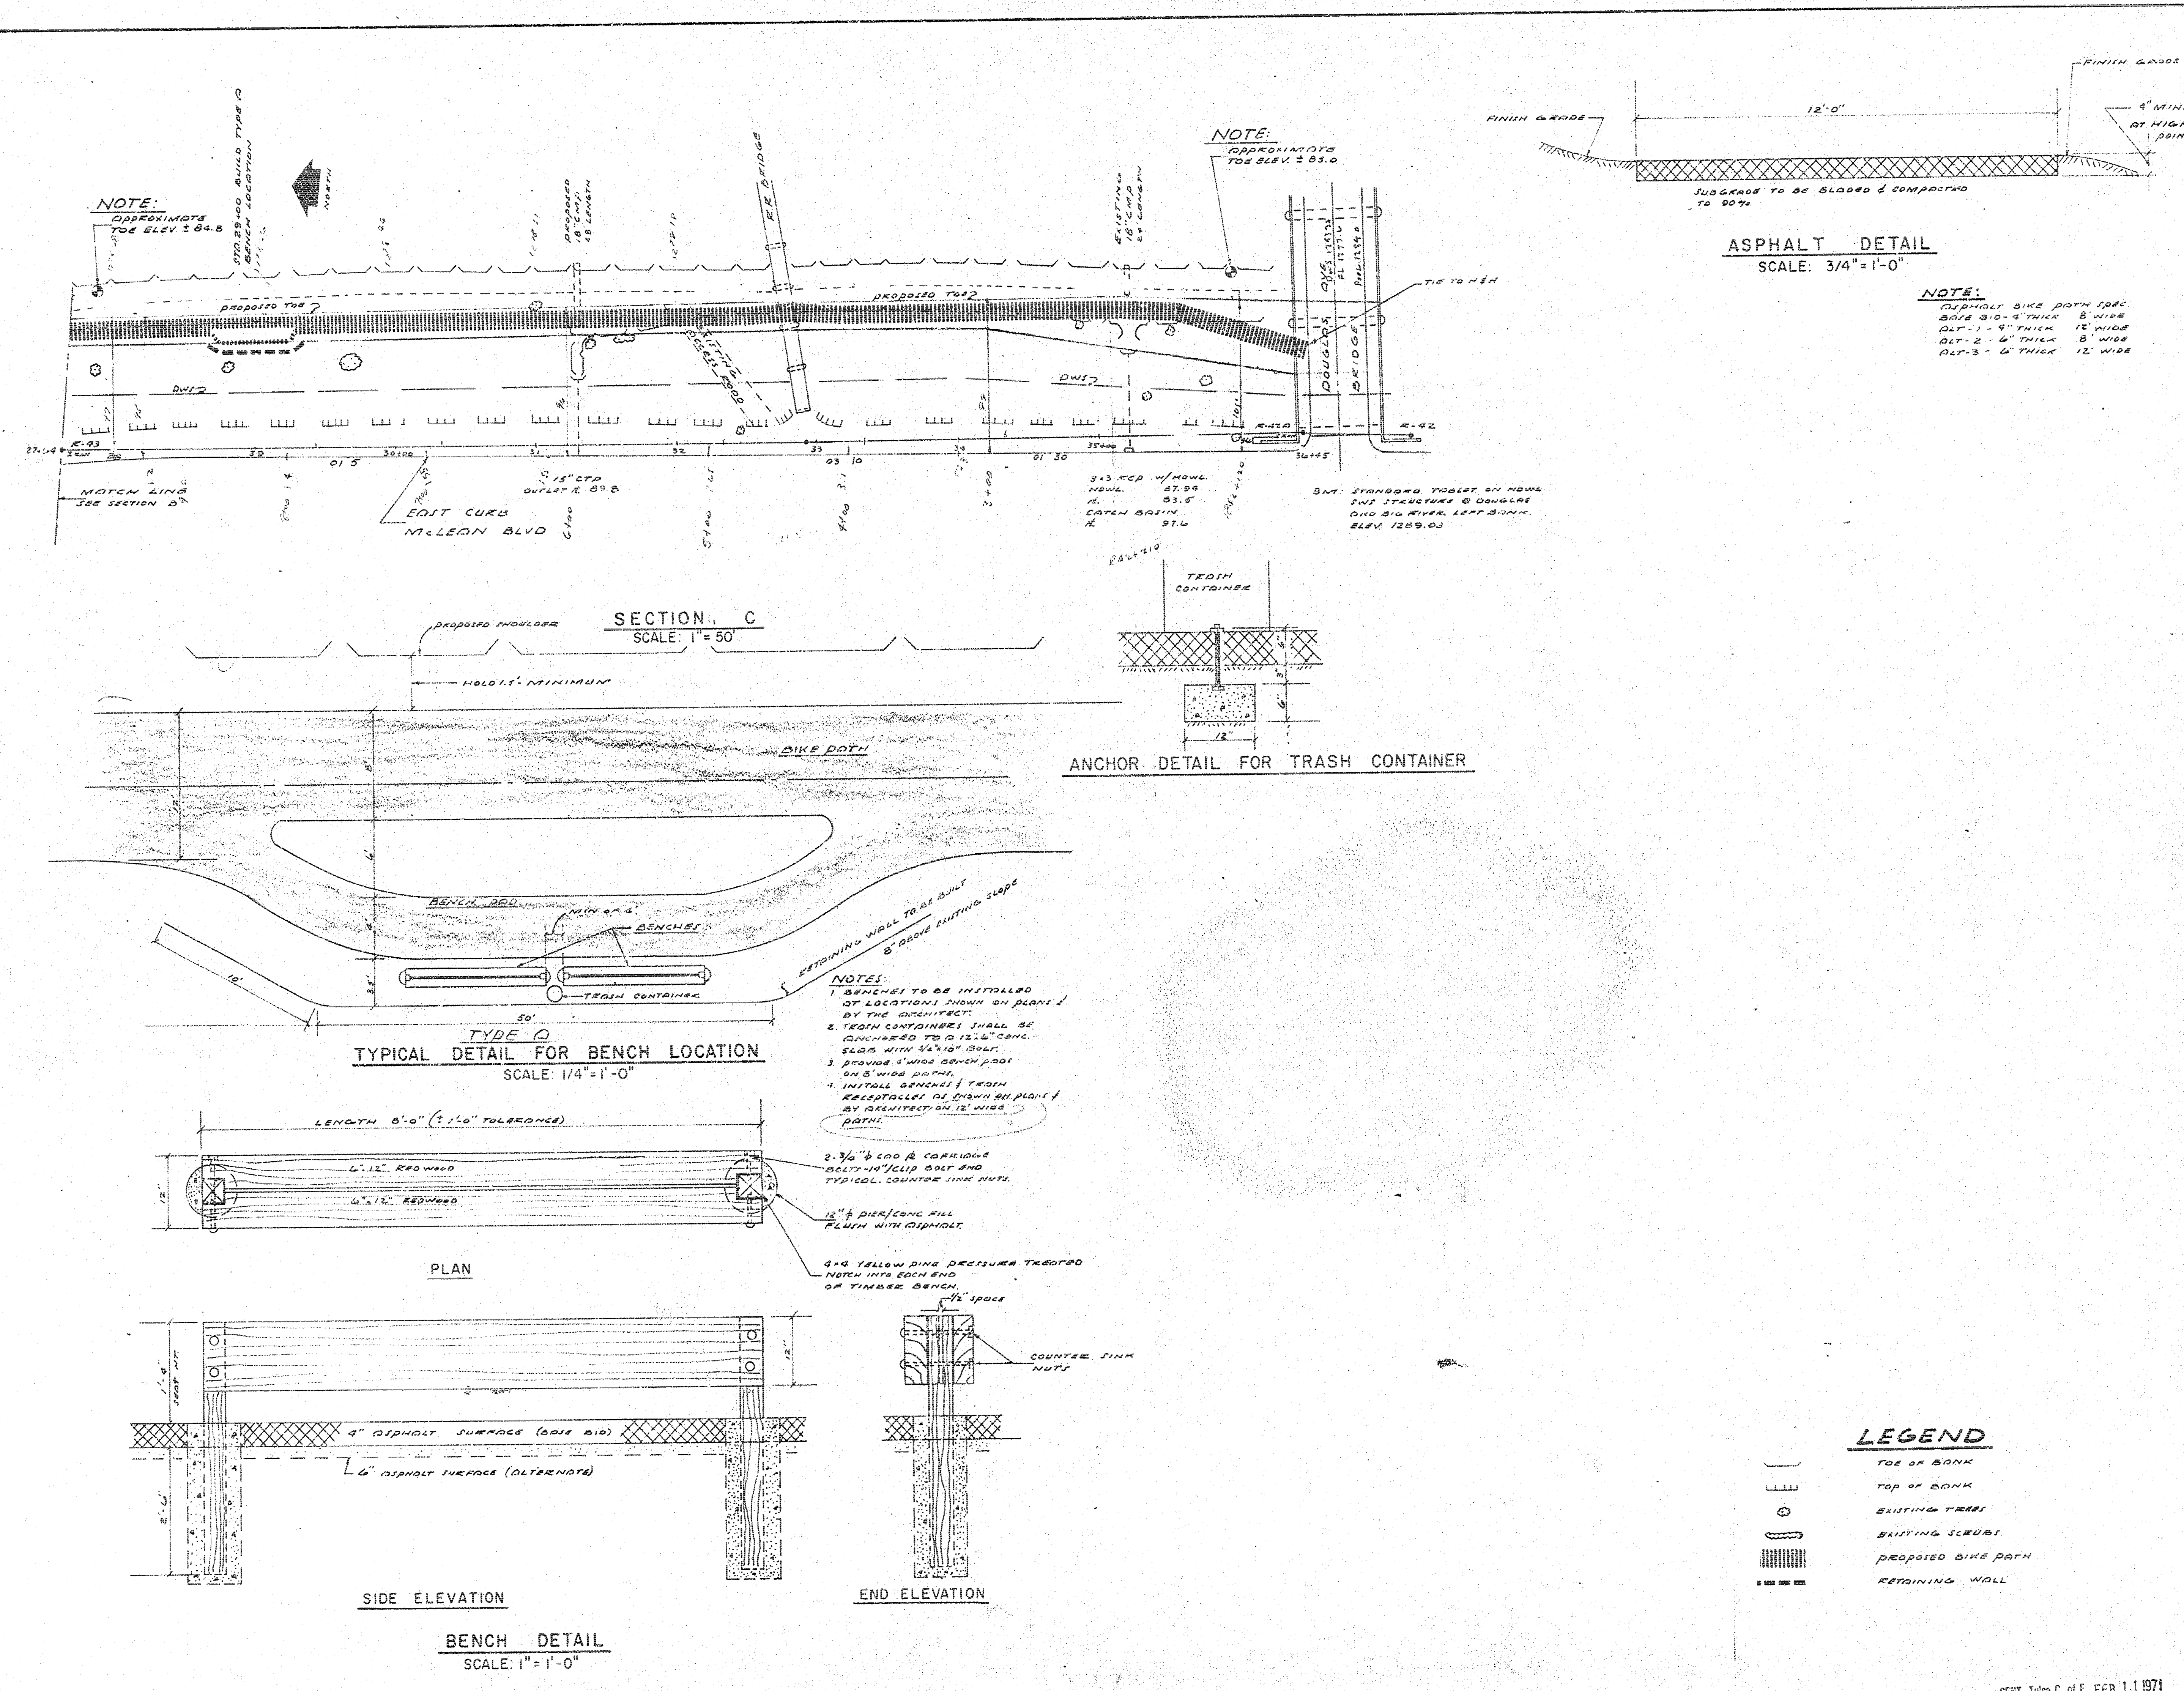

JOHN GATES
Architect

oblinger-smith
Planning Consultants /
Landscape Architects
225 F. J. Ballou Bank
Building
Wichita, Kansas 67202


**PROJECT: BICYCLE PATH
URBAN RENEWAL
KANSAS A-5-2**

**SHEET TITLE: SITE PLAN
AND DETAILS**

DATE: 1-5-71

SHEETS: 3 OF 2

SENT Table C. of E. FEB 11 1971

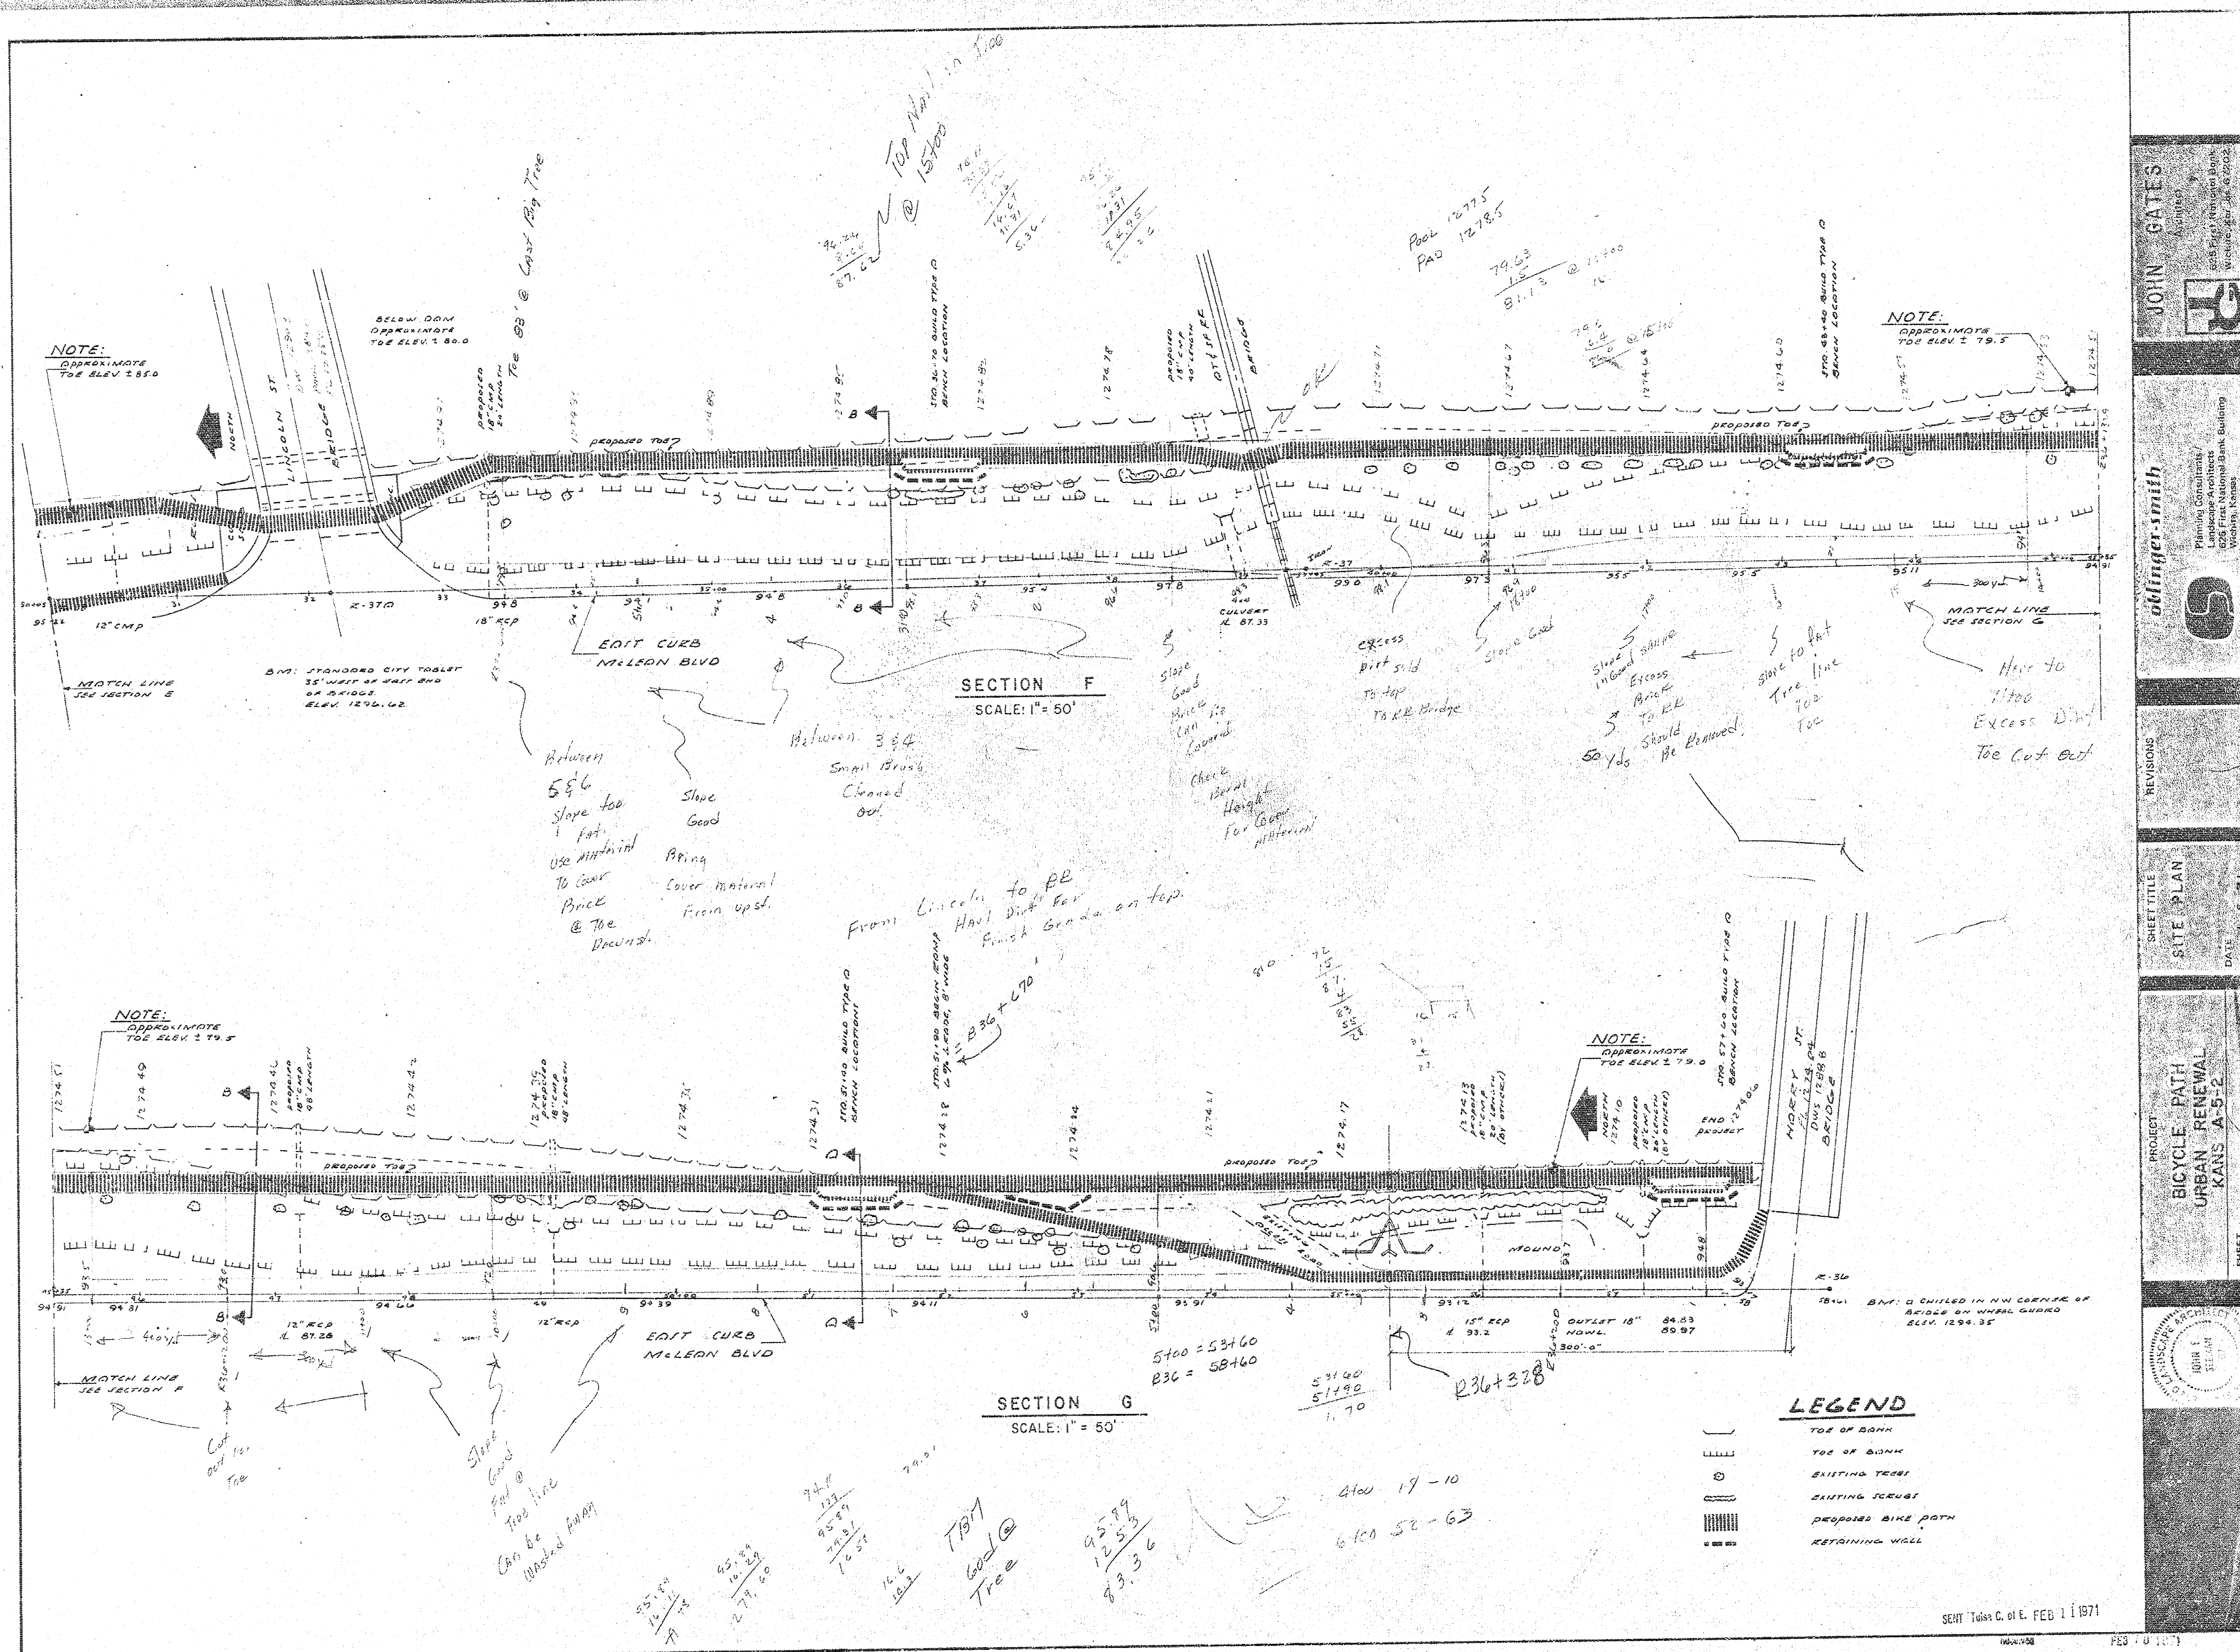

JOHN GATES
Address _____
995 First National Bank
Wichita, Kan. 67202




olinger-smith
Planning Consultants
Landscape Architects
625 First National Bldg.
Wichita, Kansas

REVISIONS


SHEET TITLE
SITE PLAN
DATE

PROJECT
BICYCLE PATH
URBAN RENEWAL
KANSAS A-5-2

SENY Tulsa C. of E. FEB 11 1971

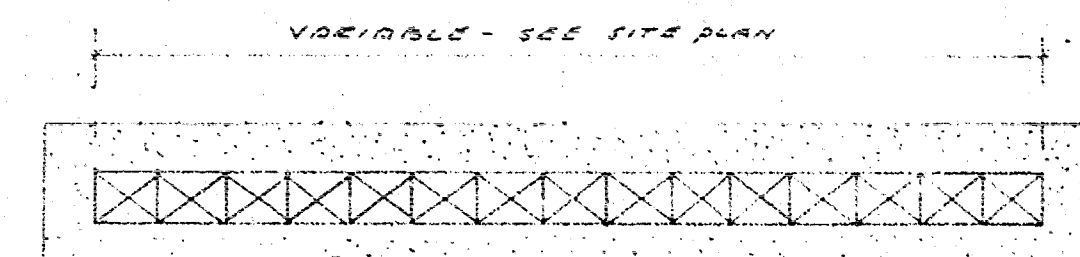


PLAN

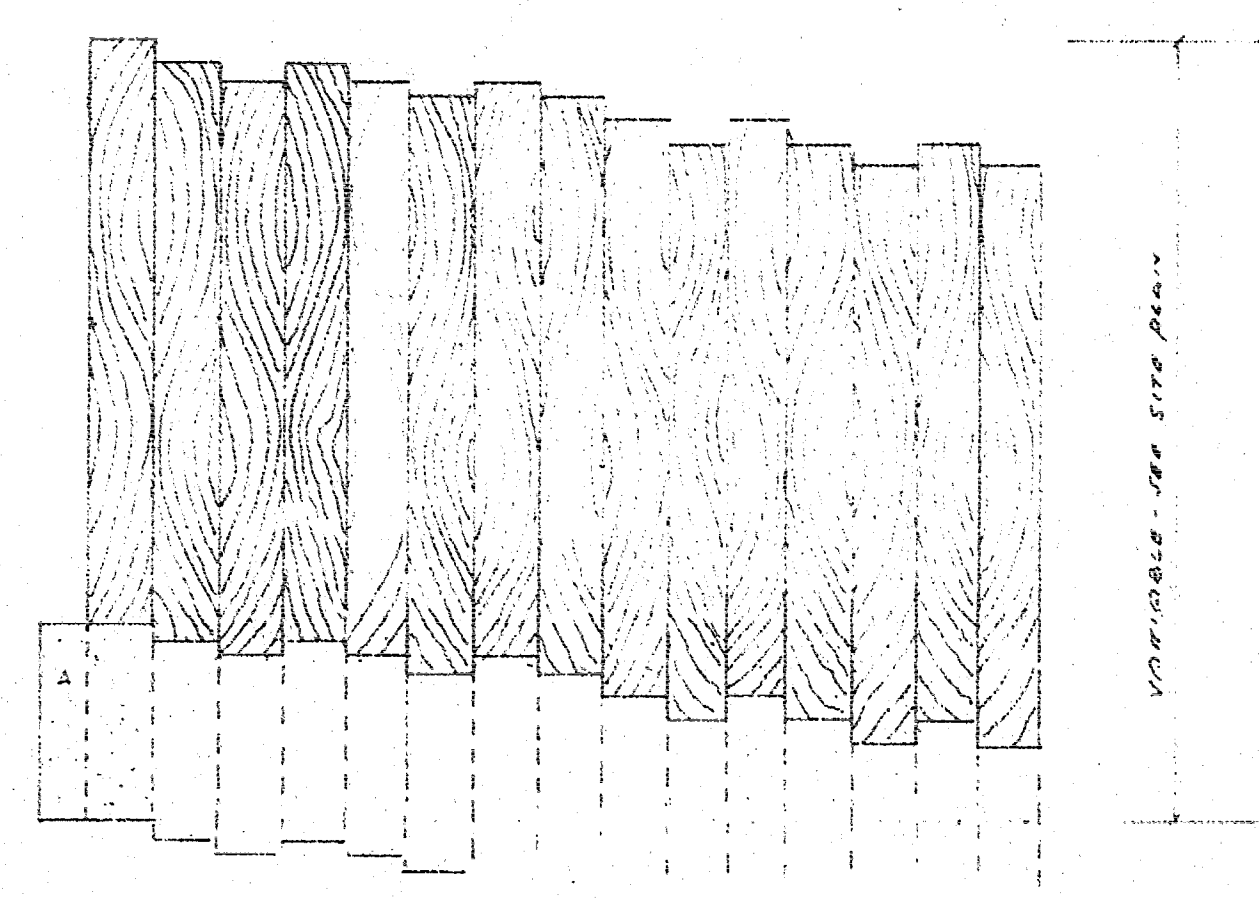


SIDE ELEVATION

RETAINING WALL DETAIL @ BIKE PATH
SCALE: 1/2" = 1'-0"


- GENERAL NOTES**
1. CONTOURS ARE INTERPOLATED FROM EXISTING DATA.
 2. CONTRACTOR SHALL VERIFY SPARK LOCATION PRIOR TO IMPLEMENTING CONSTRUCTION.
 3. CONTRACTOR SHALL CONFIRM EXISTING PLUM W/DEVELOPER FOR CONSERVATION OF EXISTING TREES.
- SYMBOL SCHEDULE**
- - - - - EXISTING CONTOUR
 - — — — — EXISTING CONTOUR
 - — — — — FINISHED ELEV.
 - - - - - WATER SERVICE
 - - - - - SLOPE INDICATOR
 - — — — — ASPHALT SURFACE

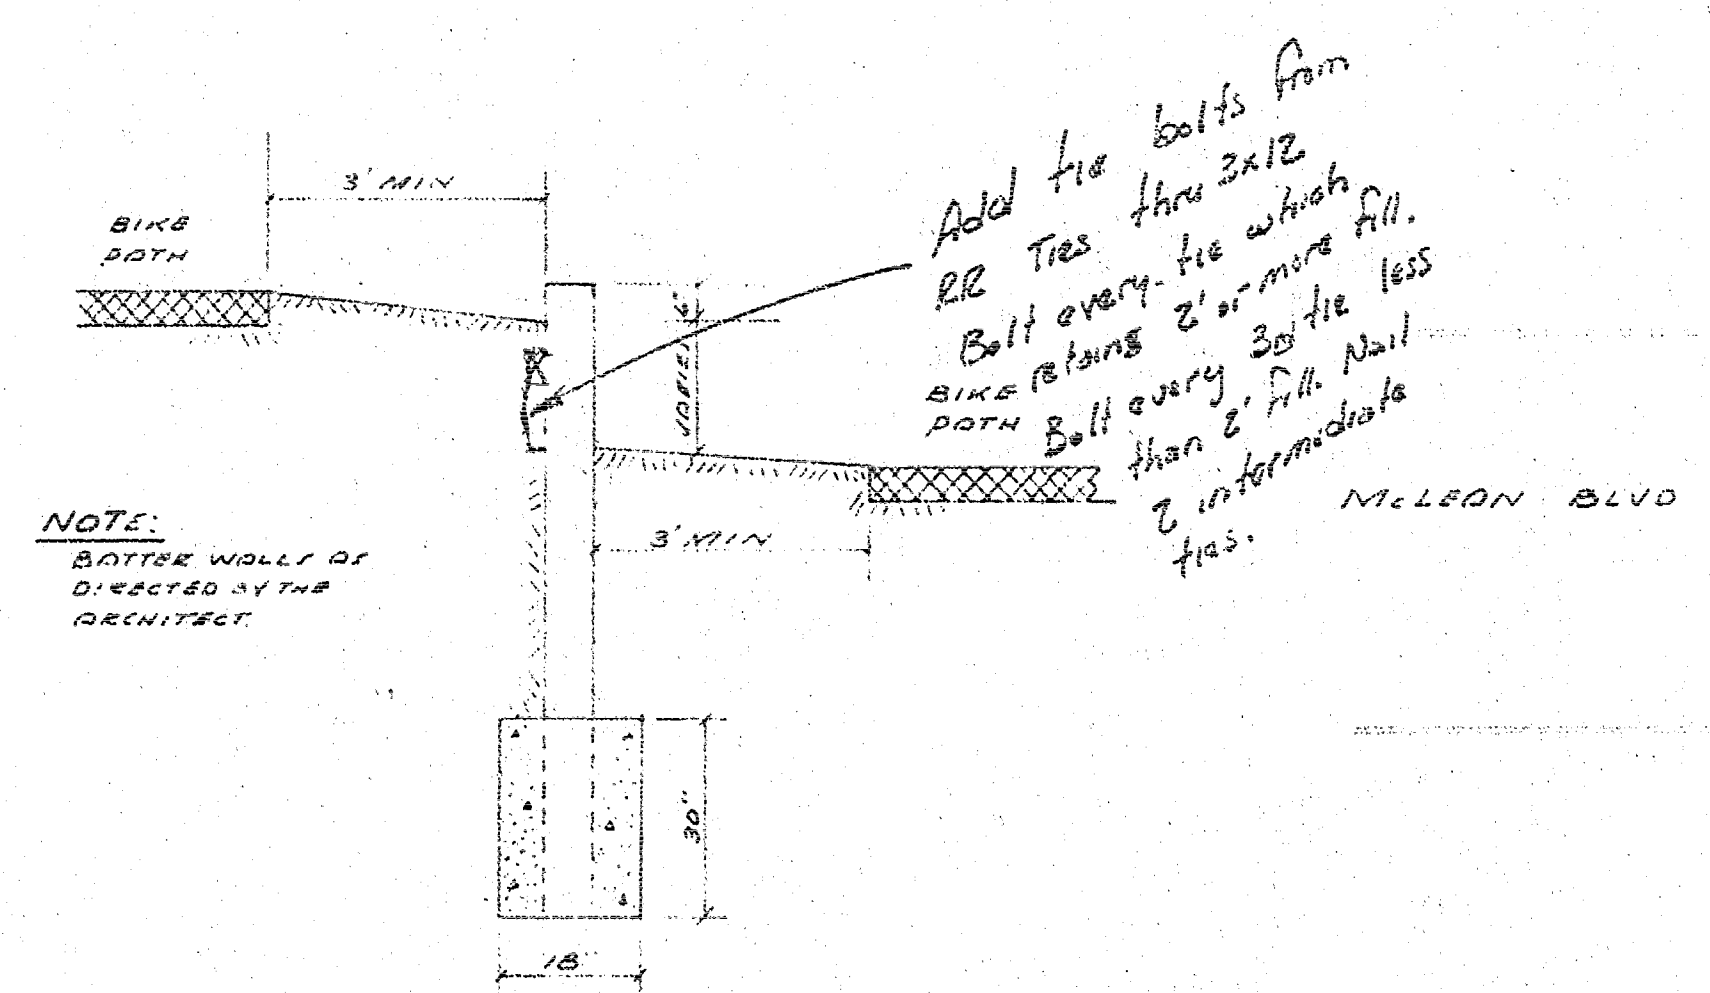

TYP. SECTION RETAINING WALL DETAIL
SCALE: 1/2" = 1'-0"

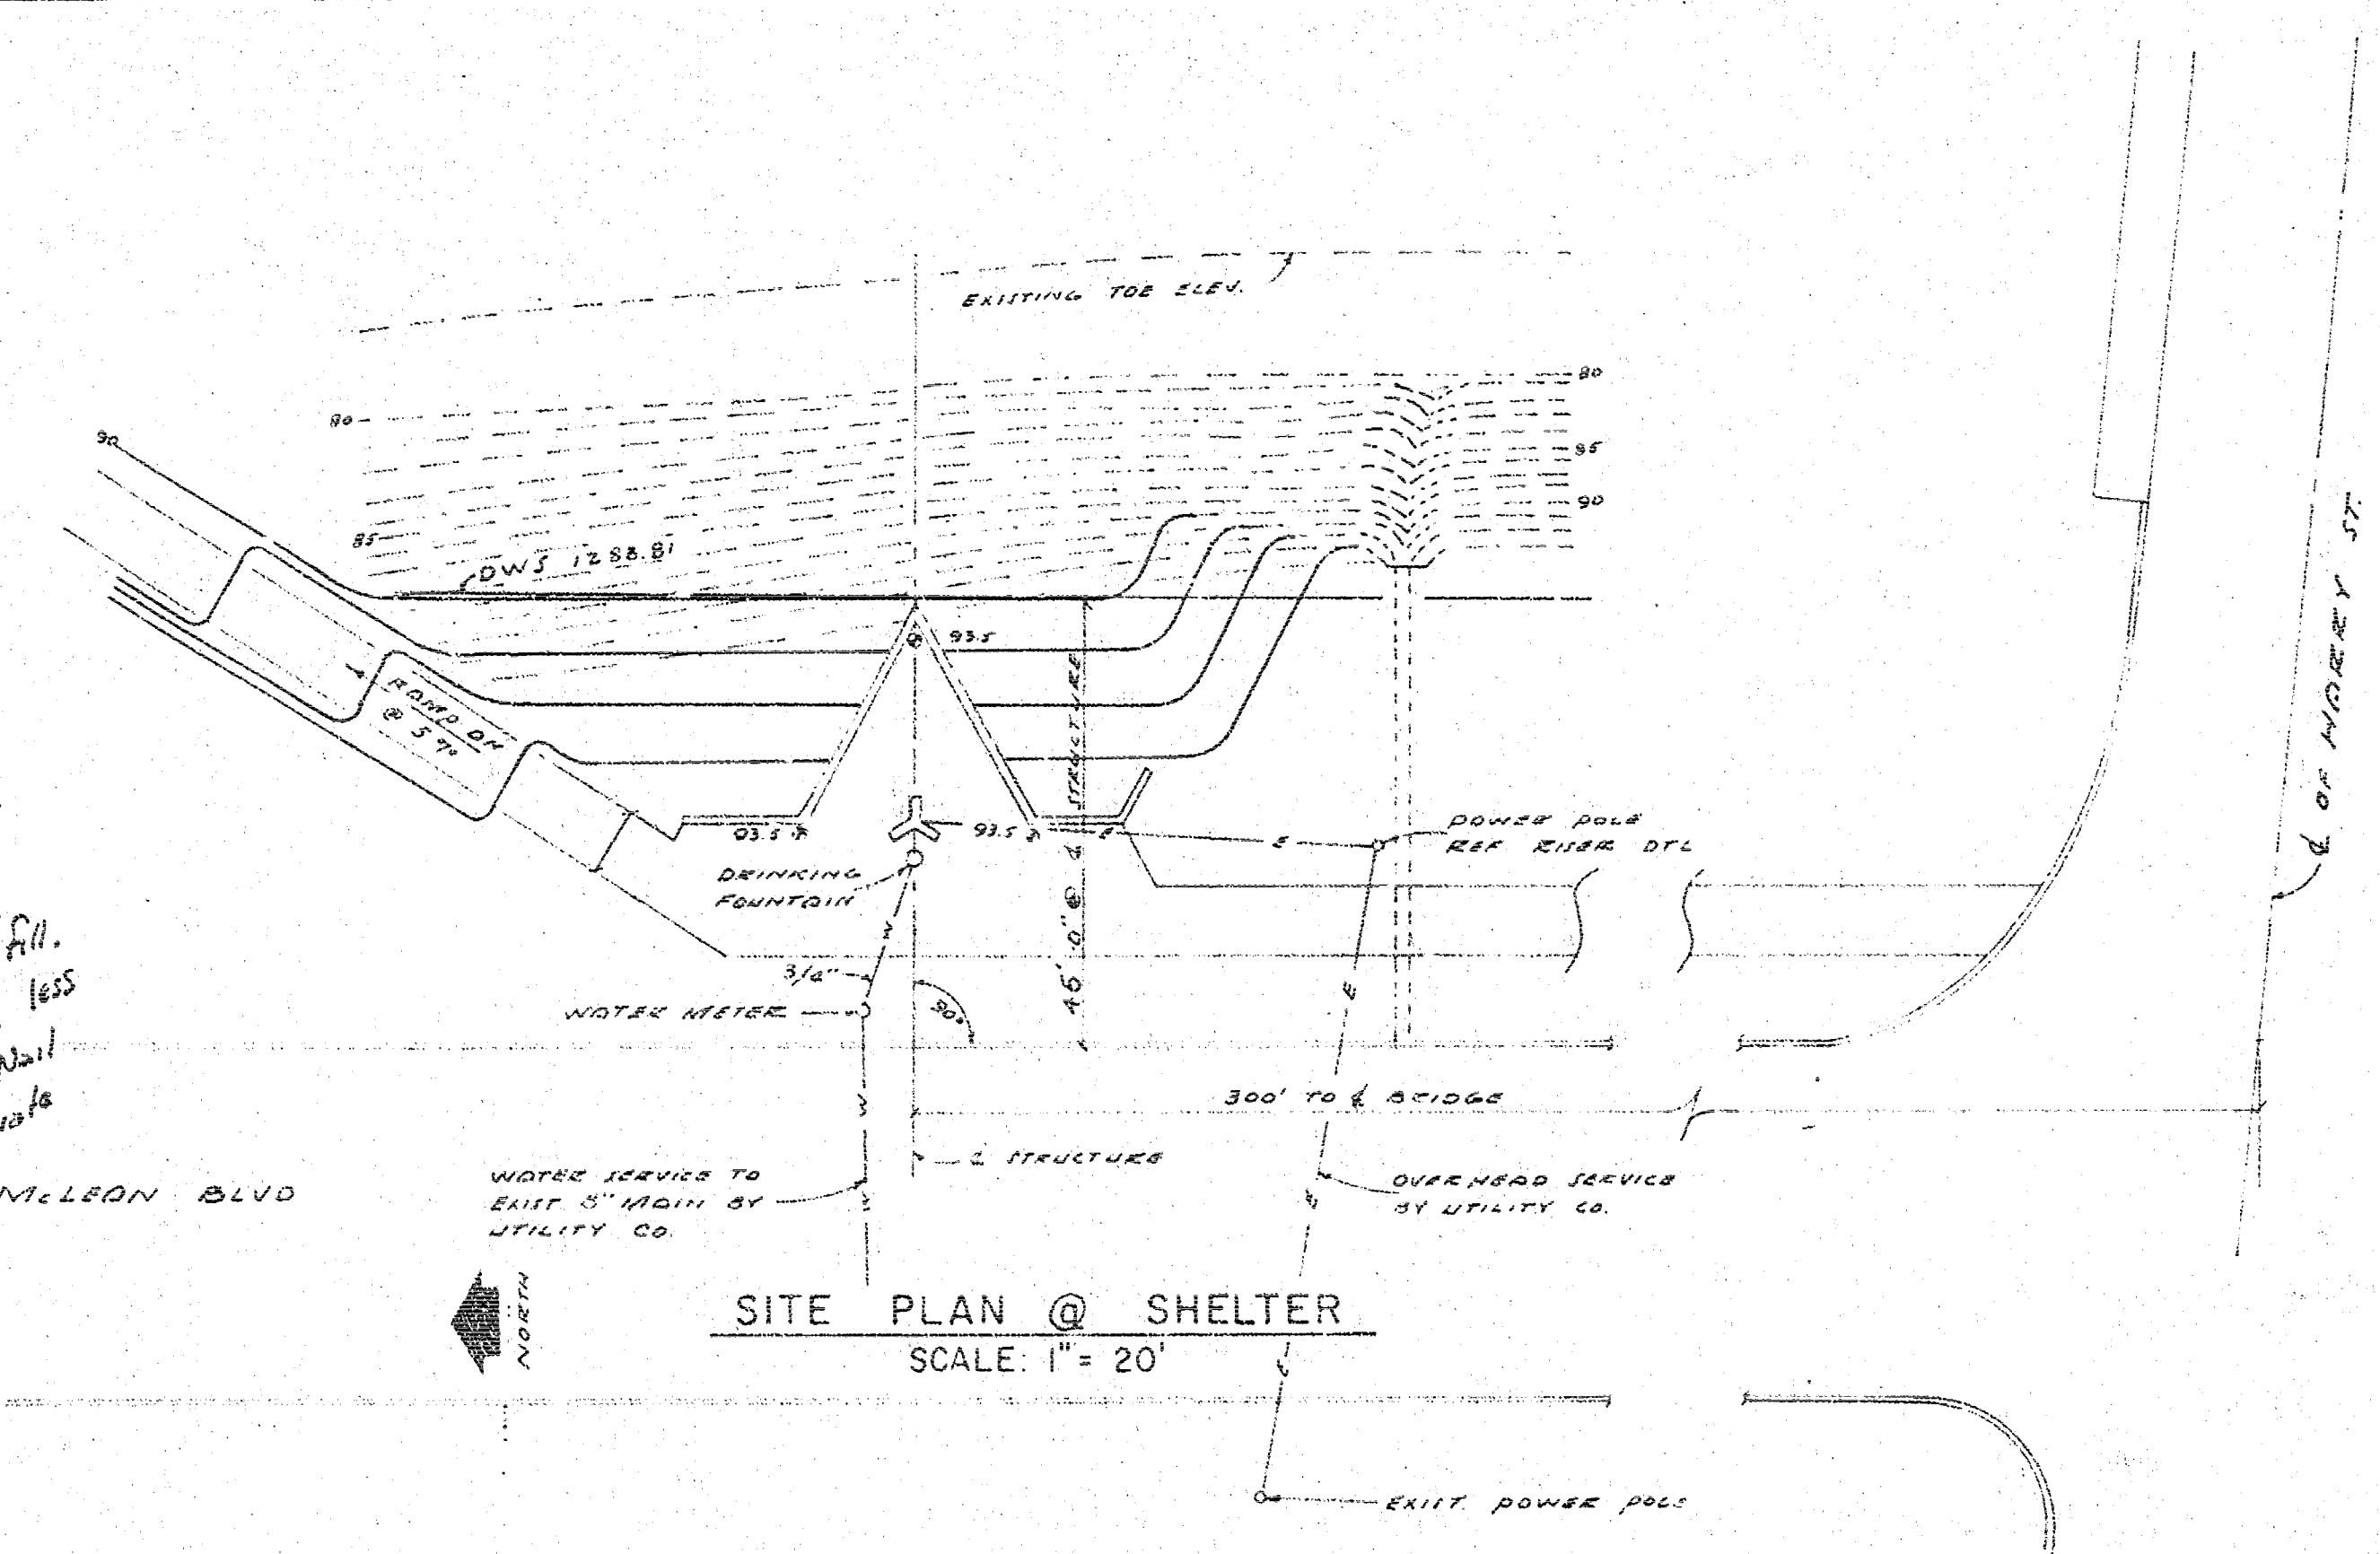

SITE PLAN @ SHELTER
SCALE: 1" = 20'

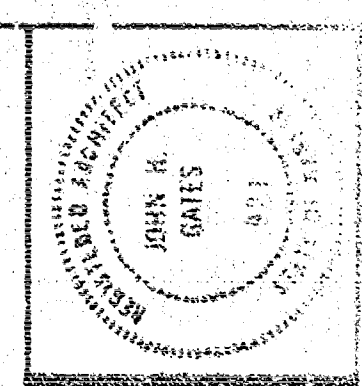

JOHN R. GATES
825 First National Bank
Wichita, Kansas 67202

odlinger-smith
Planning Consultants
625 First National Bank Building
Wichita, Kansas

REVISIONS

SHEET TITLE
SITE PLAN
AND DETAILS
DATE
1-5-71

PROJECT
BICYCLE PATH
URBAN RENEWAL
KANSAS
A-5-2
SHEET NUMBER 6 OF 8 SHEETS