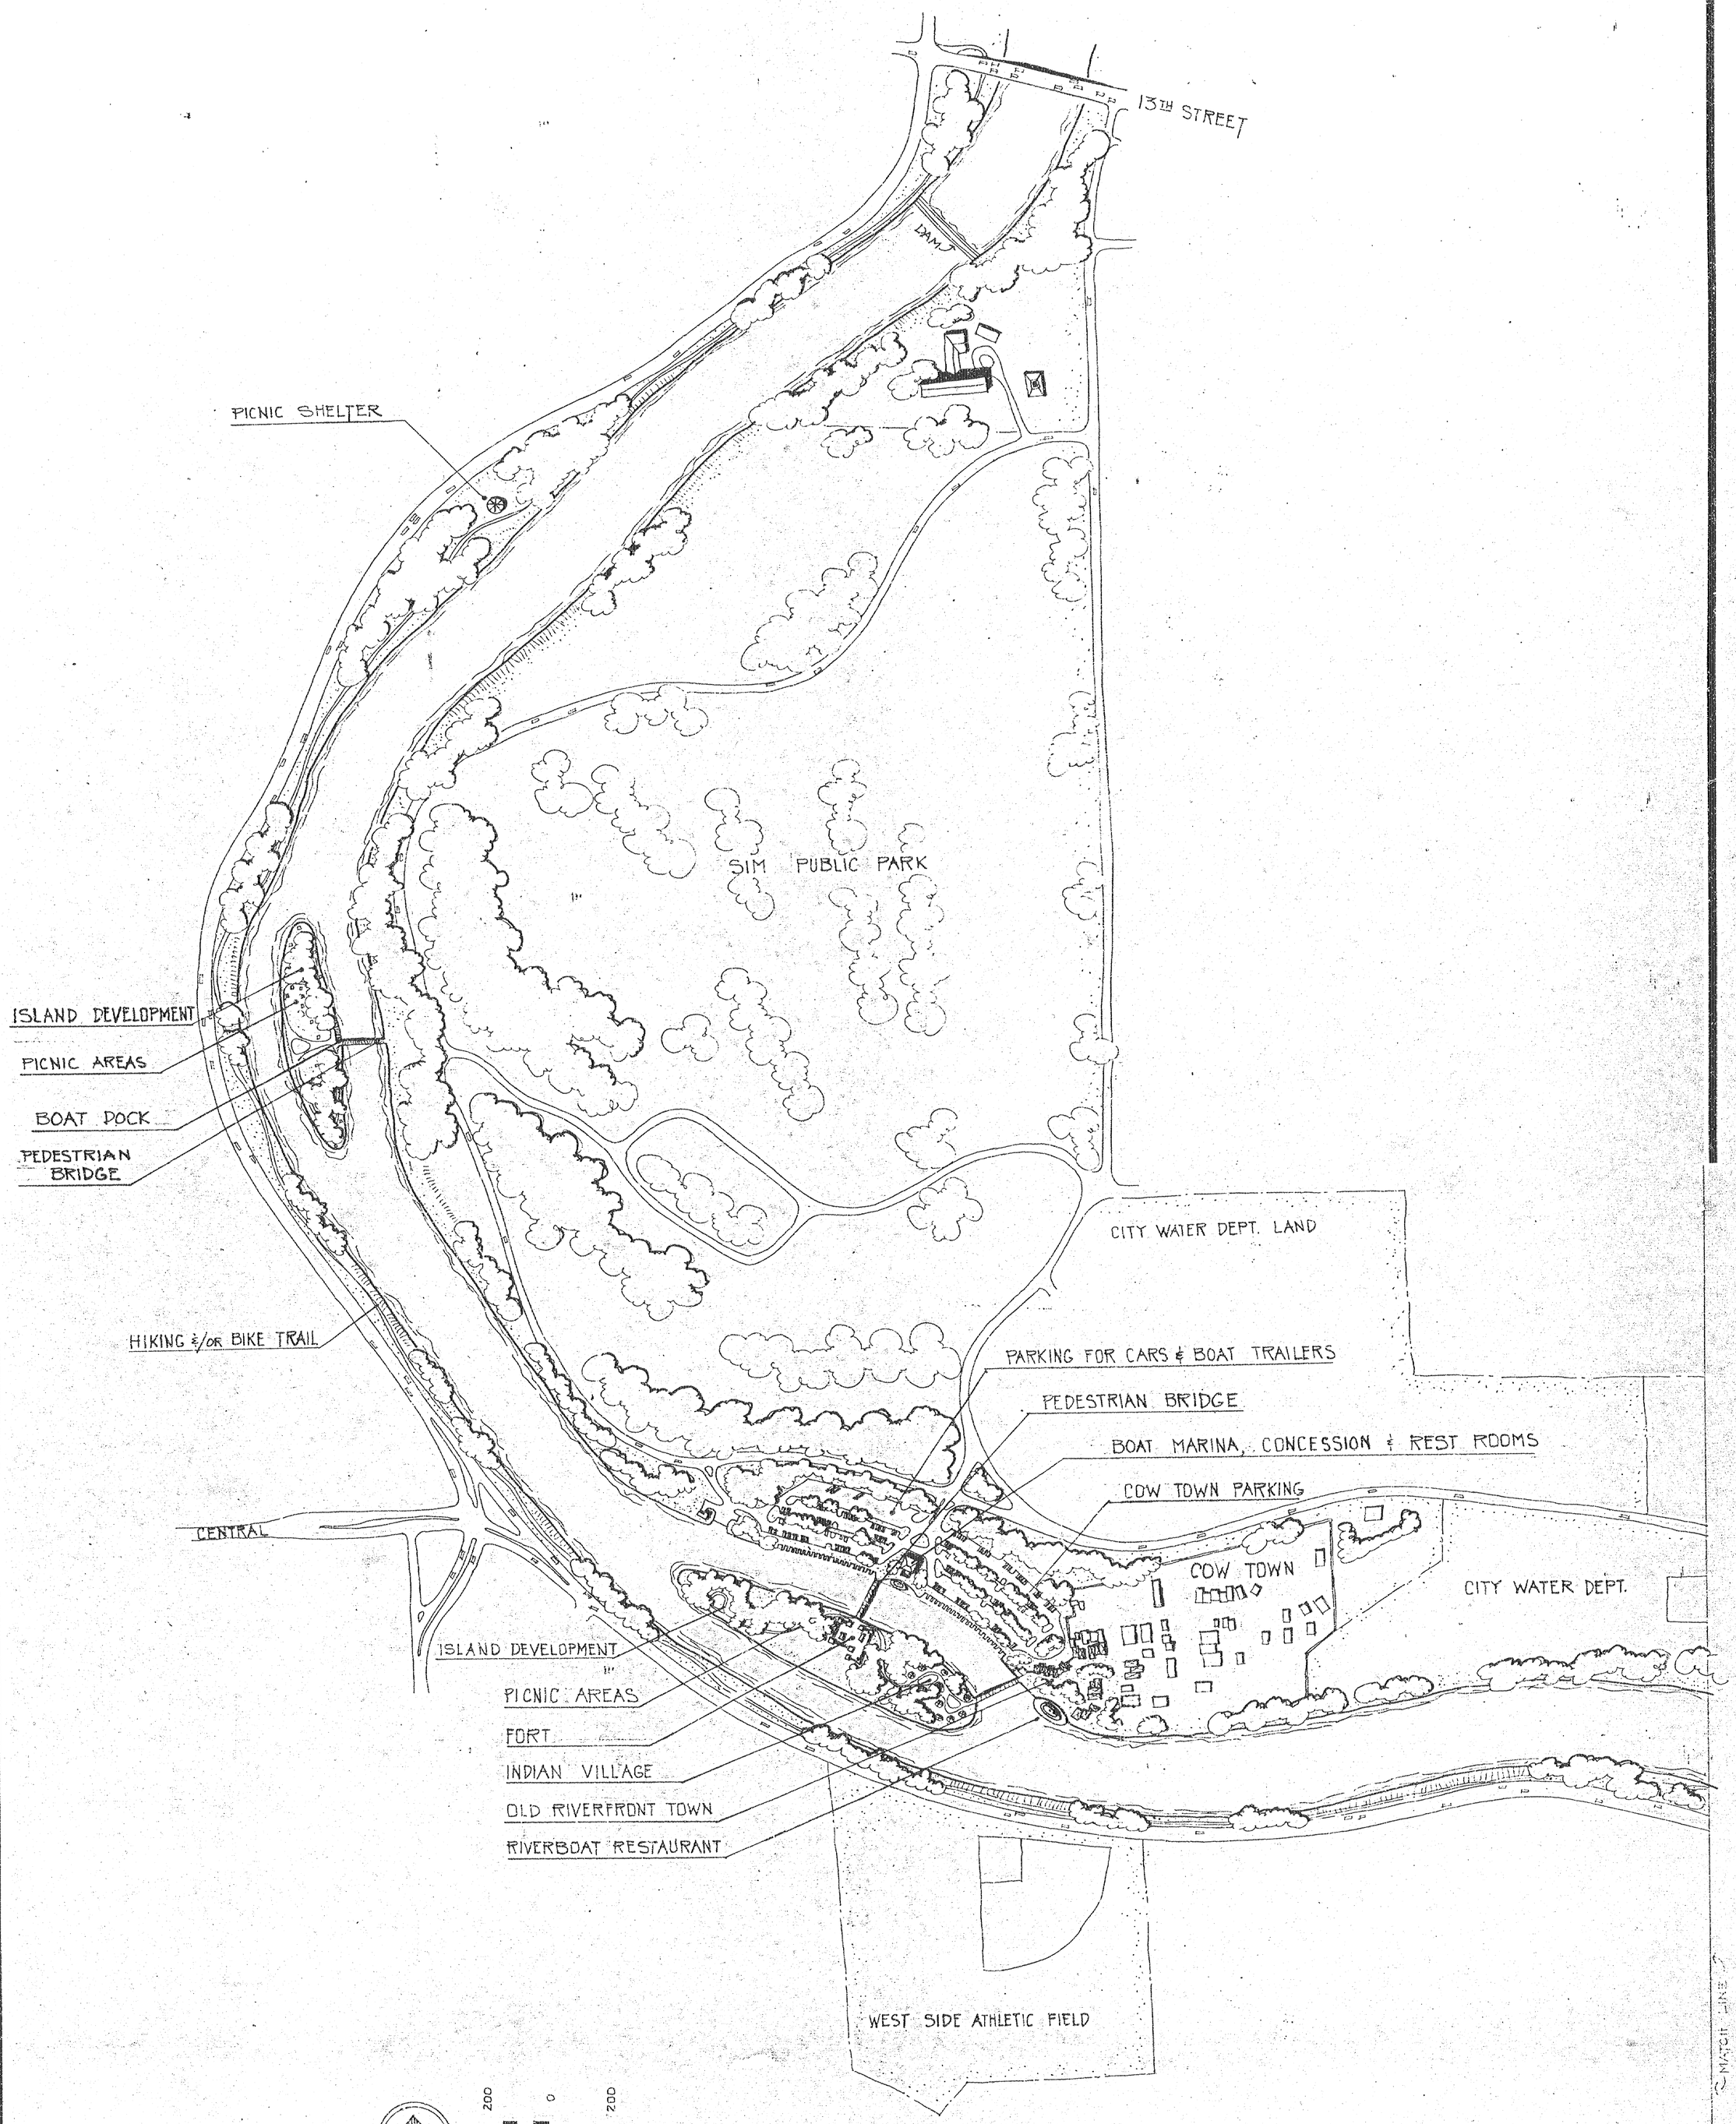
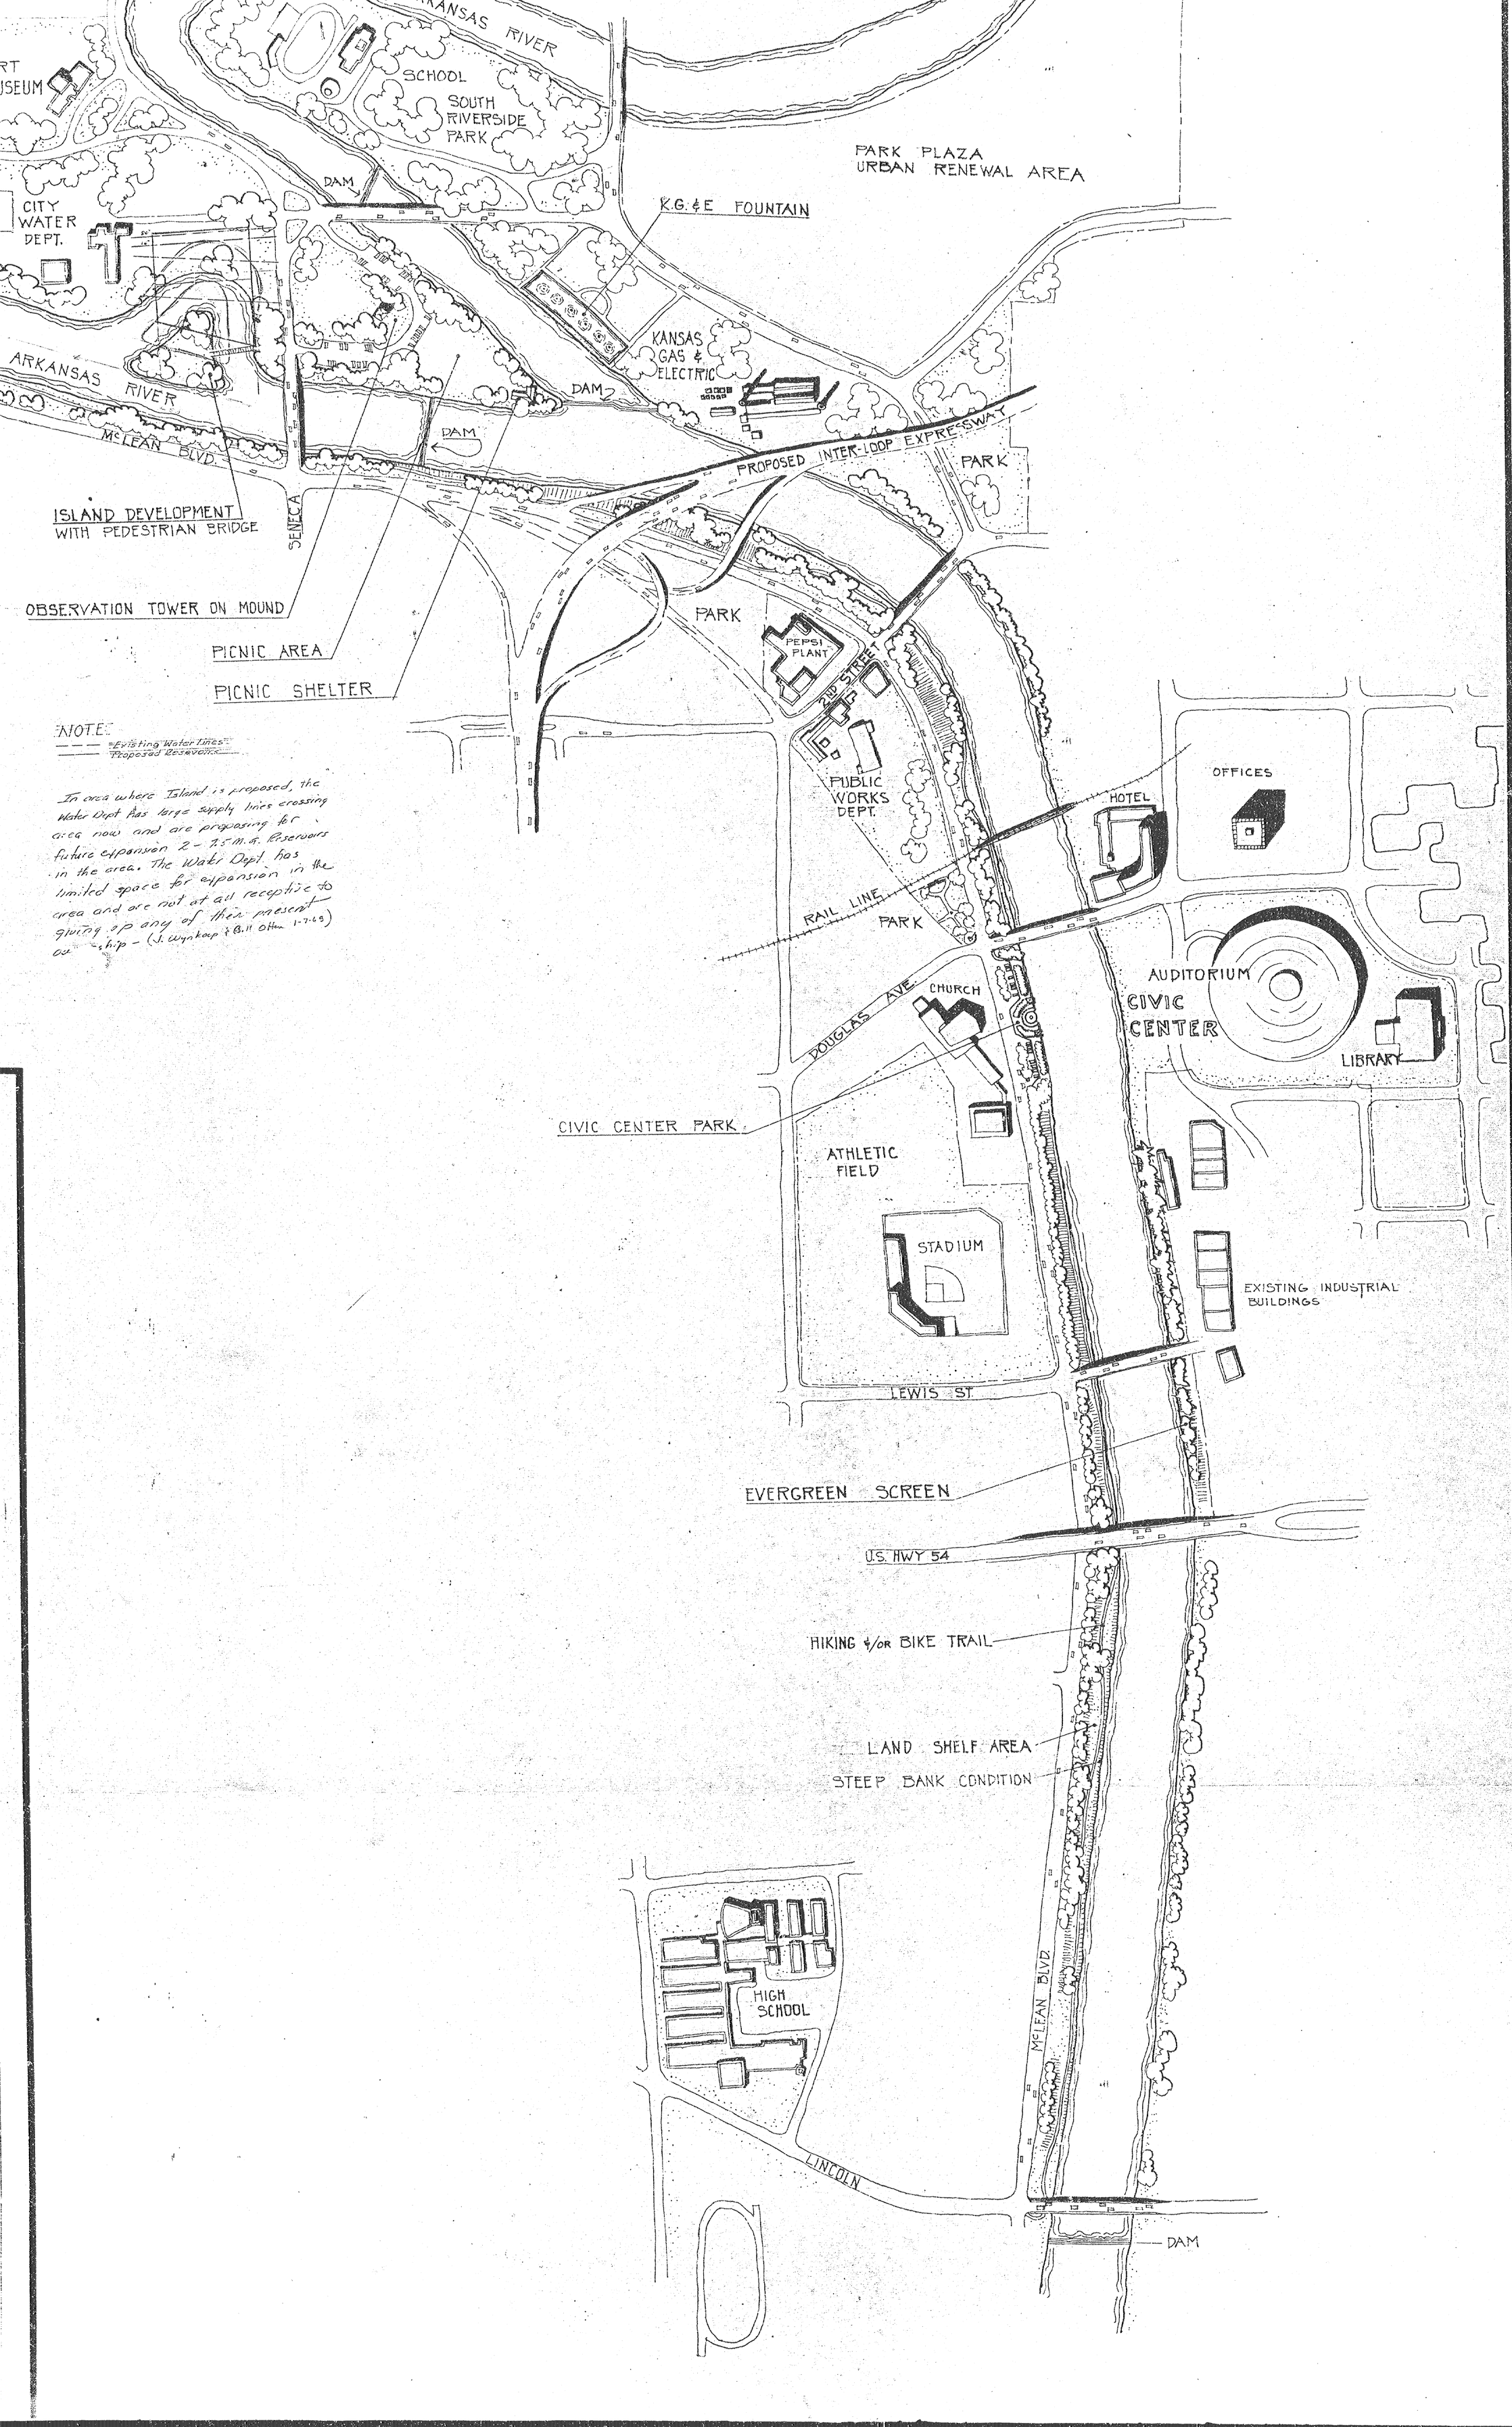


MASTER PLAN

FOR THE IMPROVEMENT OF A PORTION OF THE BANK OF THE ARKANSAS RIVER · WICHITA, KANSAS

PREPARED FOR THE BOARD OF PARK COMMISSIONERS · WICHITA, KANSAS

HARE & HARE · LANDSCAPE ARCHITECTS · KANSAS CITY, MISSOURI


ARKANSAS RIVER
SCHOOL
SOUTH RIVERSIDE PARK
DAM
PARK PLAZA URBAN RENEWAL AREA
K.G.&E FOUNTAIN
CITY WATER DEPT.
KANSAS GAS & ELECTRIC
ARKANSAS RIVER
McLEAN BLVD.
DAM
DAM
PROPOSED INTER-LOOP EXPRESSWAY
PARK
ISLAND DEVELOPMENT WITH PEDESTRIAN BRIDGE
SENECA
OBSERVATION TOWER ON MOUND
PICNIC AREA
PICNIC SHELTER
NOTE:
Existing Water Lines
Proposed Reservoirs
In area where Island is proposed, the Water Dept has large supply lines crossing area now and are proposing for future expansion 2 - 7.5 M.G. Reservoirs in the area. The Water Dept. has limited space for expansion in the area and are not at all receptive to giving up any of their present ownership - (J. Wyskap & B.H. Otten 1-7-69)
PARK
PEPSI PLANT
2ND STREET
PUBLIC WORKS DEPT.
RAIL LINE
PARK
HOTEL
OFFICES
AUDITORIUM
CIVIC CENTER
LIBRARY
CHURCH
DOUGLAS AVE.
CIVIC CENTER PARK
ATHLETIC FIELD
STADIUM
EXISTING INDUSTRIAL BUILDINGS
LEWIS ST.
EVERGREEN SCREEN
U.S. HWY 54
HIKING &/OR BIKE TRAIL
LAND SHELF AREA
STEEP BANK CONDITION
HIGH SCHOOL
McLEAN BLVD
LINCOLN
DAM