

BARCLAY SQUARE
MARINA
LITTLE ARKANSAS RIVER
WICHITA, KANSAS


INDEX OF SHEETS	
SHT. NO.	SHEET
1.	TITLE SHEET
2-2A.	MARINA SITE PLAN
3-4	ELEVATION
5-7	DETAILS

FOR

JACK P. DE BOER ASSOCIATES, INC.
240 NORTH ROCK ROAD
P. O. BOX 18387
WICHITA, KANSAS 67218

MCCALED ENGINEERING
116 SOUTH BROADWAY
EDMOND, OKLAHOMA


Neal A. McCaleb
NEAL A. MCCALED

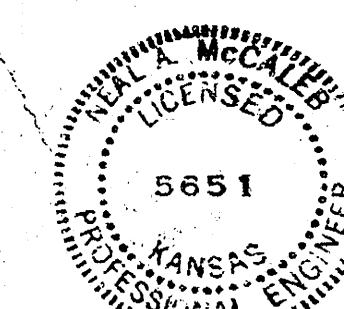

2-10-72
Neal A. McCaleb

REVISION 6-2-73
REVISION 7-6-73

4-15-74 - *See memo of 3/15/74 from Mitchell to Roush*
4-15-74 - *See memo of 4/15/74 from Roush to Mitchell*

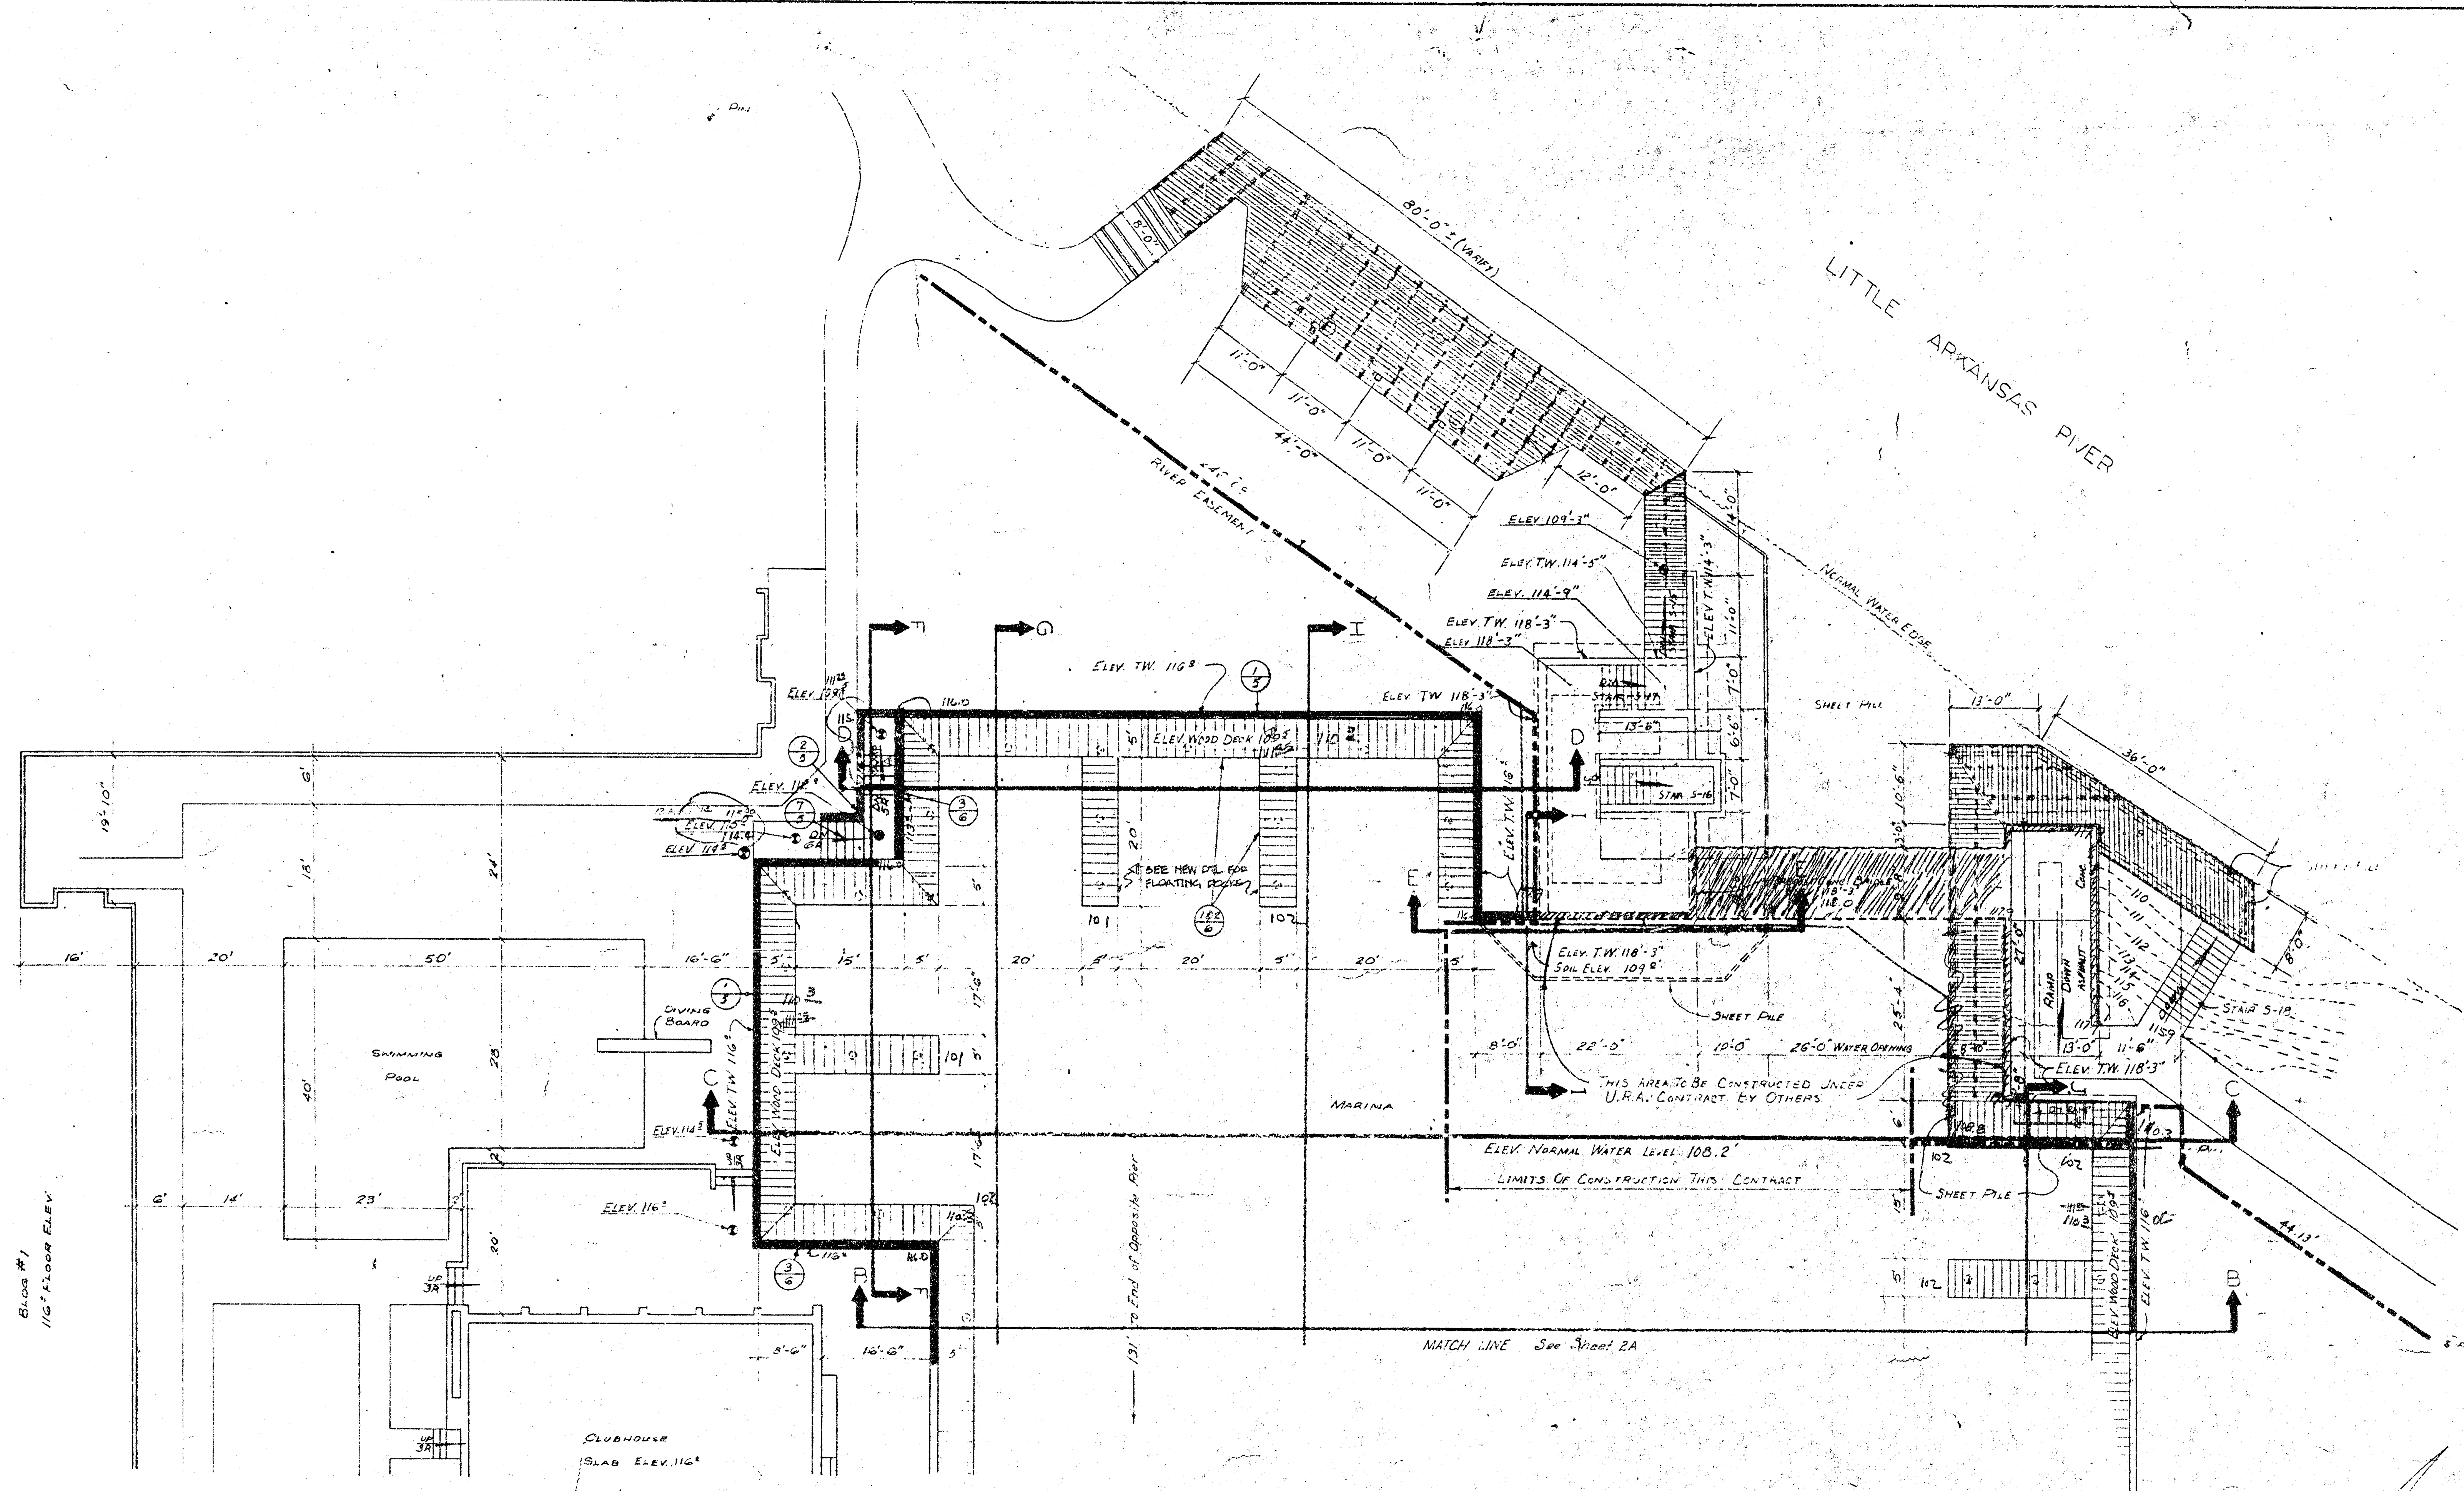


SCALE: 1" = 10'

- LEGEND:
- HANDRAIL (RED W'D) ———
 - LIMITS OF CONTRACT ———
 - CONSTRUCTION EASEMENT ———


REVISIONS: 6-21-78 1 RAISED DOCKS

2-10-78
2-11-78


MCCLEB ENGINEERING EDMOND, OKLAHOMA		Date: _____ Drawn: _____ Check: _____ Rev: _____
PARCAY SQUARE MARINA SITE PLAN <i>Pat A</i>		
2 of 8		

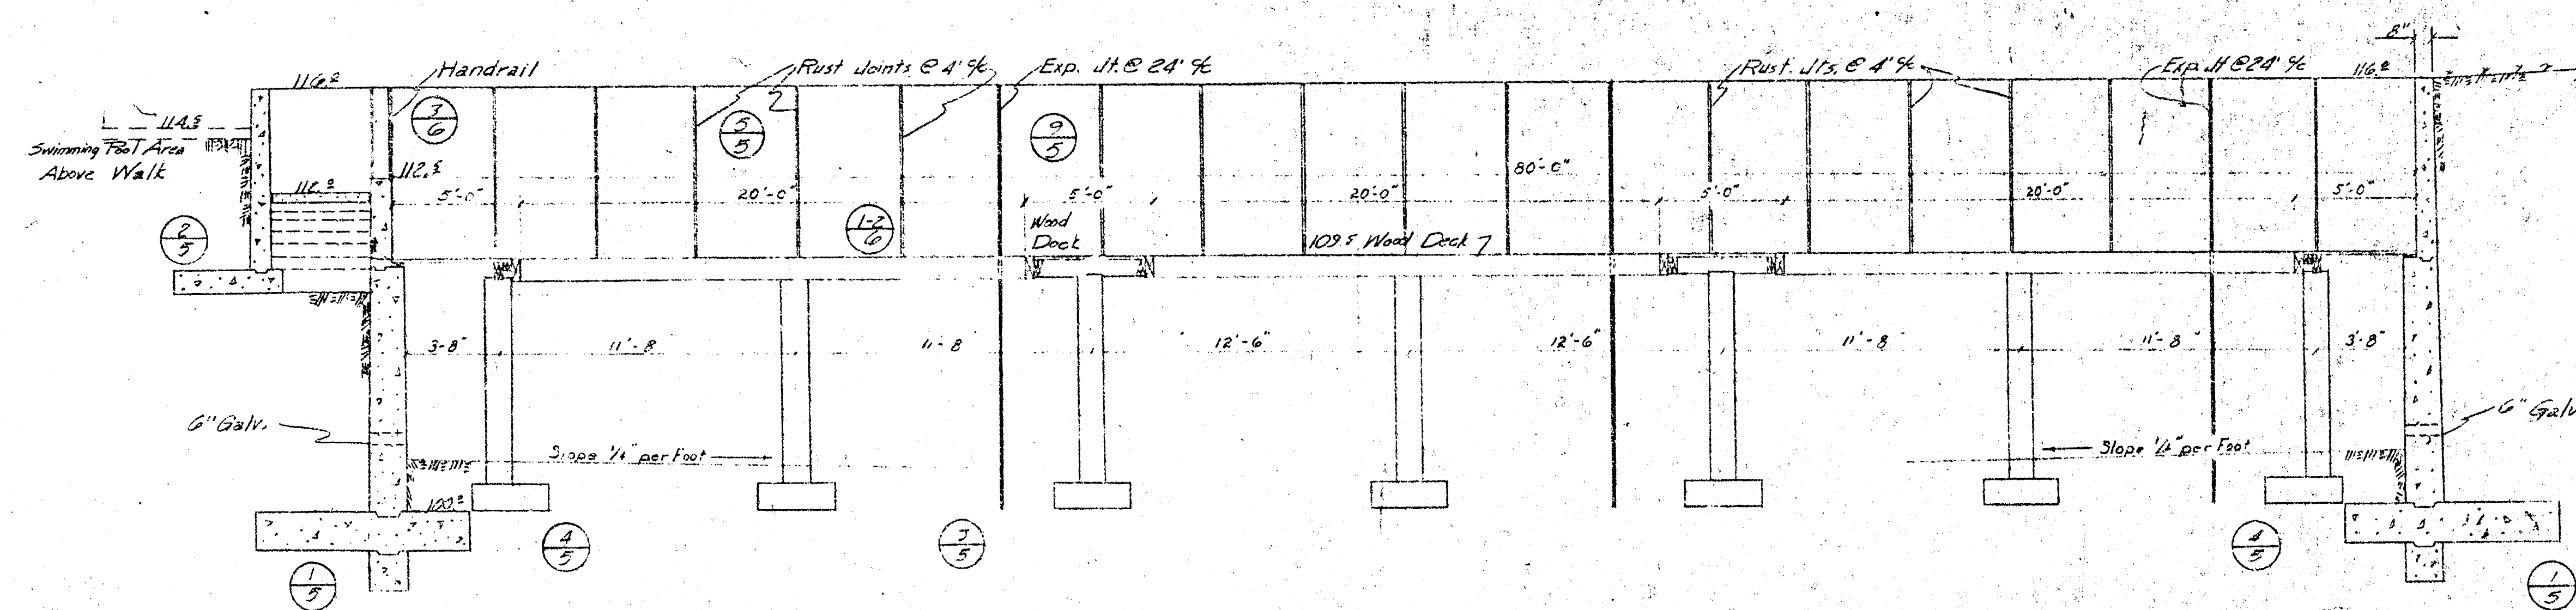


SECTION DD
Scale: 1/4" = 1'-0"

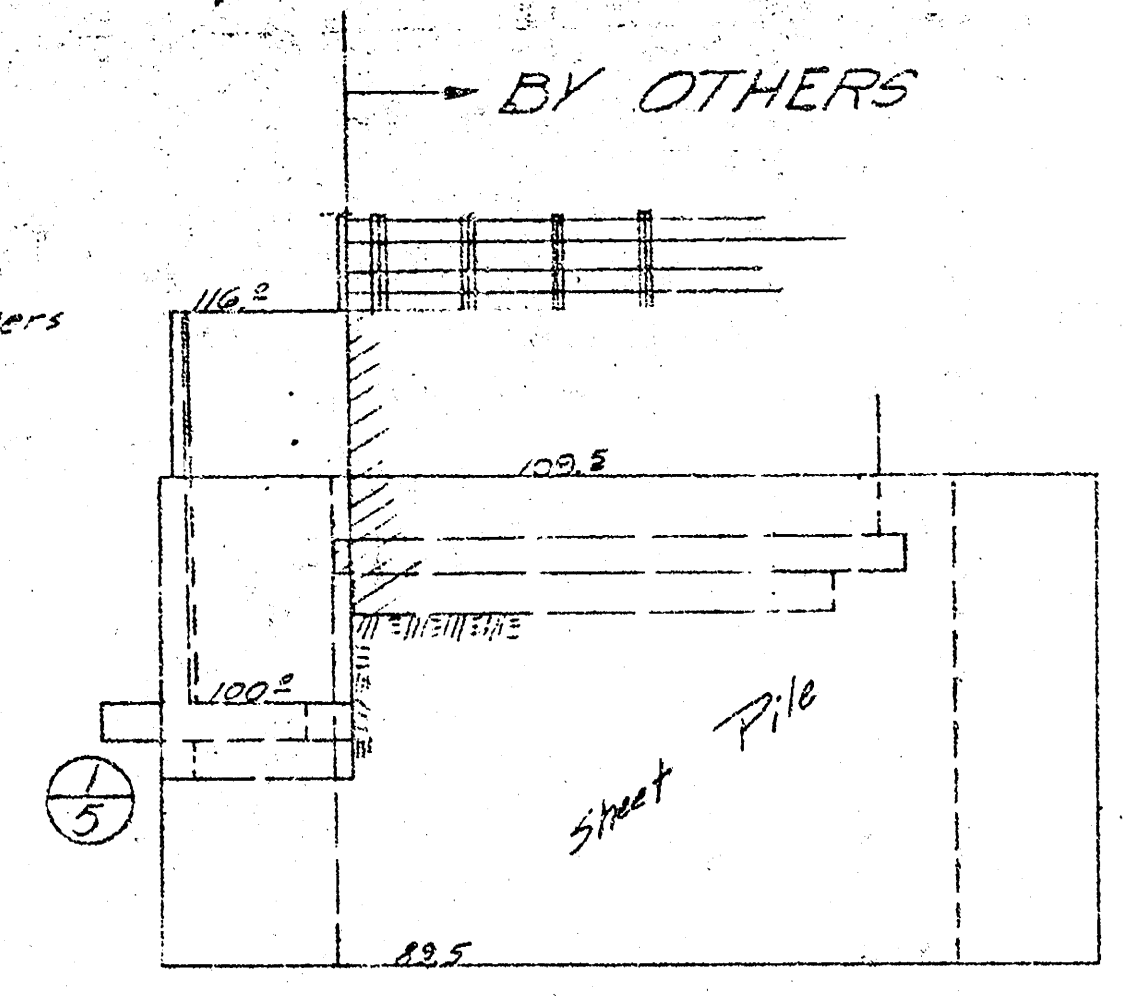


SECTION EE
Scale: 1/4" = 1'-0"

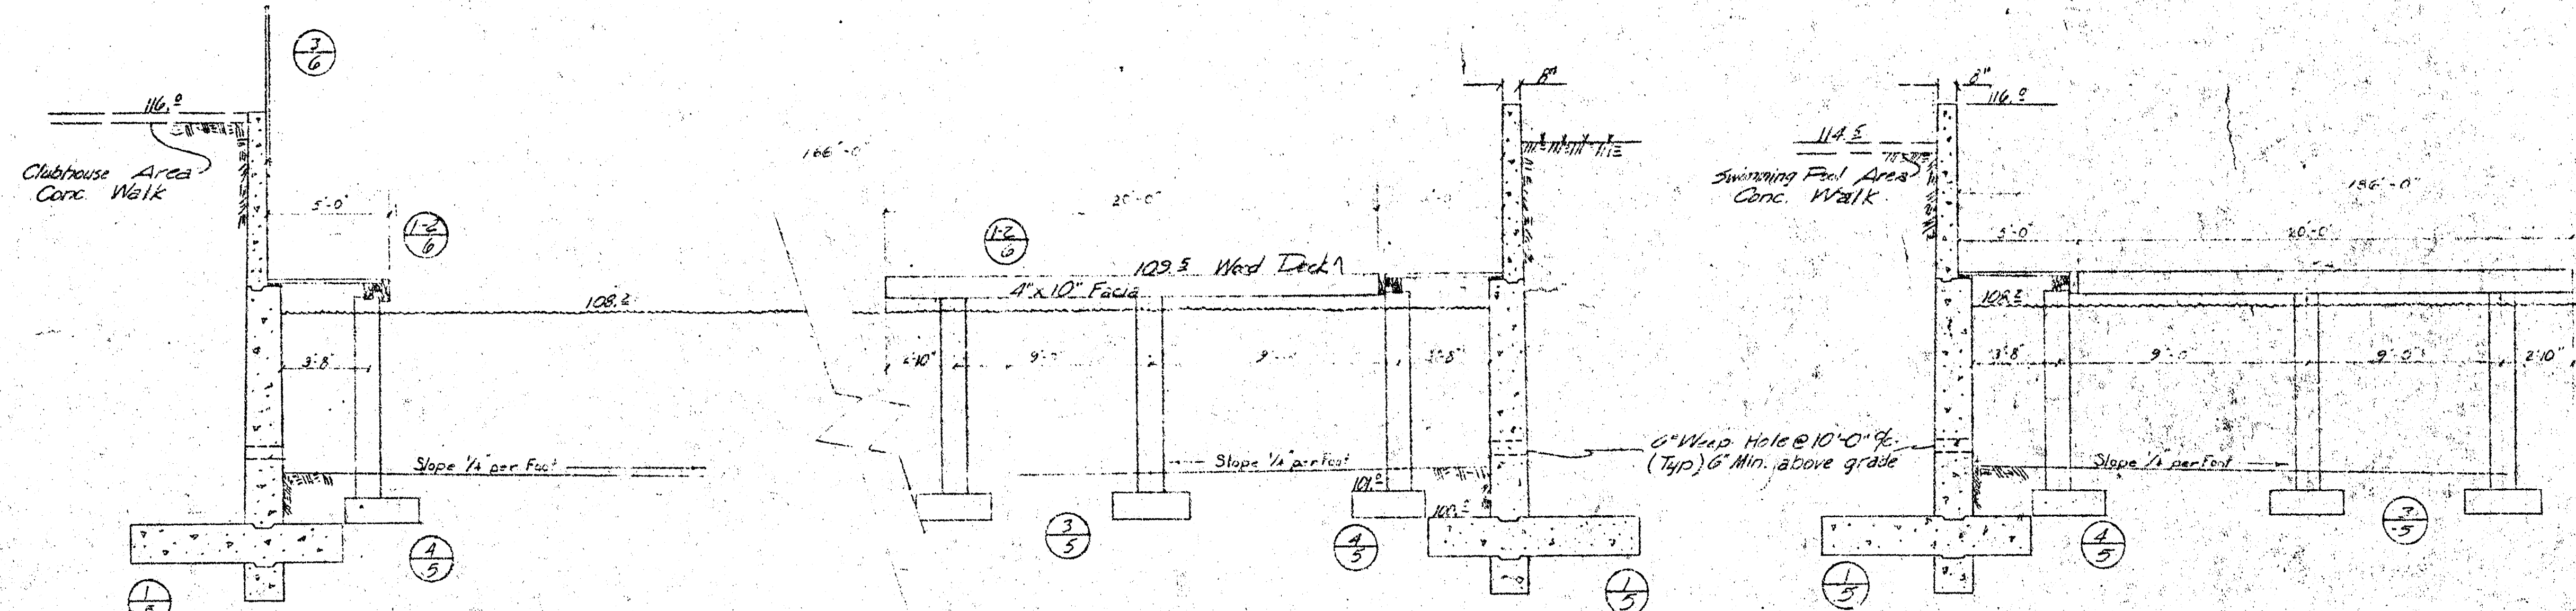


SECTION BB
Scale: 1/4" = 1'-0"

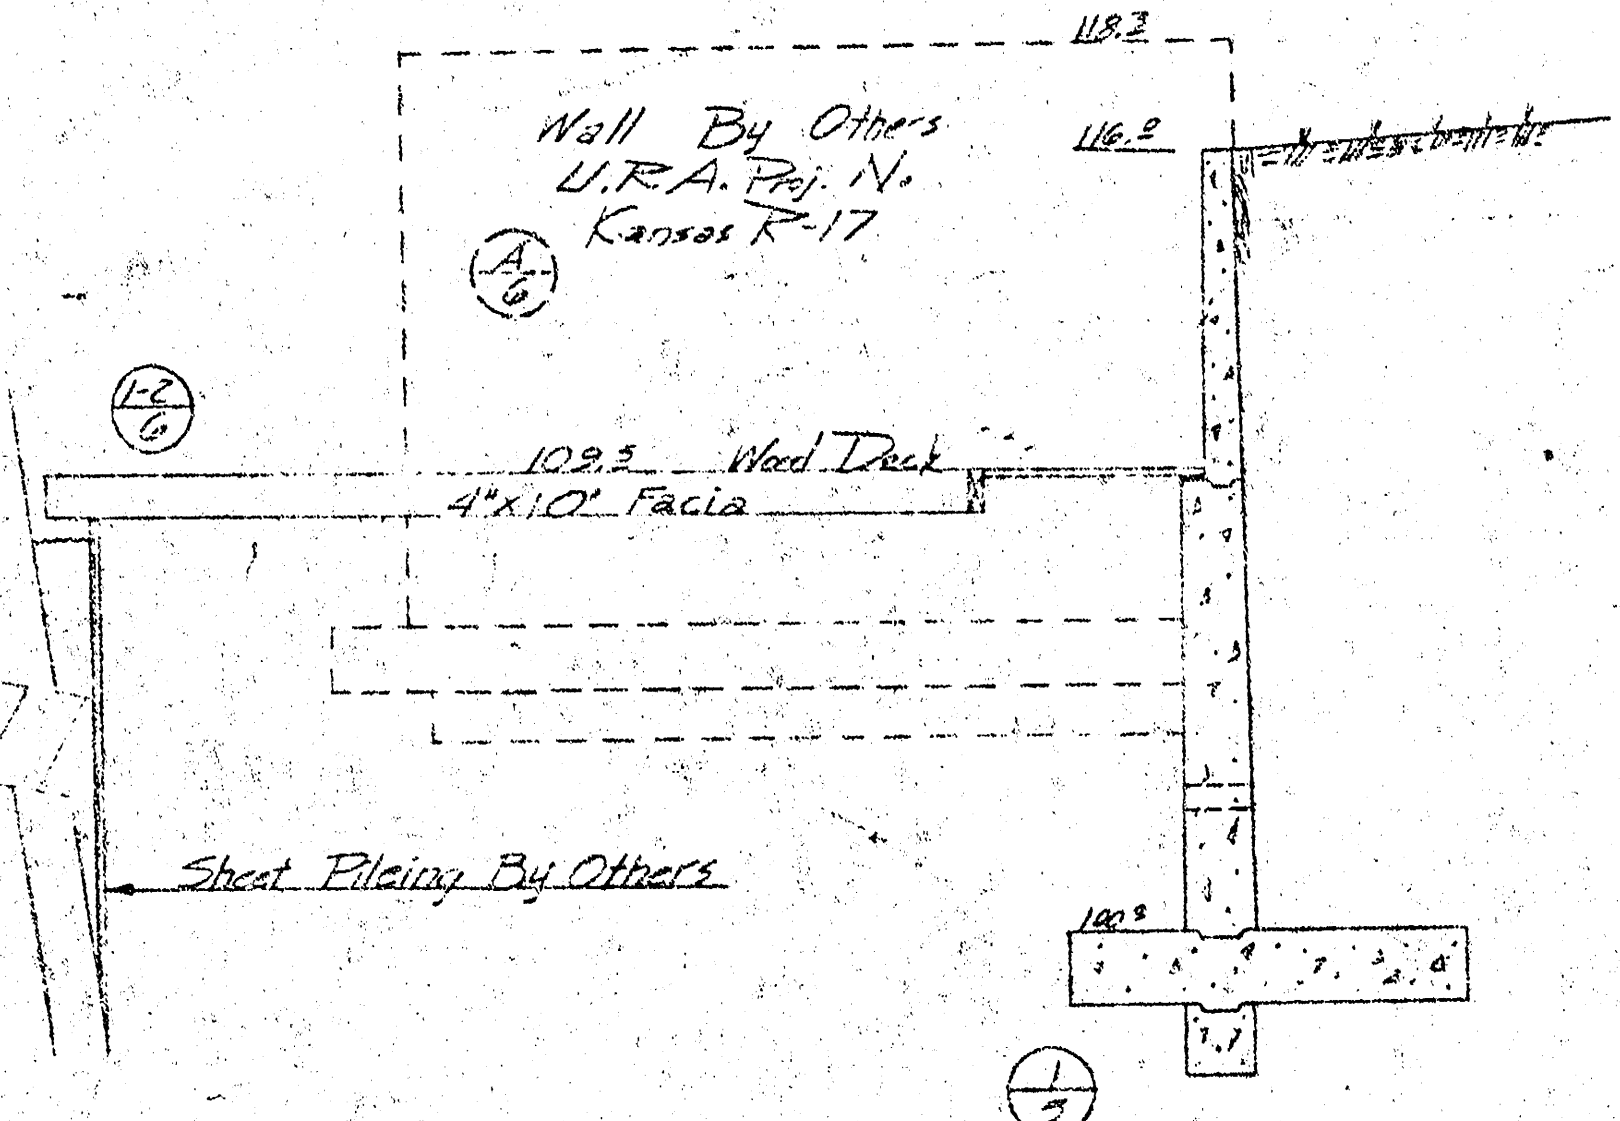

SECTION CC
Scale: 1/4" = 1'-0"

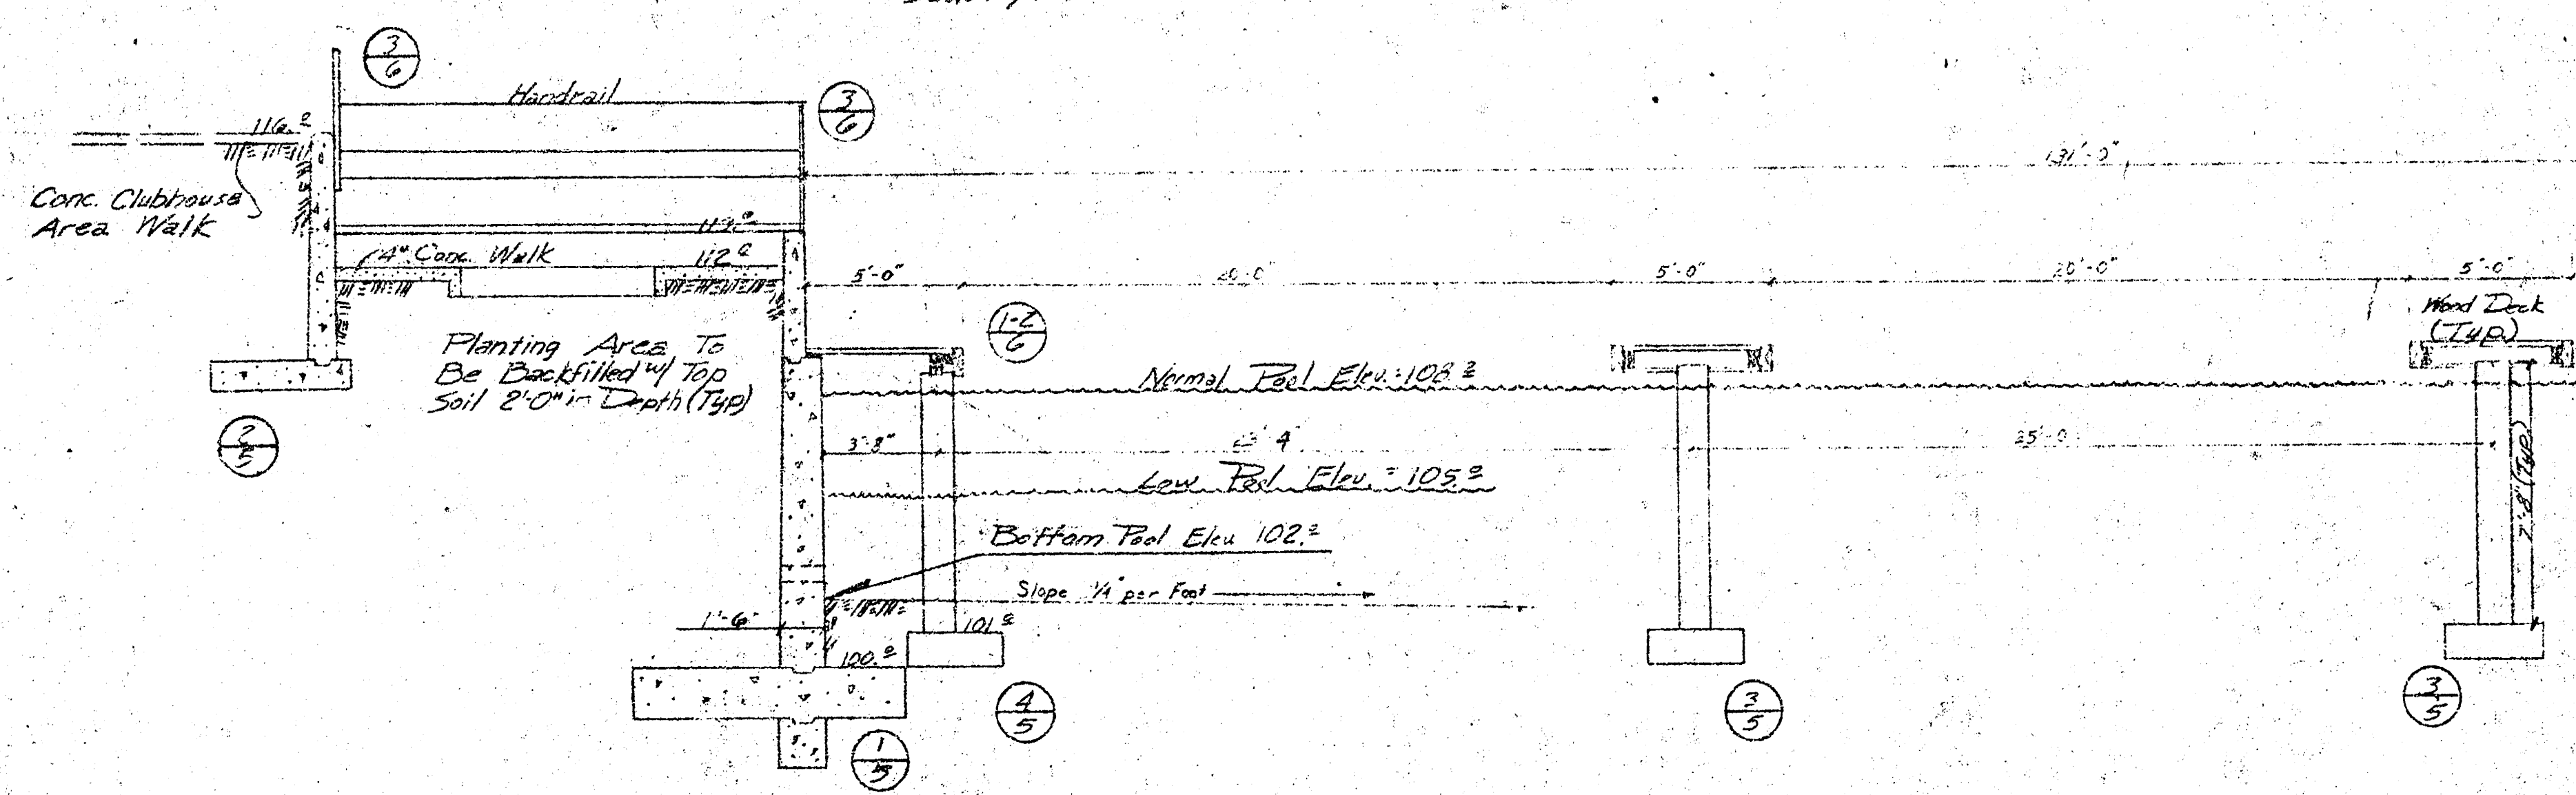






SECTION AA
Scale: 1/4" = 1'-0"

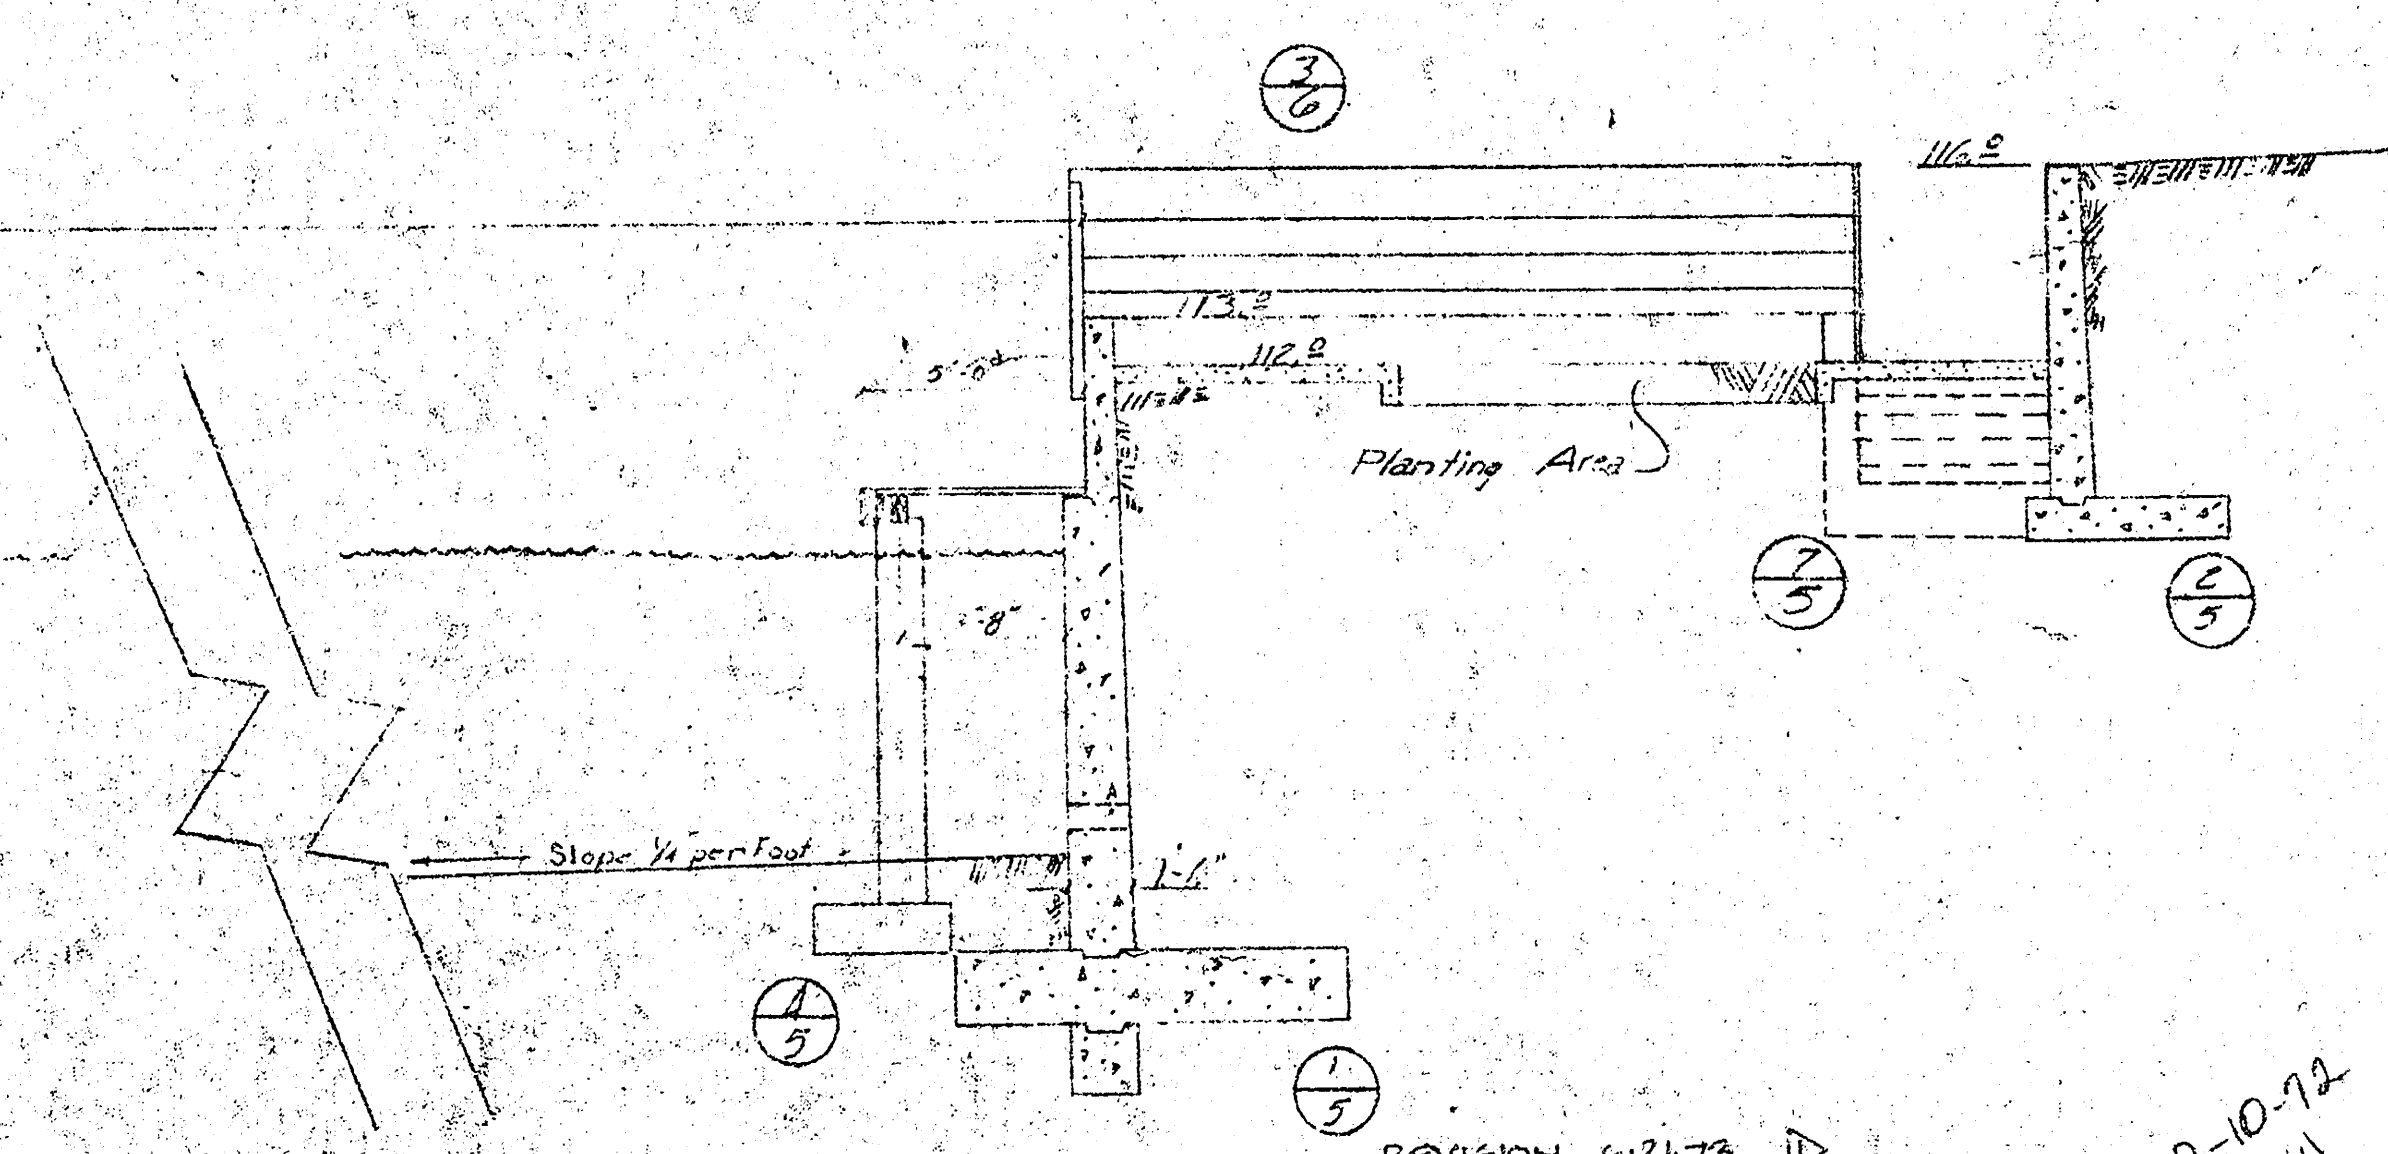

REVISION 6-21-79

2-10-72
DU

McCALEB ENGINEERING EDMOND, OKLAHOMA	
PROJECT NO. 240-10-1	DATE 6-21-79
BARCLAY SQUARE MARINA ELEVATIONS	
DRAWN BY [Signature]	

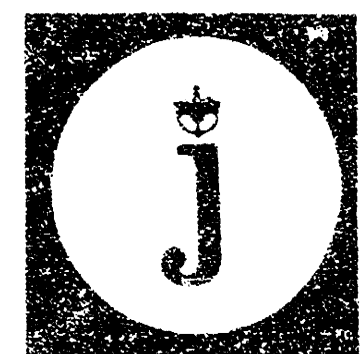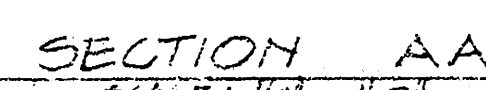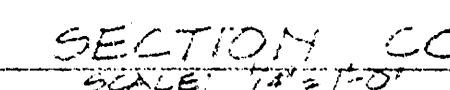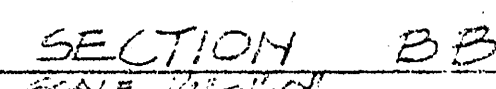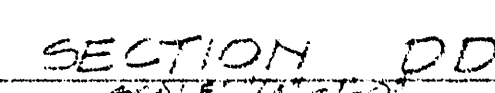

APPROVAL:

JACK P. DEBORN ASSOCIATES, INC.

CONTRACTOR

LEADER

A PLANNED RESIDENTIAL AREA IN

DATE	REVISION	BY

DATE 6-21-77

DRWN. BY

CHKD. BY


ISSUE NO.
REVISION SKT

SHEET NO.

R3 of 8



OF SHTS

JACK P. DE BOER ASSOCIATES, INC.
40 N. ROCK ROAD P.O. BOX 15387 WICHITA, KANSAS 67214
(316) 863-2831

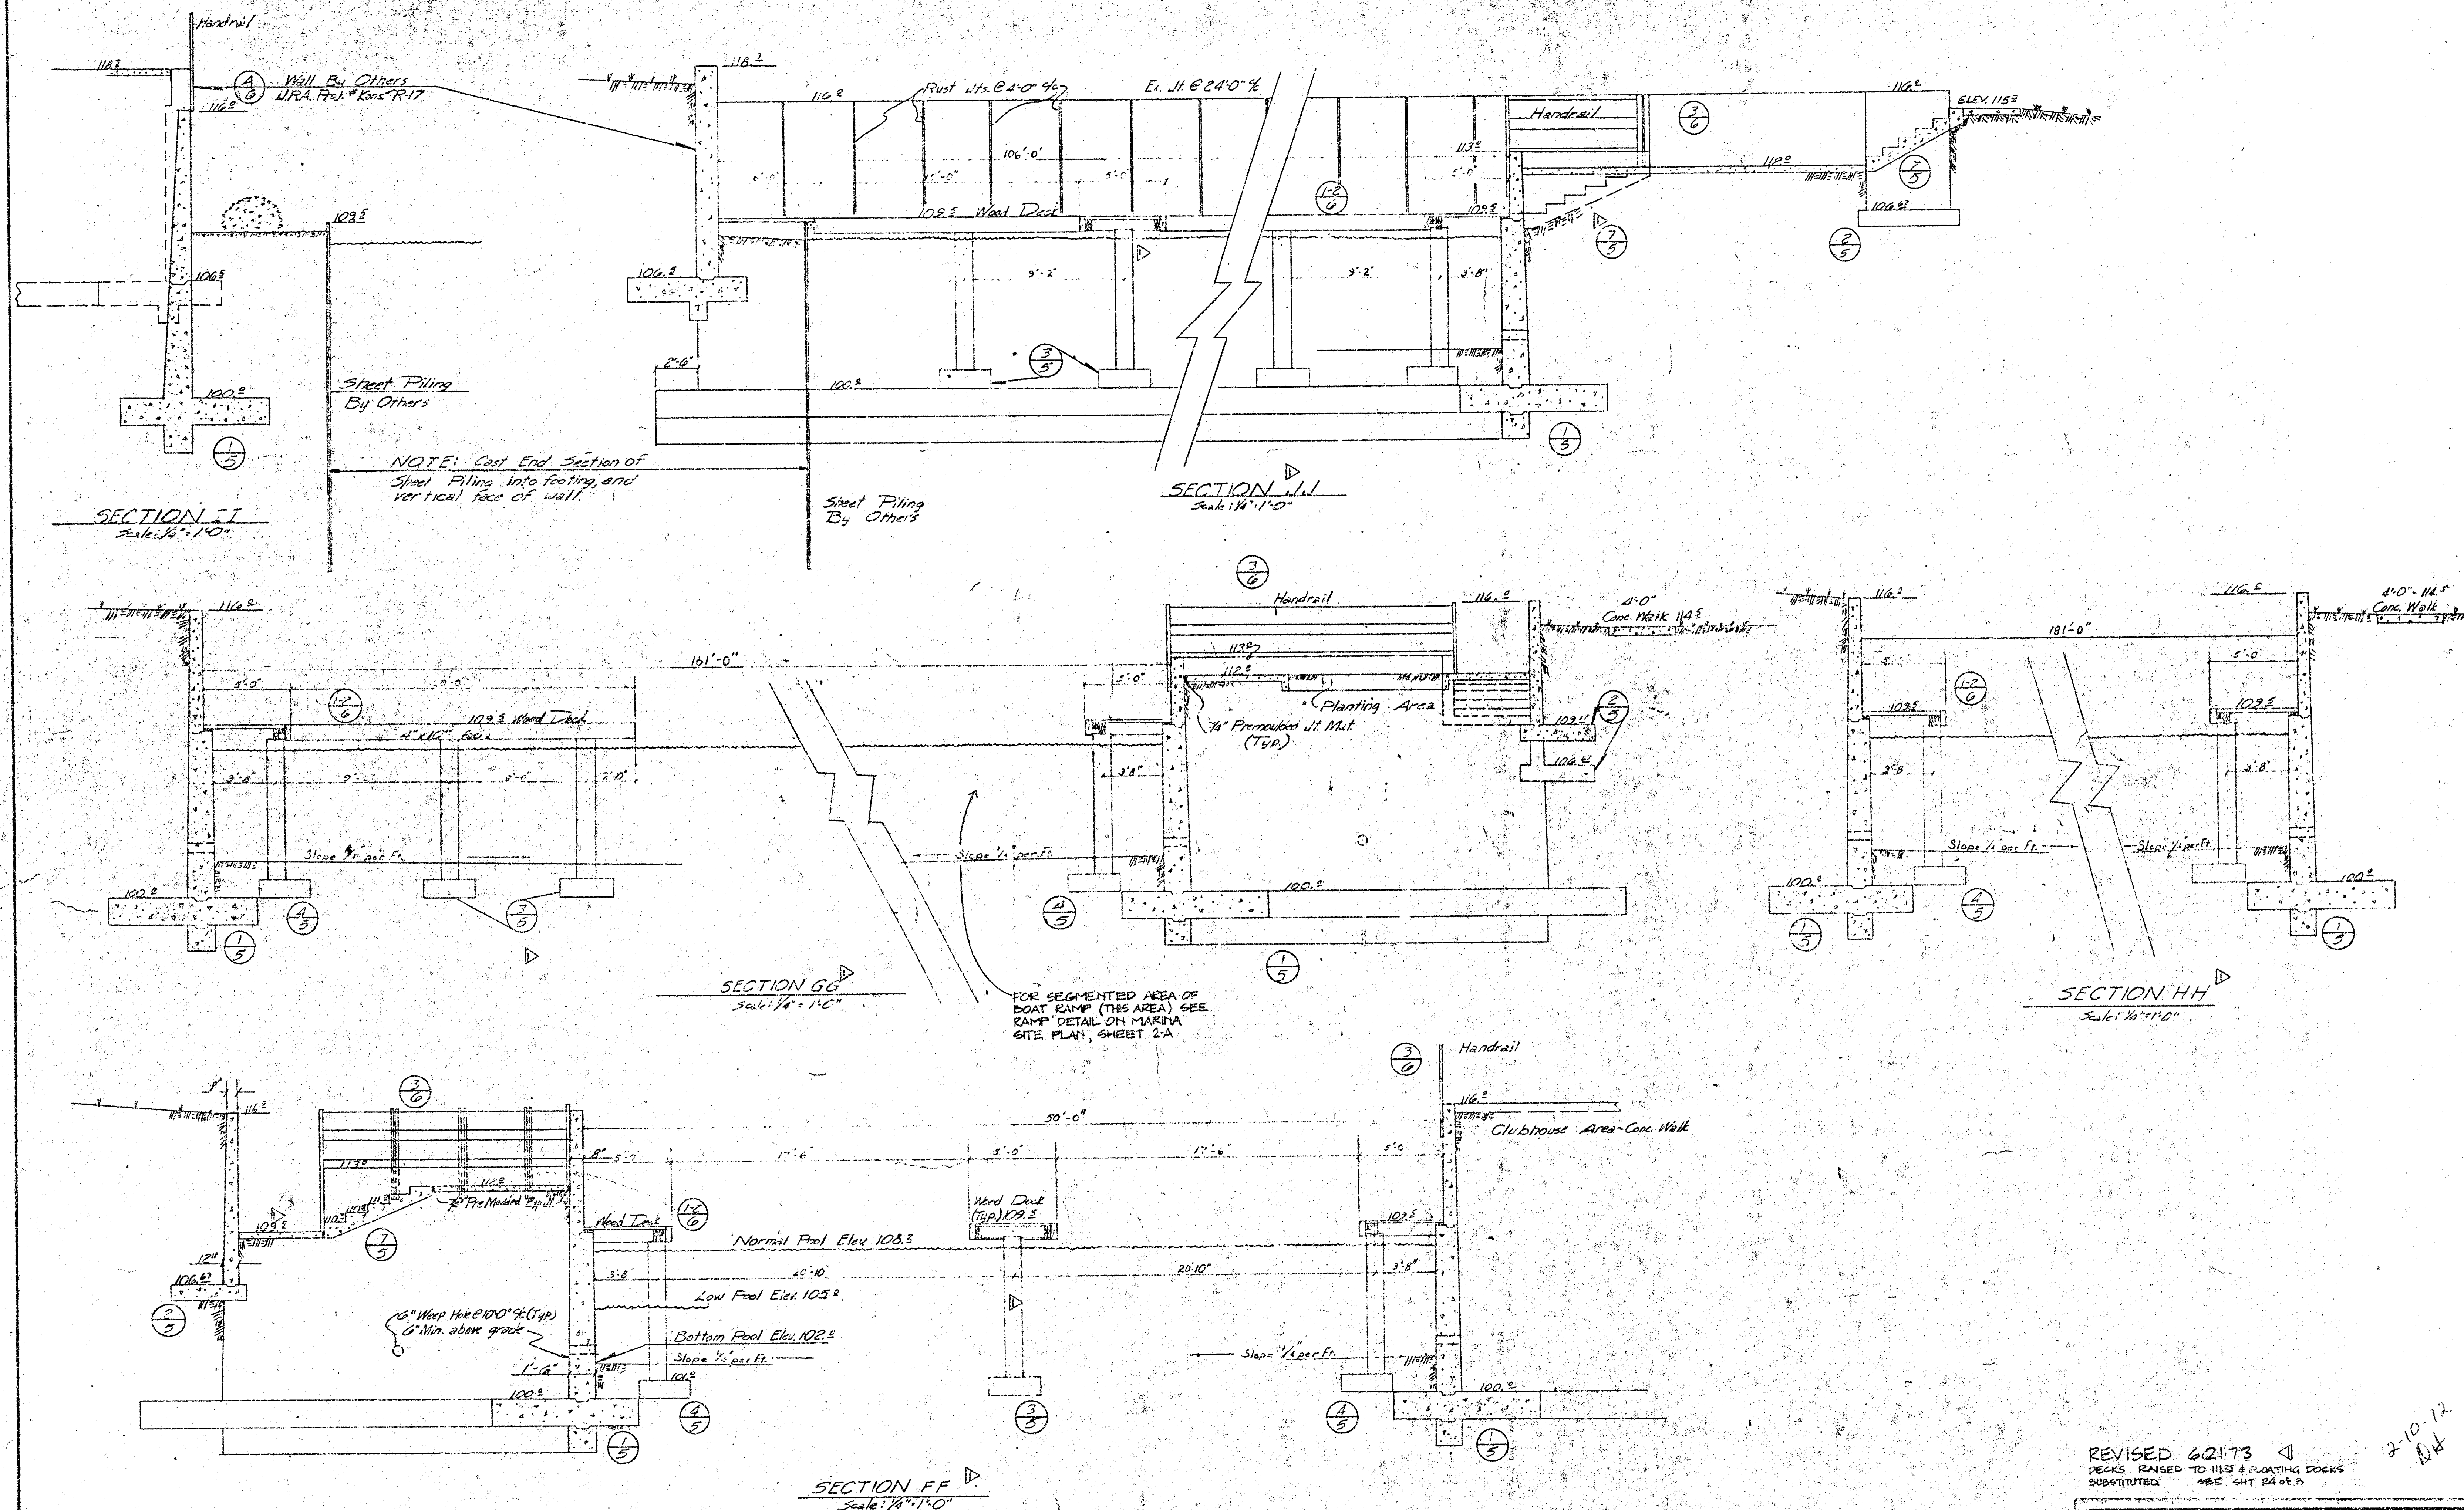

REVISED 6.21.73
DECKS RAISED TO 115.5 & FLOATING DOCKS
SUBSTITUTED SEE GHT 2A at 2

McCALEB ENGINEERING EDMOND, OKLAHOMA		Date: 6-21-73 Title: MARINA ELEVATIONS Scale: 1/4" = 1'-0"
BARCLAY SQUIP MARINA ELEVATIONS		210.12 114

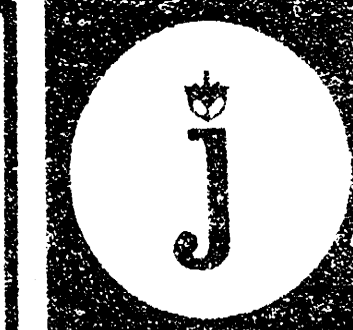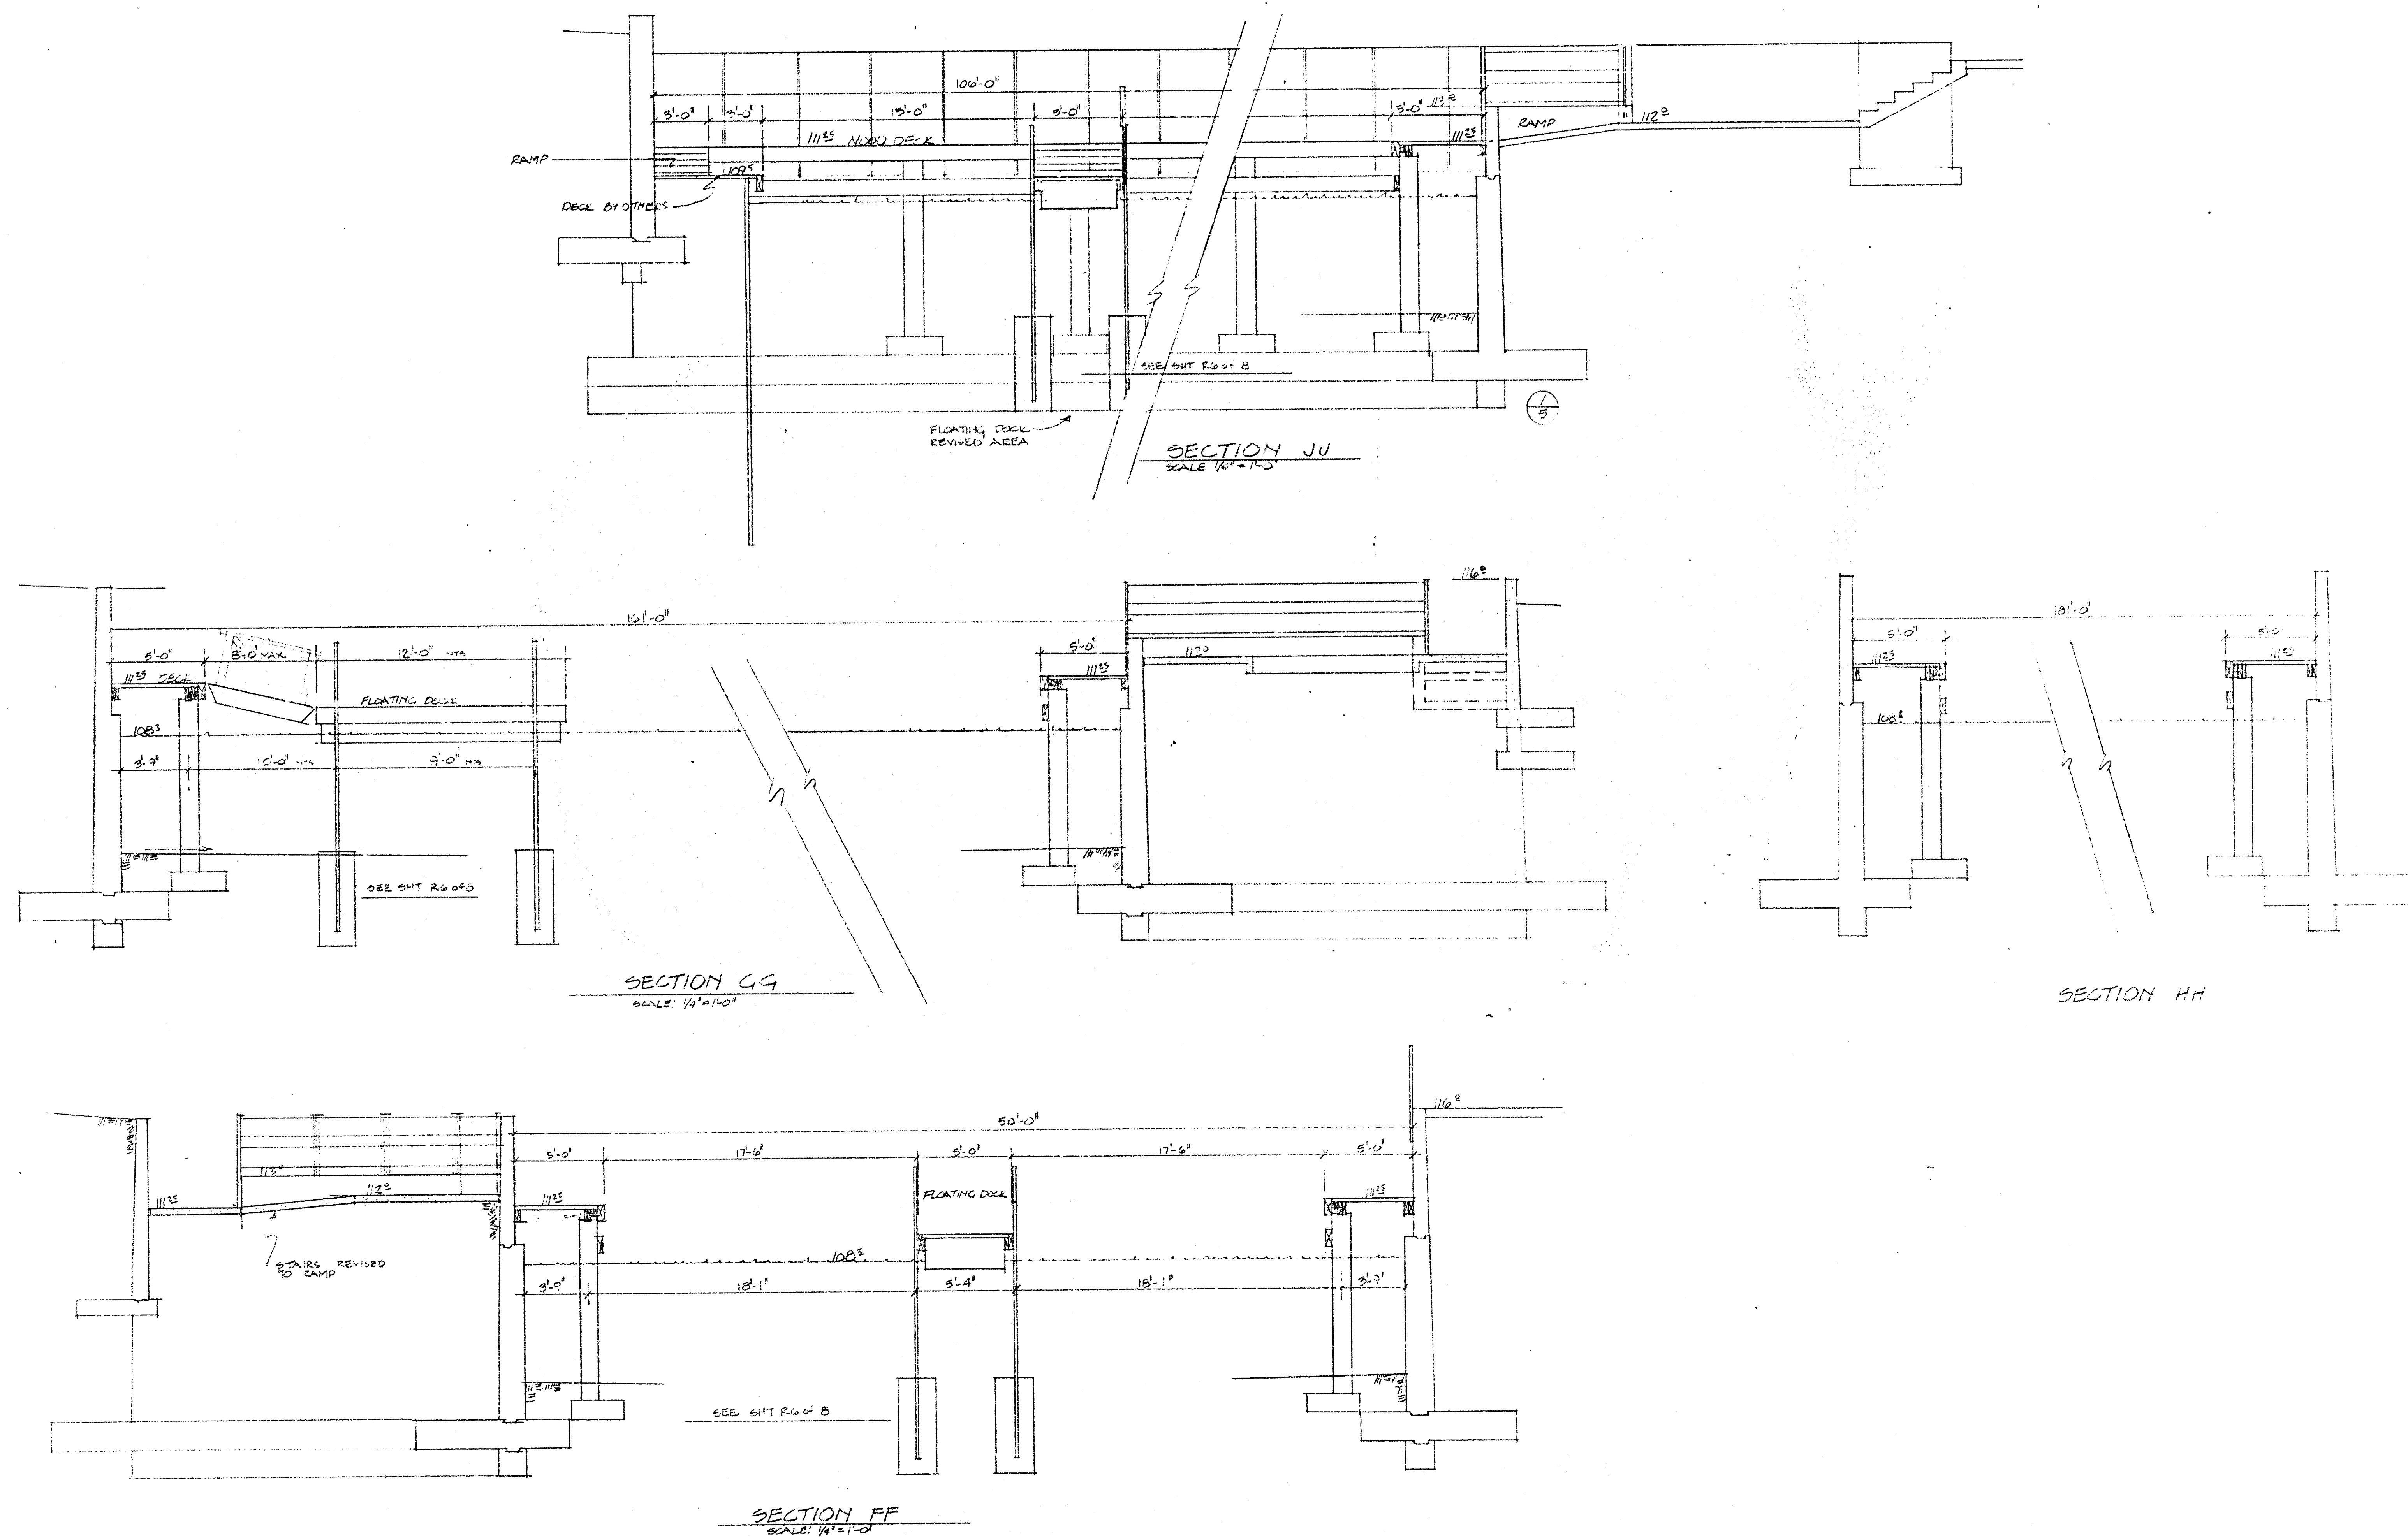

APPROVAL:
JACK P. DEBOER ASSOCIATES, INC.
CONTRACTOR








A PLANNED RESIDENTIAL AREA IN

BY
DATE REVISION
7-6-73

DATE
6-2-73
DRAWN. BY
CHKD. BY
ISSUE NO.
REVISED

SHEET NO.
24 of 8
OF SHTS

JACK P. DEBOER ASSOCIATES, INC.
240 N. ROCK ROAD, P.O. BOX 16887, WICHITA, KANSAS 67216

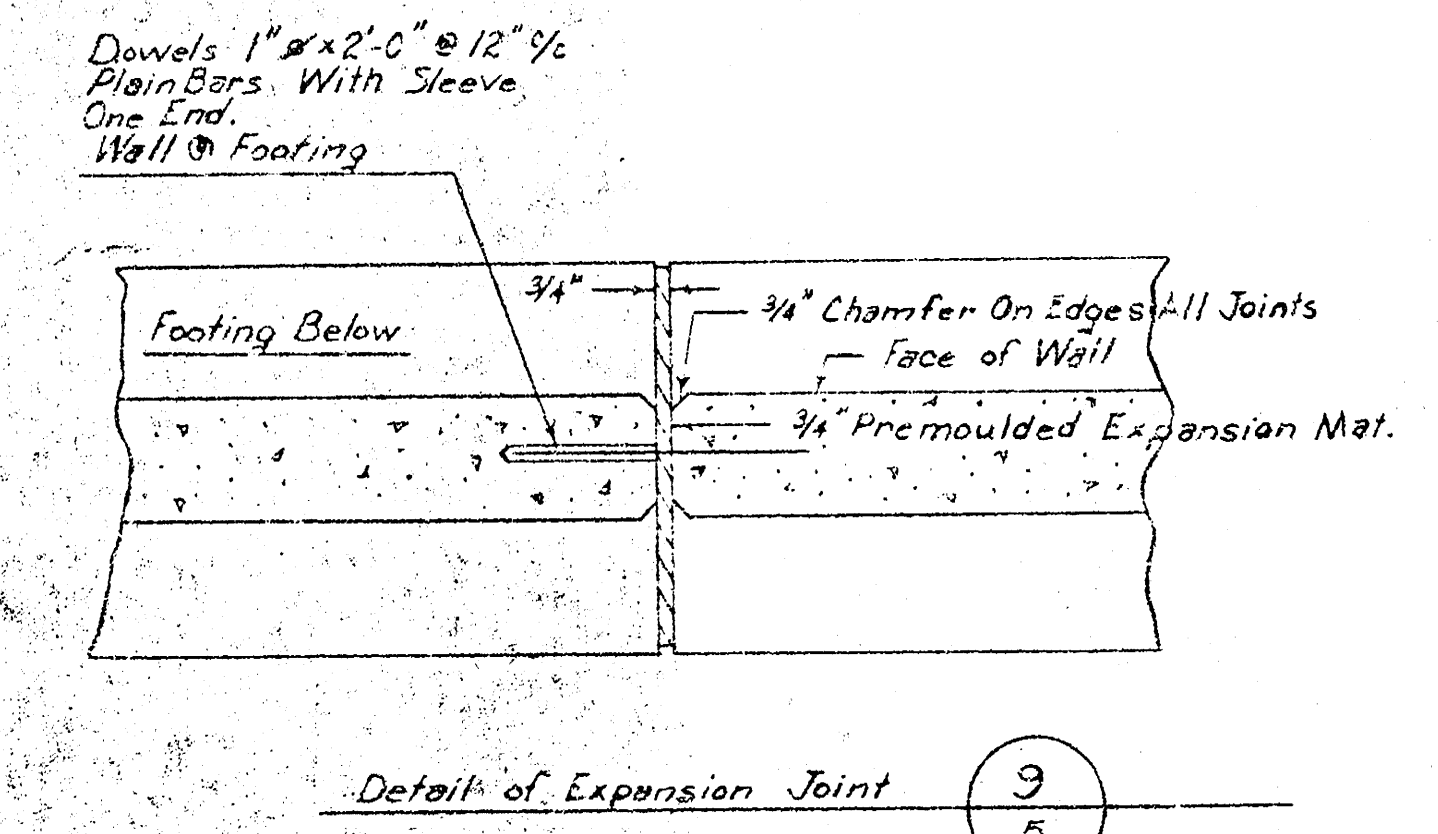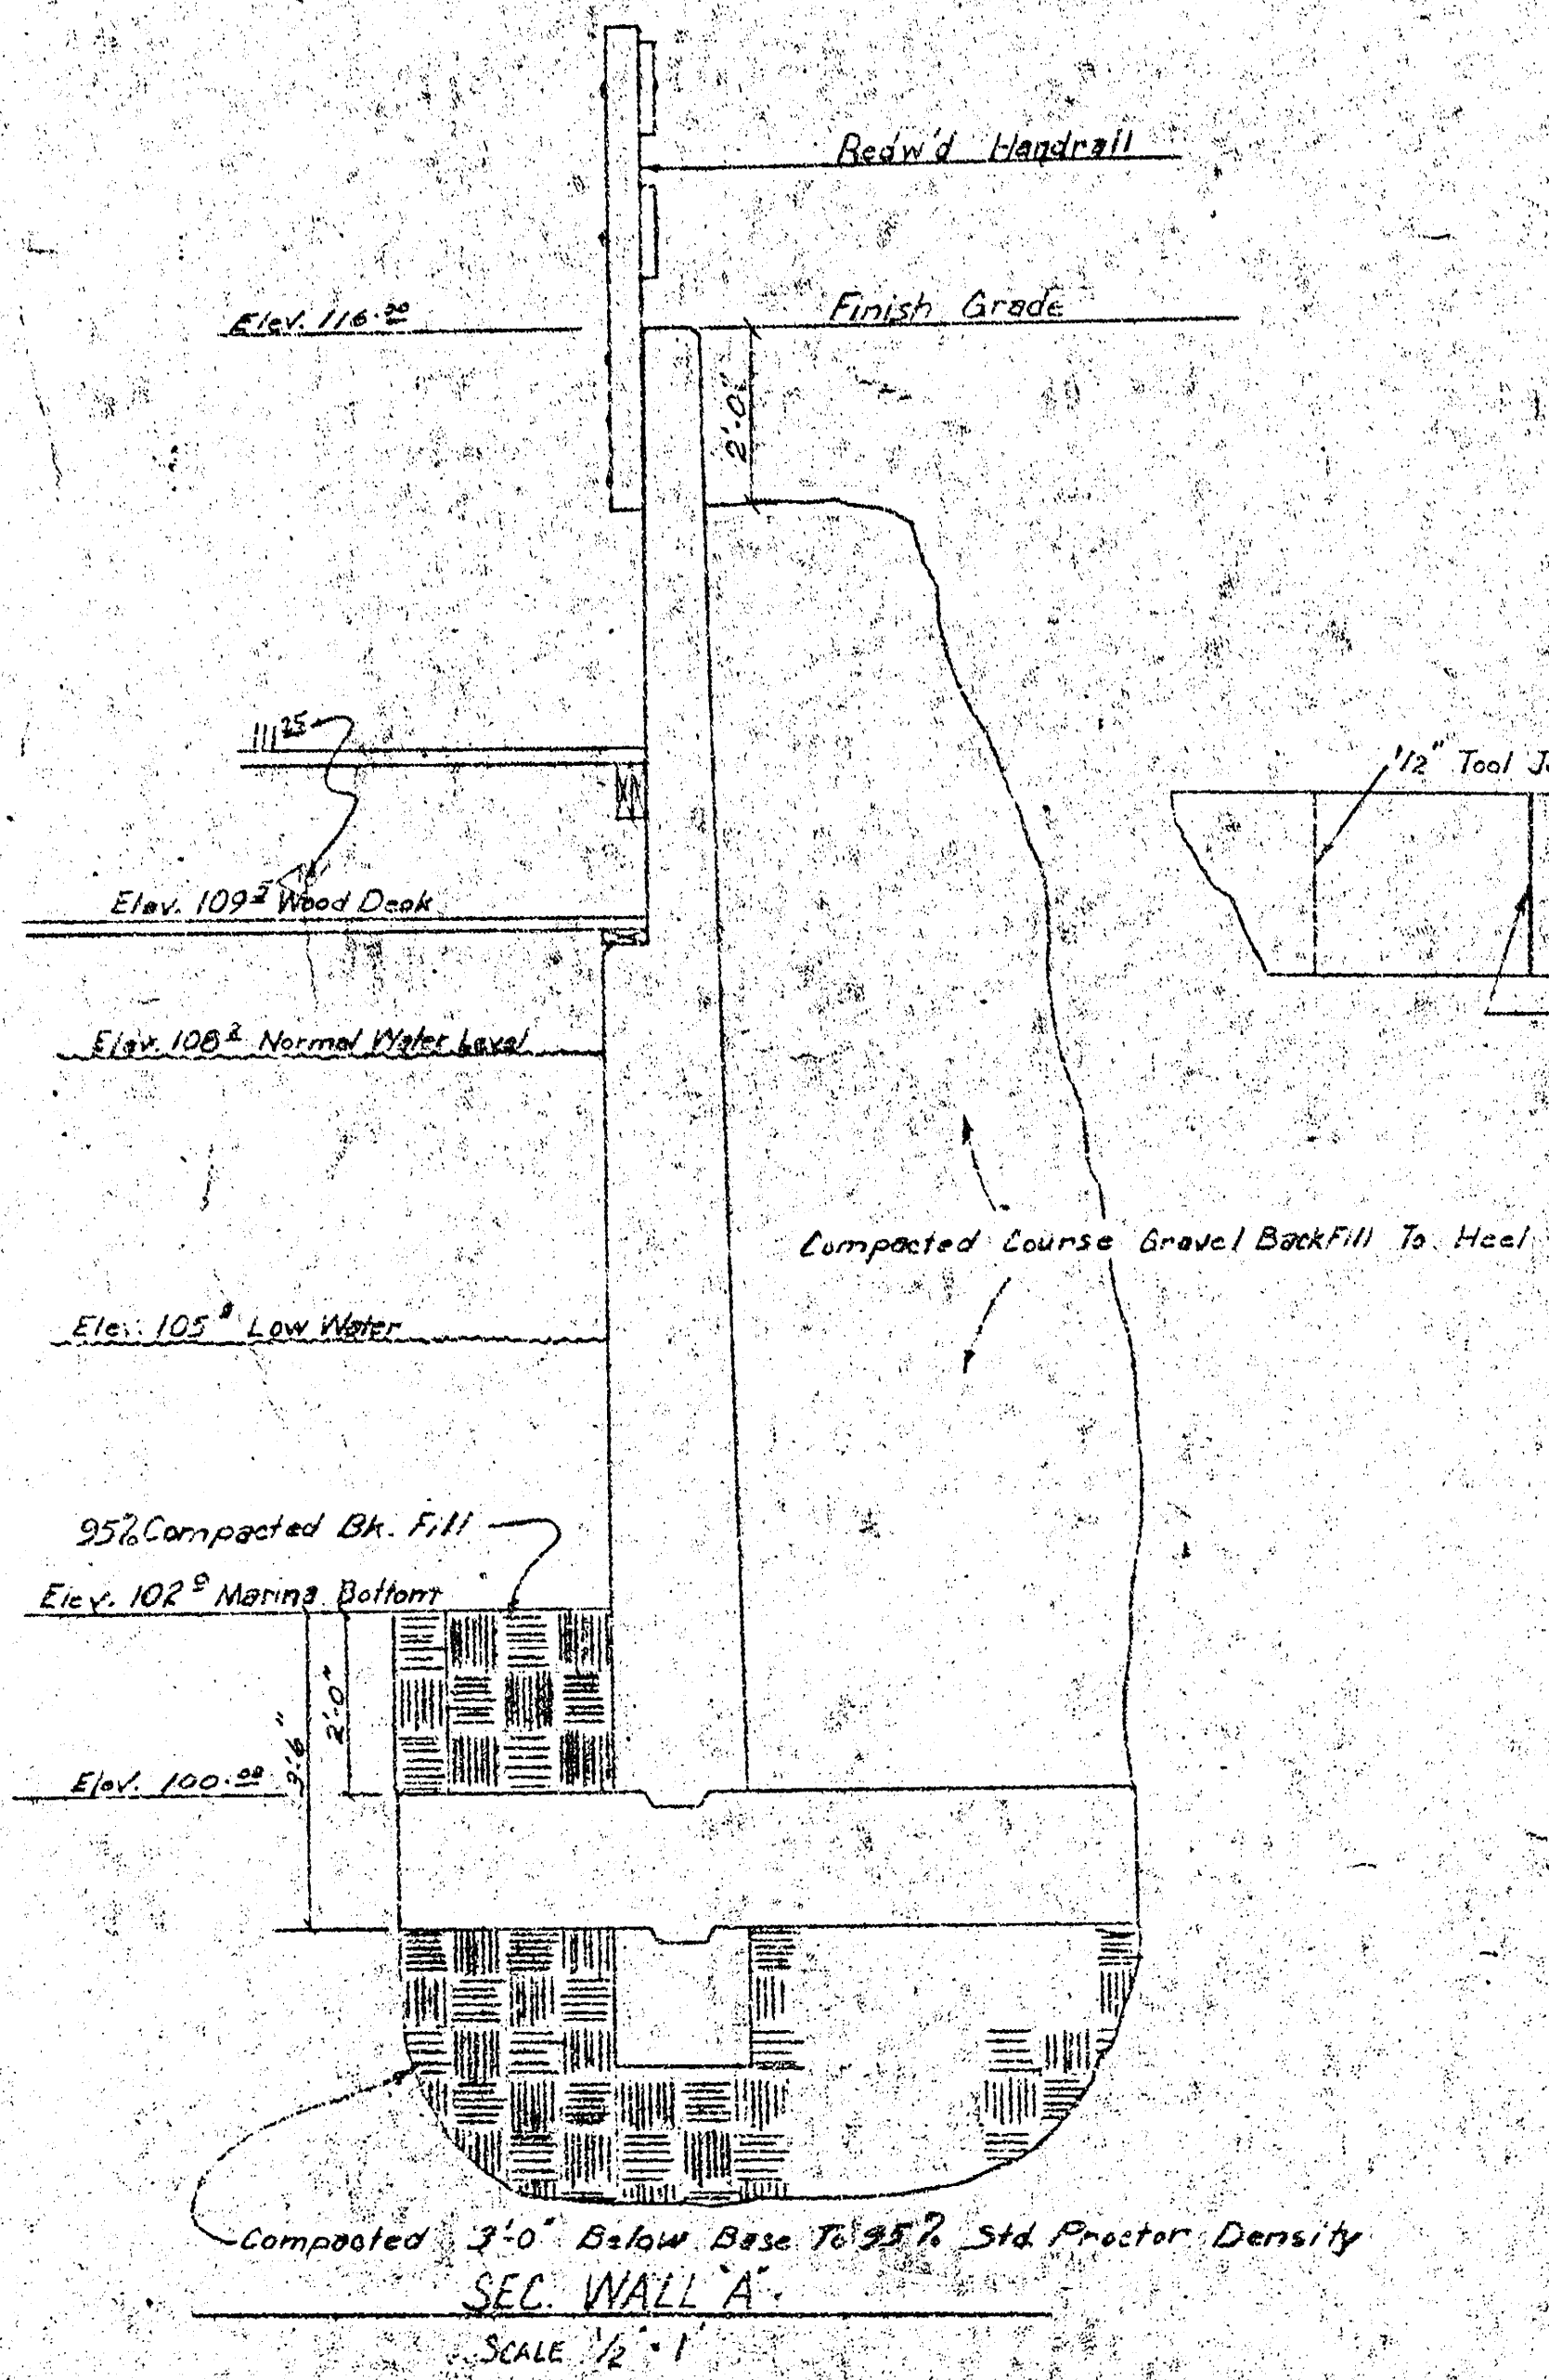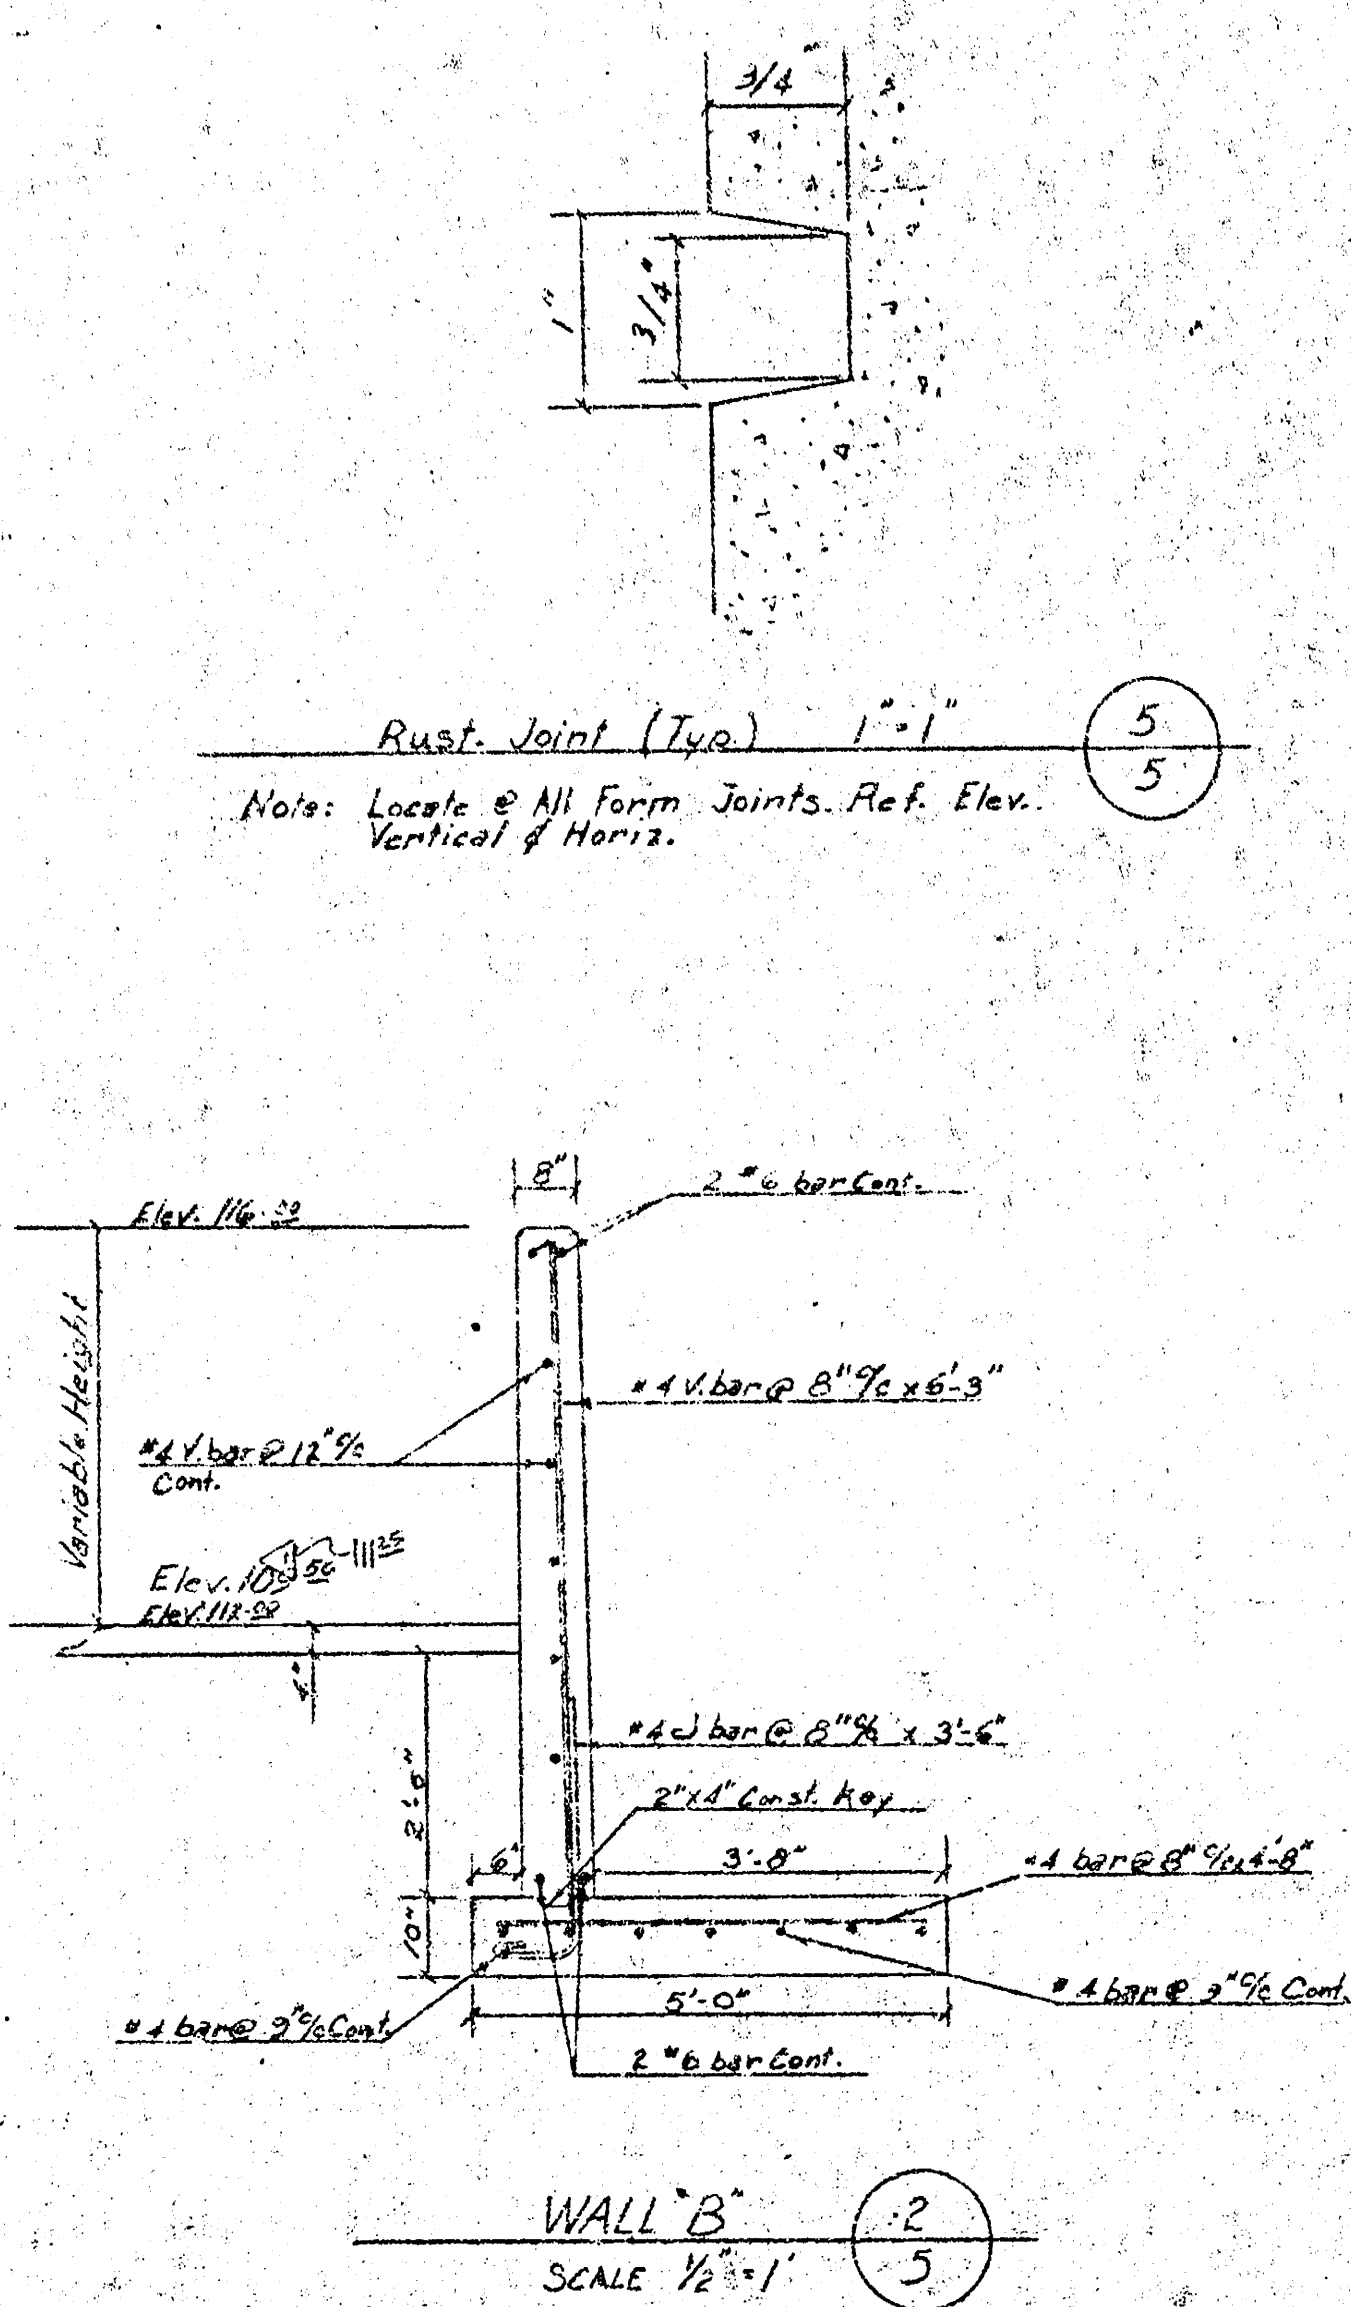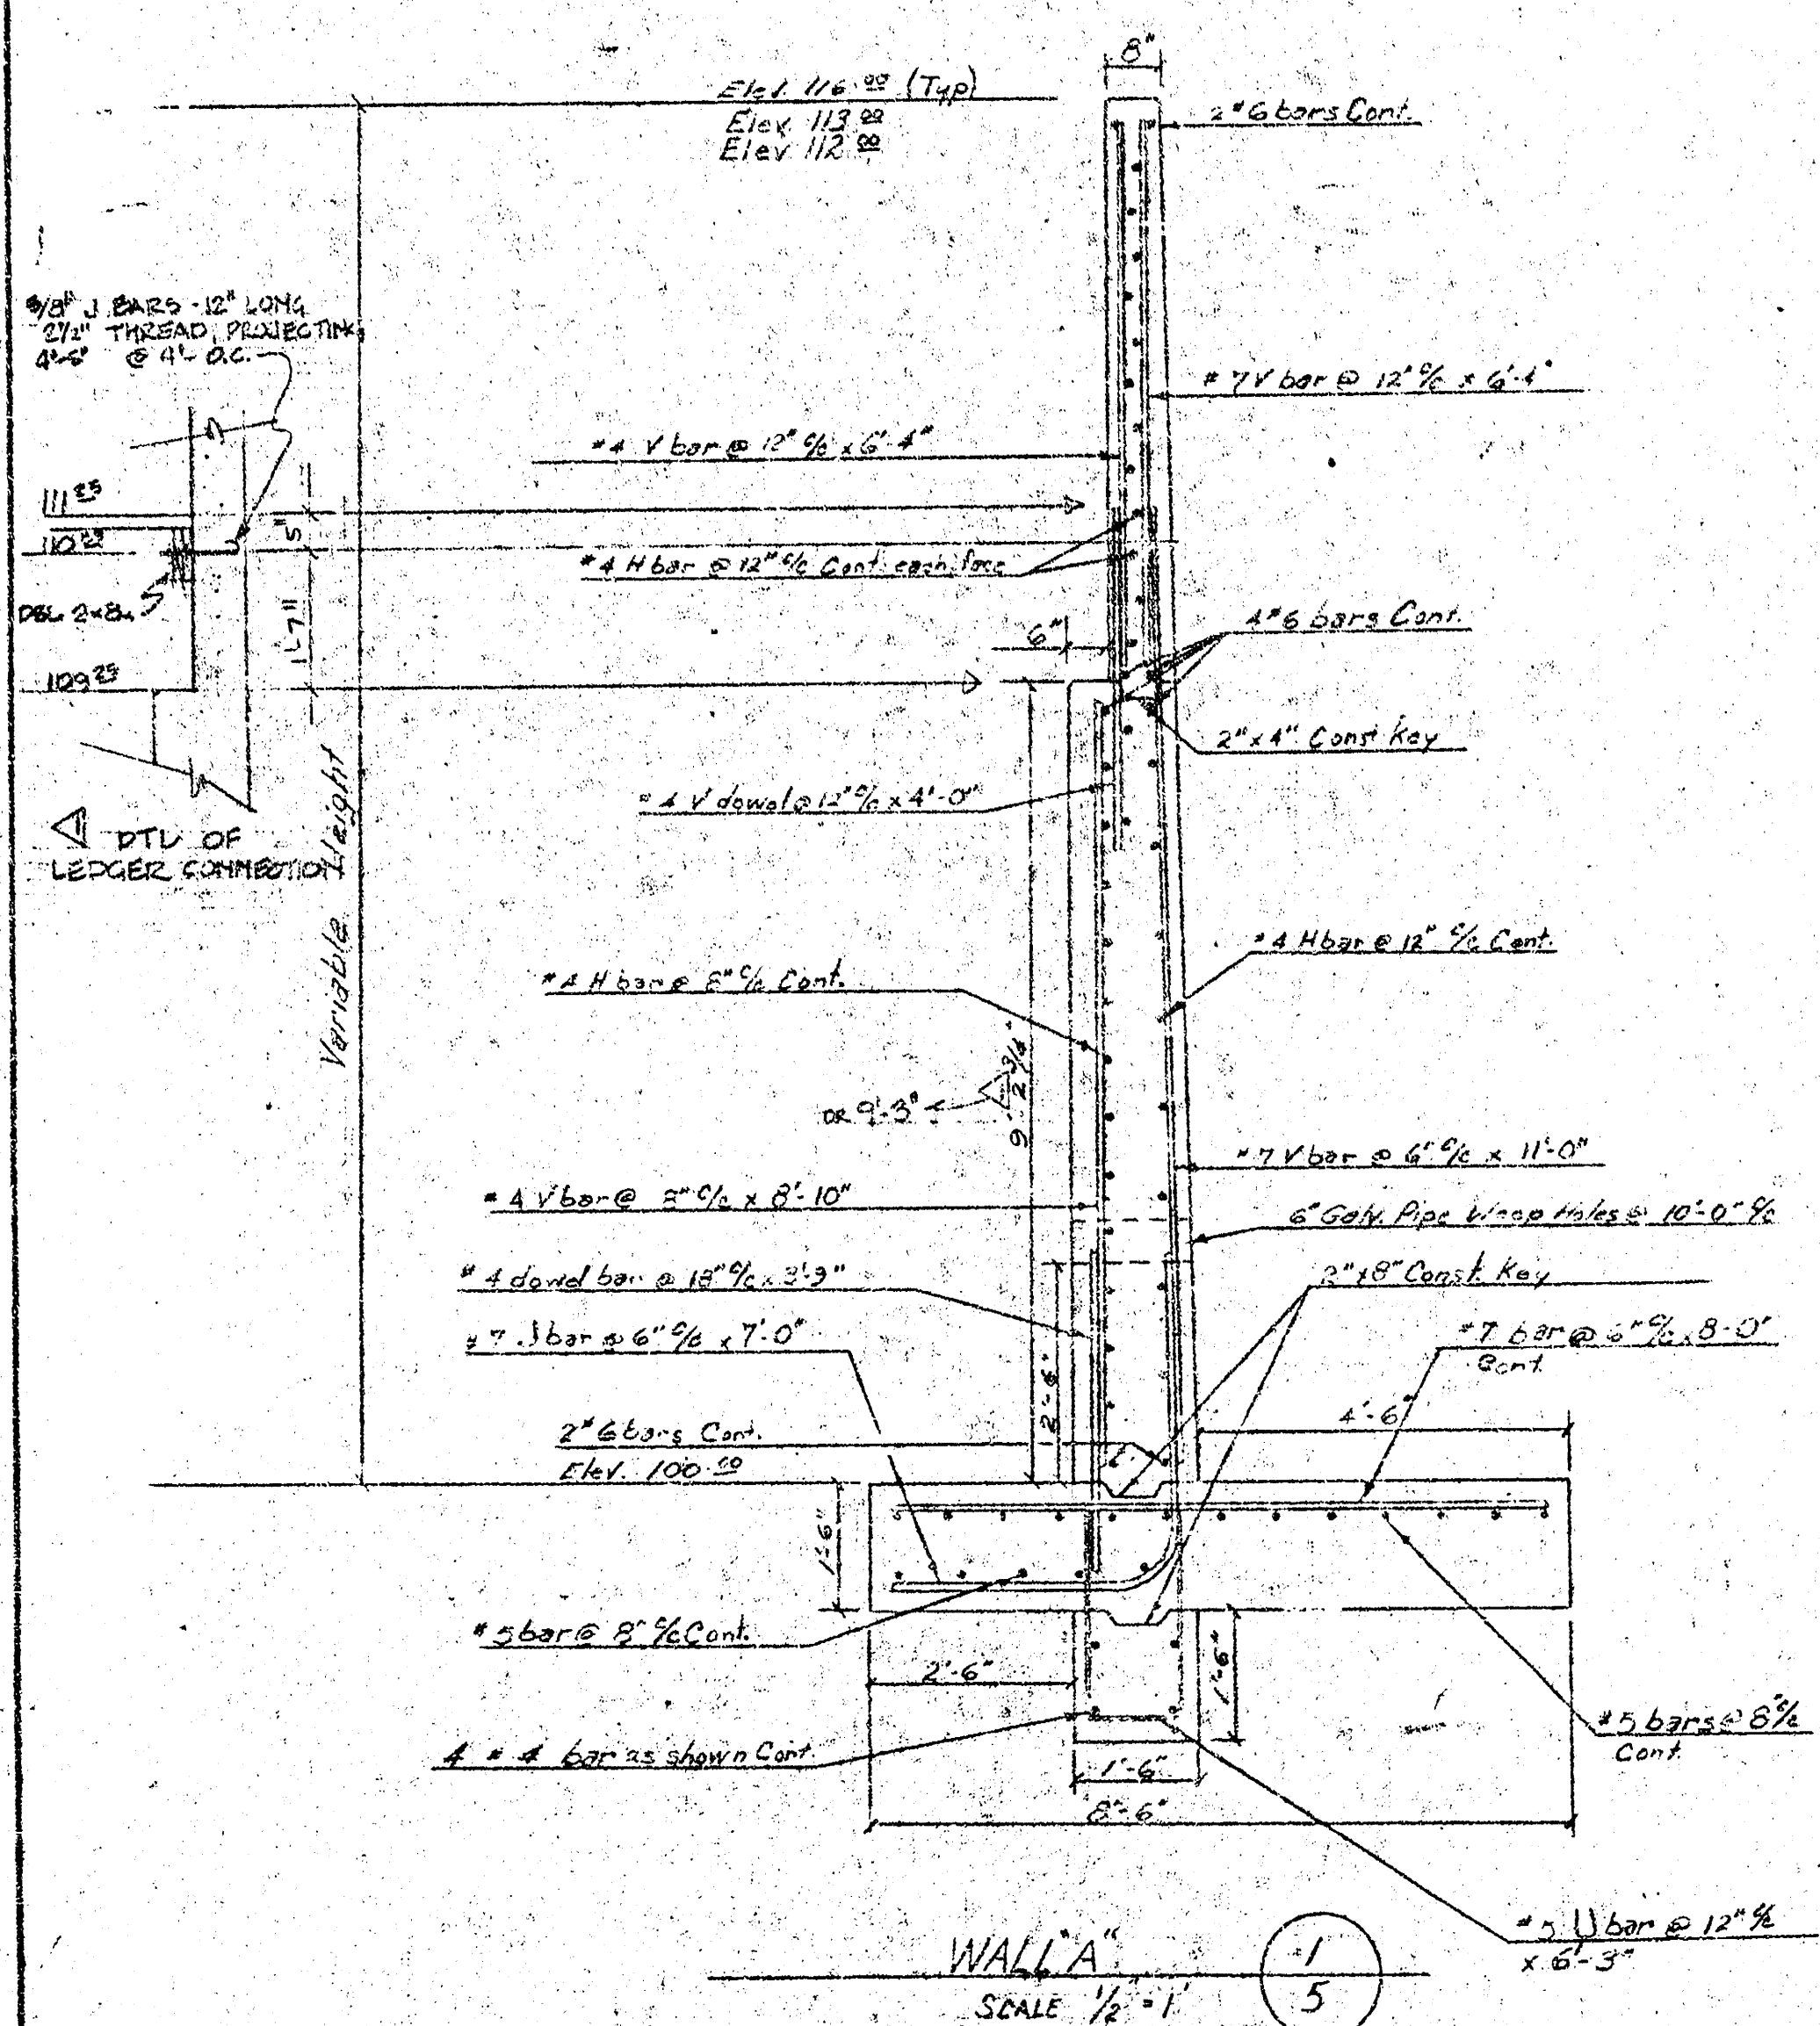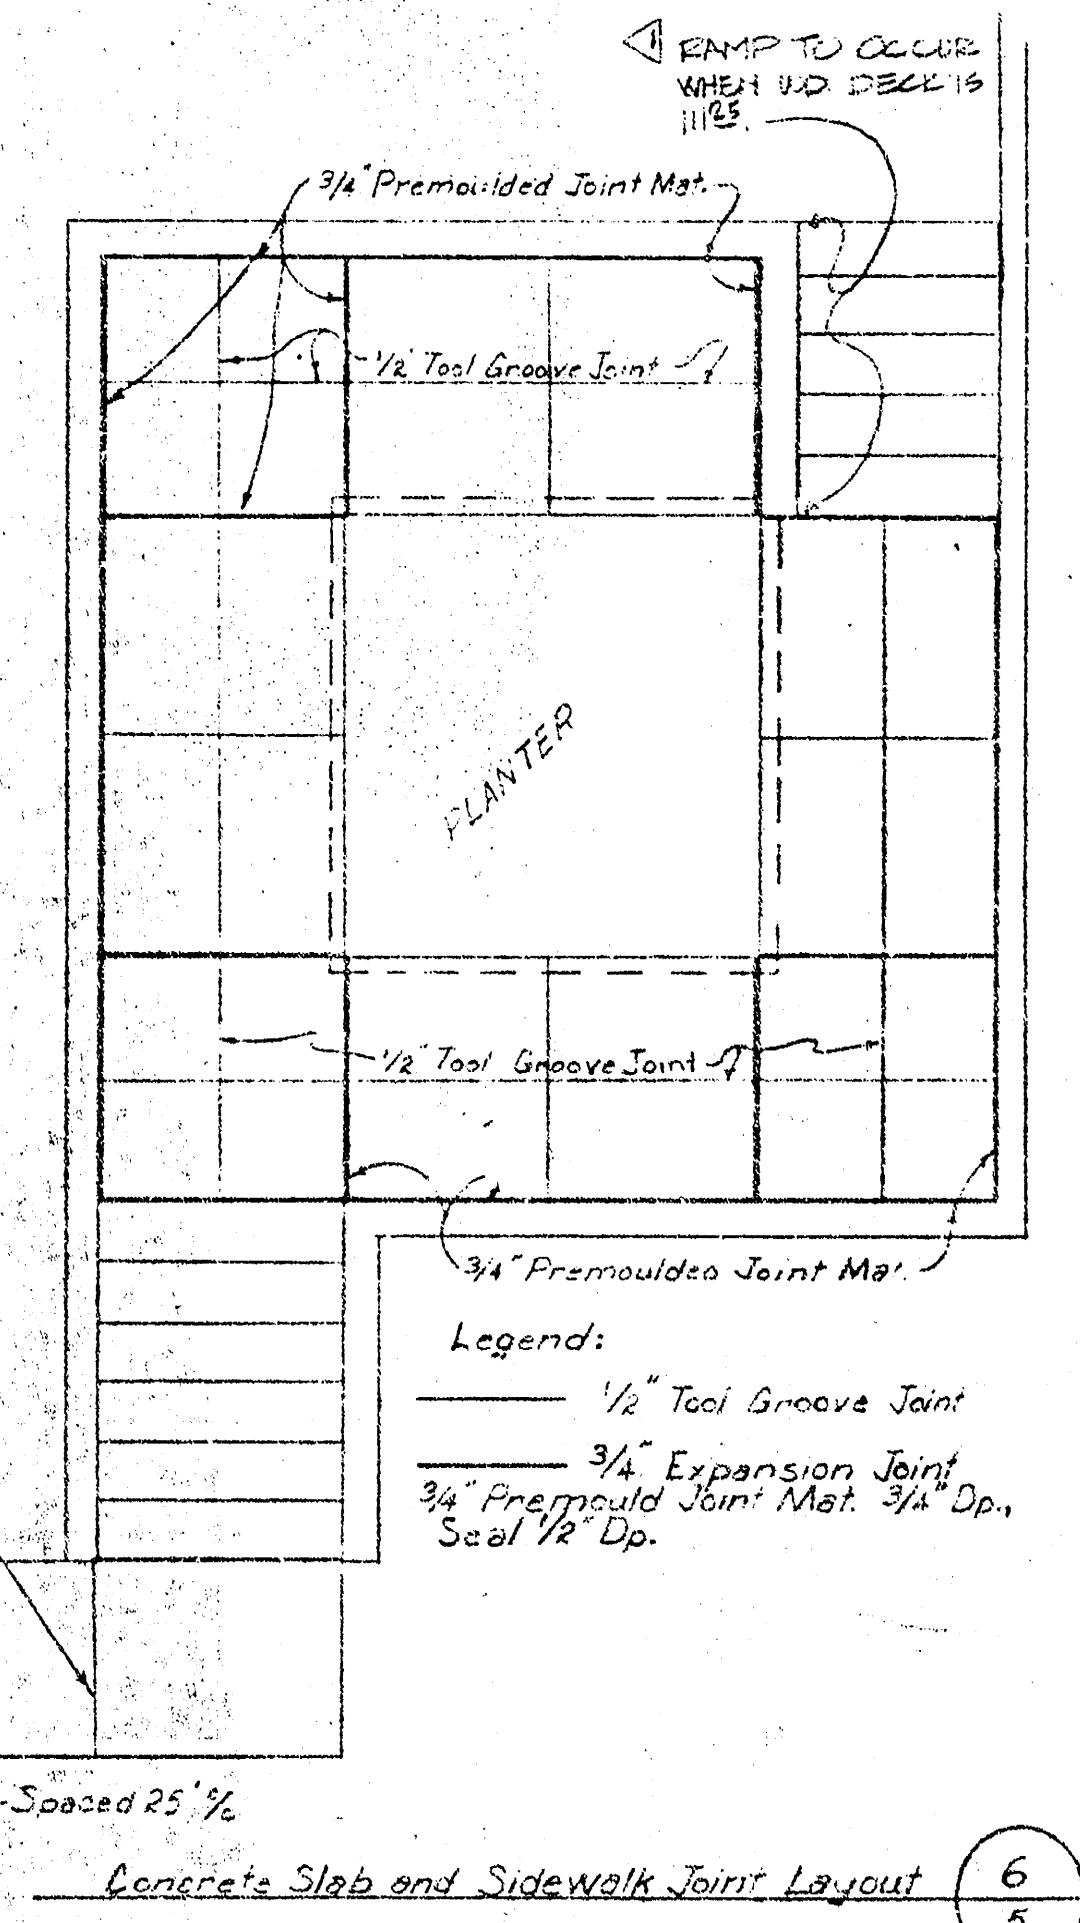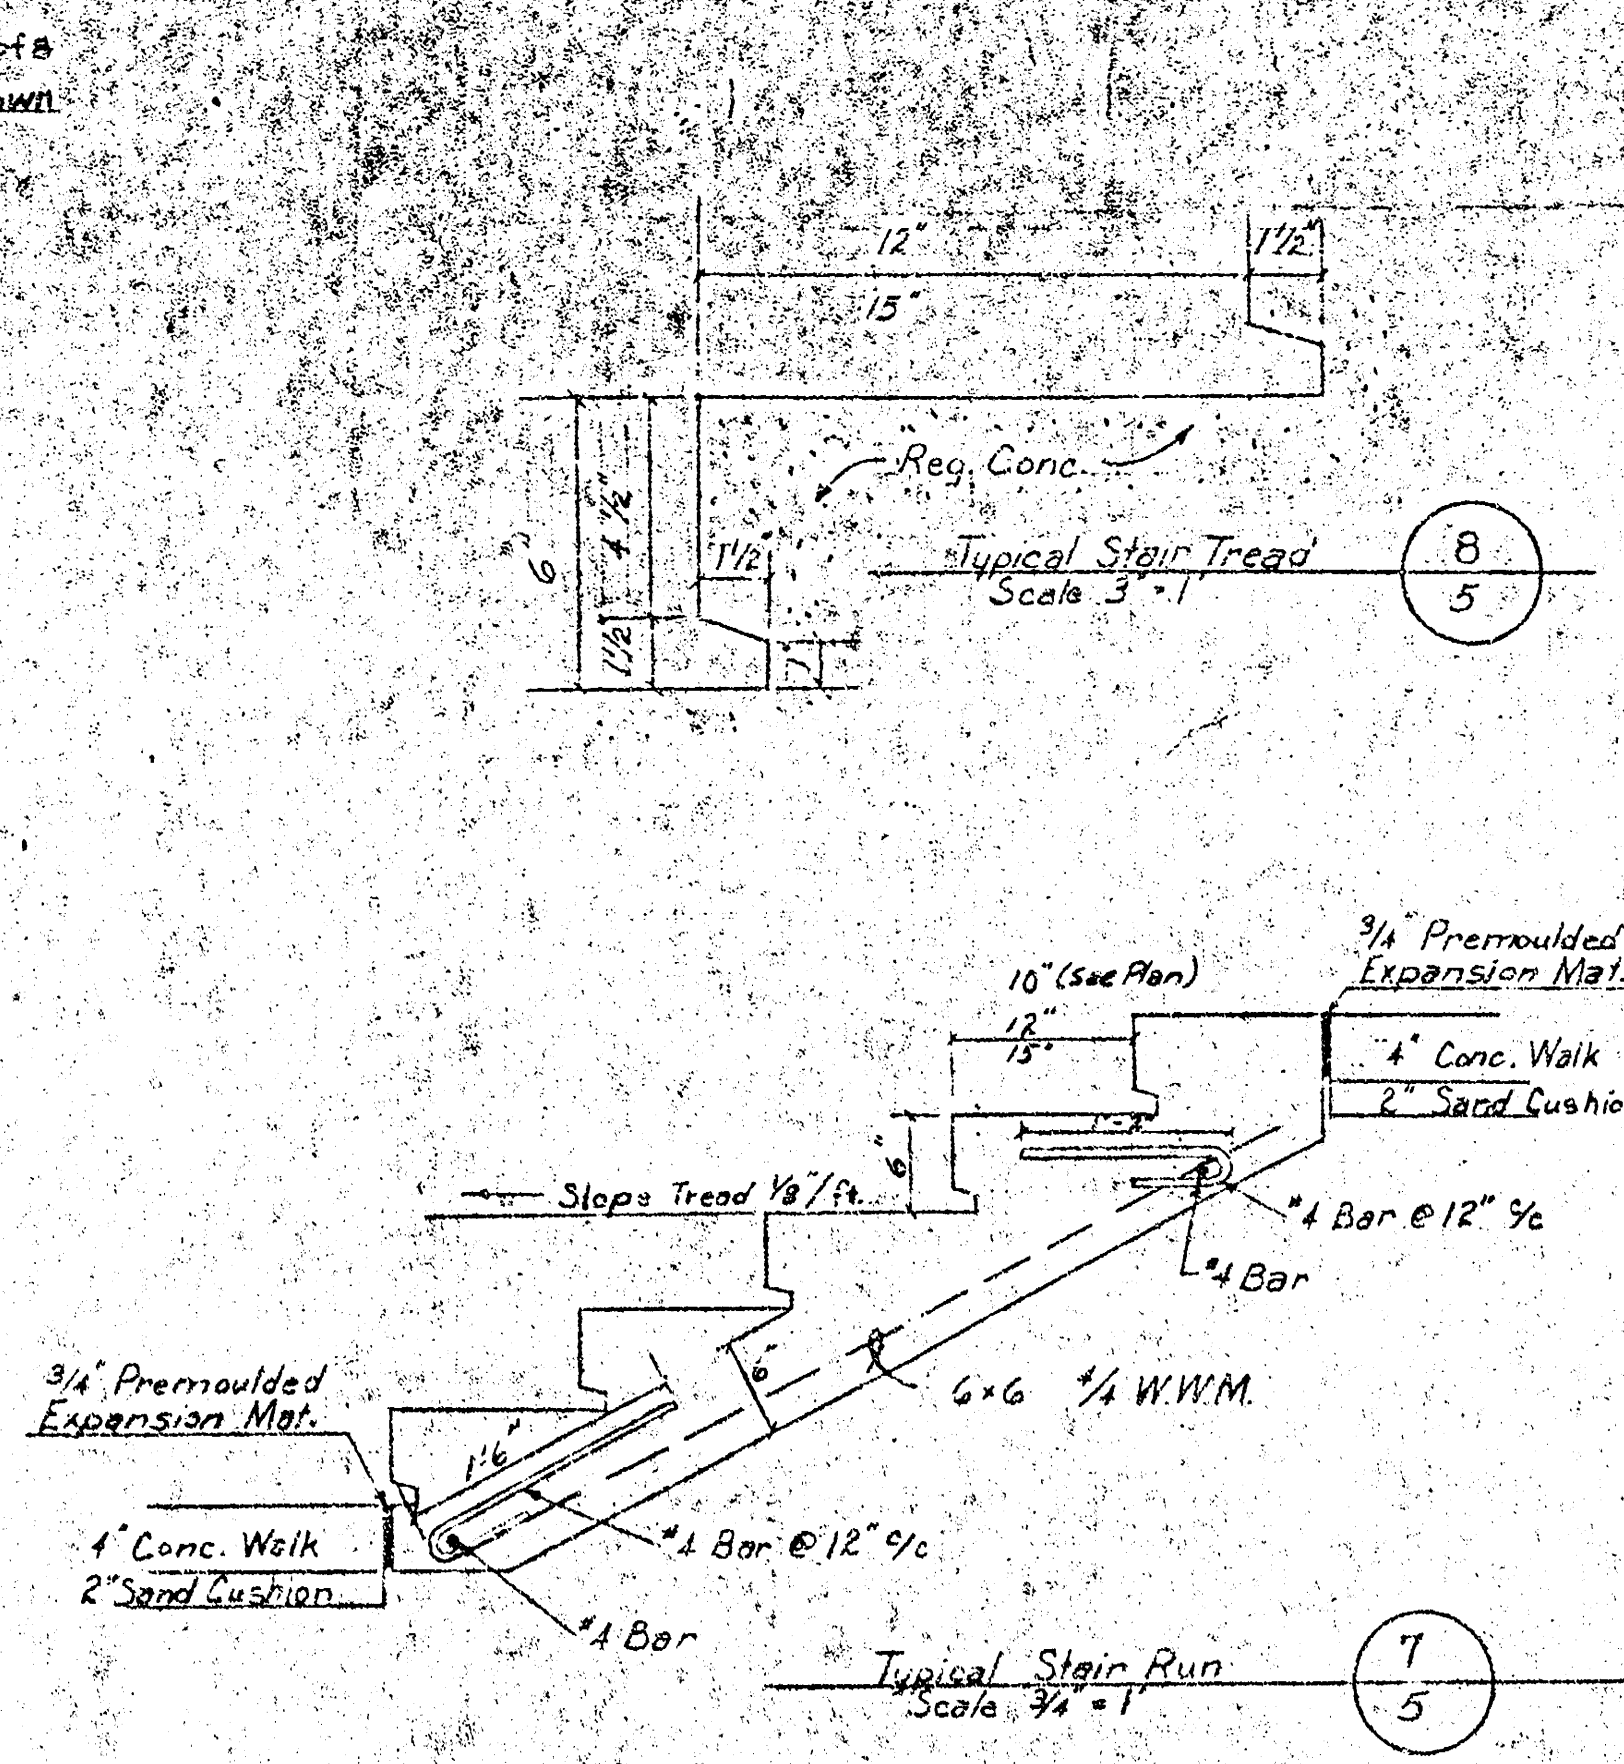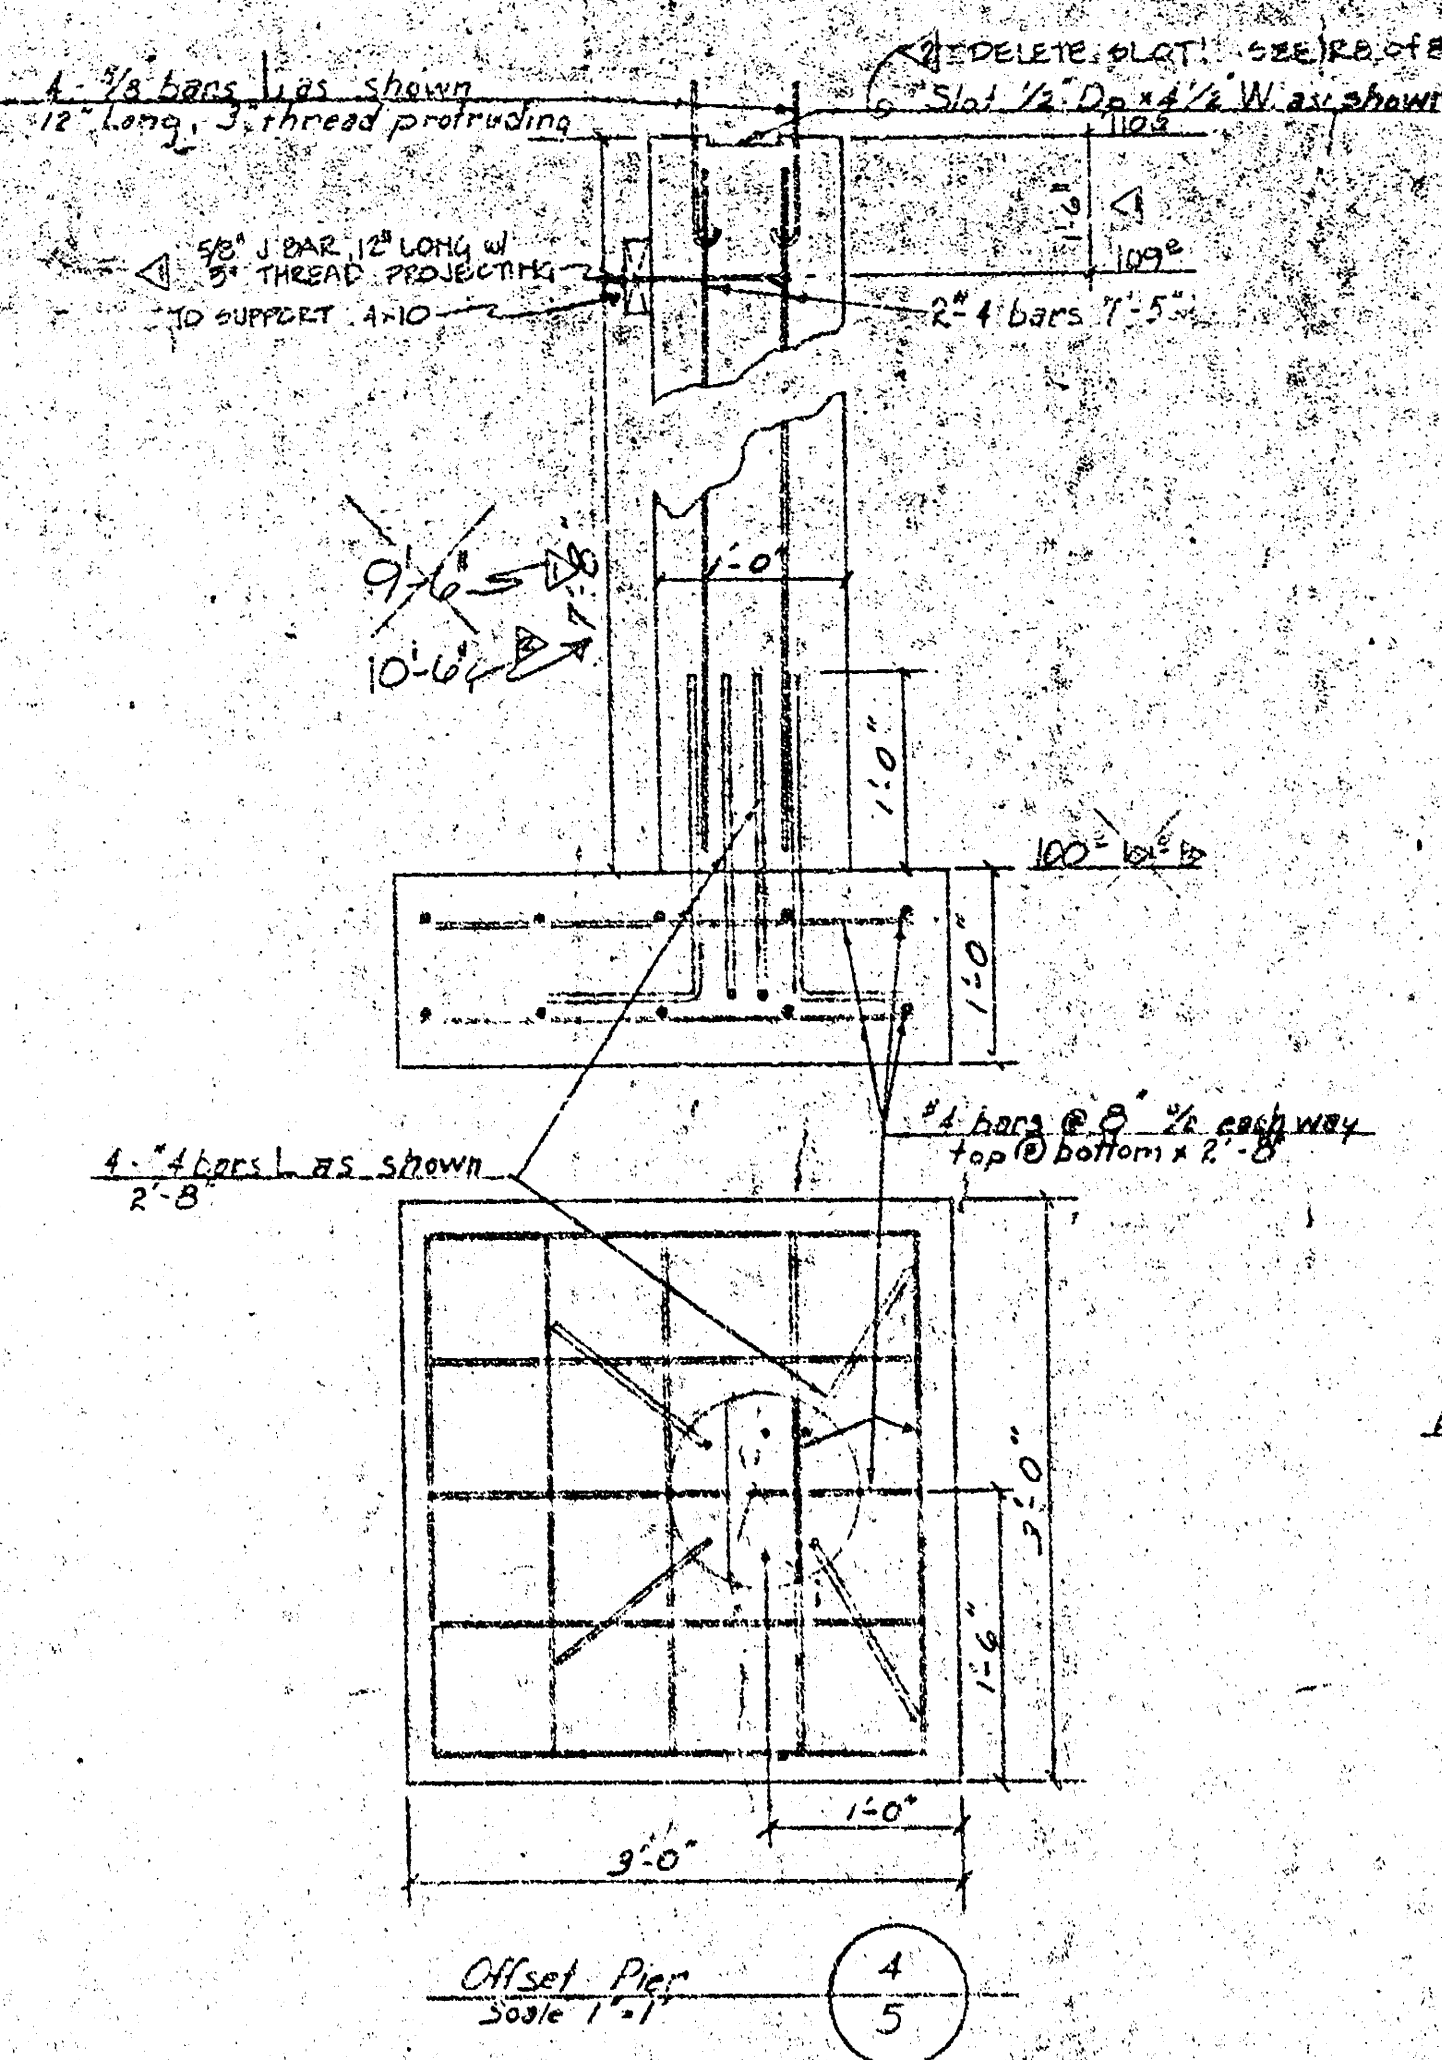



Notes: 1) concrete shall be composed of Portland Cement, fine and coarse aggregate, and water. Minimum cement shall be 100 lbs/cu yd. Maximum water-cement ratio shall be 0.50. Maximum water content, per volume of concrete, shall be 32%. Maximum coarse aggregate, when dry, shall be 1 1/2" maximum size. Maximum fines shall be 20%. Strengths shall be 4,000 psi 7 days/1,000 psi, 28 days/3,000 psi.

Bar reinforcement shall conform to the latest published requirements for #11 to #16w Bars for Concrete Reinforcements of Intermediate Grade, ASTM Designation A-63, Deformation of Reinforced Steel Bars of Concrete Reinforcement, ASTM Designation A-305.


Welded wire fabric for reinforcement shall conform to the latest published requirements of the Standard Specifications for Welded Steel Wire Fabric for Concrete Reinforcement, ASTM Designation A-185.

MCCALEB ENGINEERING EDMOND, OKLAHOMA		Date _____ Title _____ Rev. _____
 MARINA		
DETAIL SHEET		Drawing No. 5 of 8


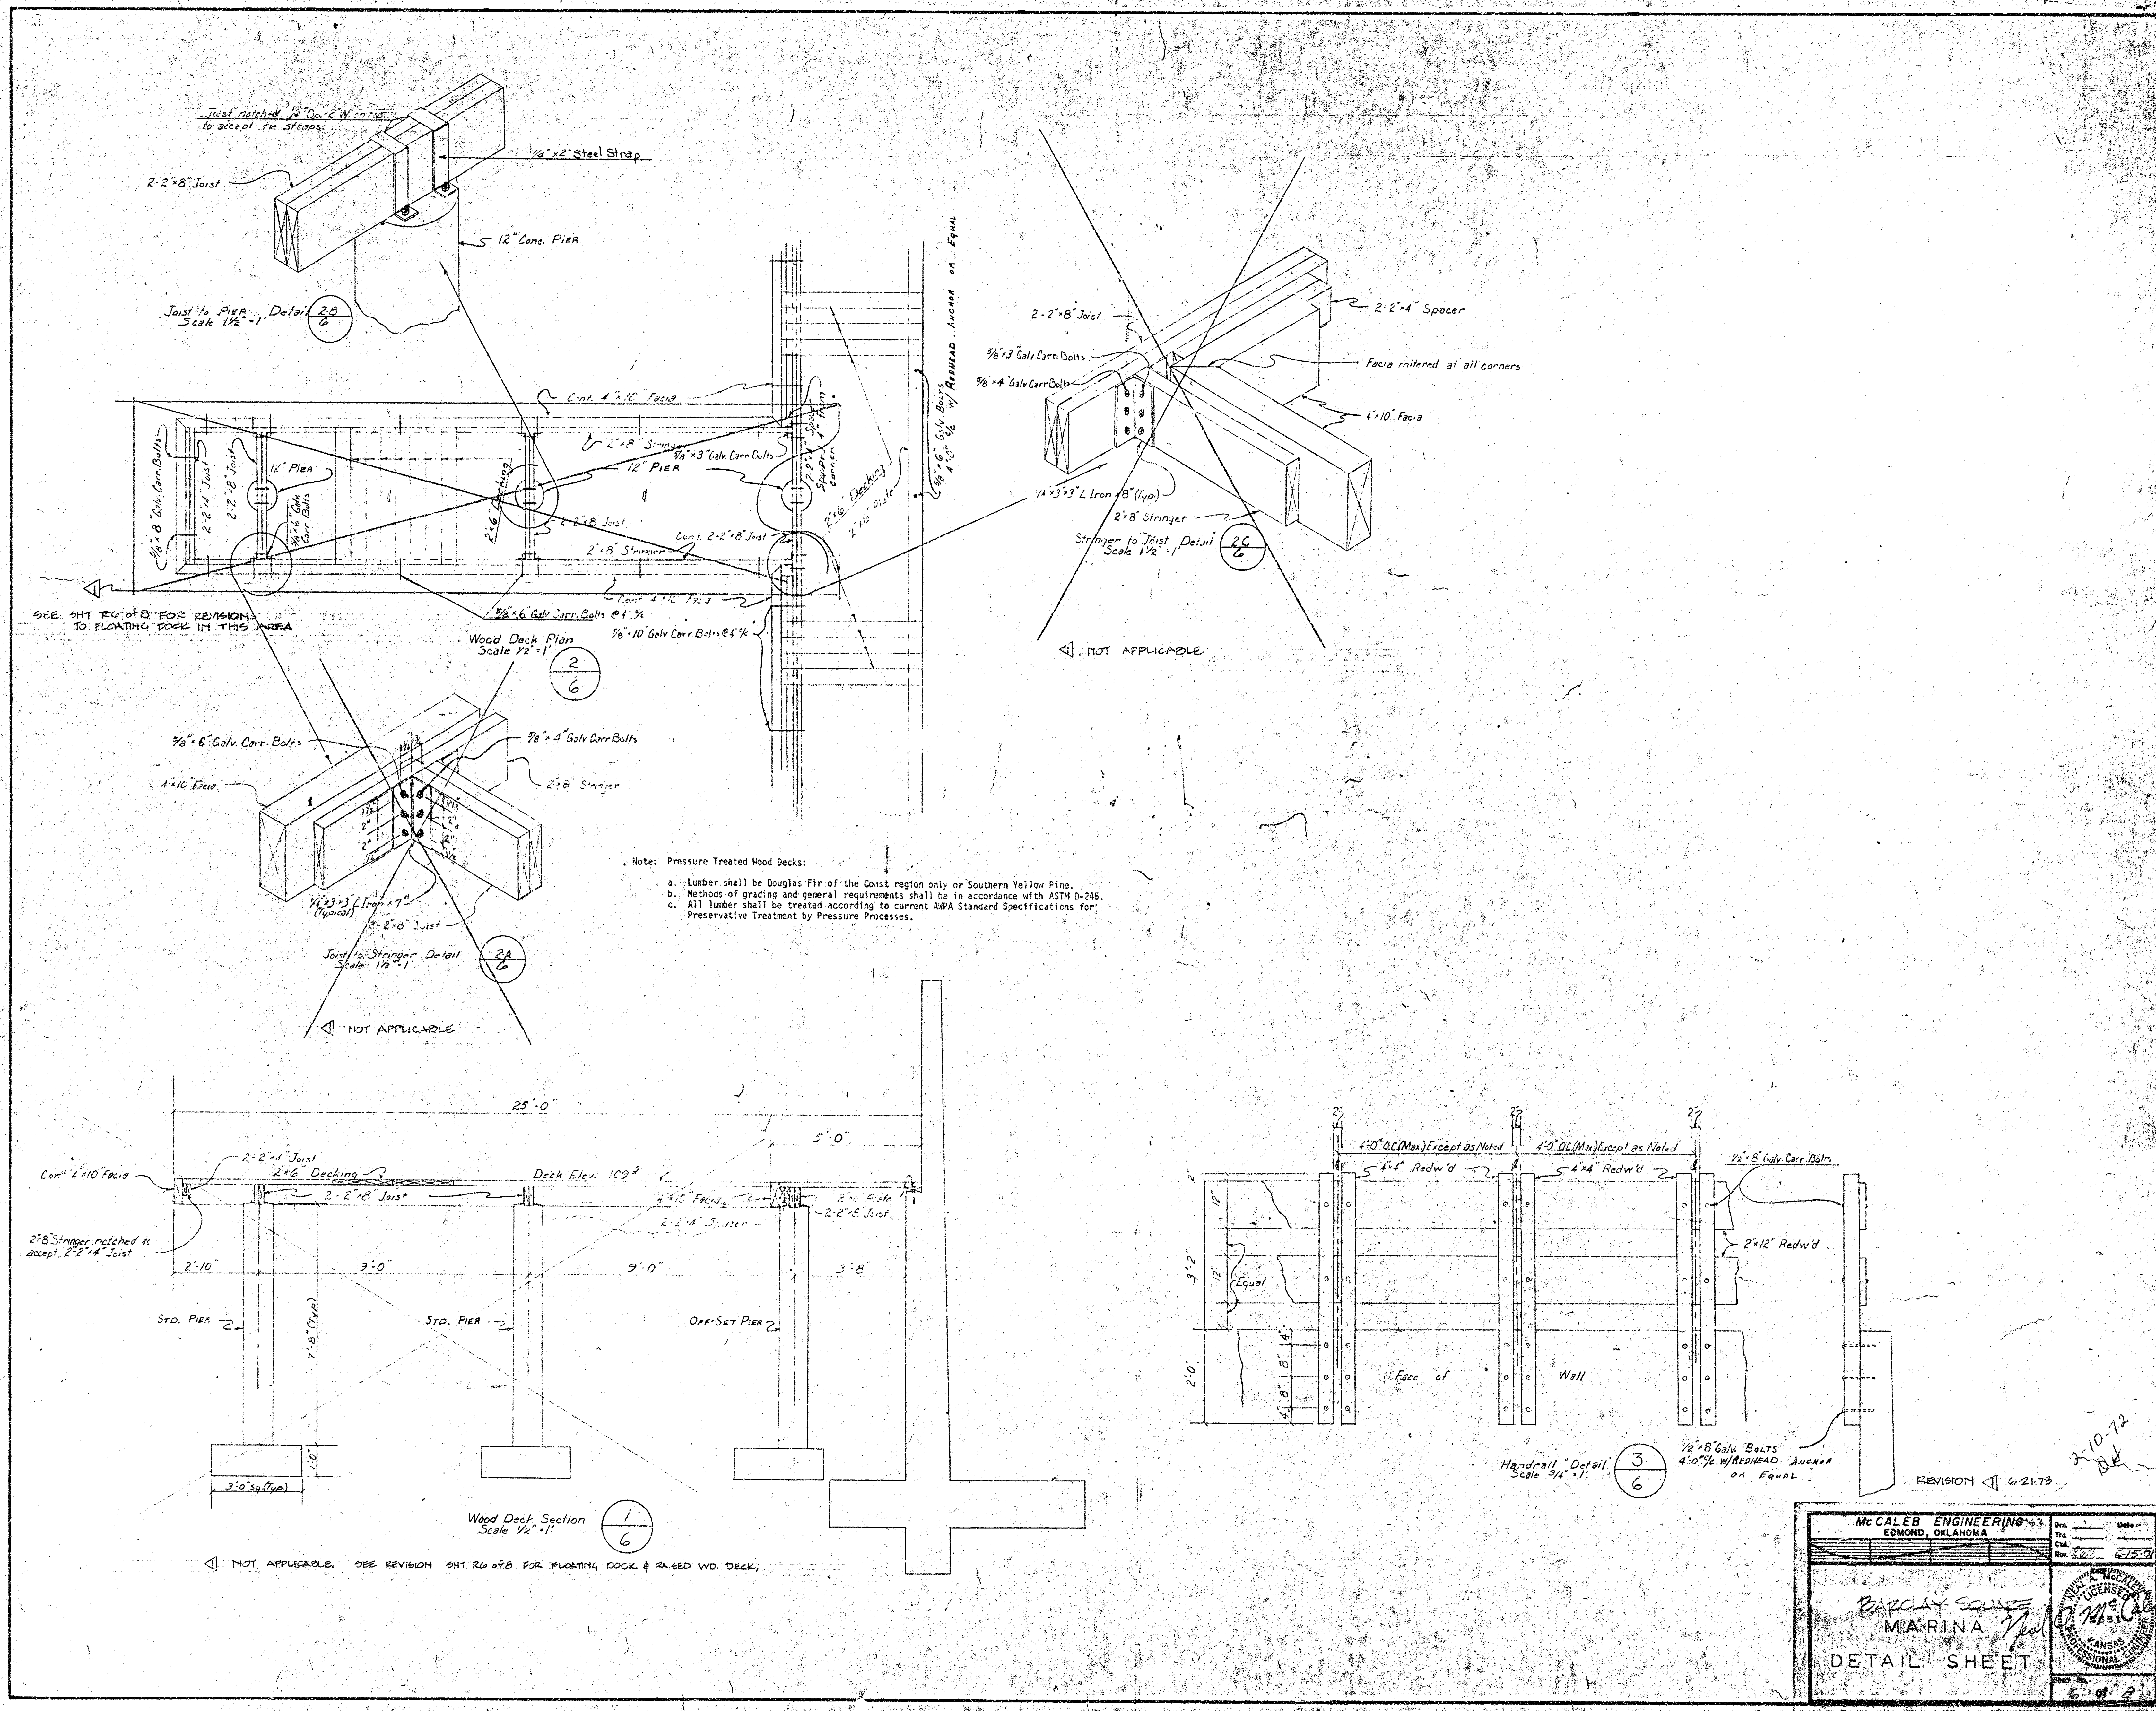


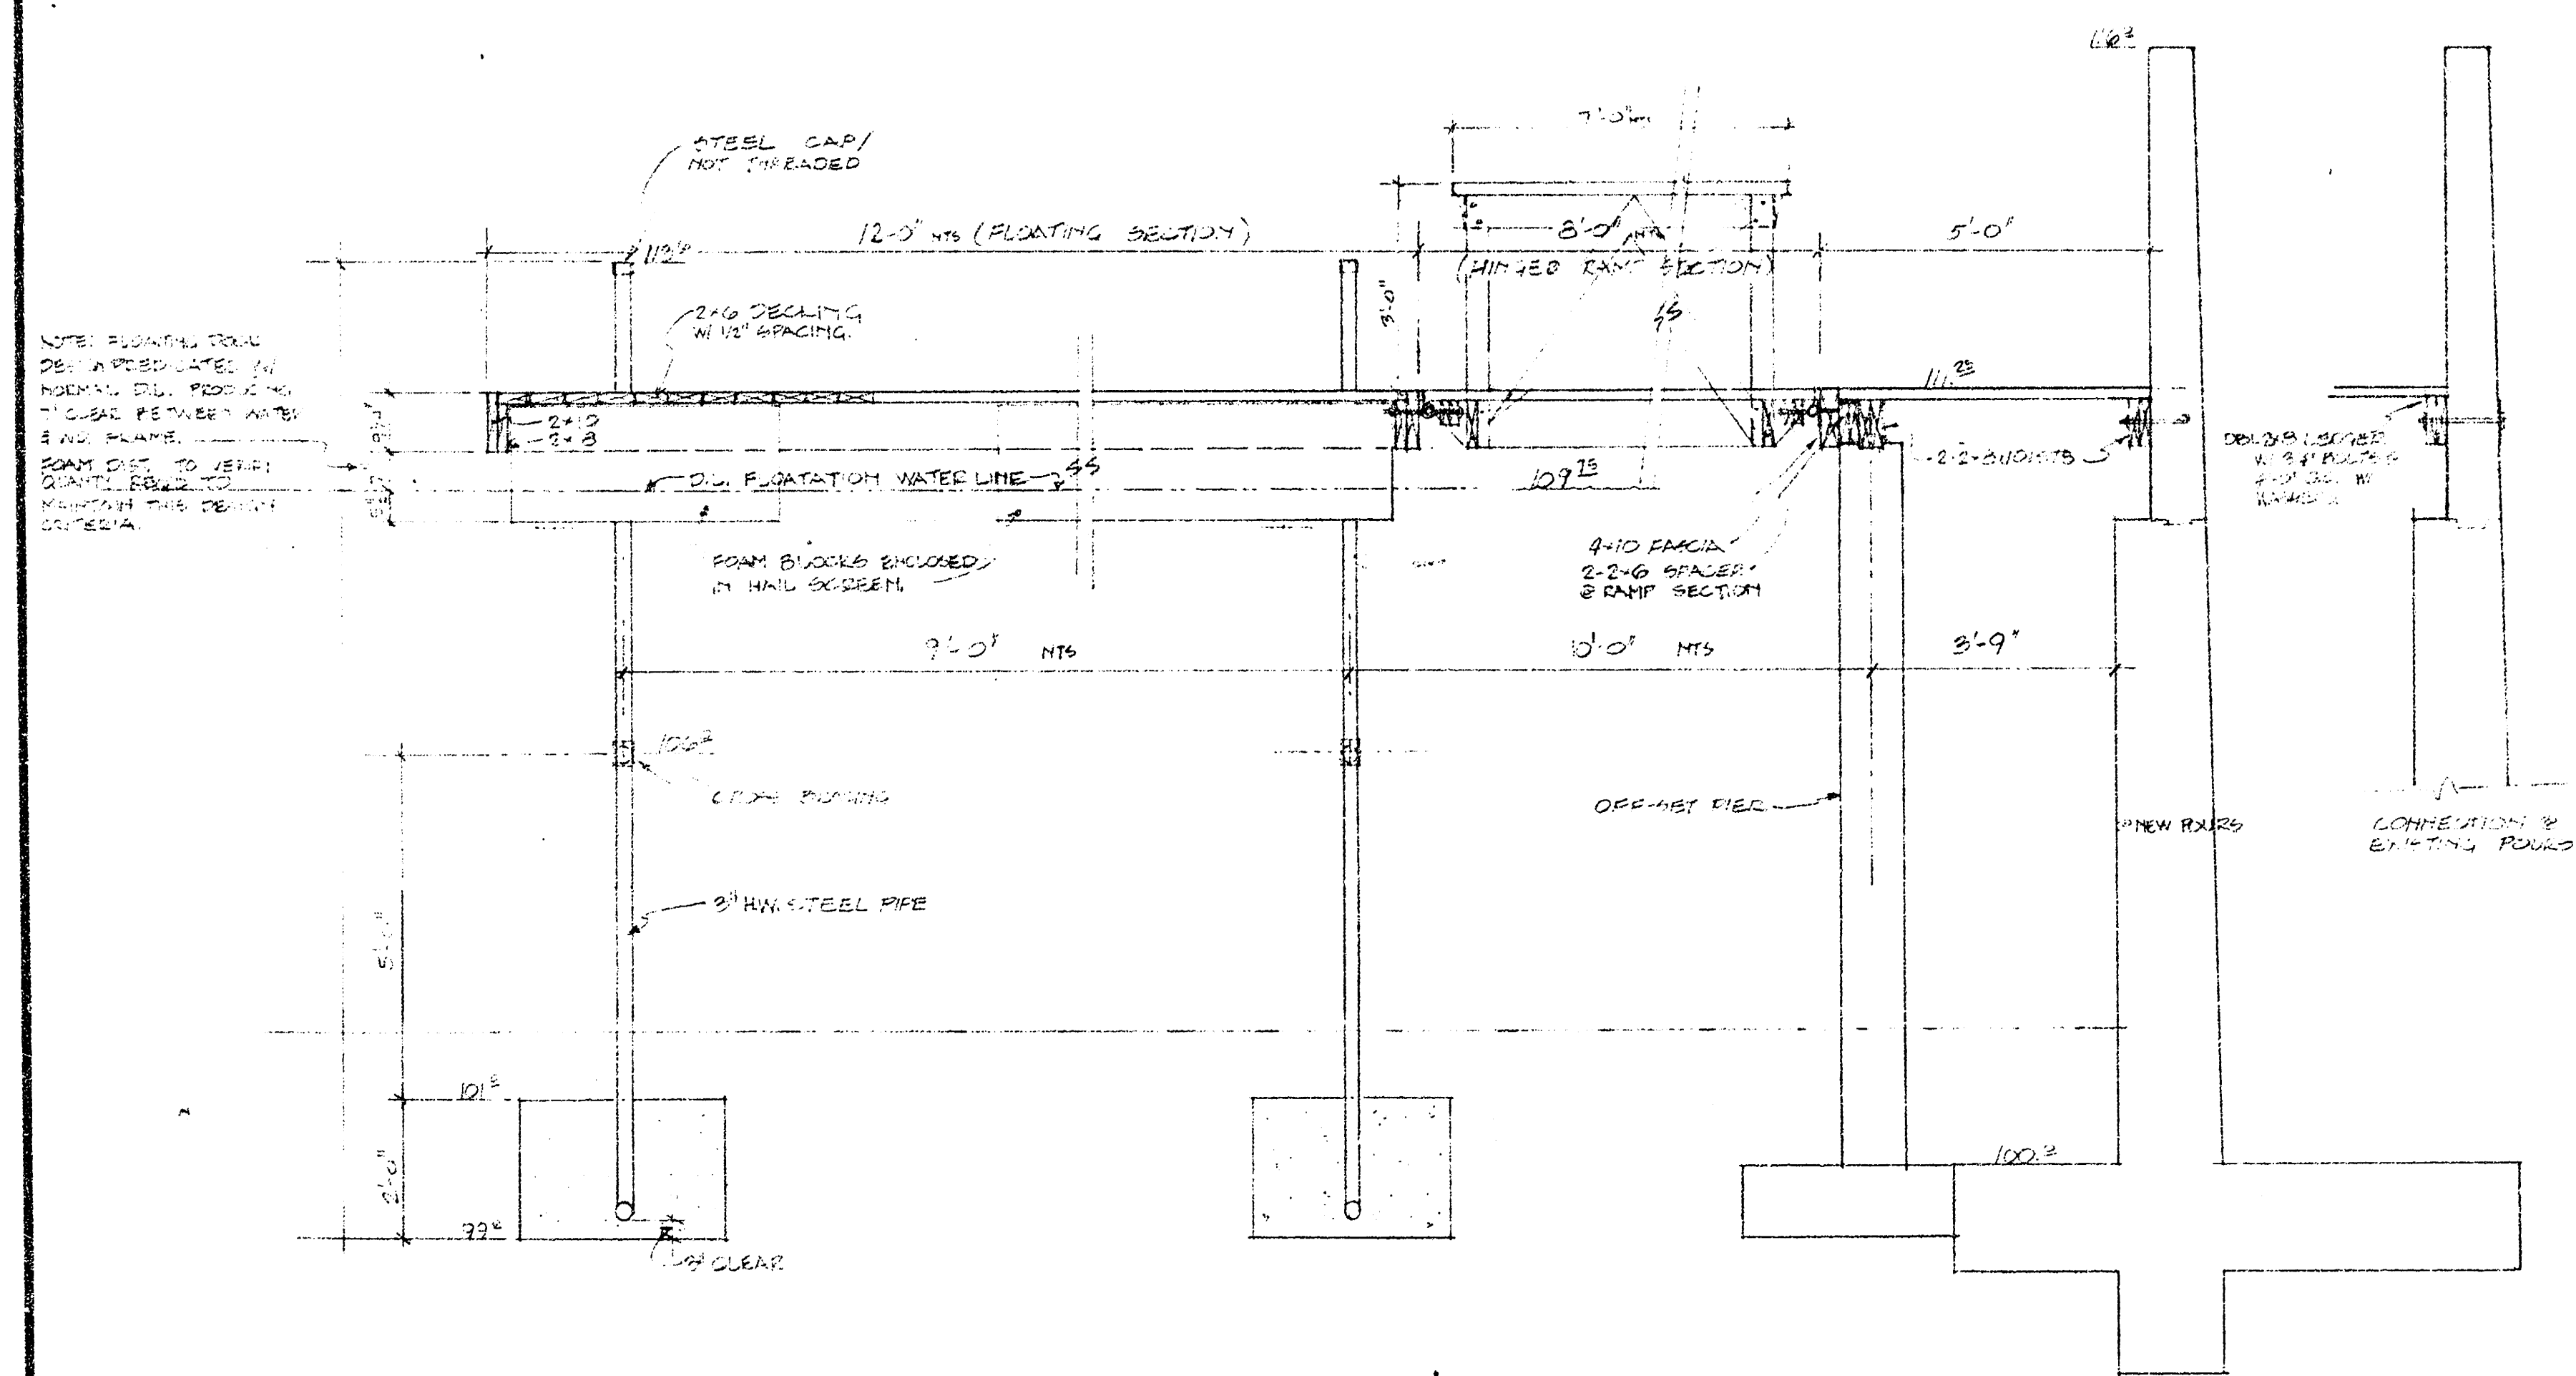

JACK P. DE BOER ASSOCIATES, INC.
P.O. BOX 18387 WICHITA, KANSAS 67218
(316) 693-2831

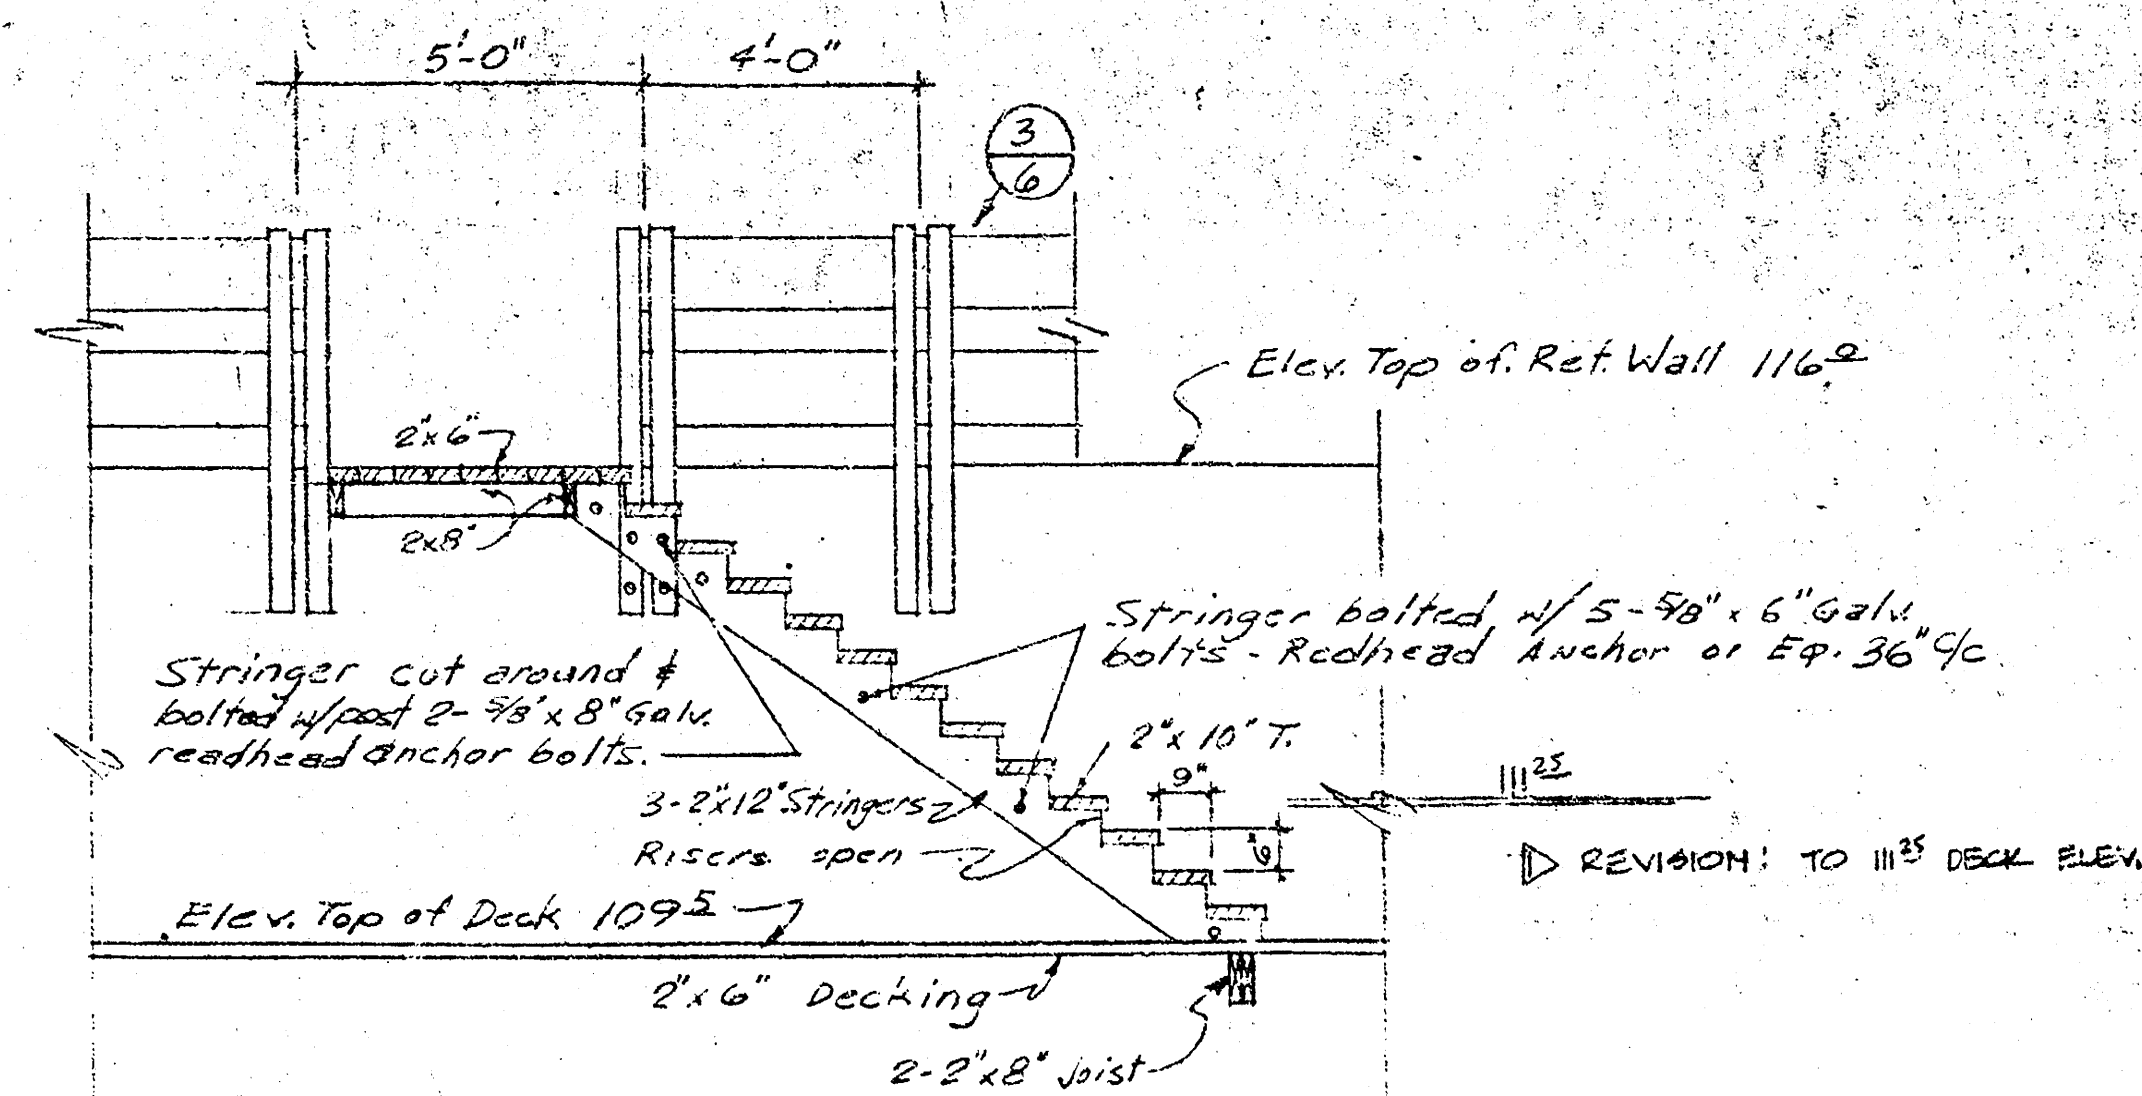


STAIR SECTION "X-X"

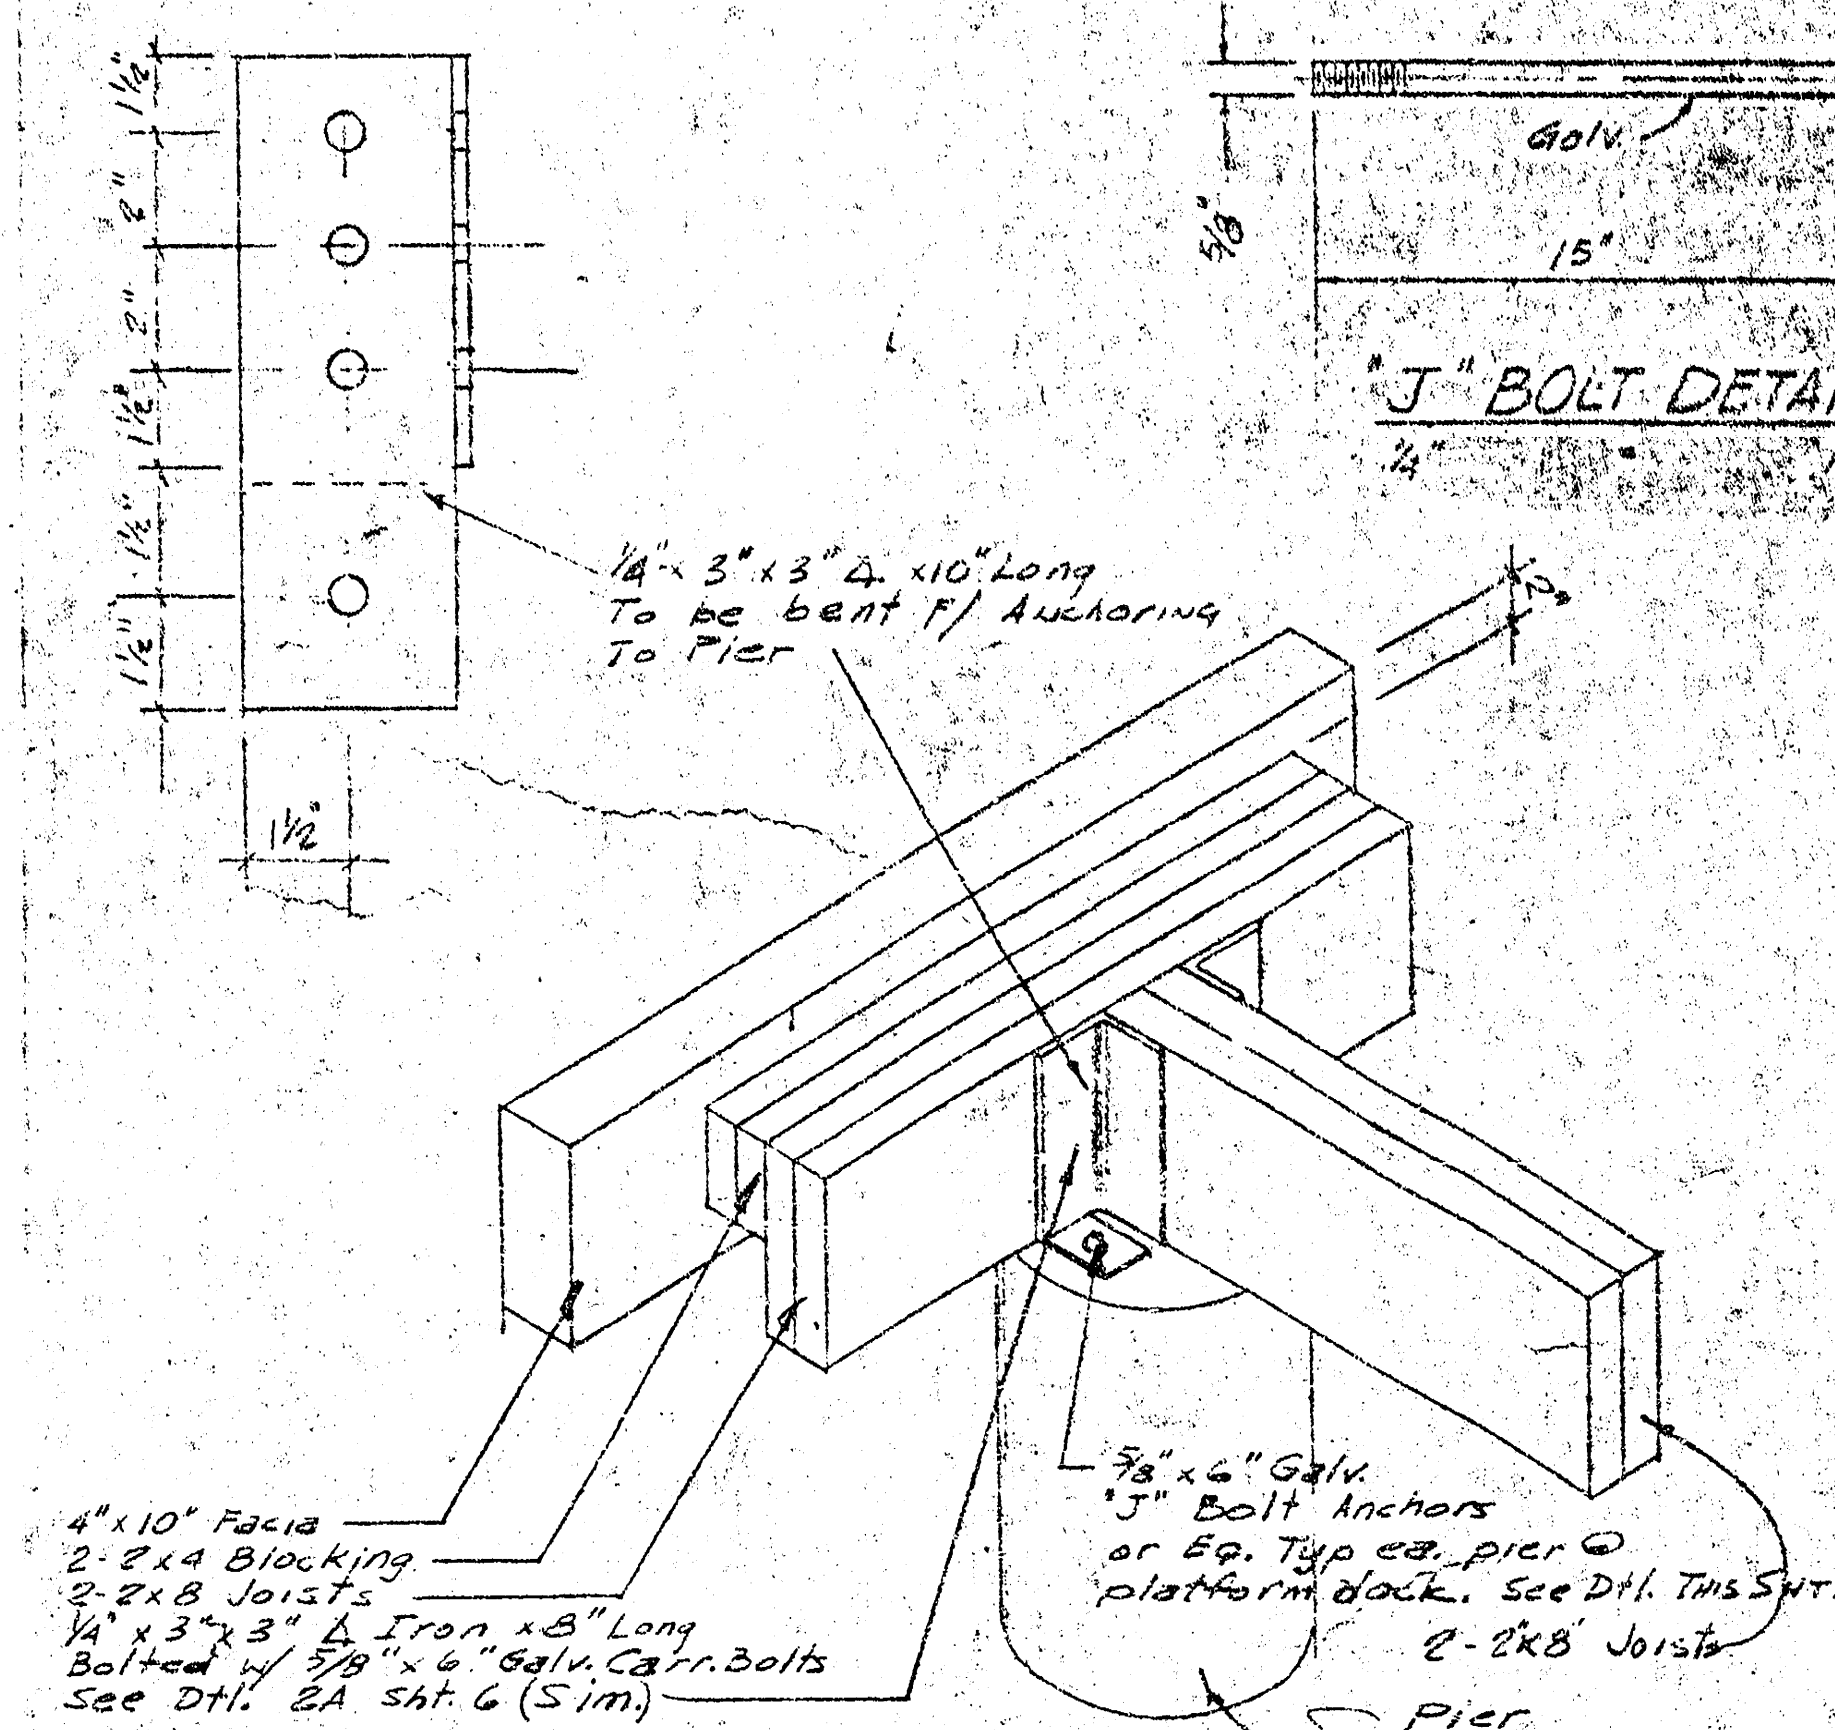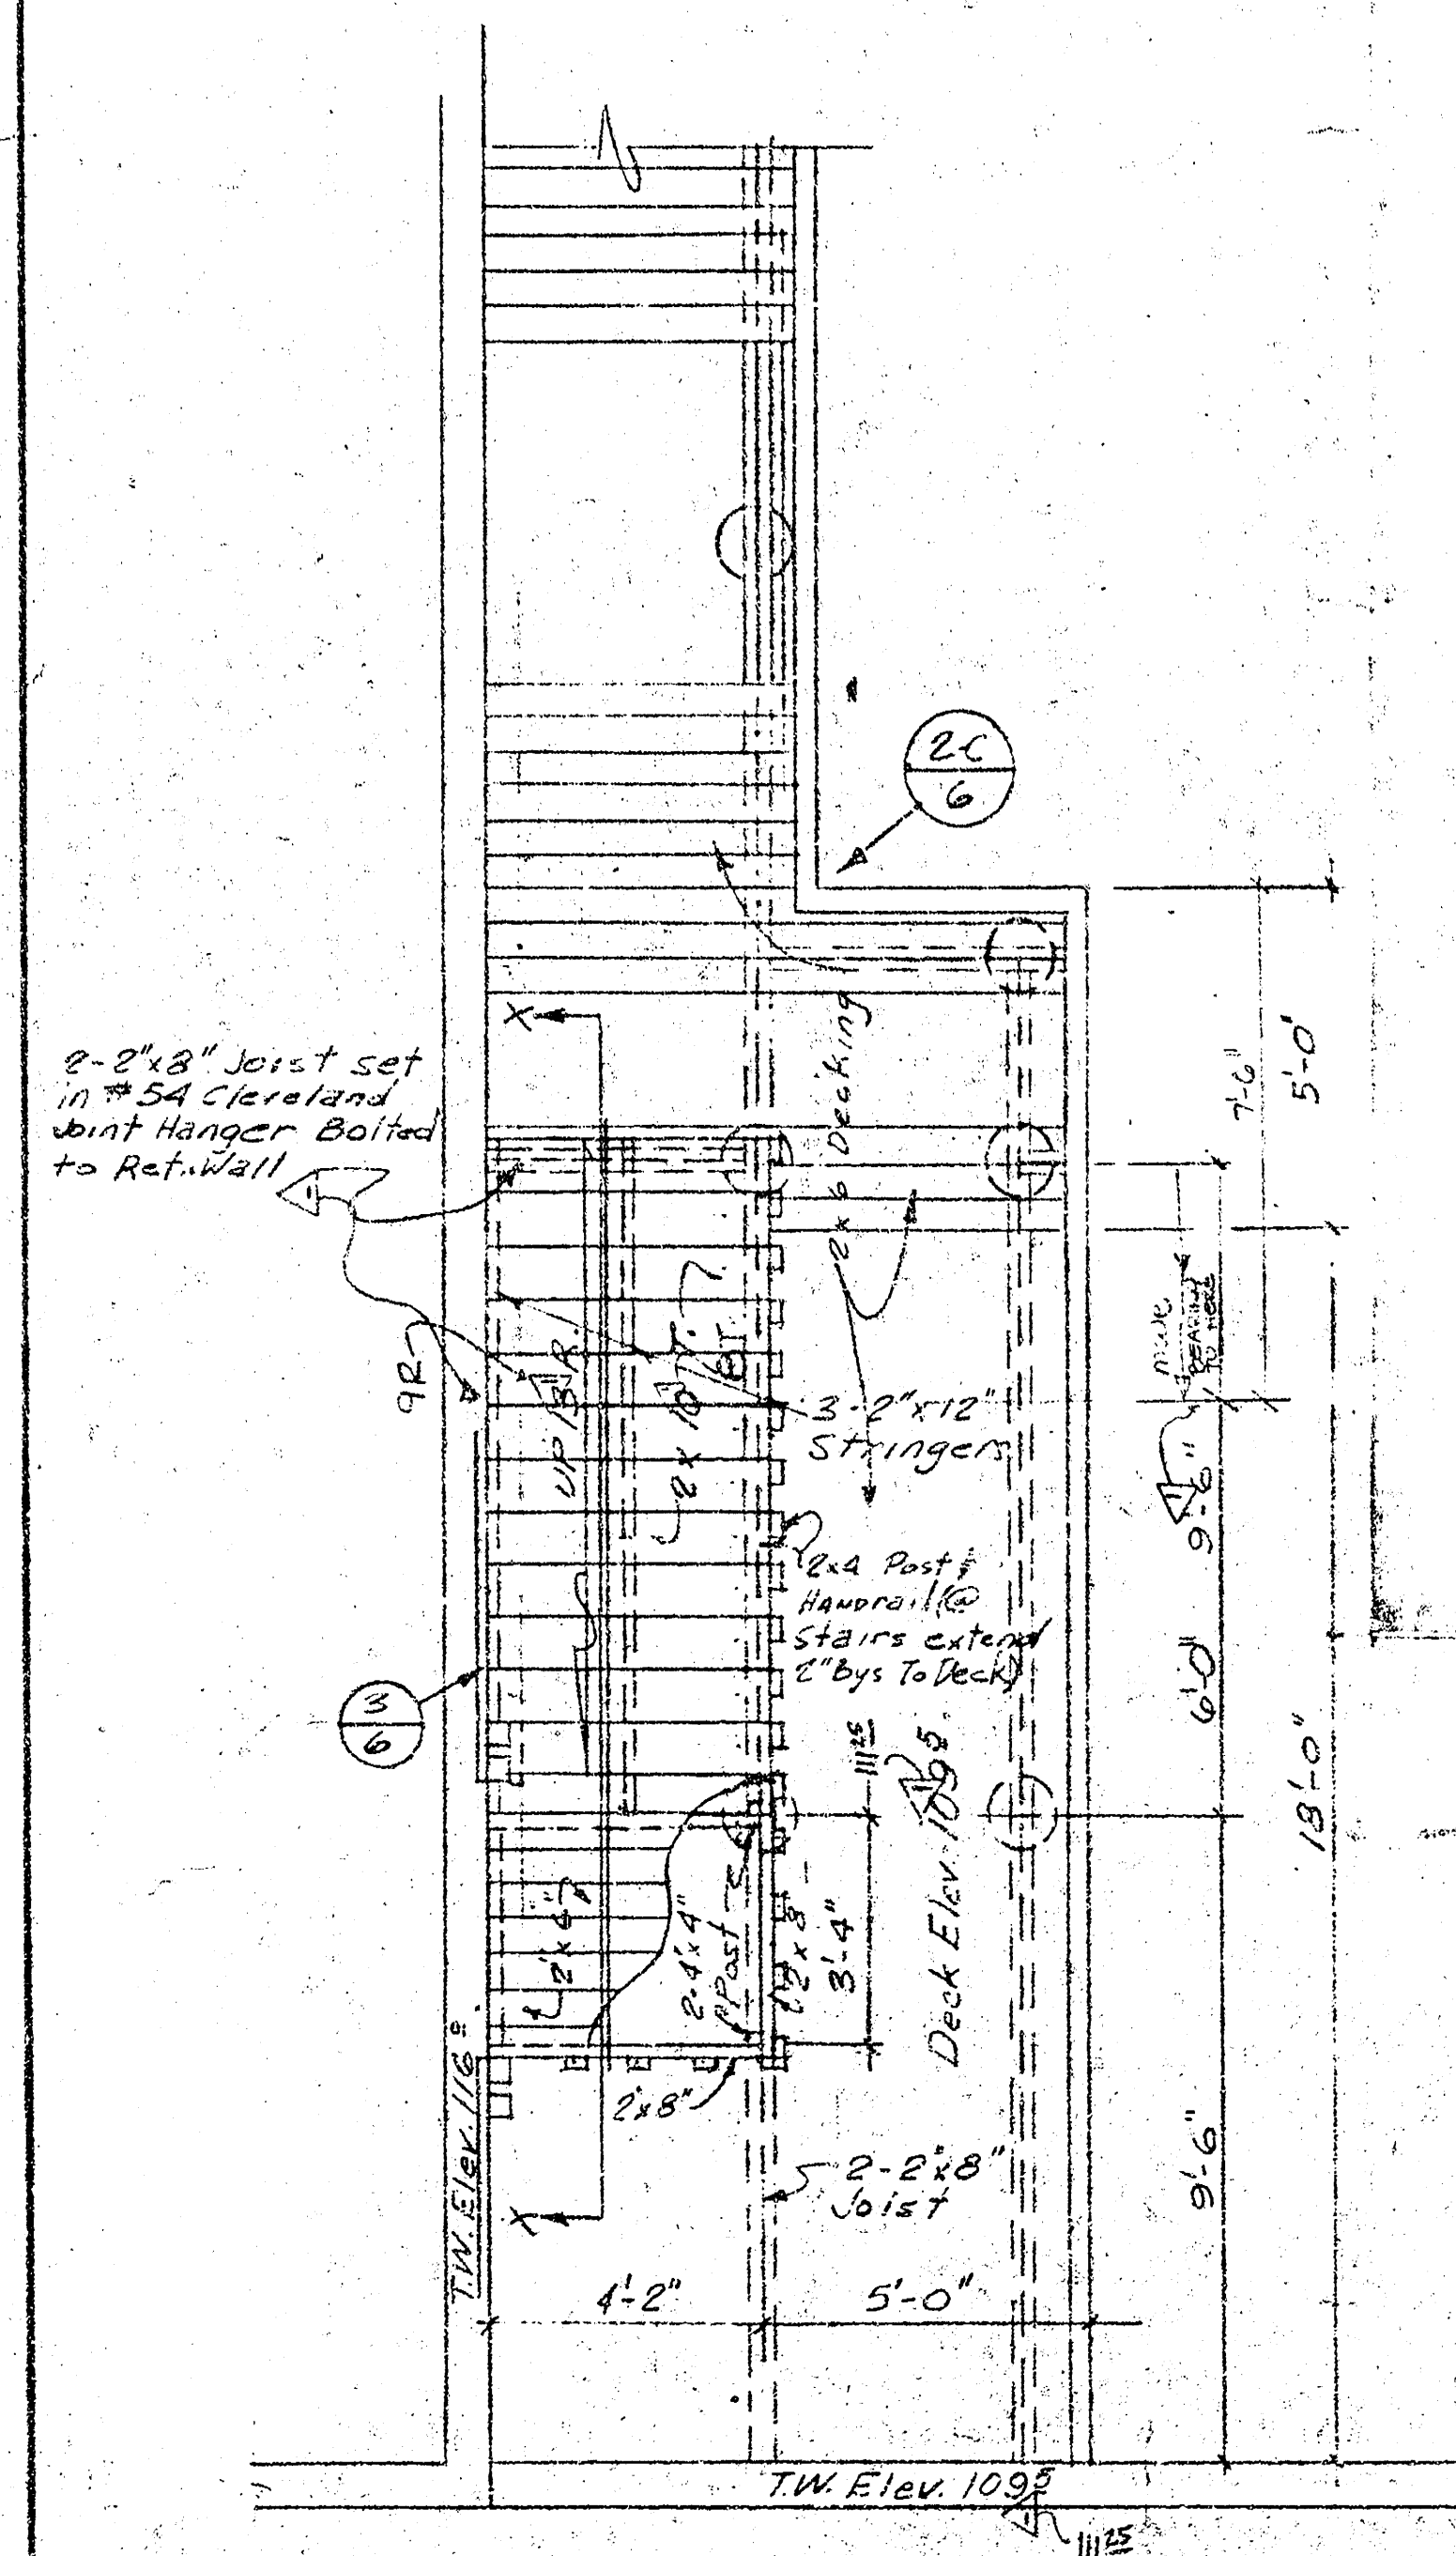


DETAIL "Y" DOES NOT OCCUR



McCALEB ENGINEERING EDMOND, OKLAHOMA		Date
Drawn	Checked	9-10-72
Revised	Approved	
MARLEY SQUARE MARINA		
DETAIL SHEET		
7 of 8		

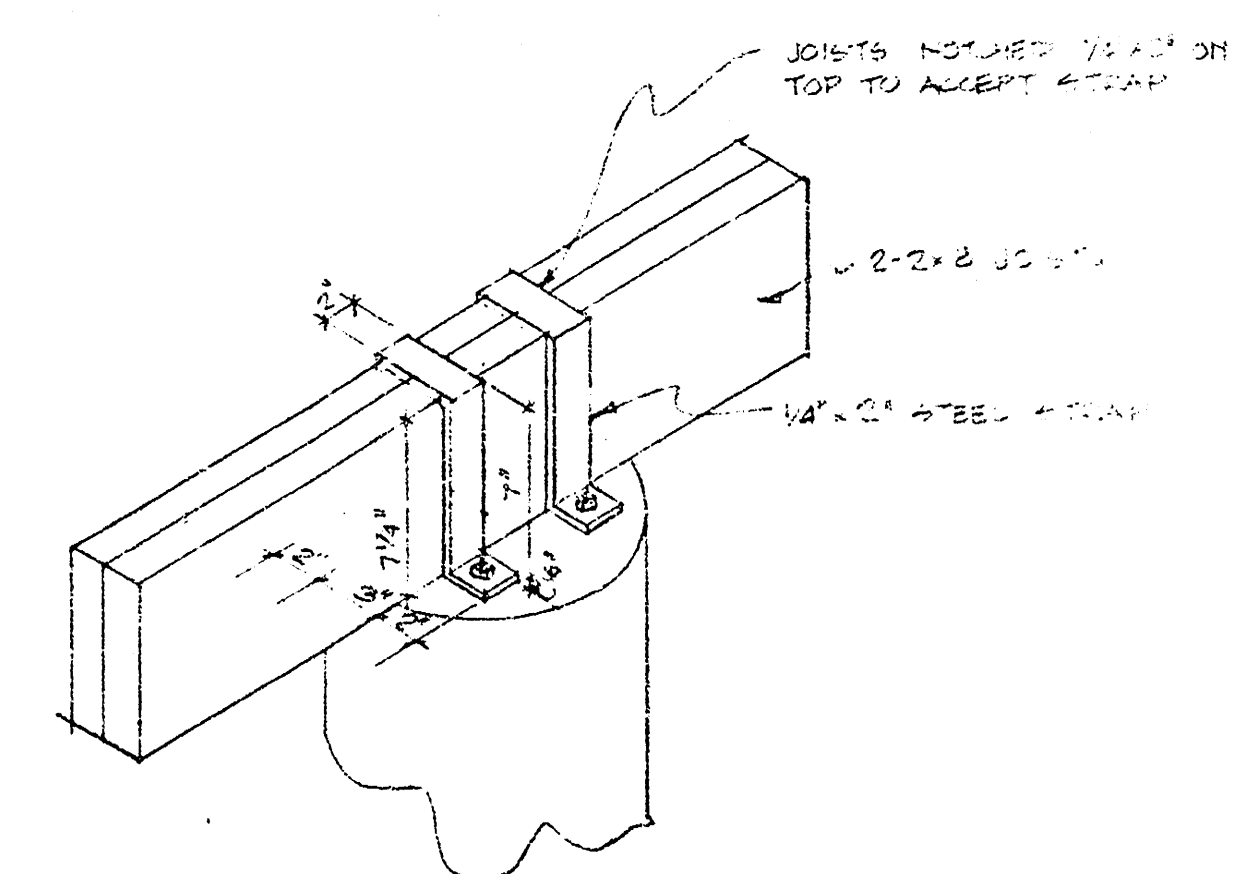

ISOMETRIC VIEW COLUMN TOP STEEP CONNECTION
K₁ = 1.0

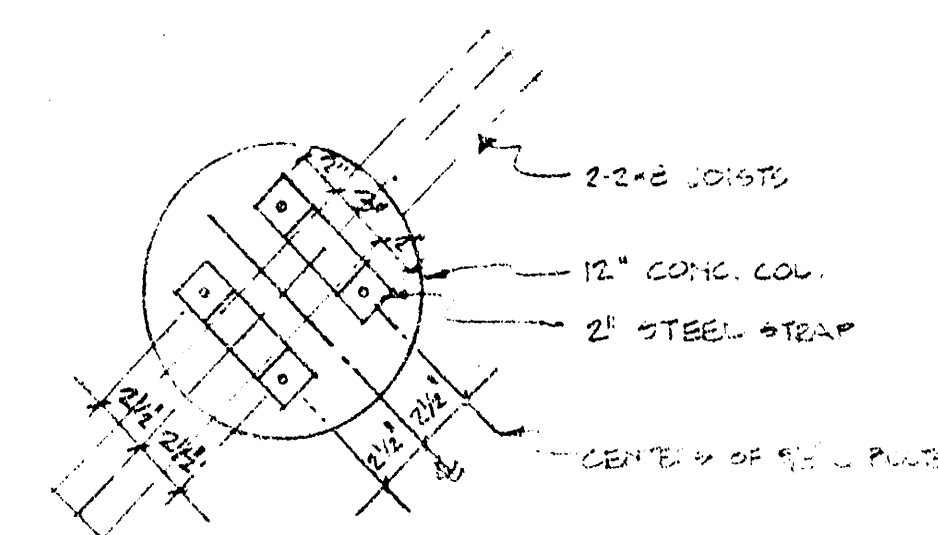

PLAN VIEW COLUMN TOP STRAP CONN.
1/2" = 1'-0"

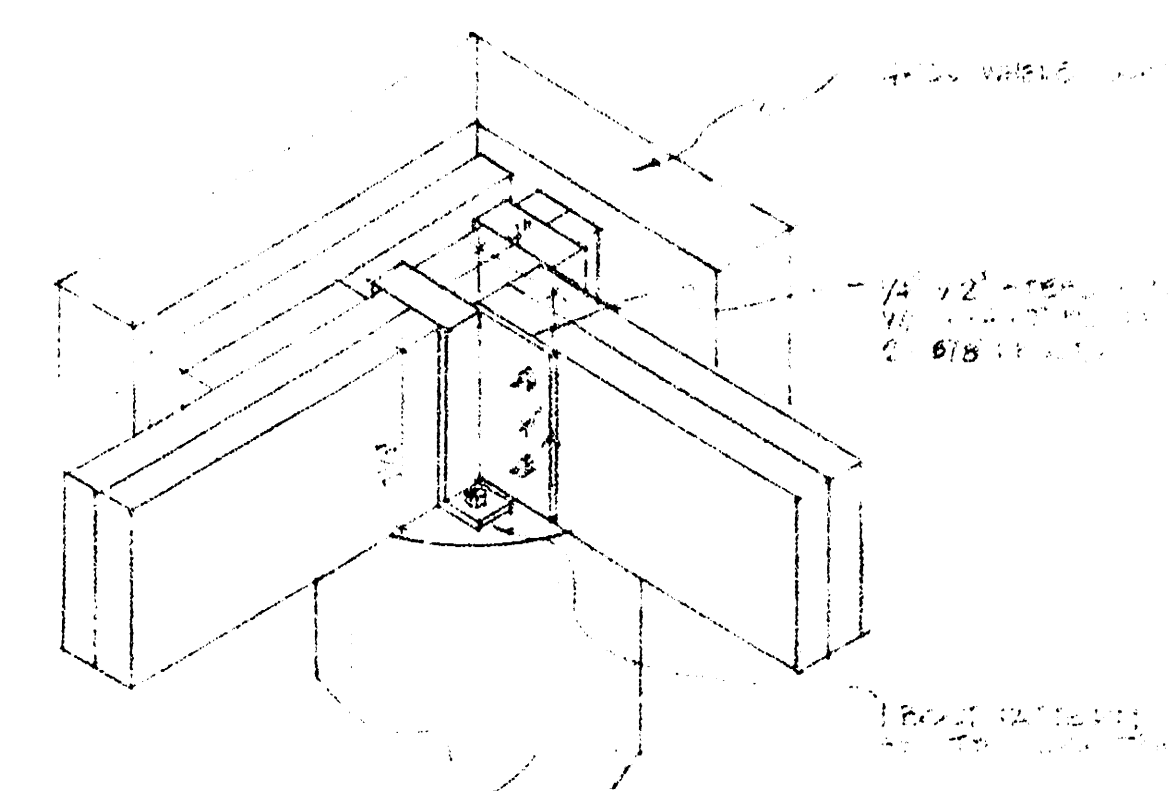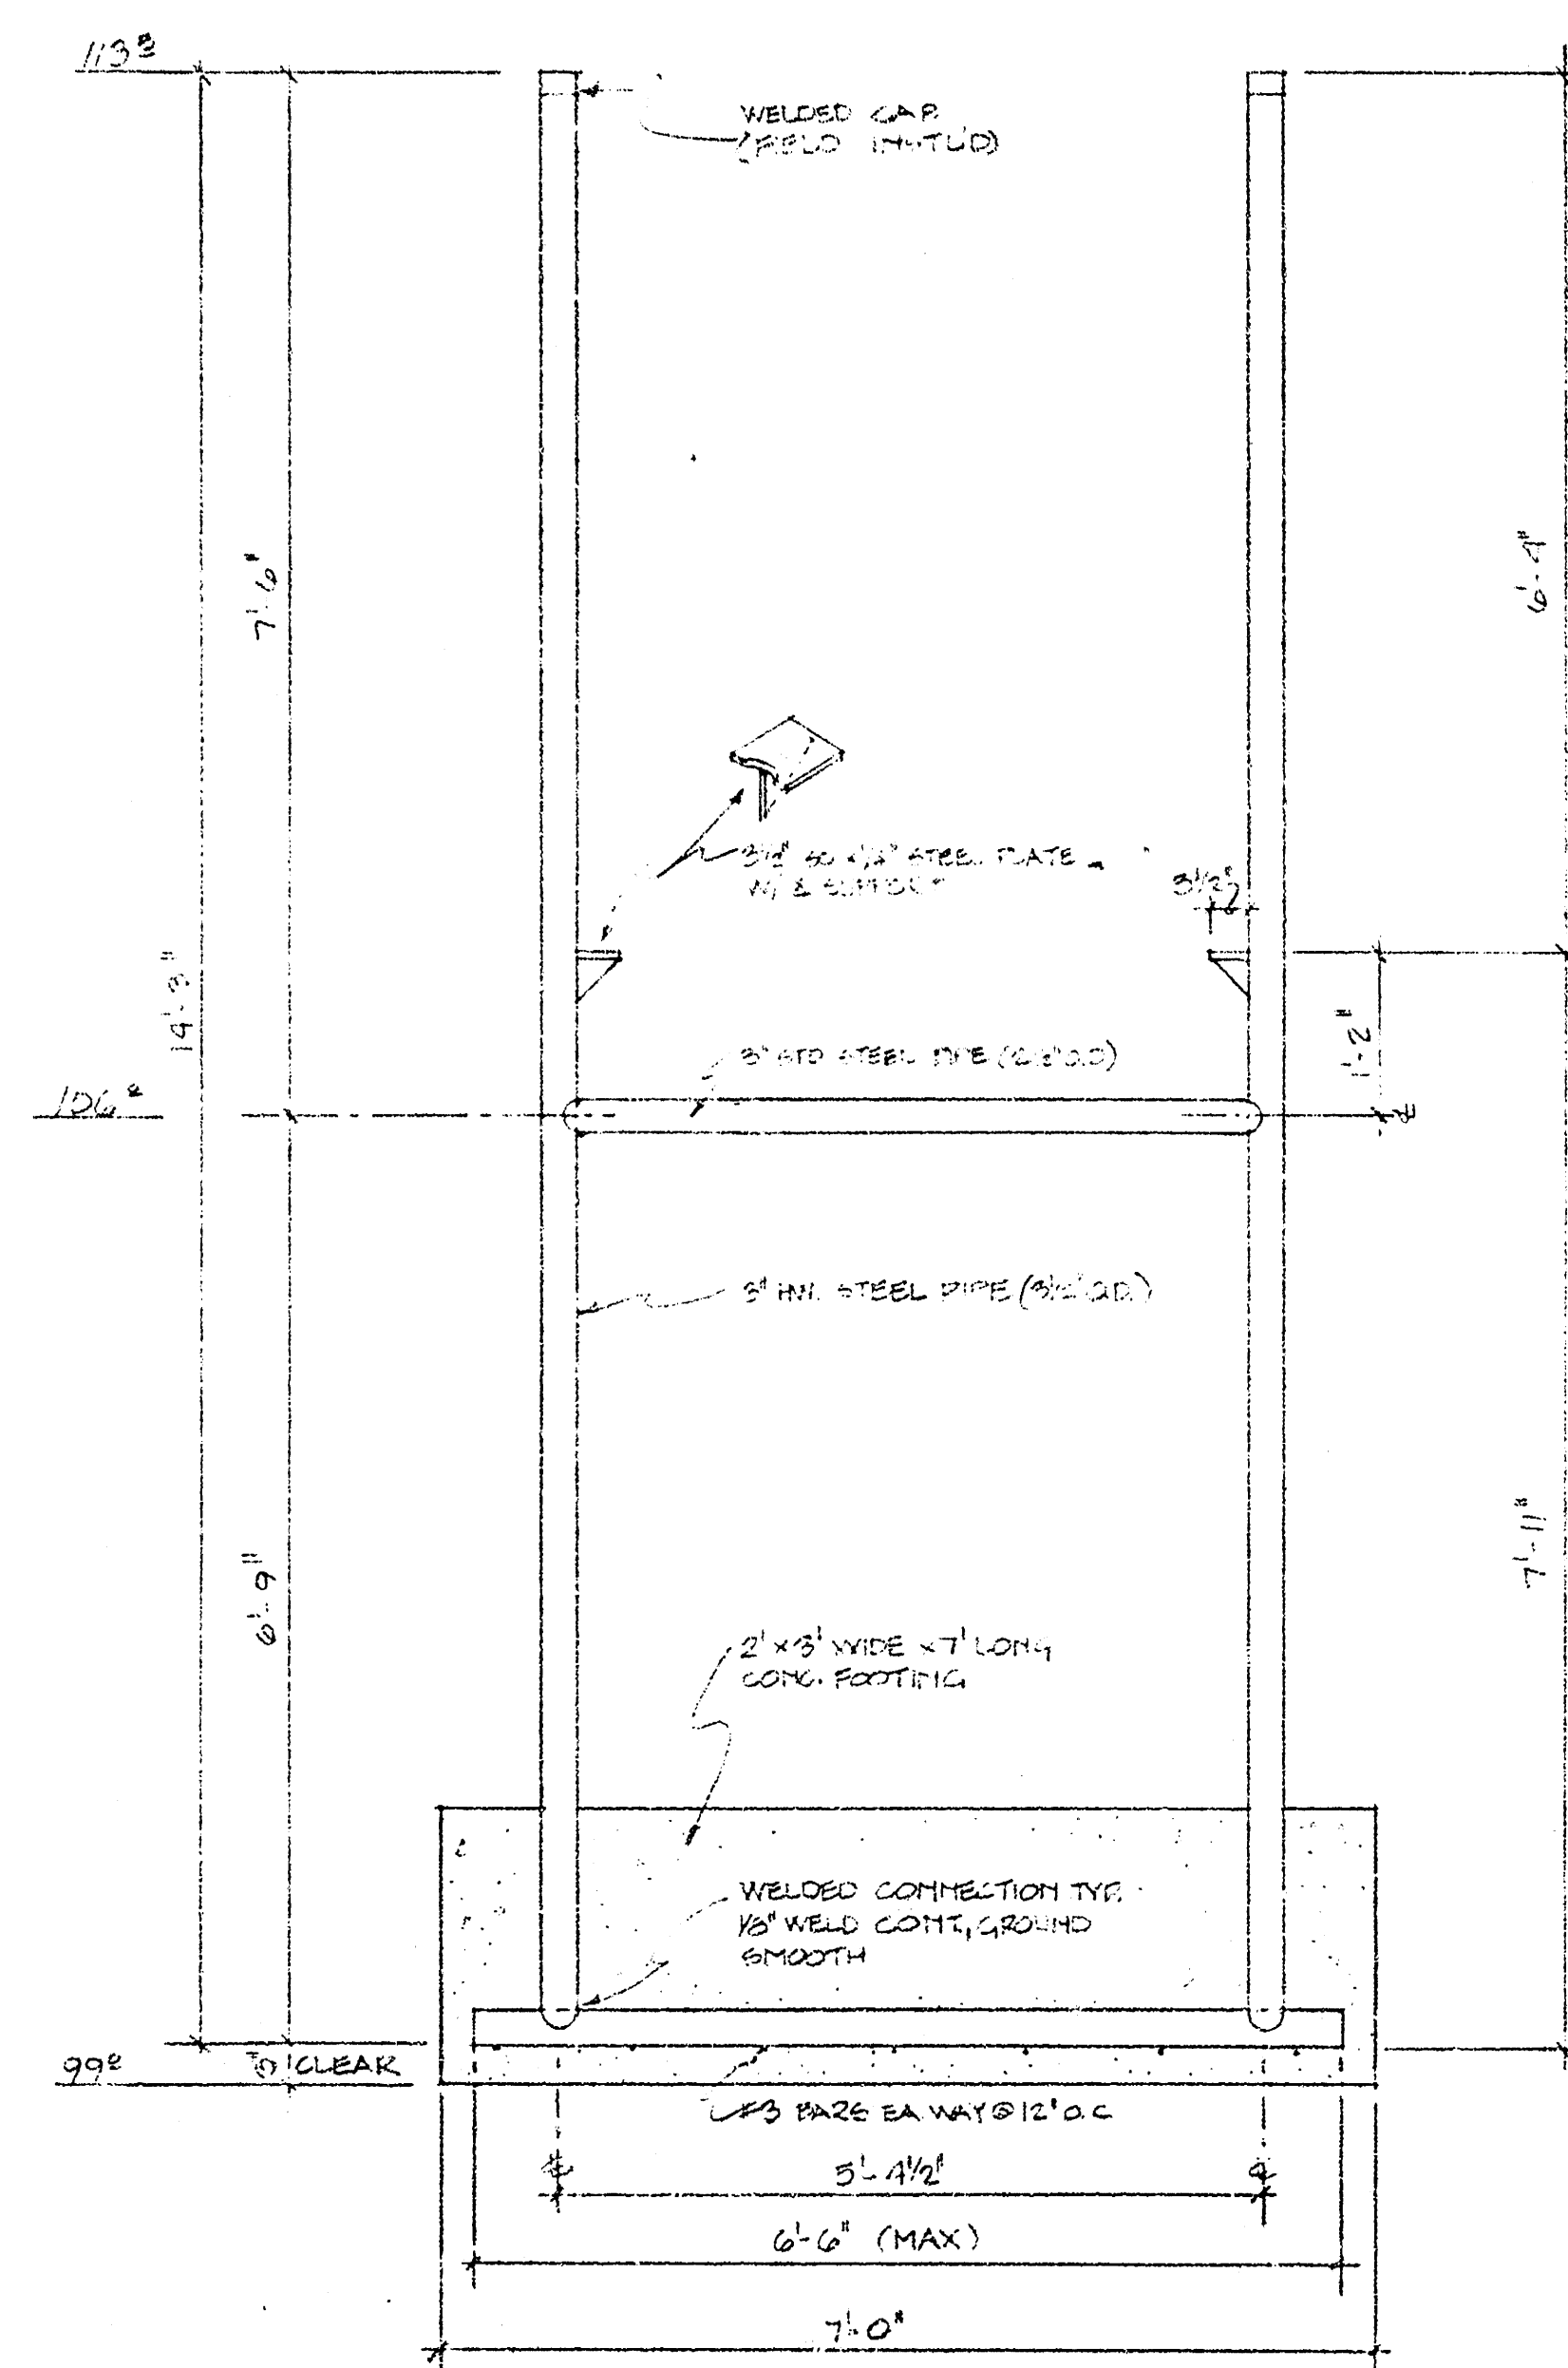


APPROVAL:

SACK & BORNHORN ASSOCIATES, INC.


ASSOCIATES, INC.

JACK P. DEER

DATE REVISION BY

DATE

DRAWN

CHKD

ISSUE

SHEET NO.

150-2

DE SHYS