



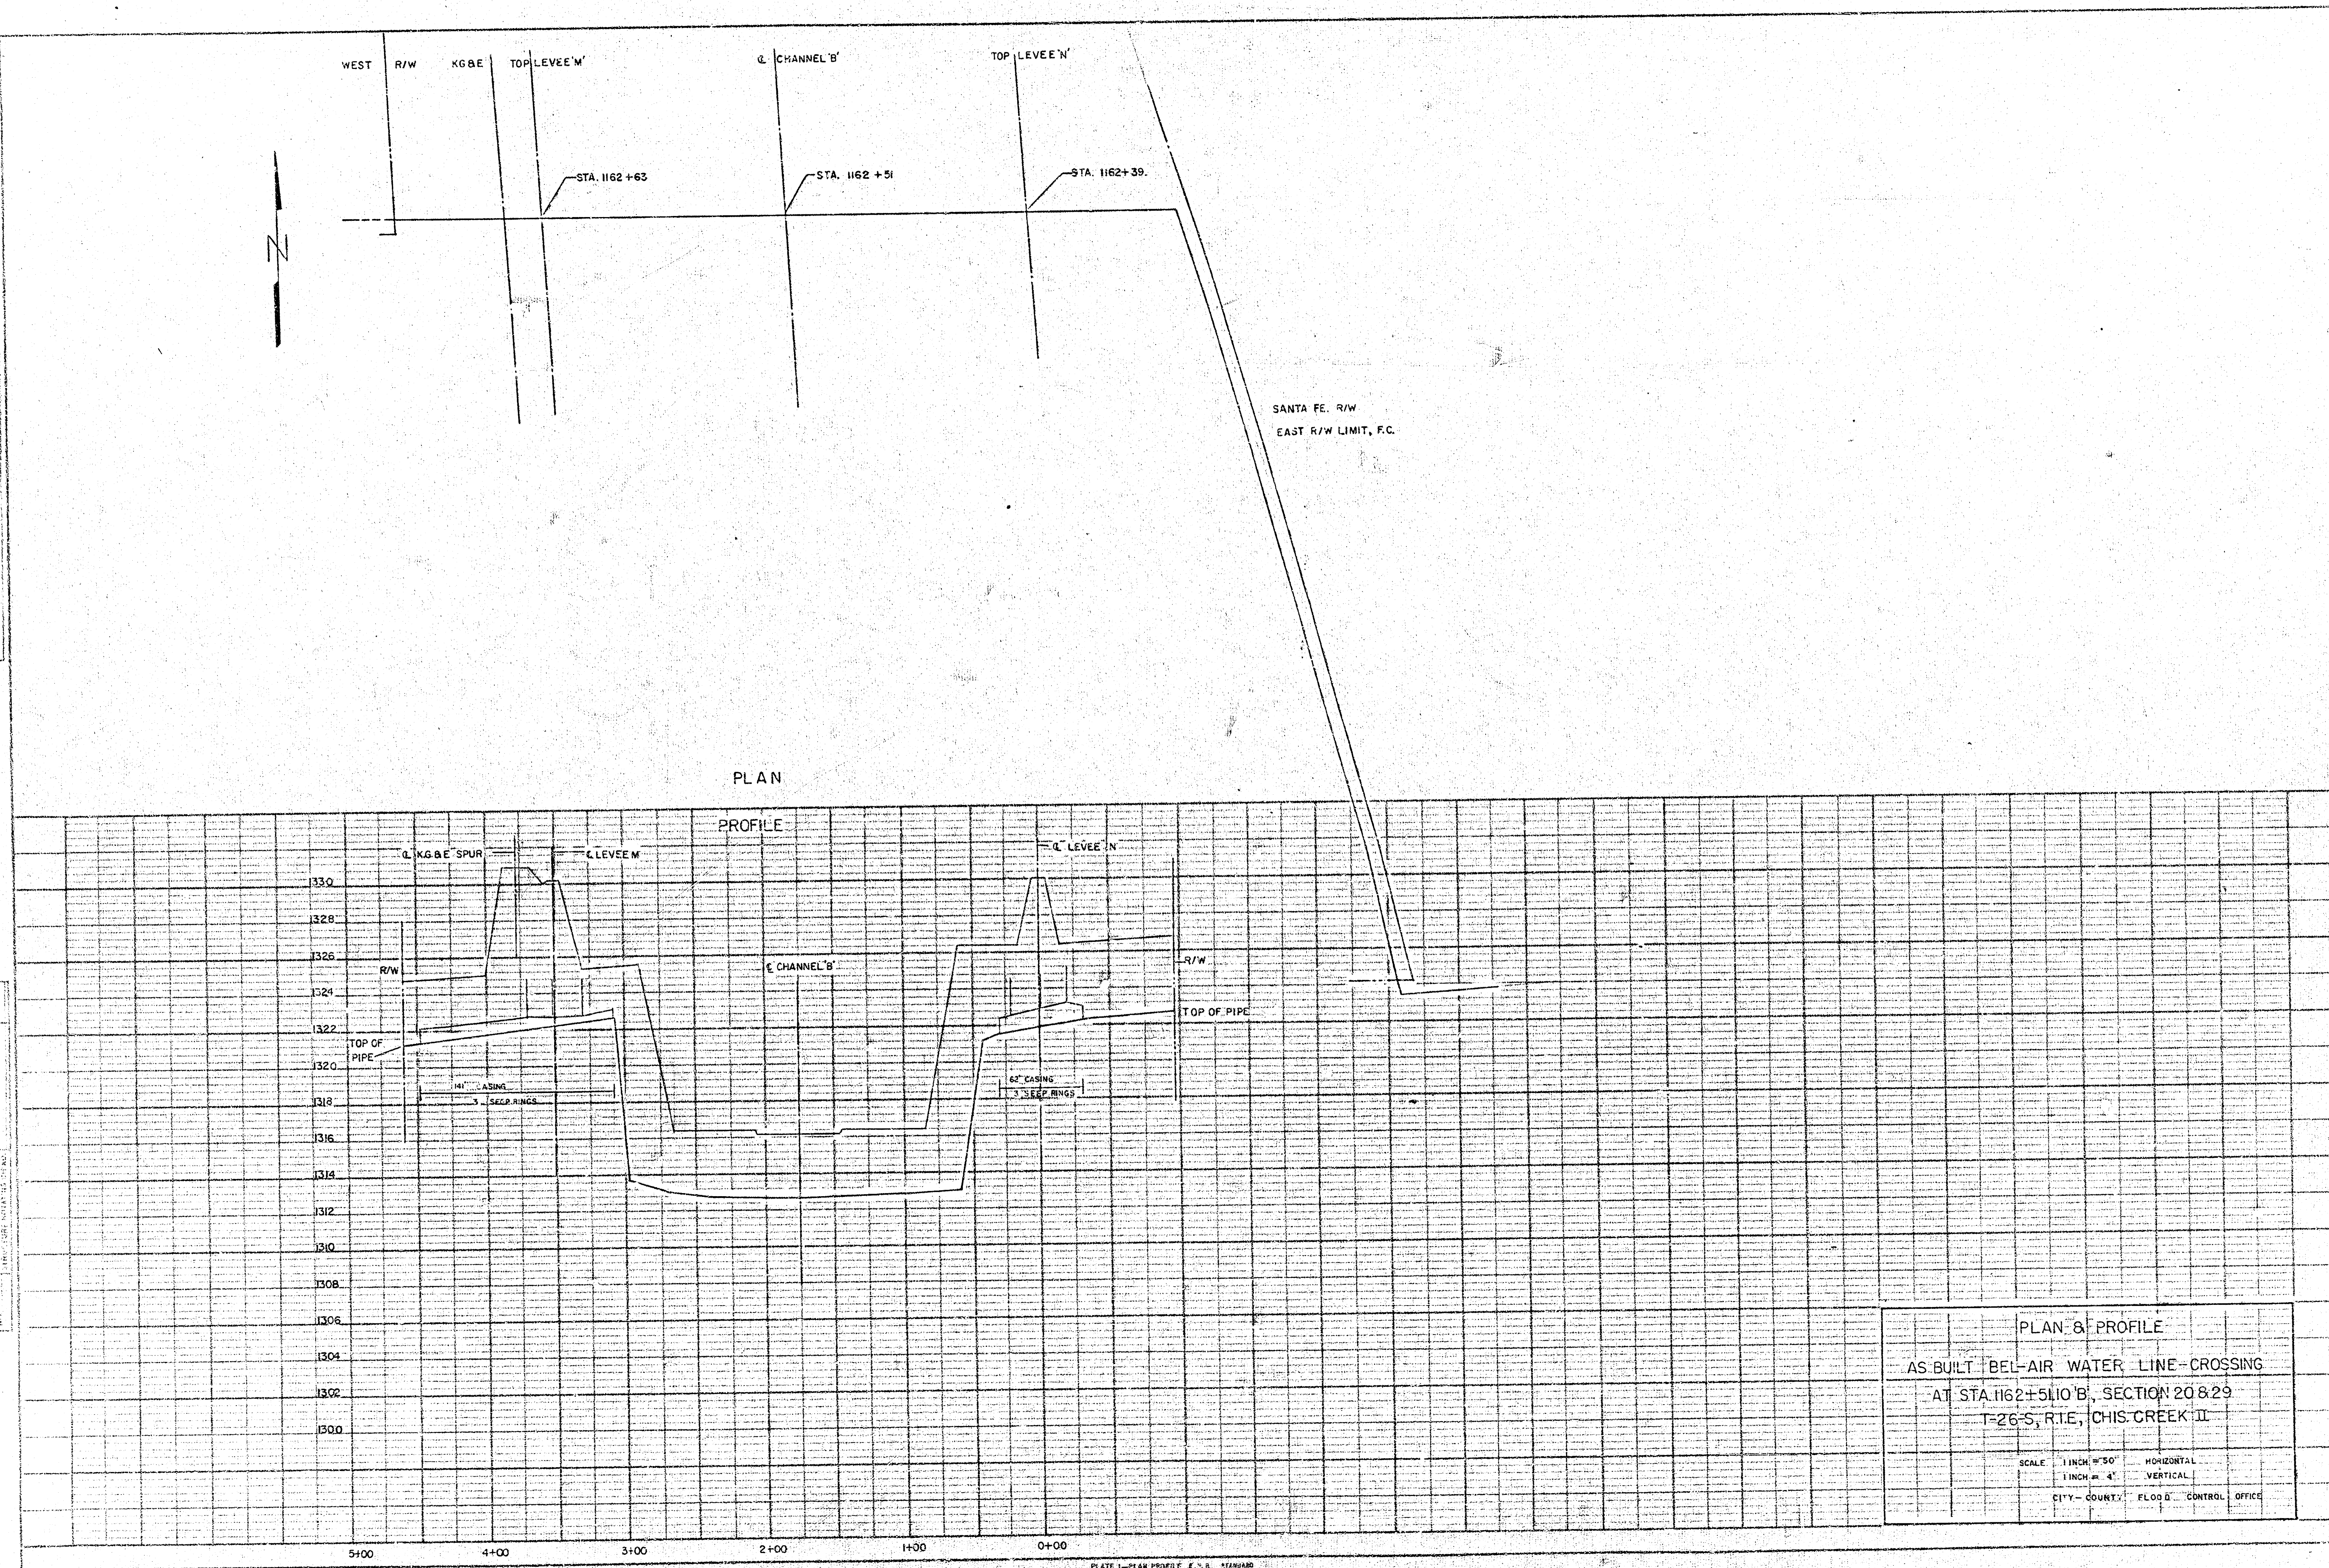


PLATE 1-PLAN PROFILE, E. & A. STANDARD

