



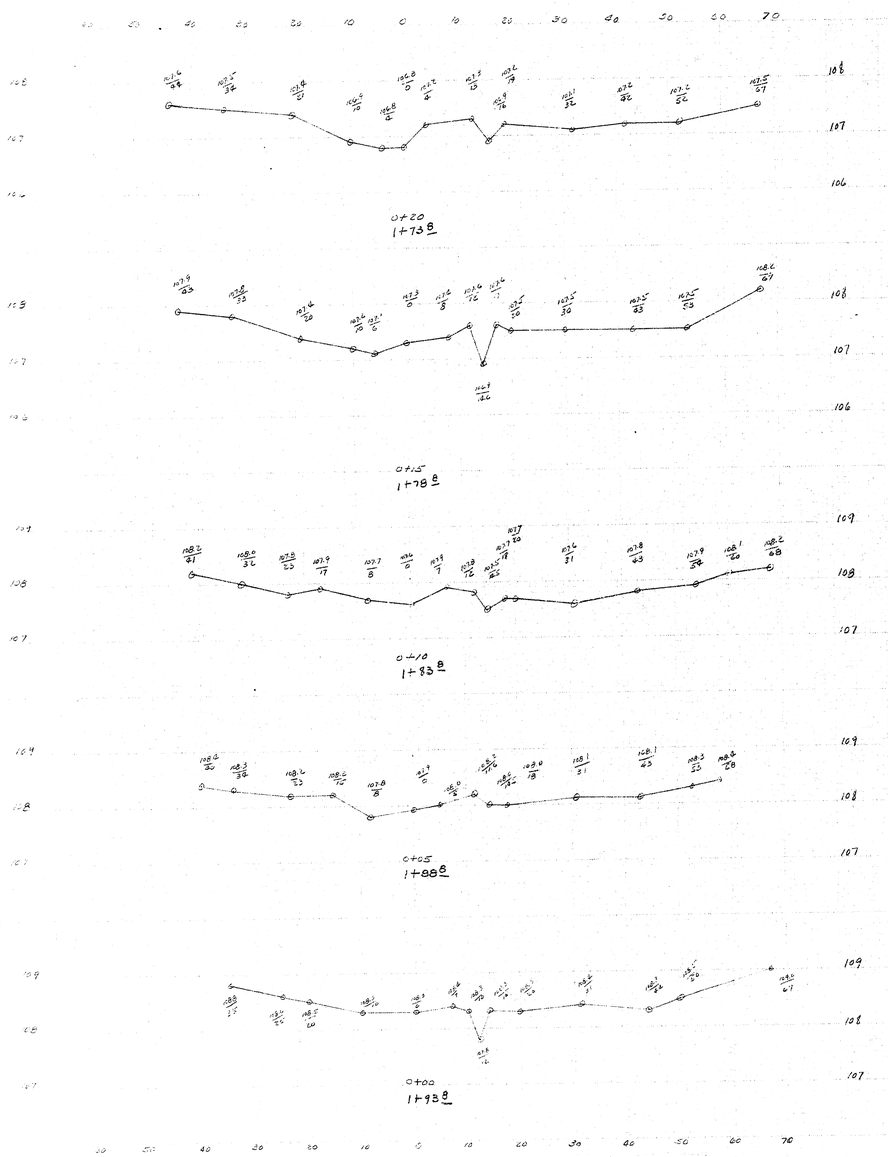


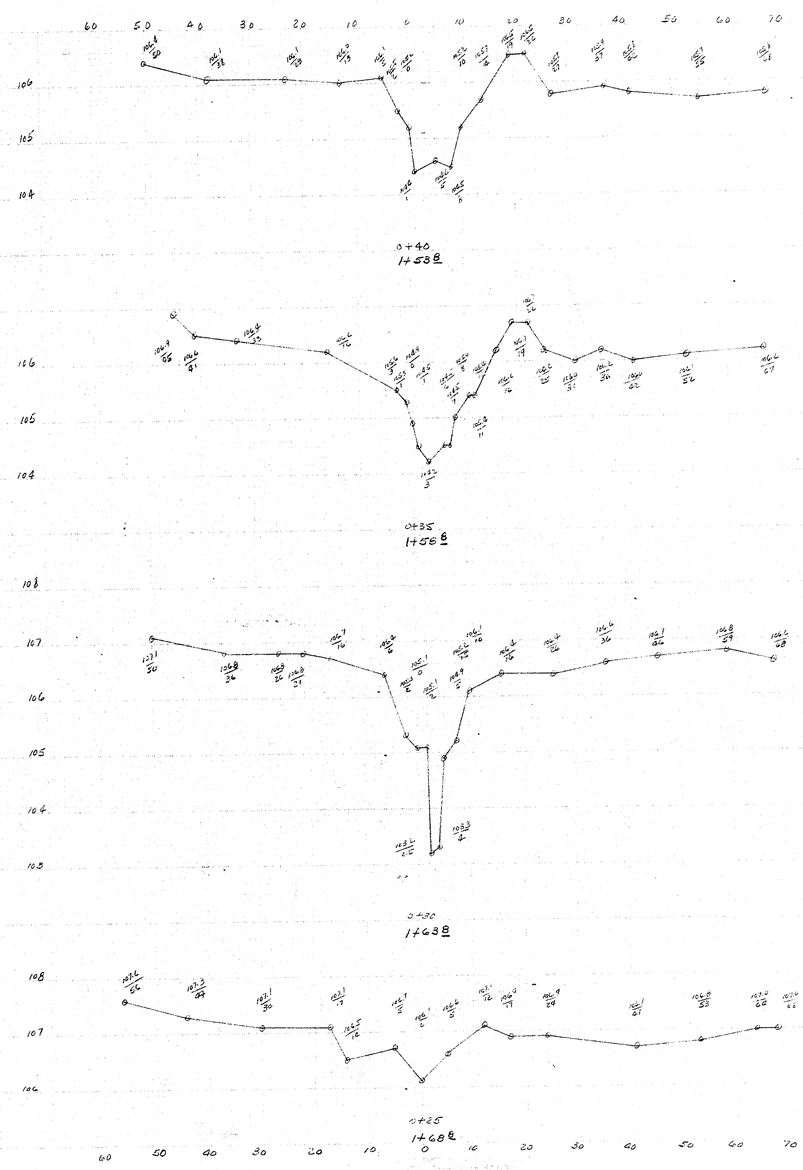



X-Sec Garrison Ditch
30th & S. Wilkins
Sheet # 1 of 5
Sept 29, 1967

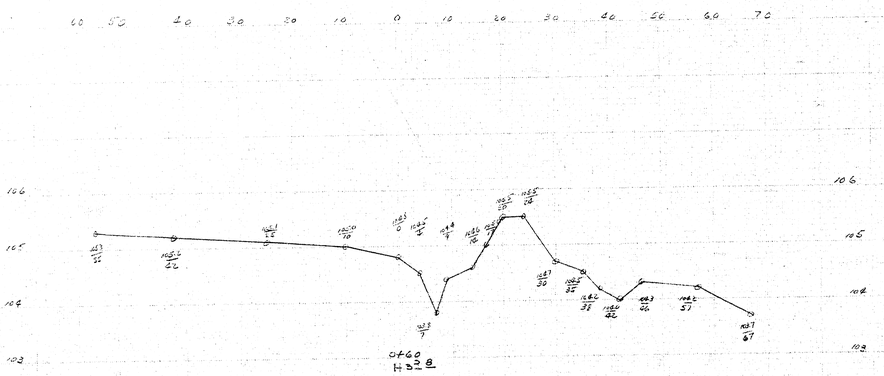


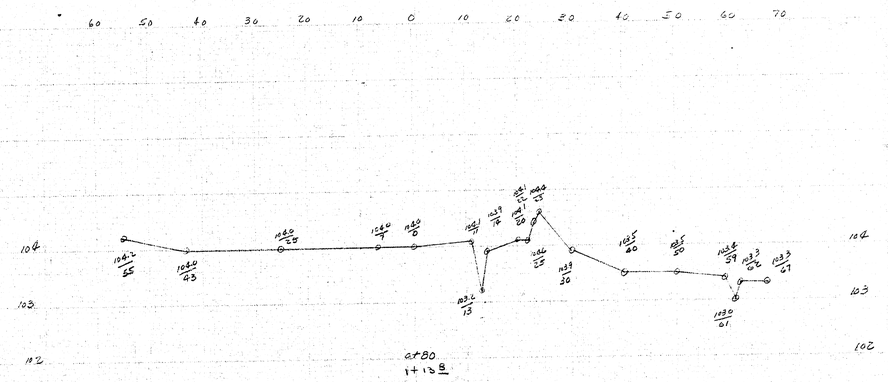


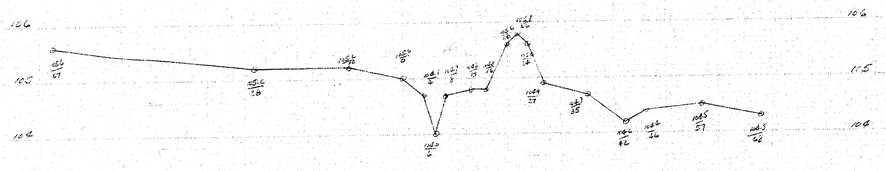


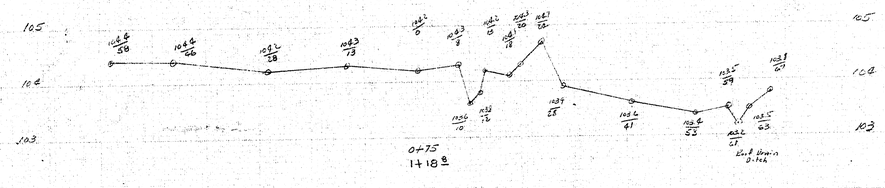

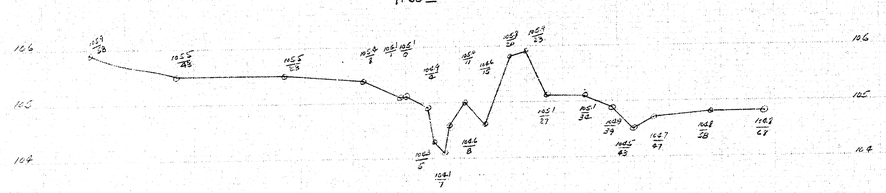


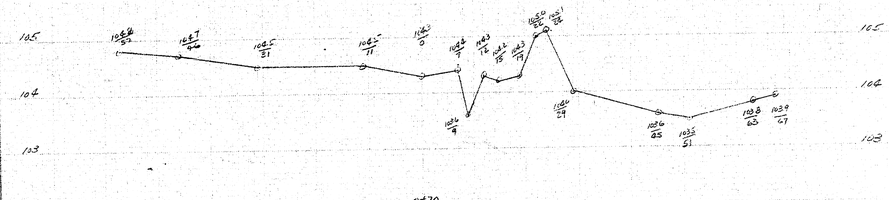

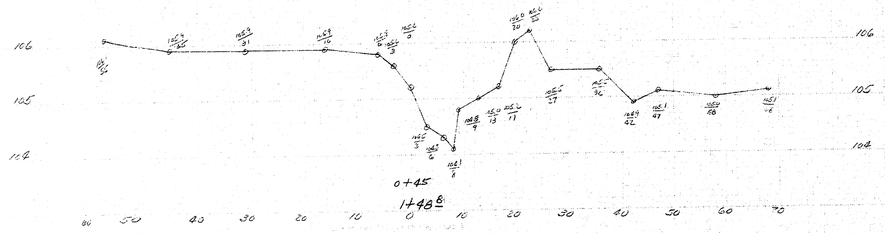


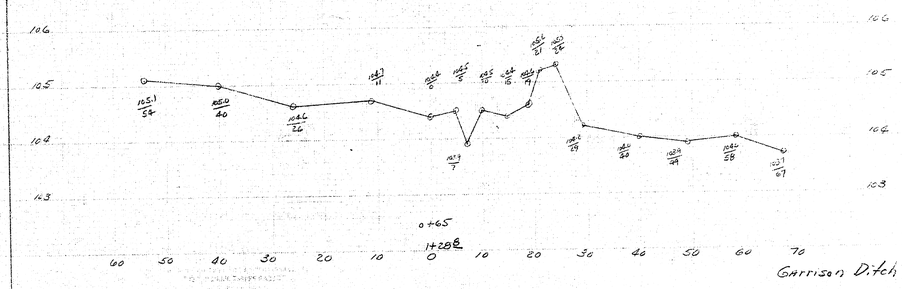


Garrison Ditch
Sheet #2 of 5

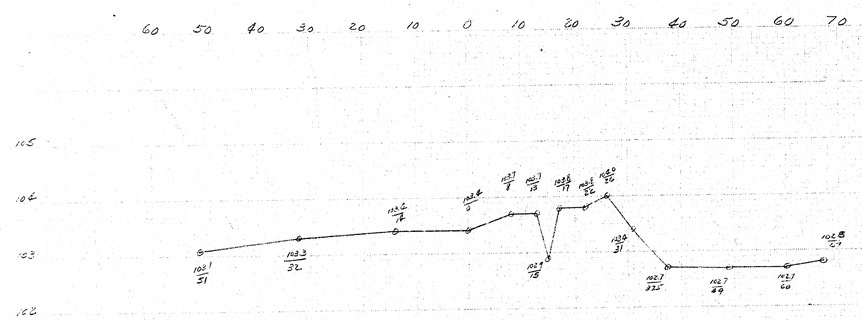


1+00
0+93 ℄

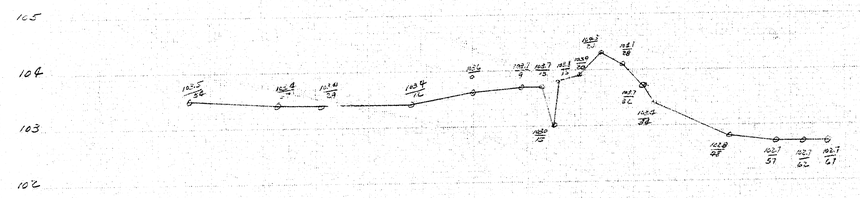


0+95
0+98 ℄

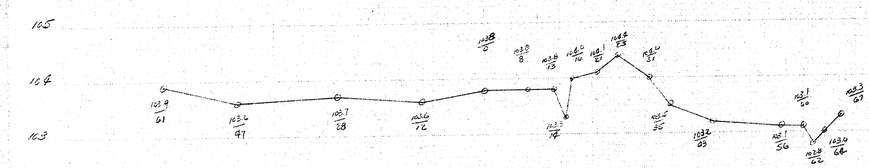


0+90
1+03 ℄

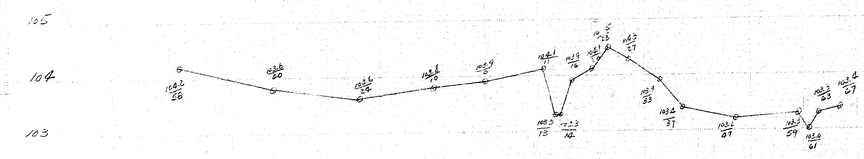


0+85
1+08 ℄

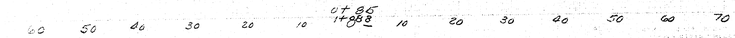


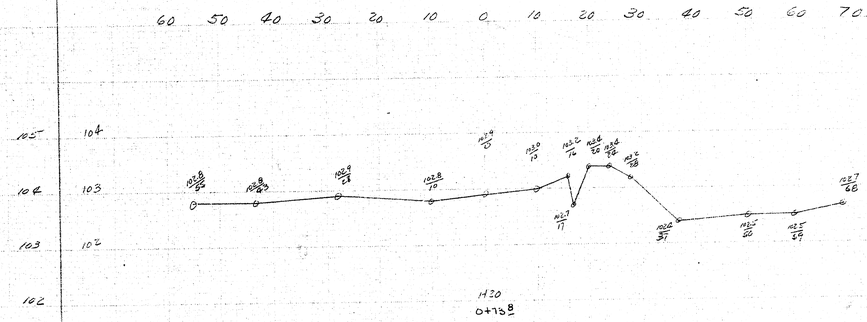


1+20
0+73 ℄

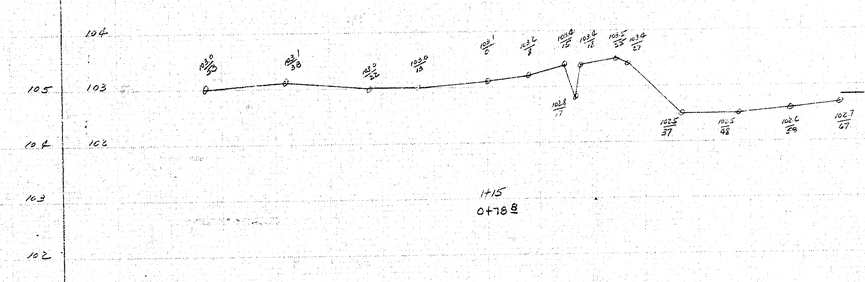


1+15
0+78 ℄

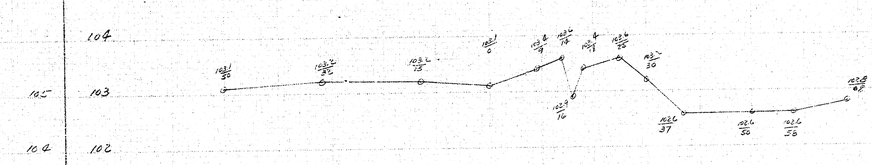

1+10
0+83 ℄

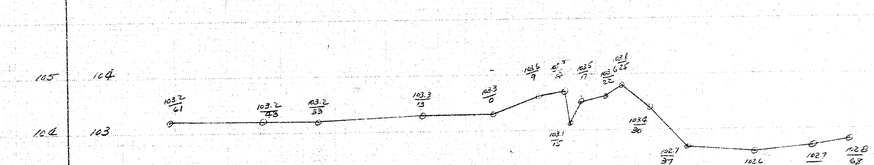


1+05
0+88 ℄

 


(Harrison Ditch)

Sheet #3 of 5


1+25
0+68 B

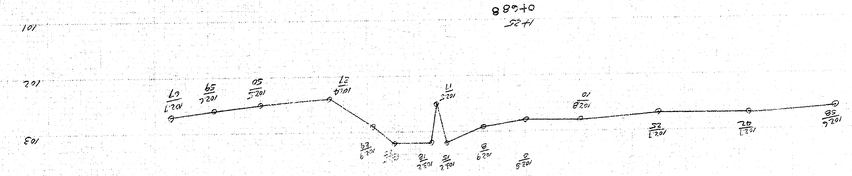


1+33
0+63 B

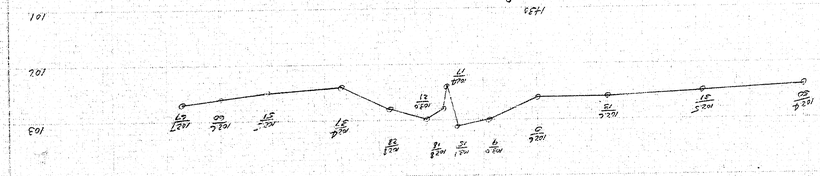


1+35
0+58 B

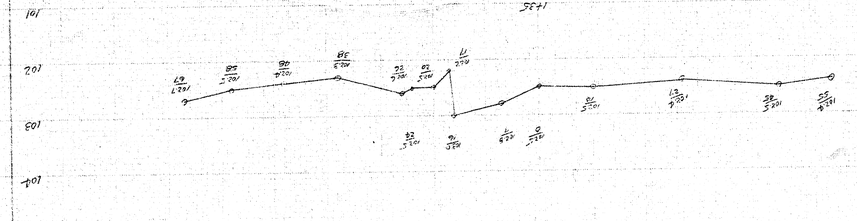


1+40
0+53 B

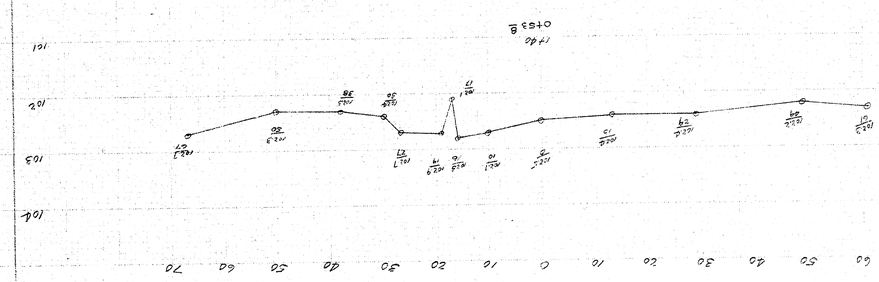


1+45
0+48 B

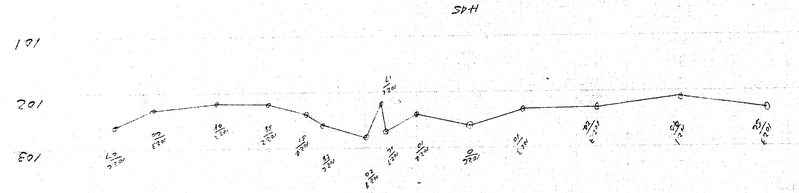


1+50
0+48 B

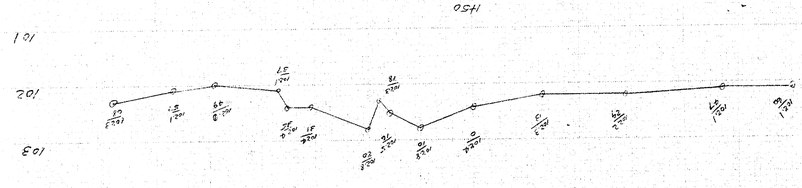



1+55
0+38 B

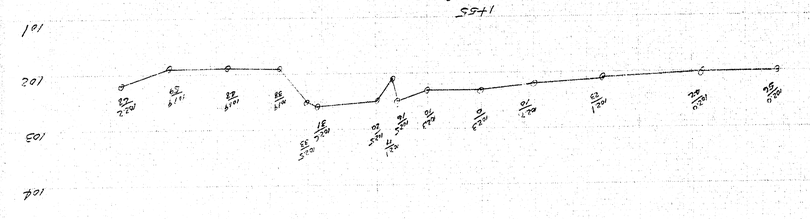



1+60
0+33 B

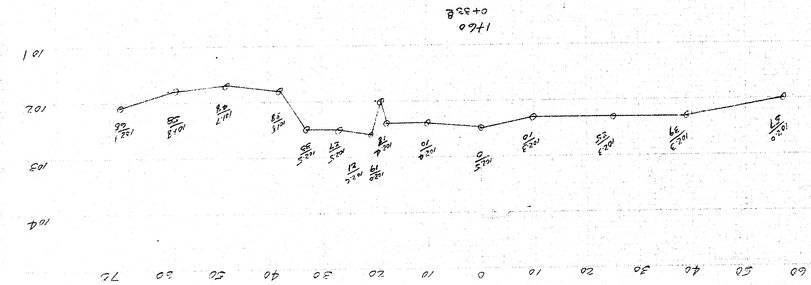


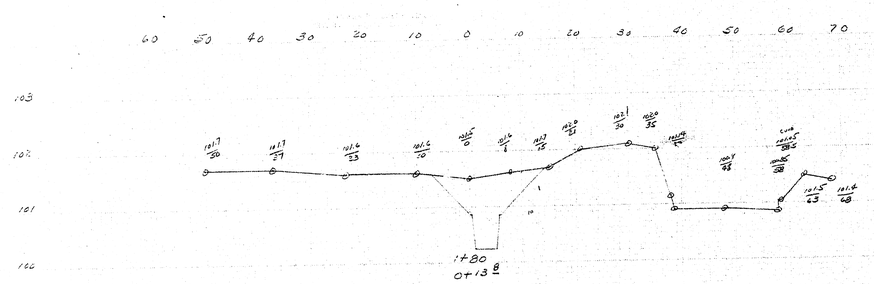


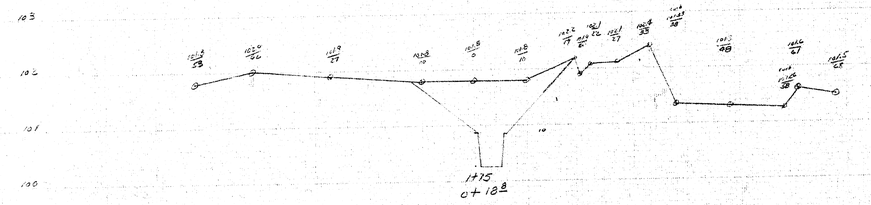


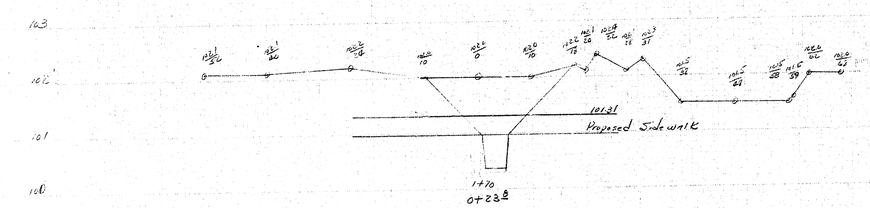


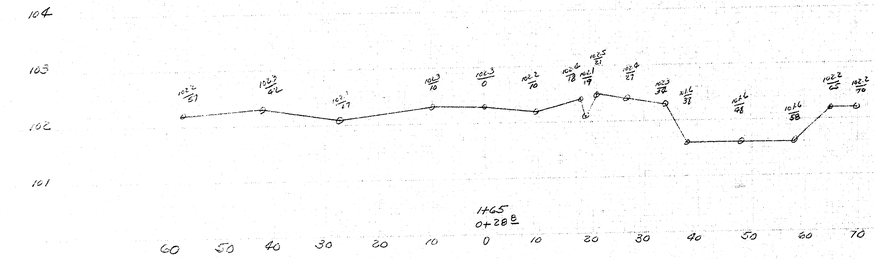

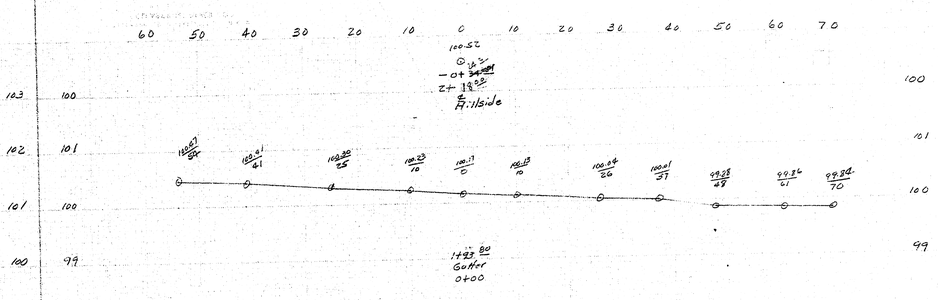

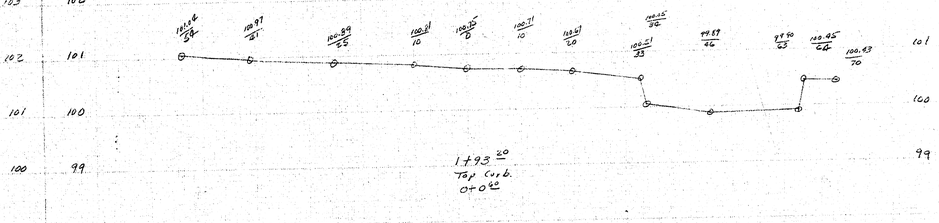

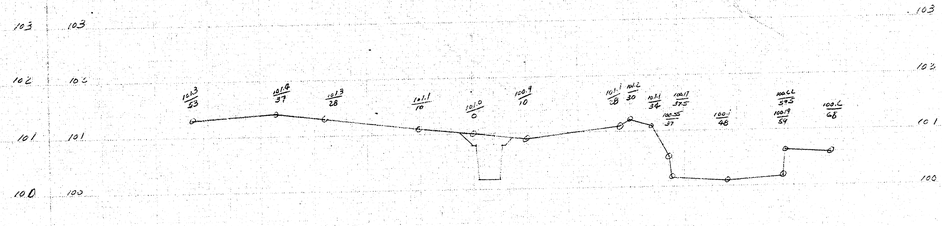

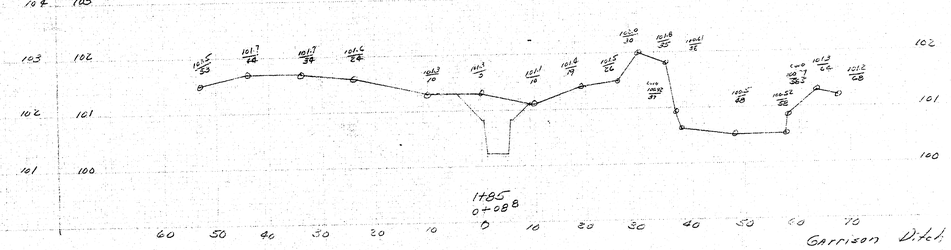

Garrison Ditch
Sheet 4 of 5