


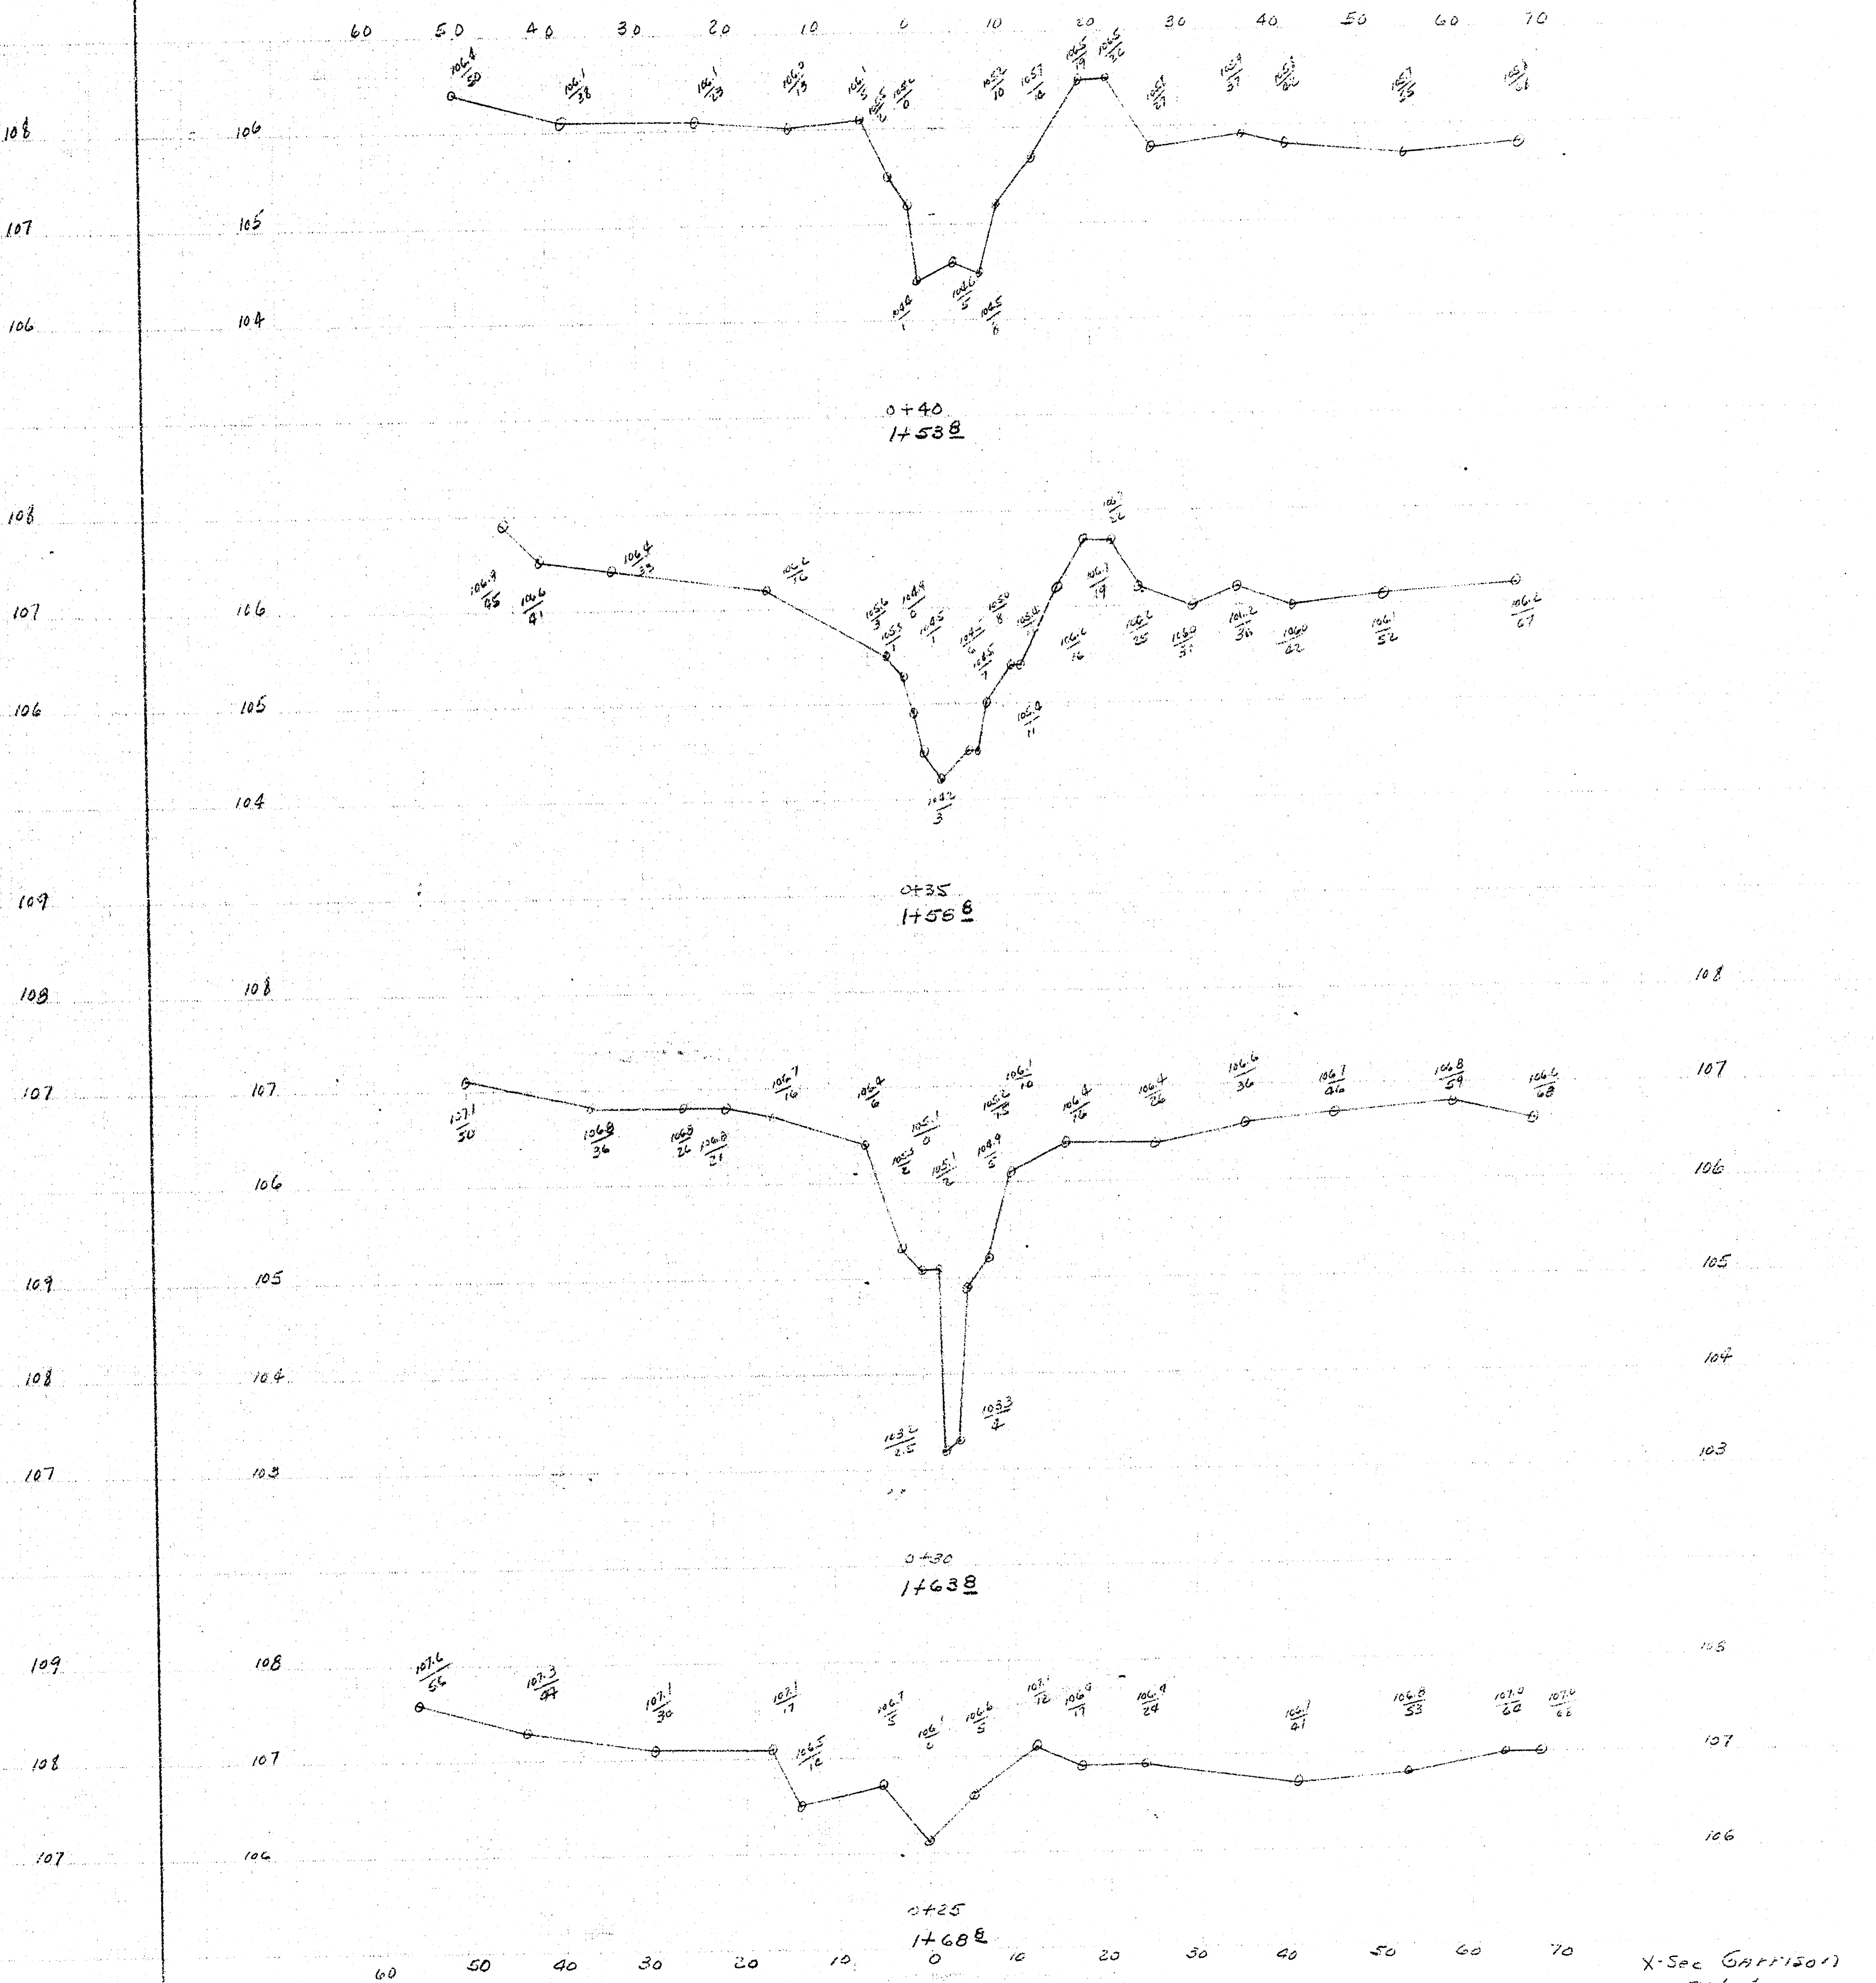



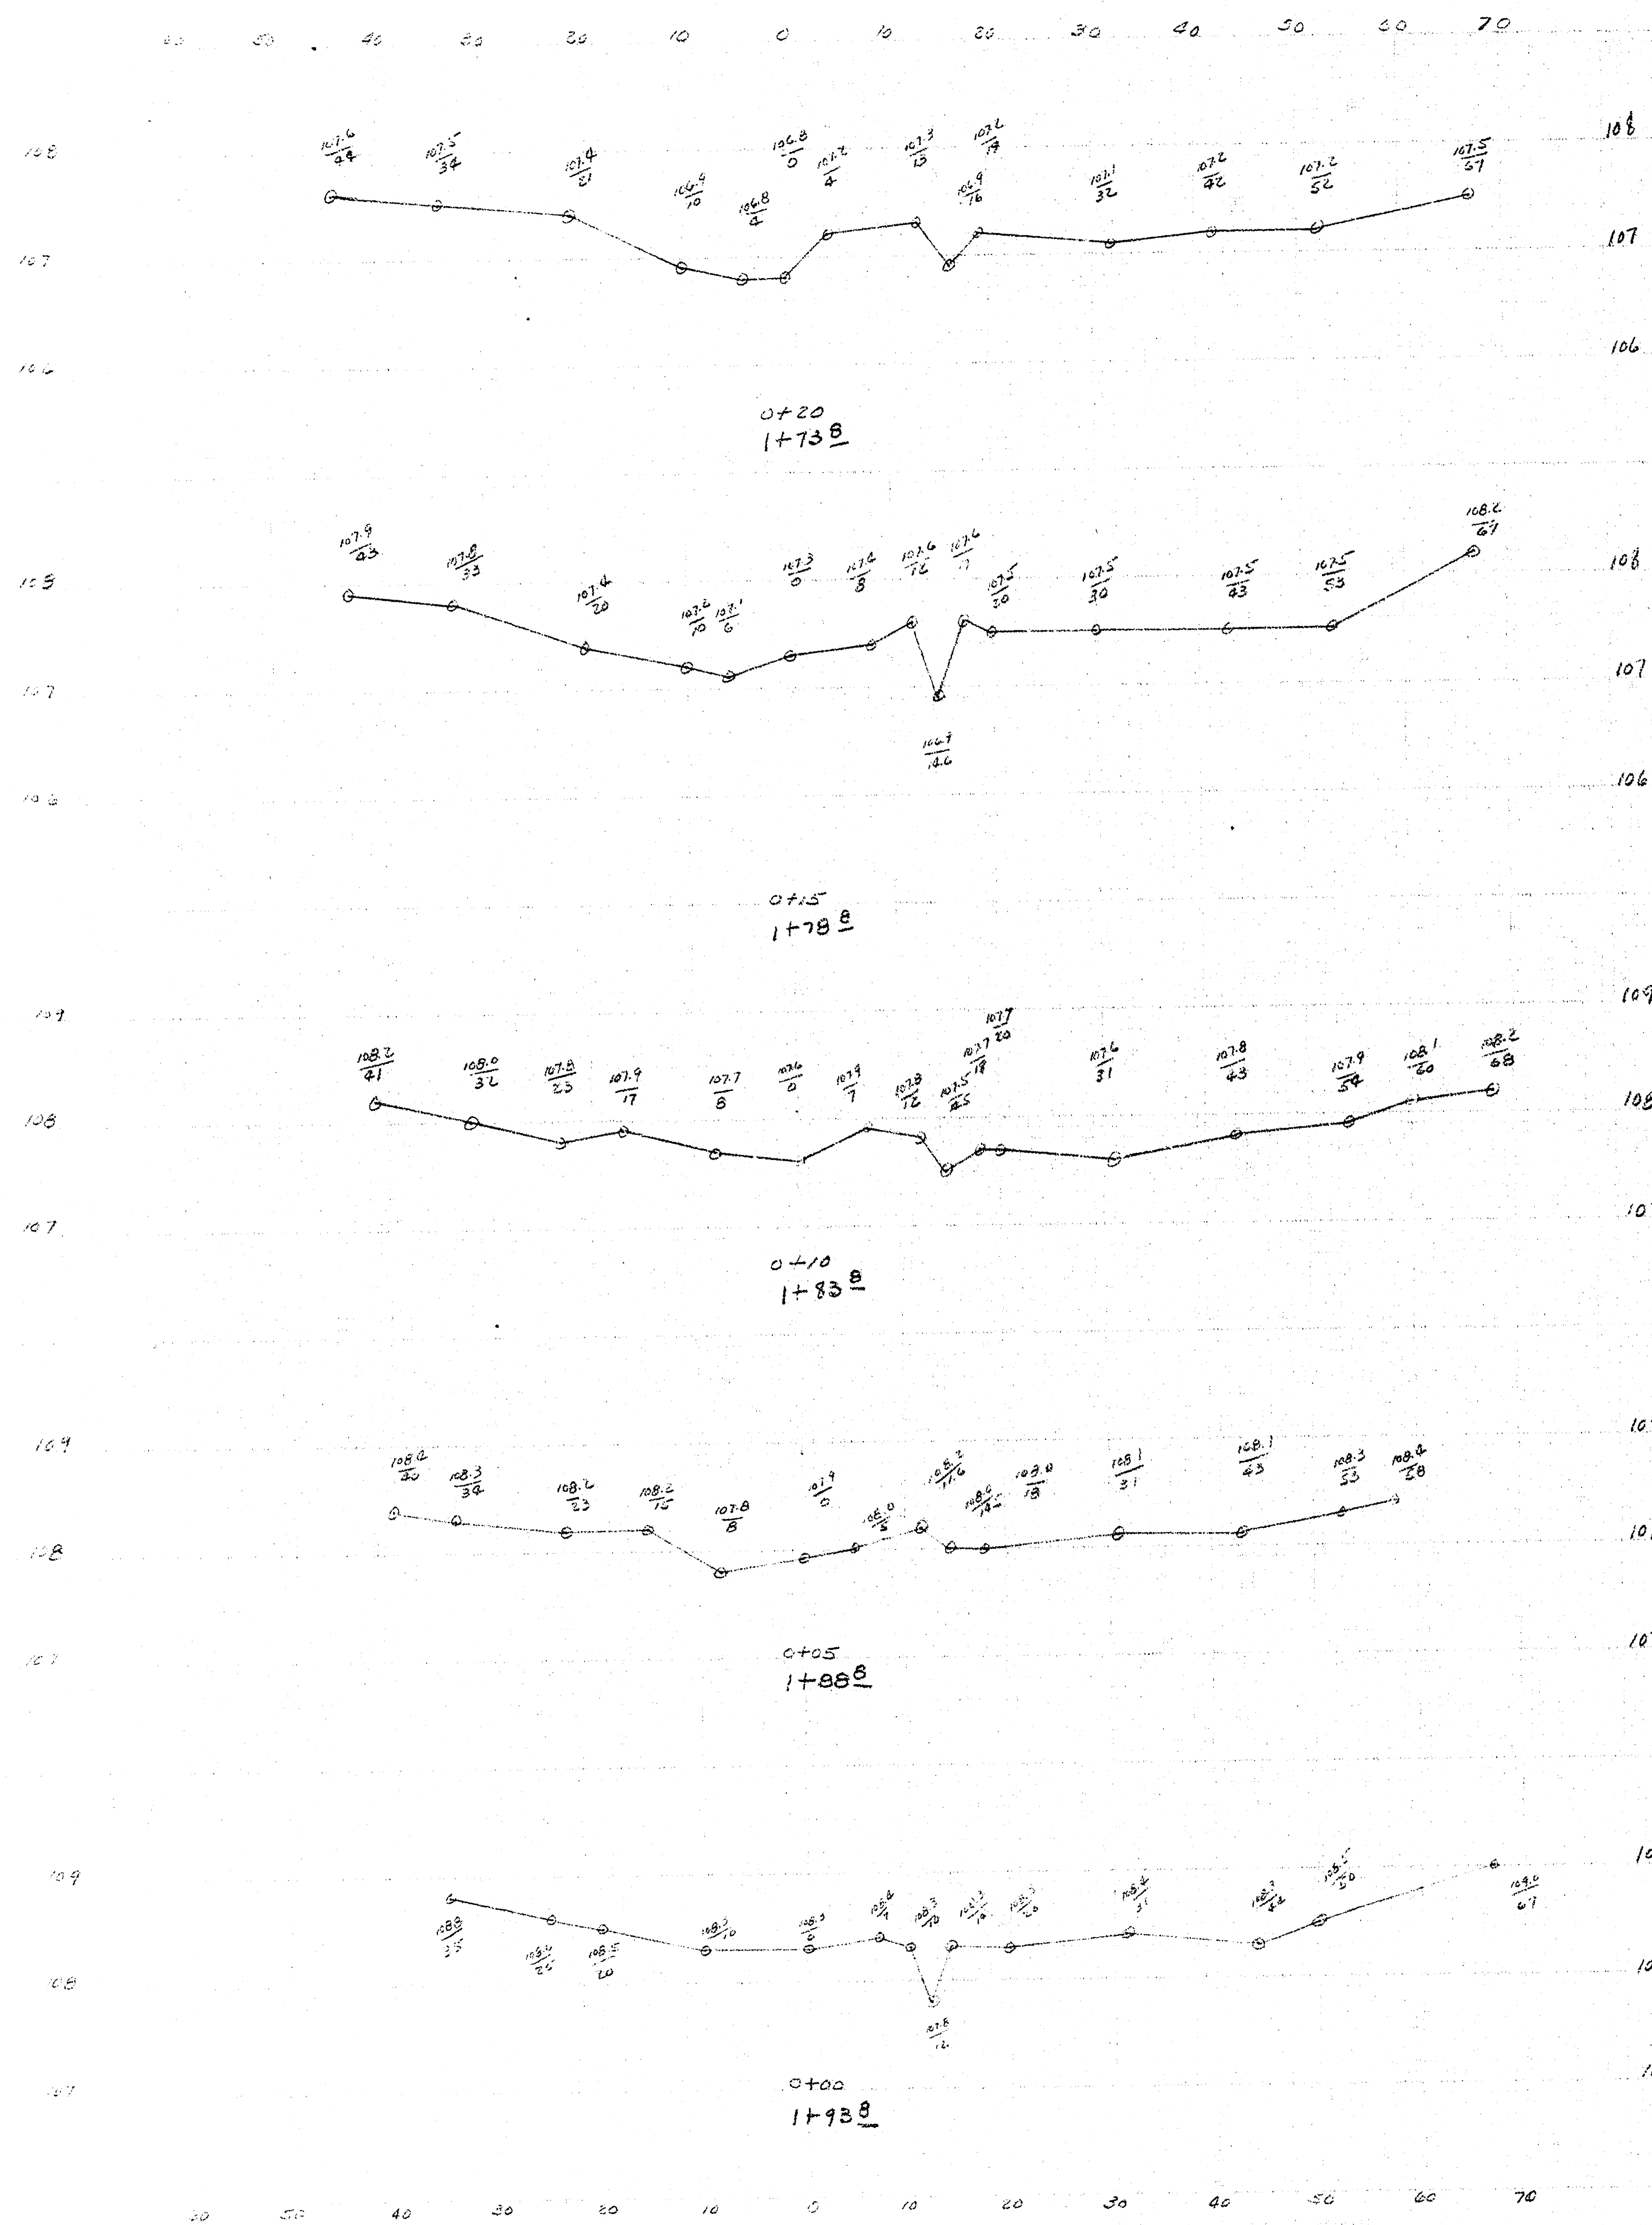


 Ditch  
 Sheet # 1 of 5  
 Sept 29, 1967

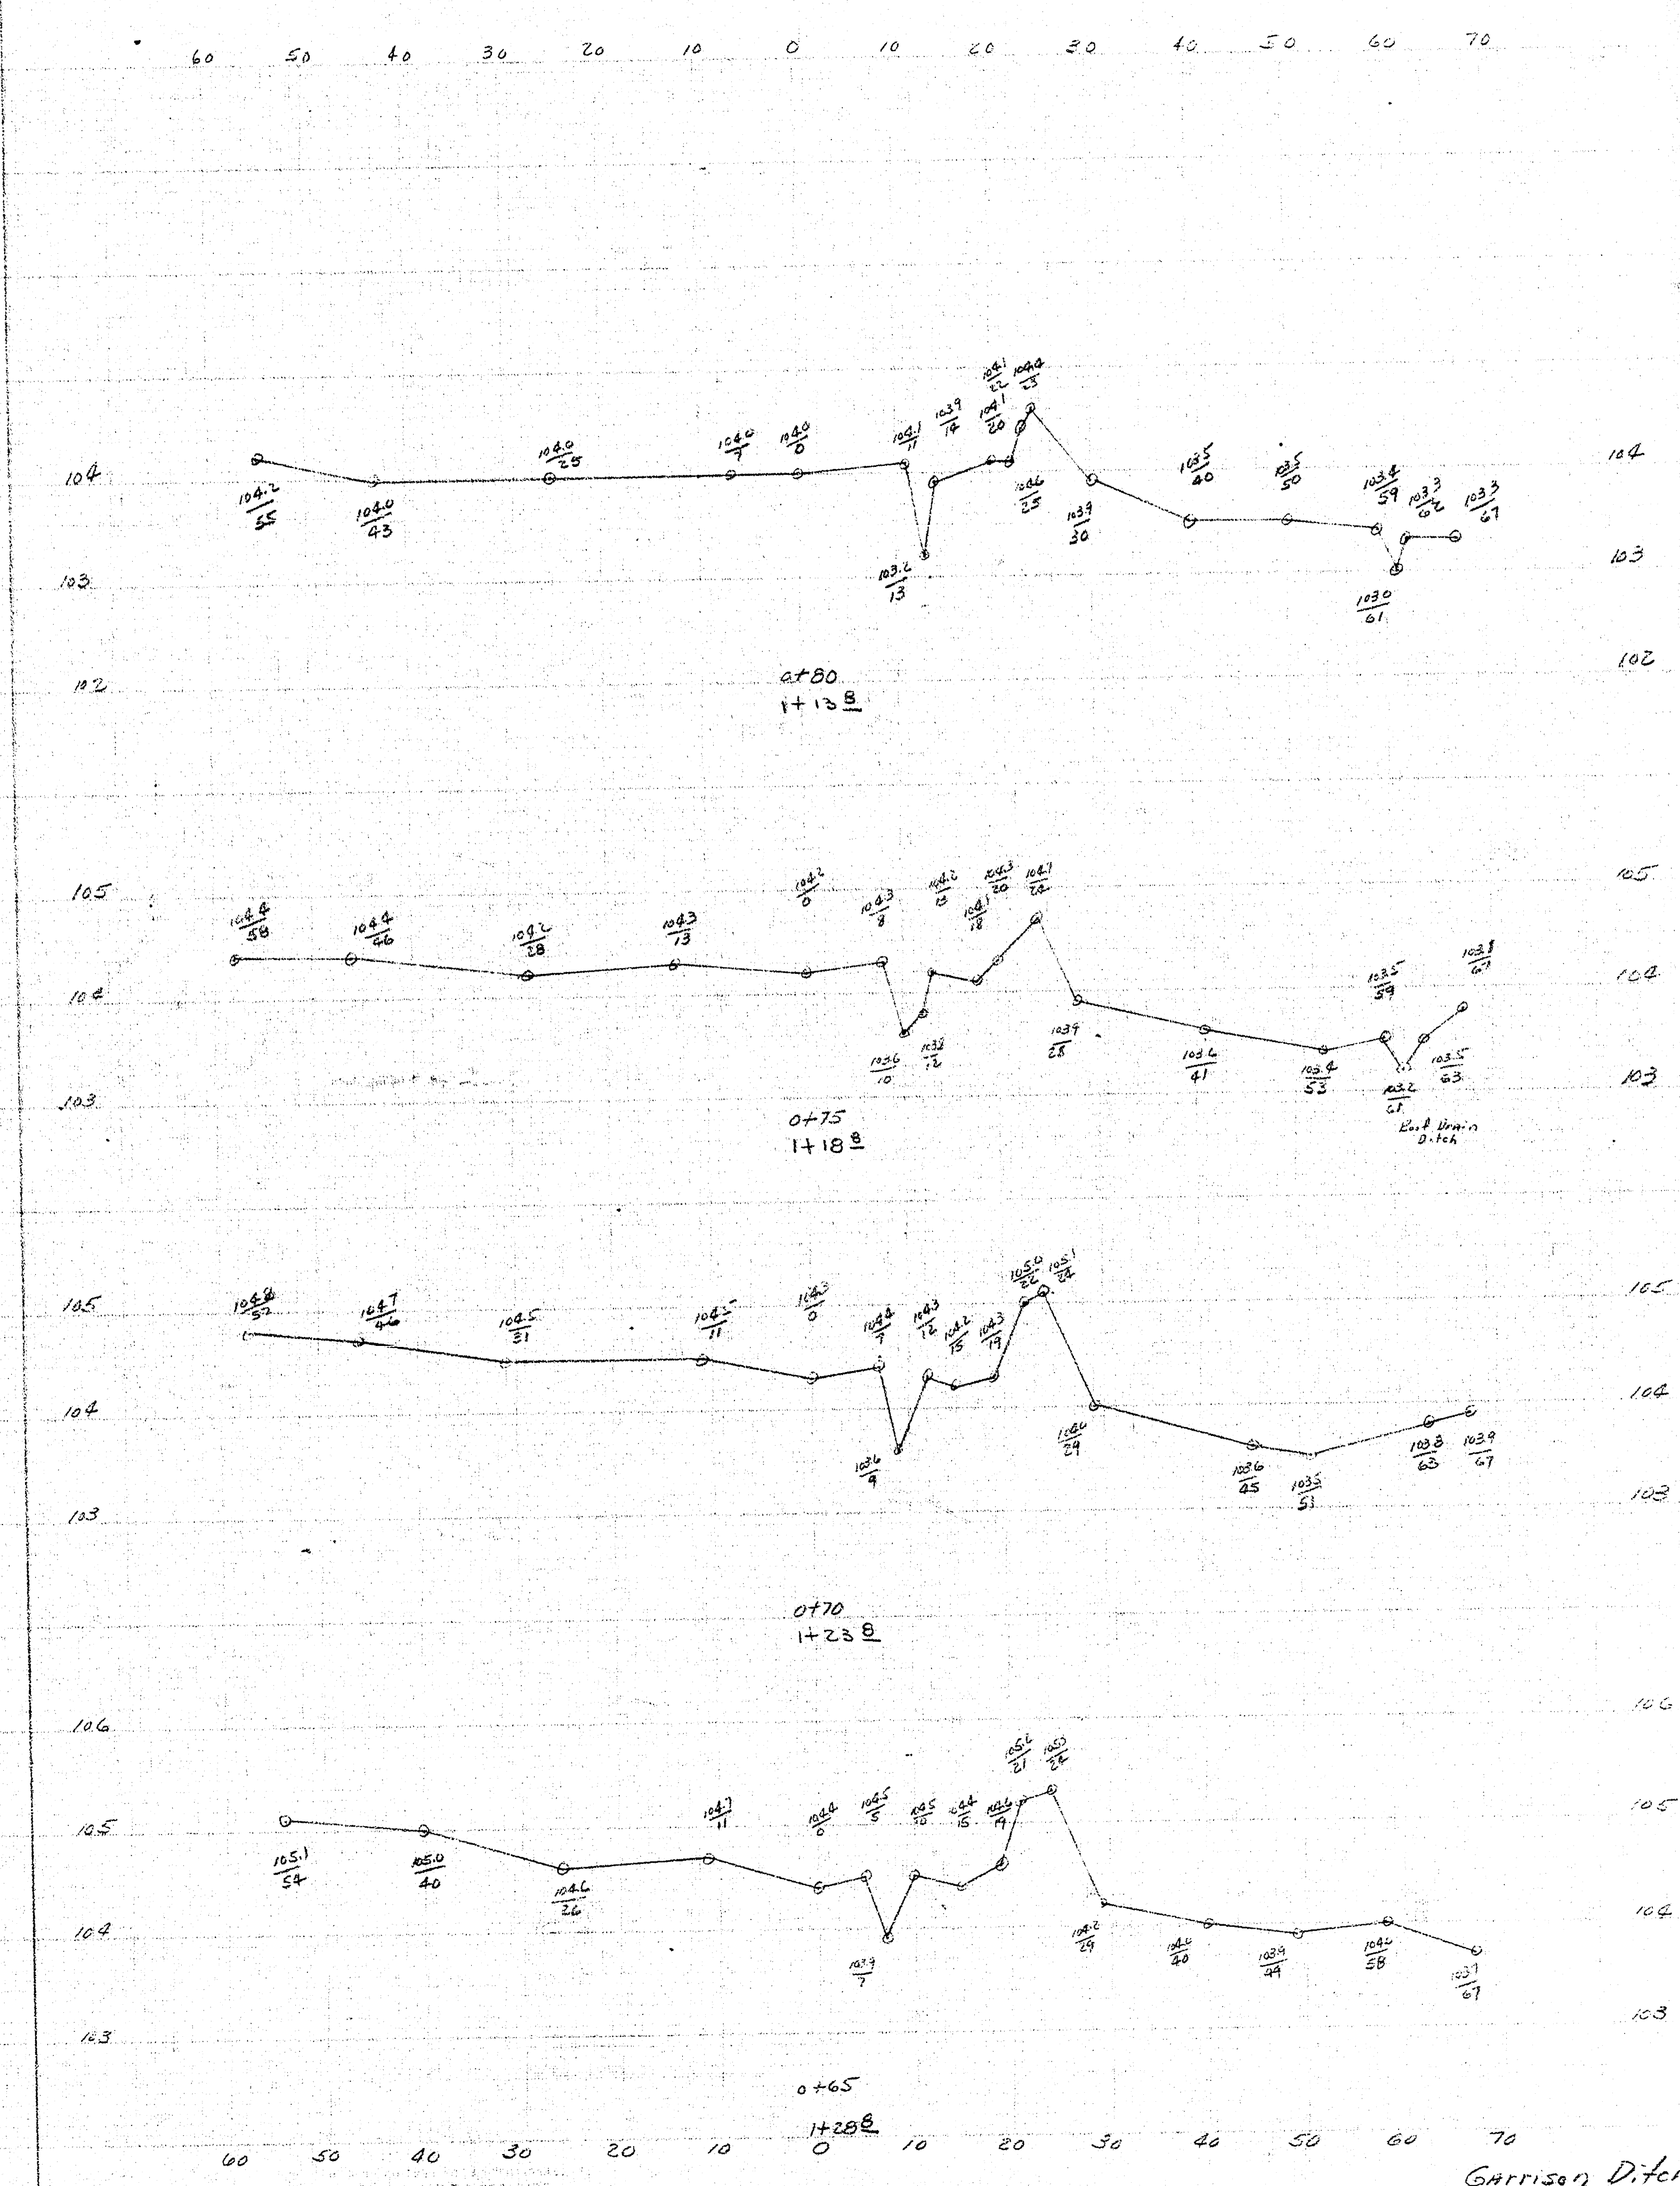

Garrison Ditch  
Sheet #2 of 5

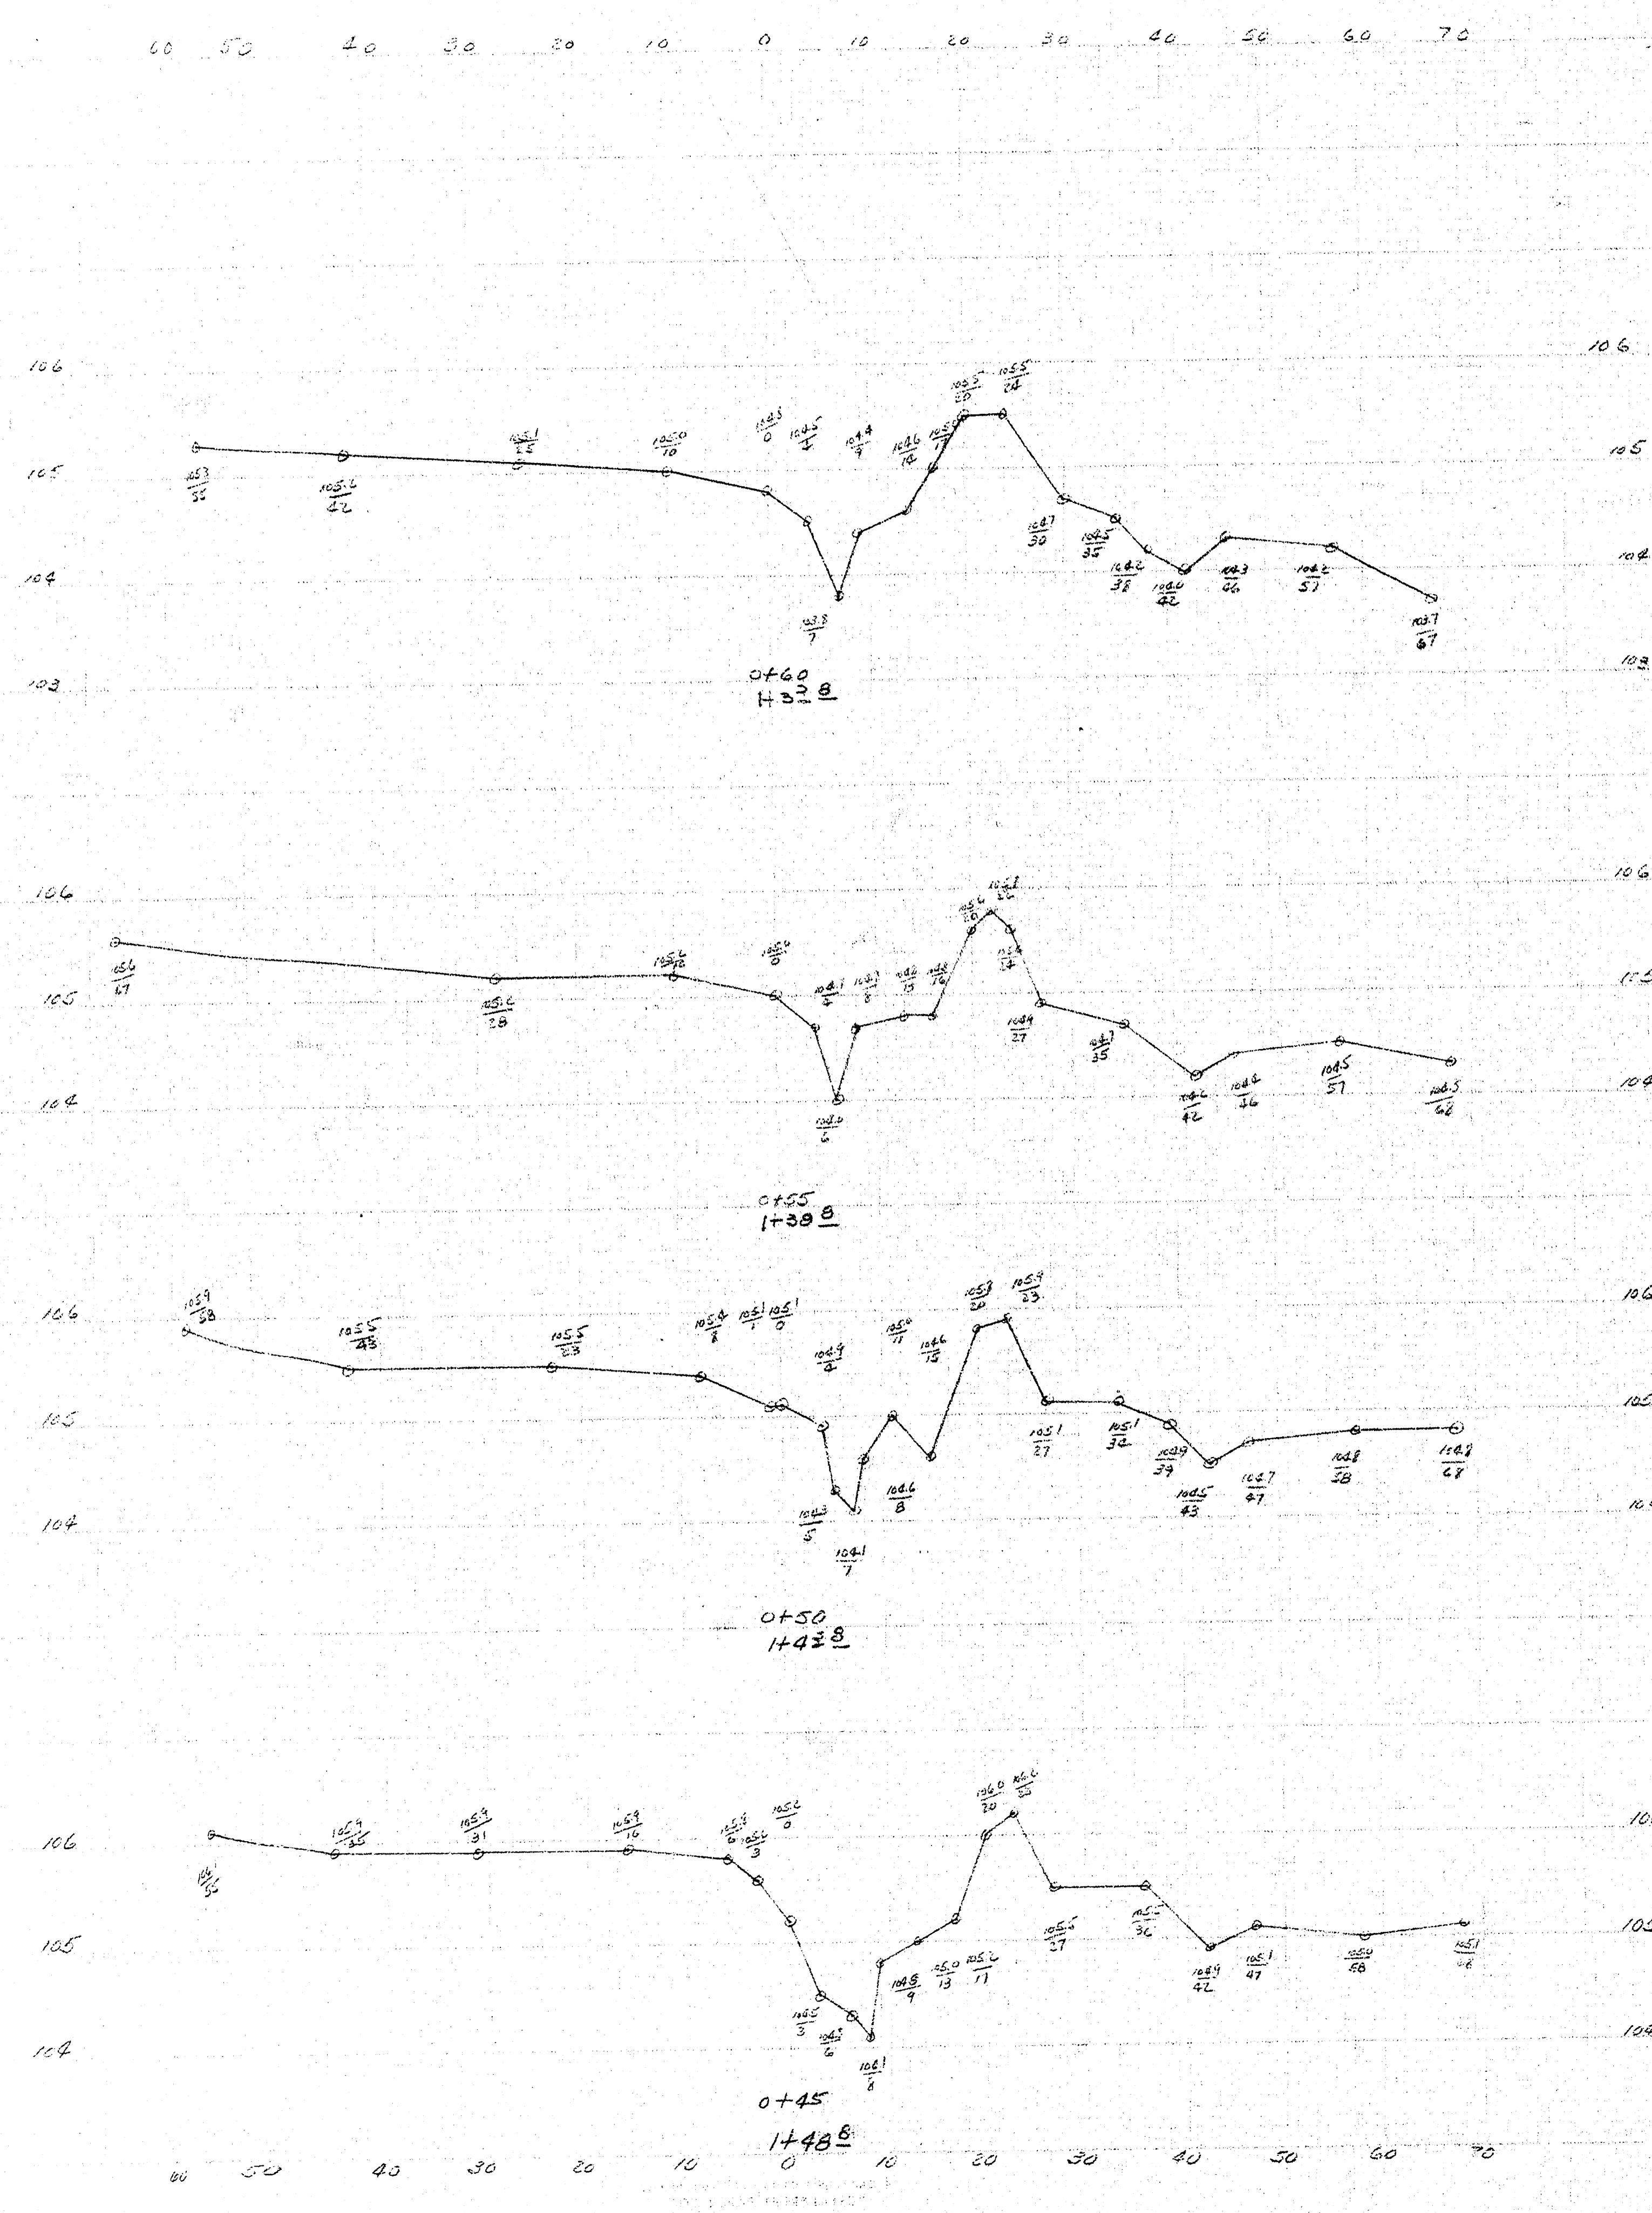

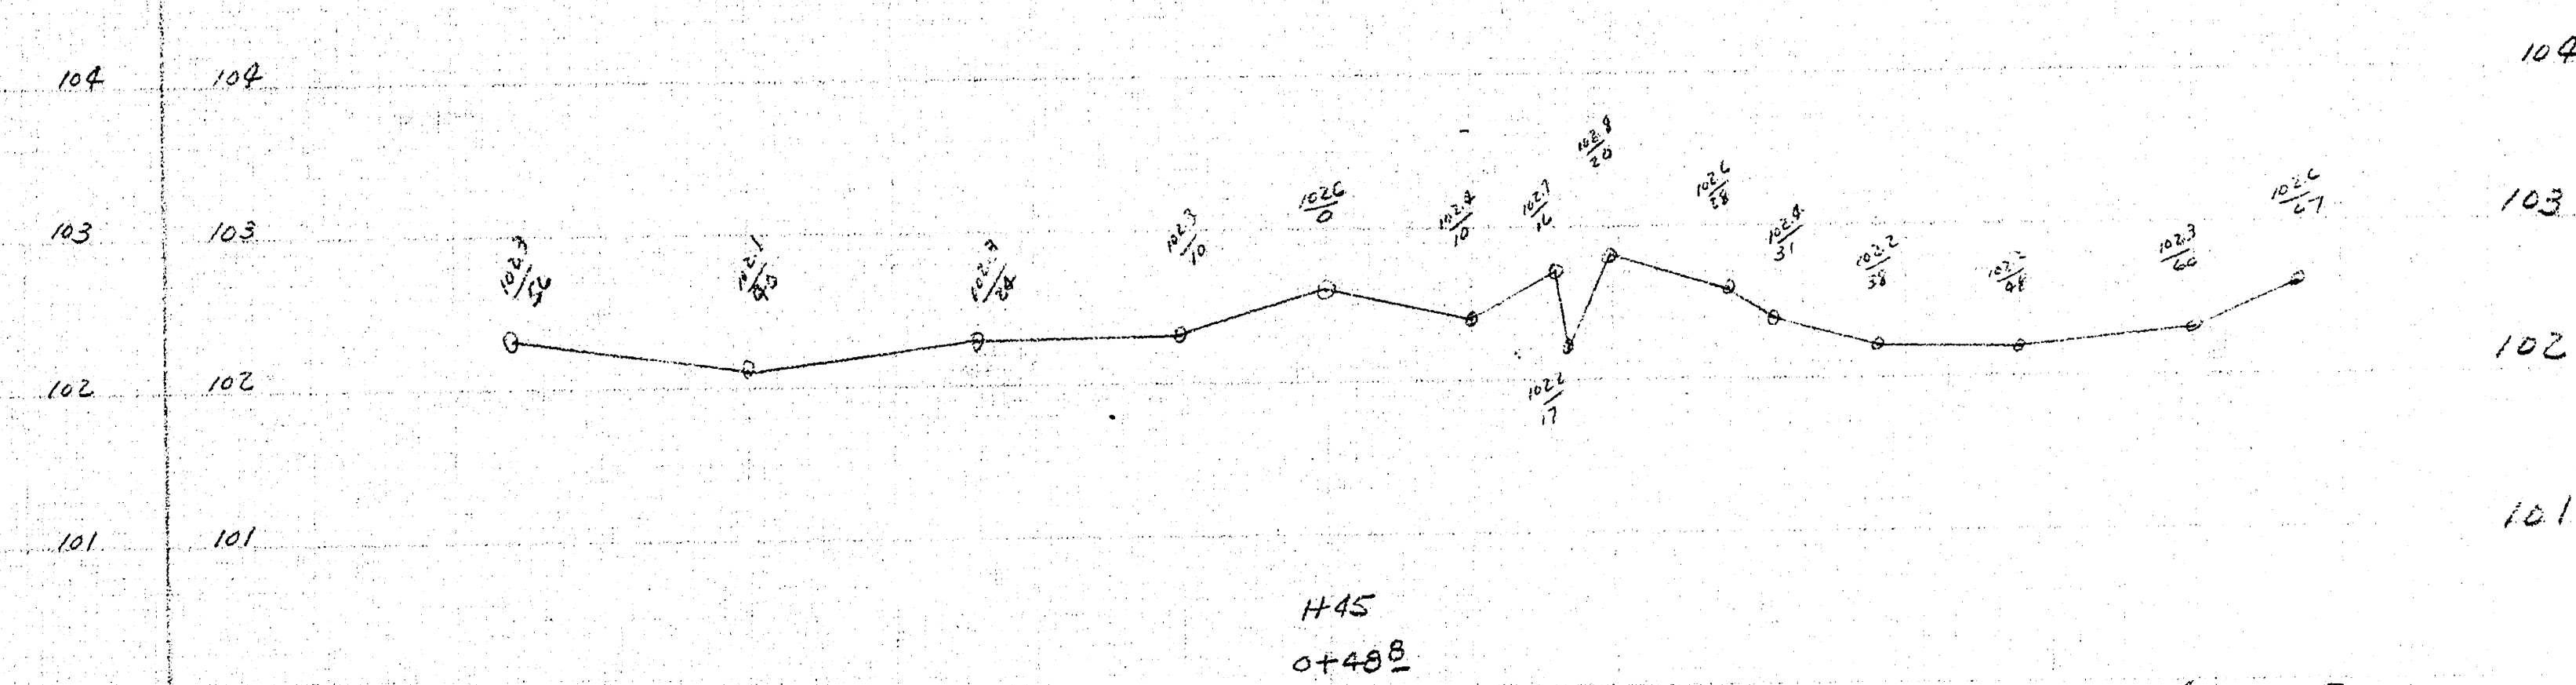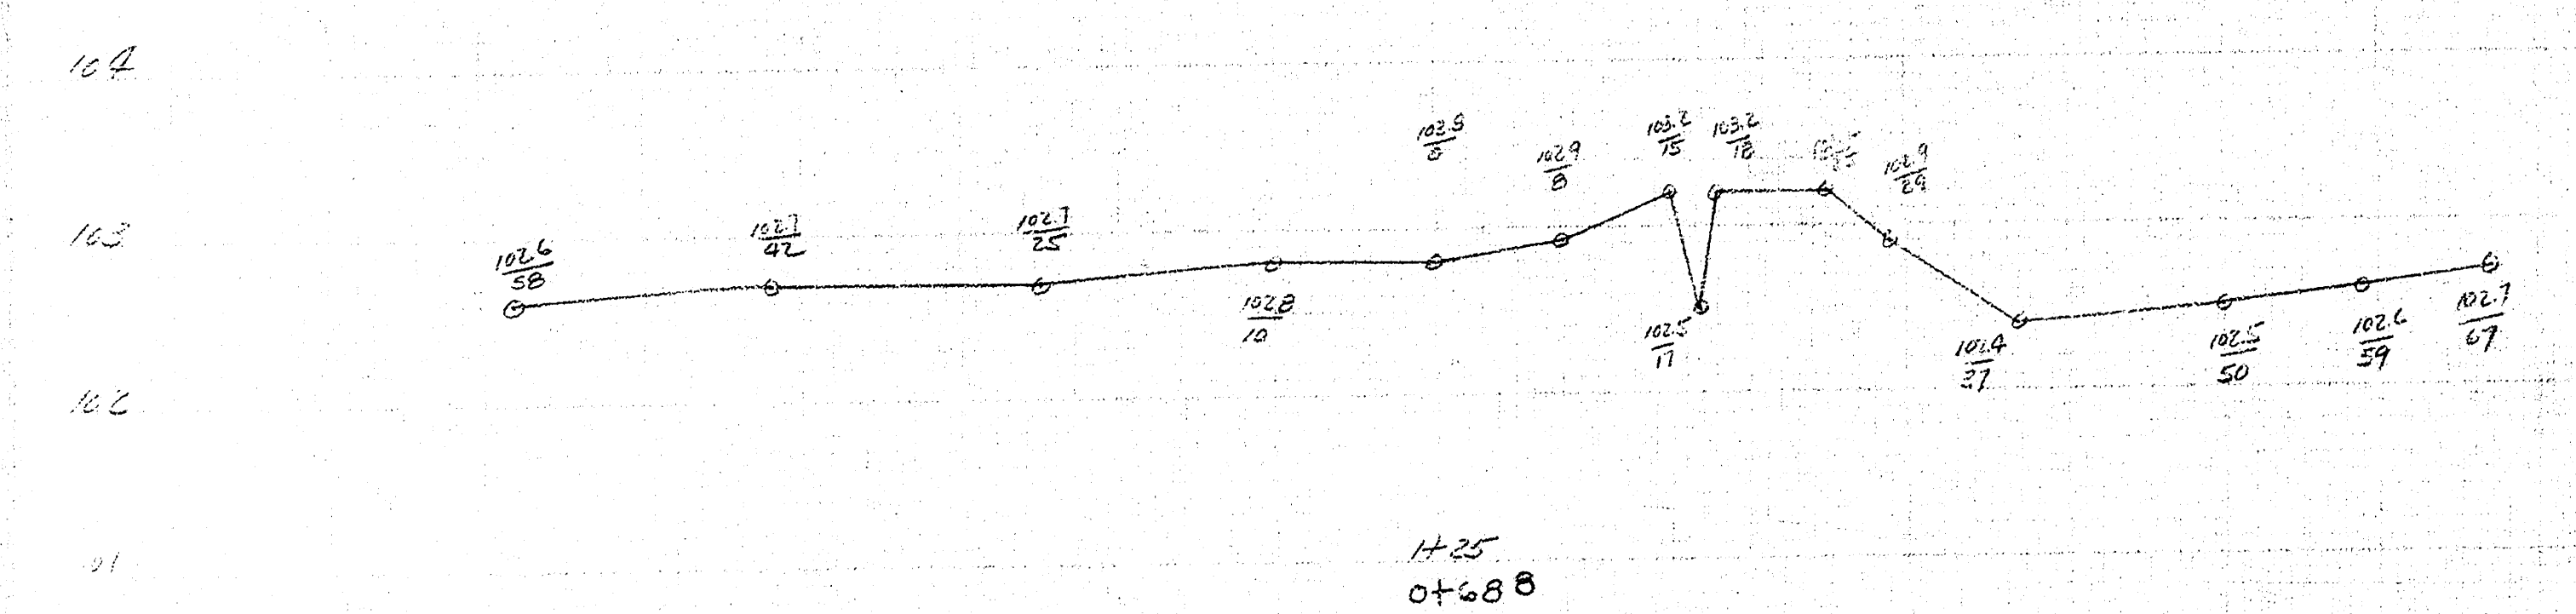

Garrison Ditch  
Sheet #4 of 5

