


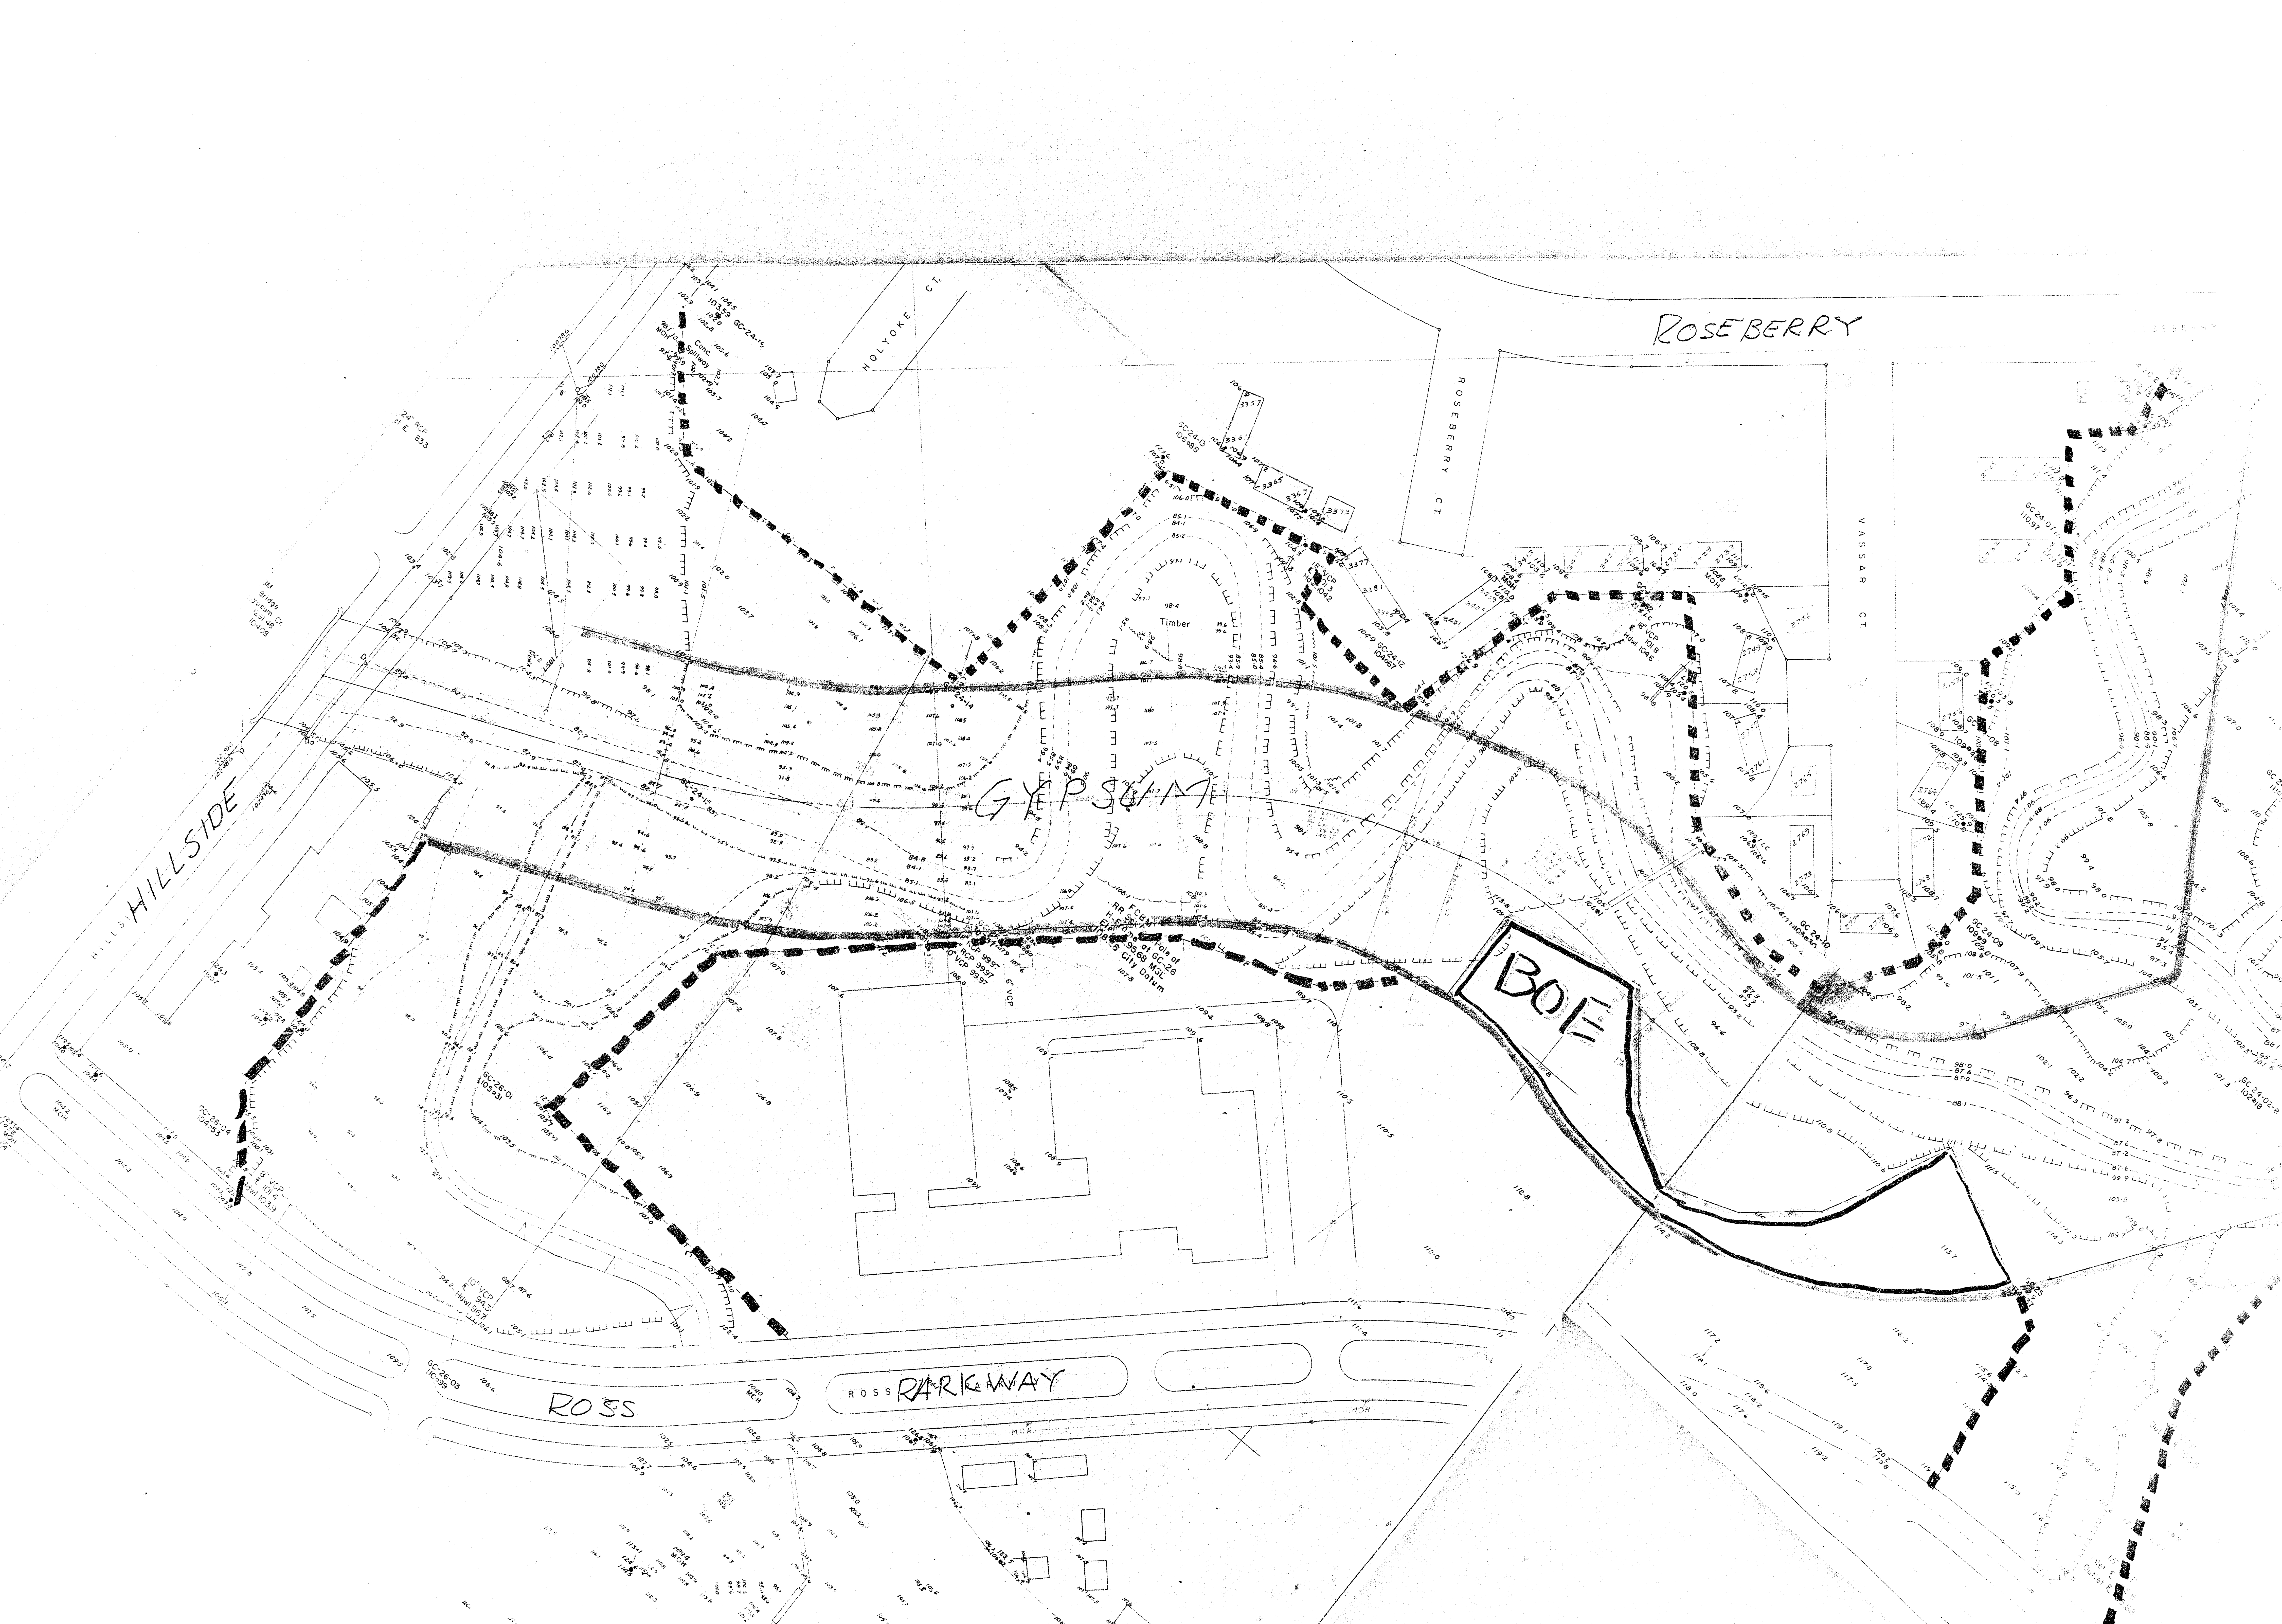

ROSEBERRY


GYP SUM

BOLE

ROSS PARKWAY

ROSS

HILLSIDE

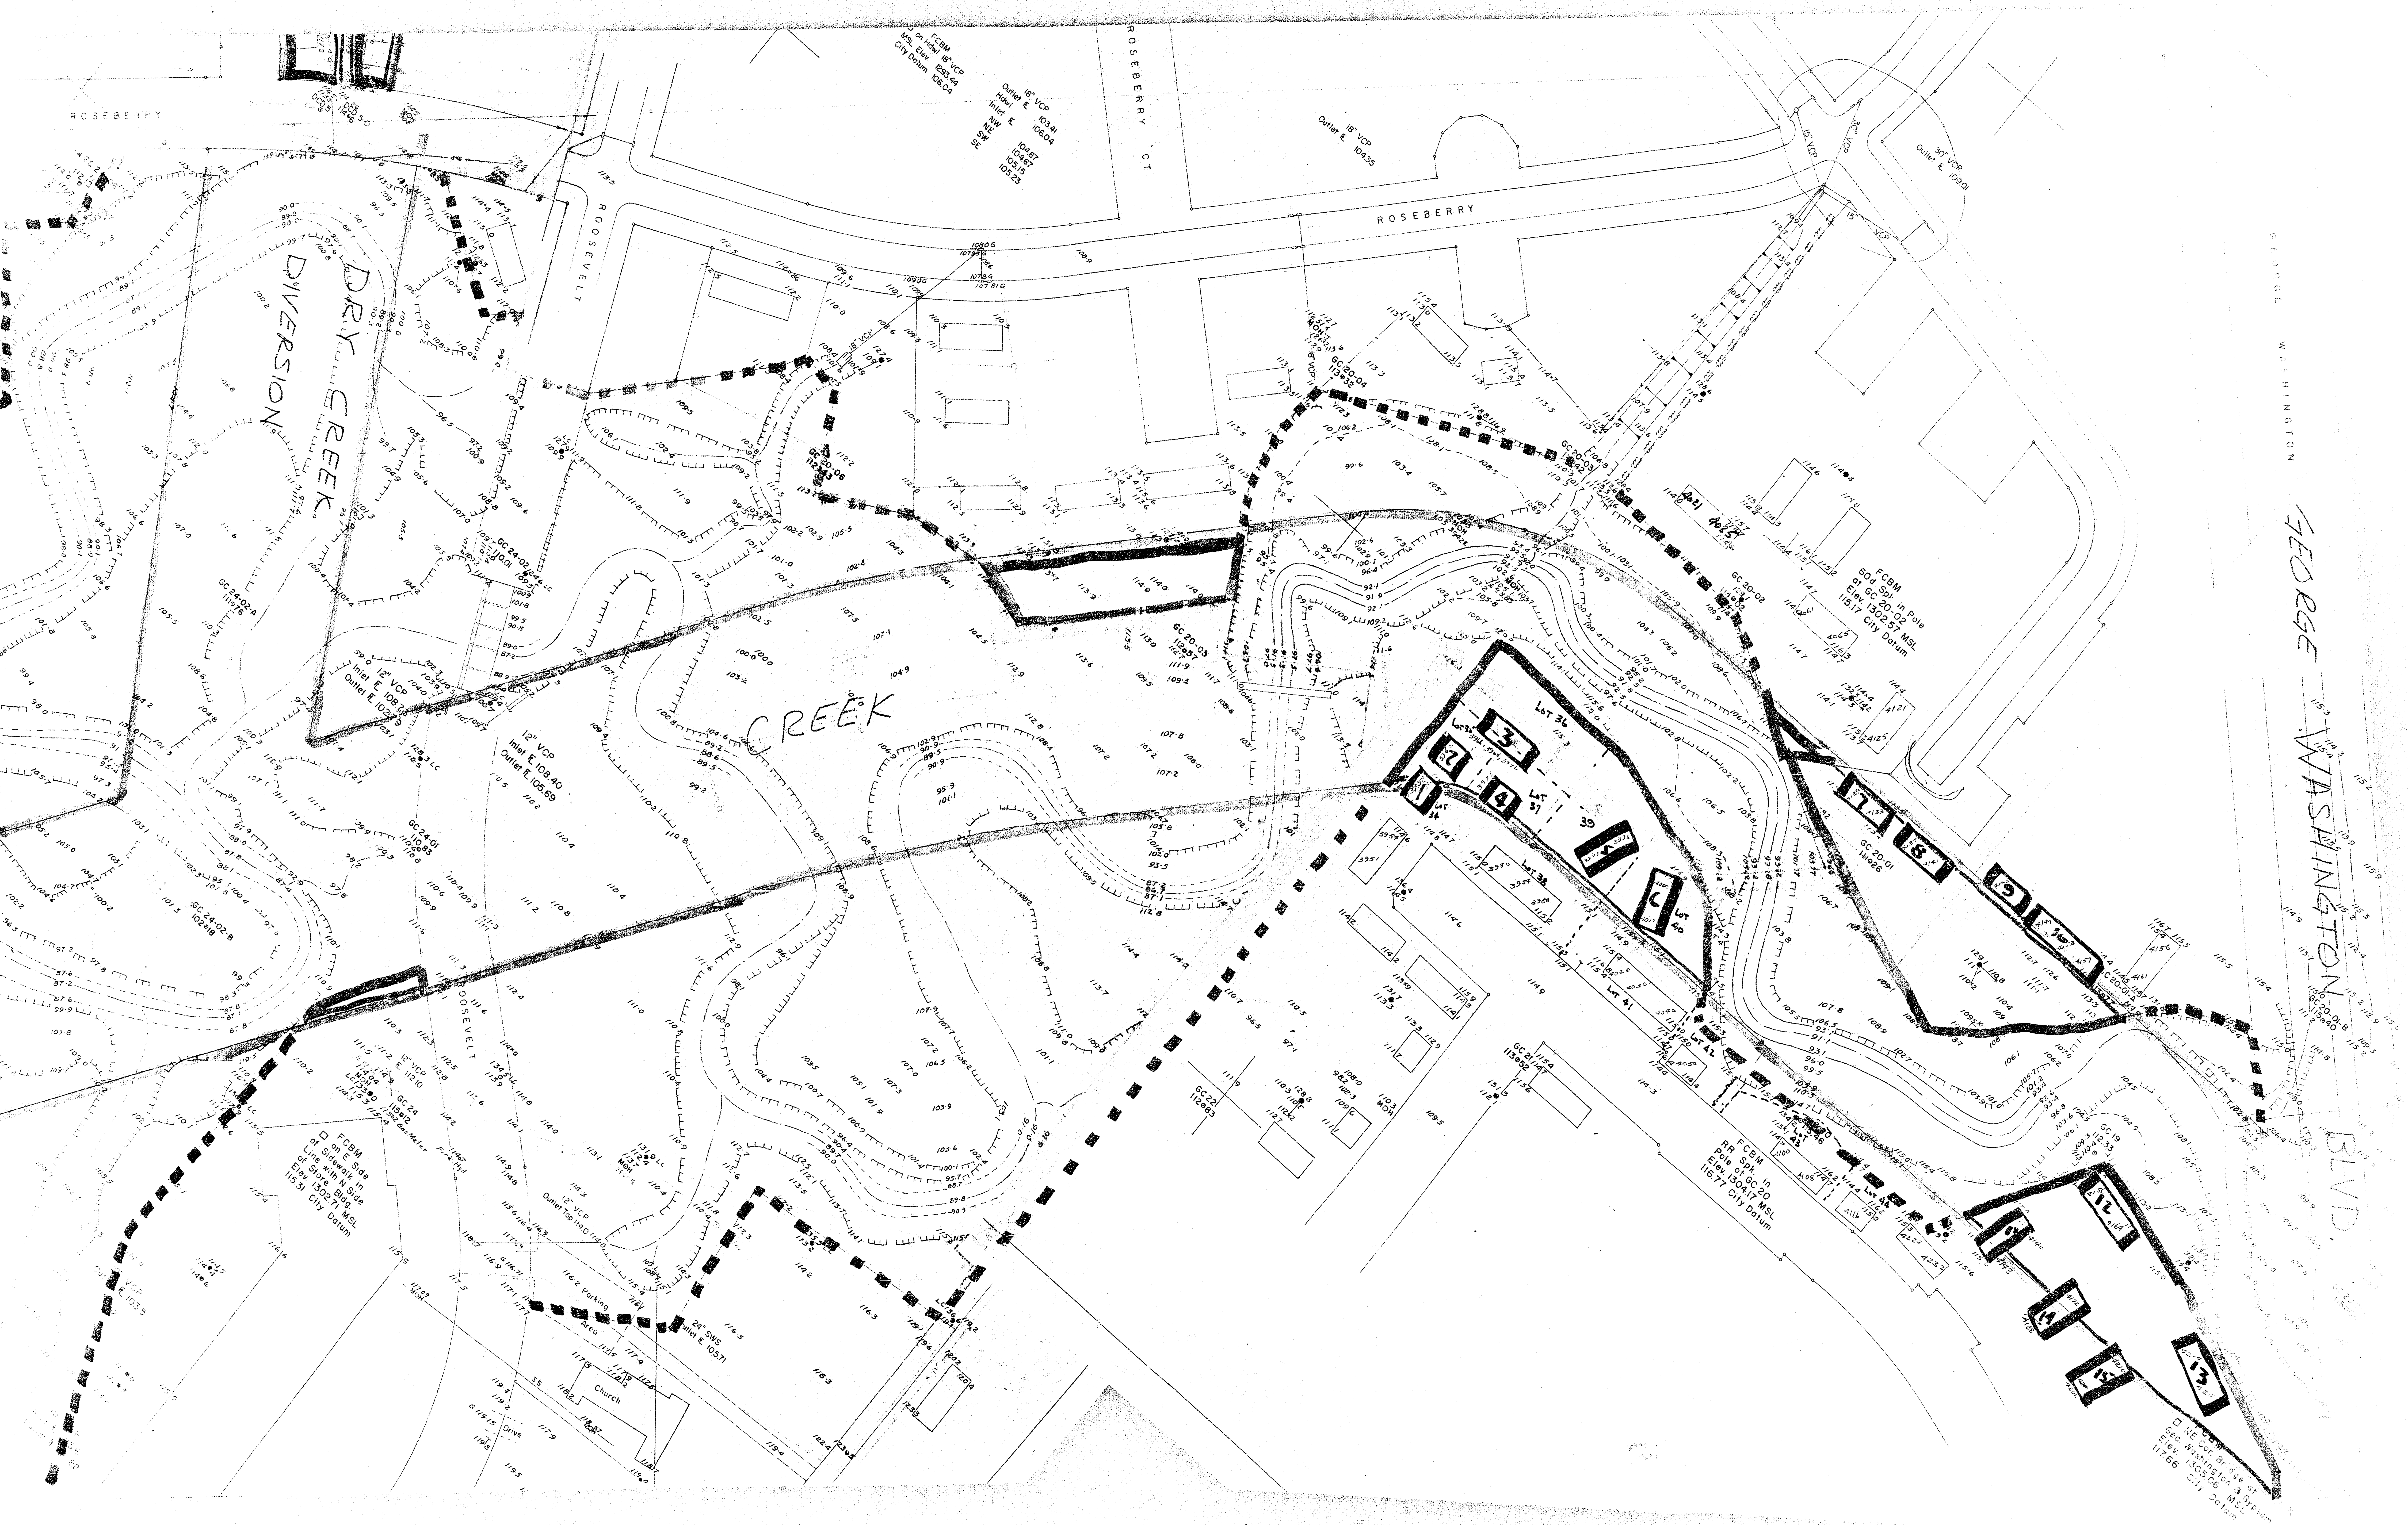

GEORGE WASHINGTON

GEORGE WASHINGTON

BLVD

