



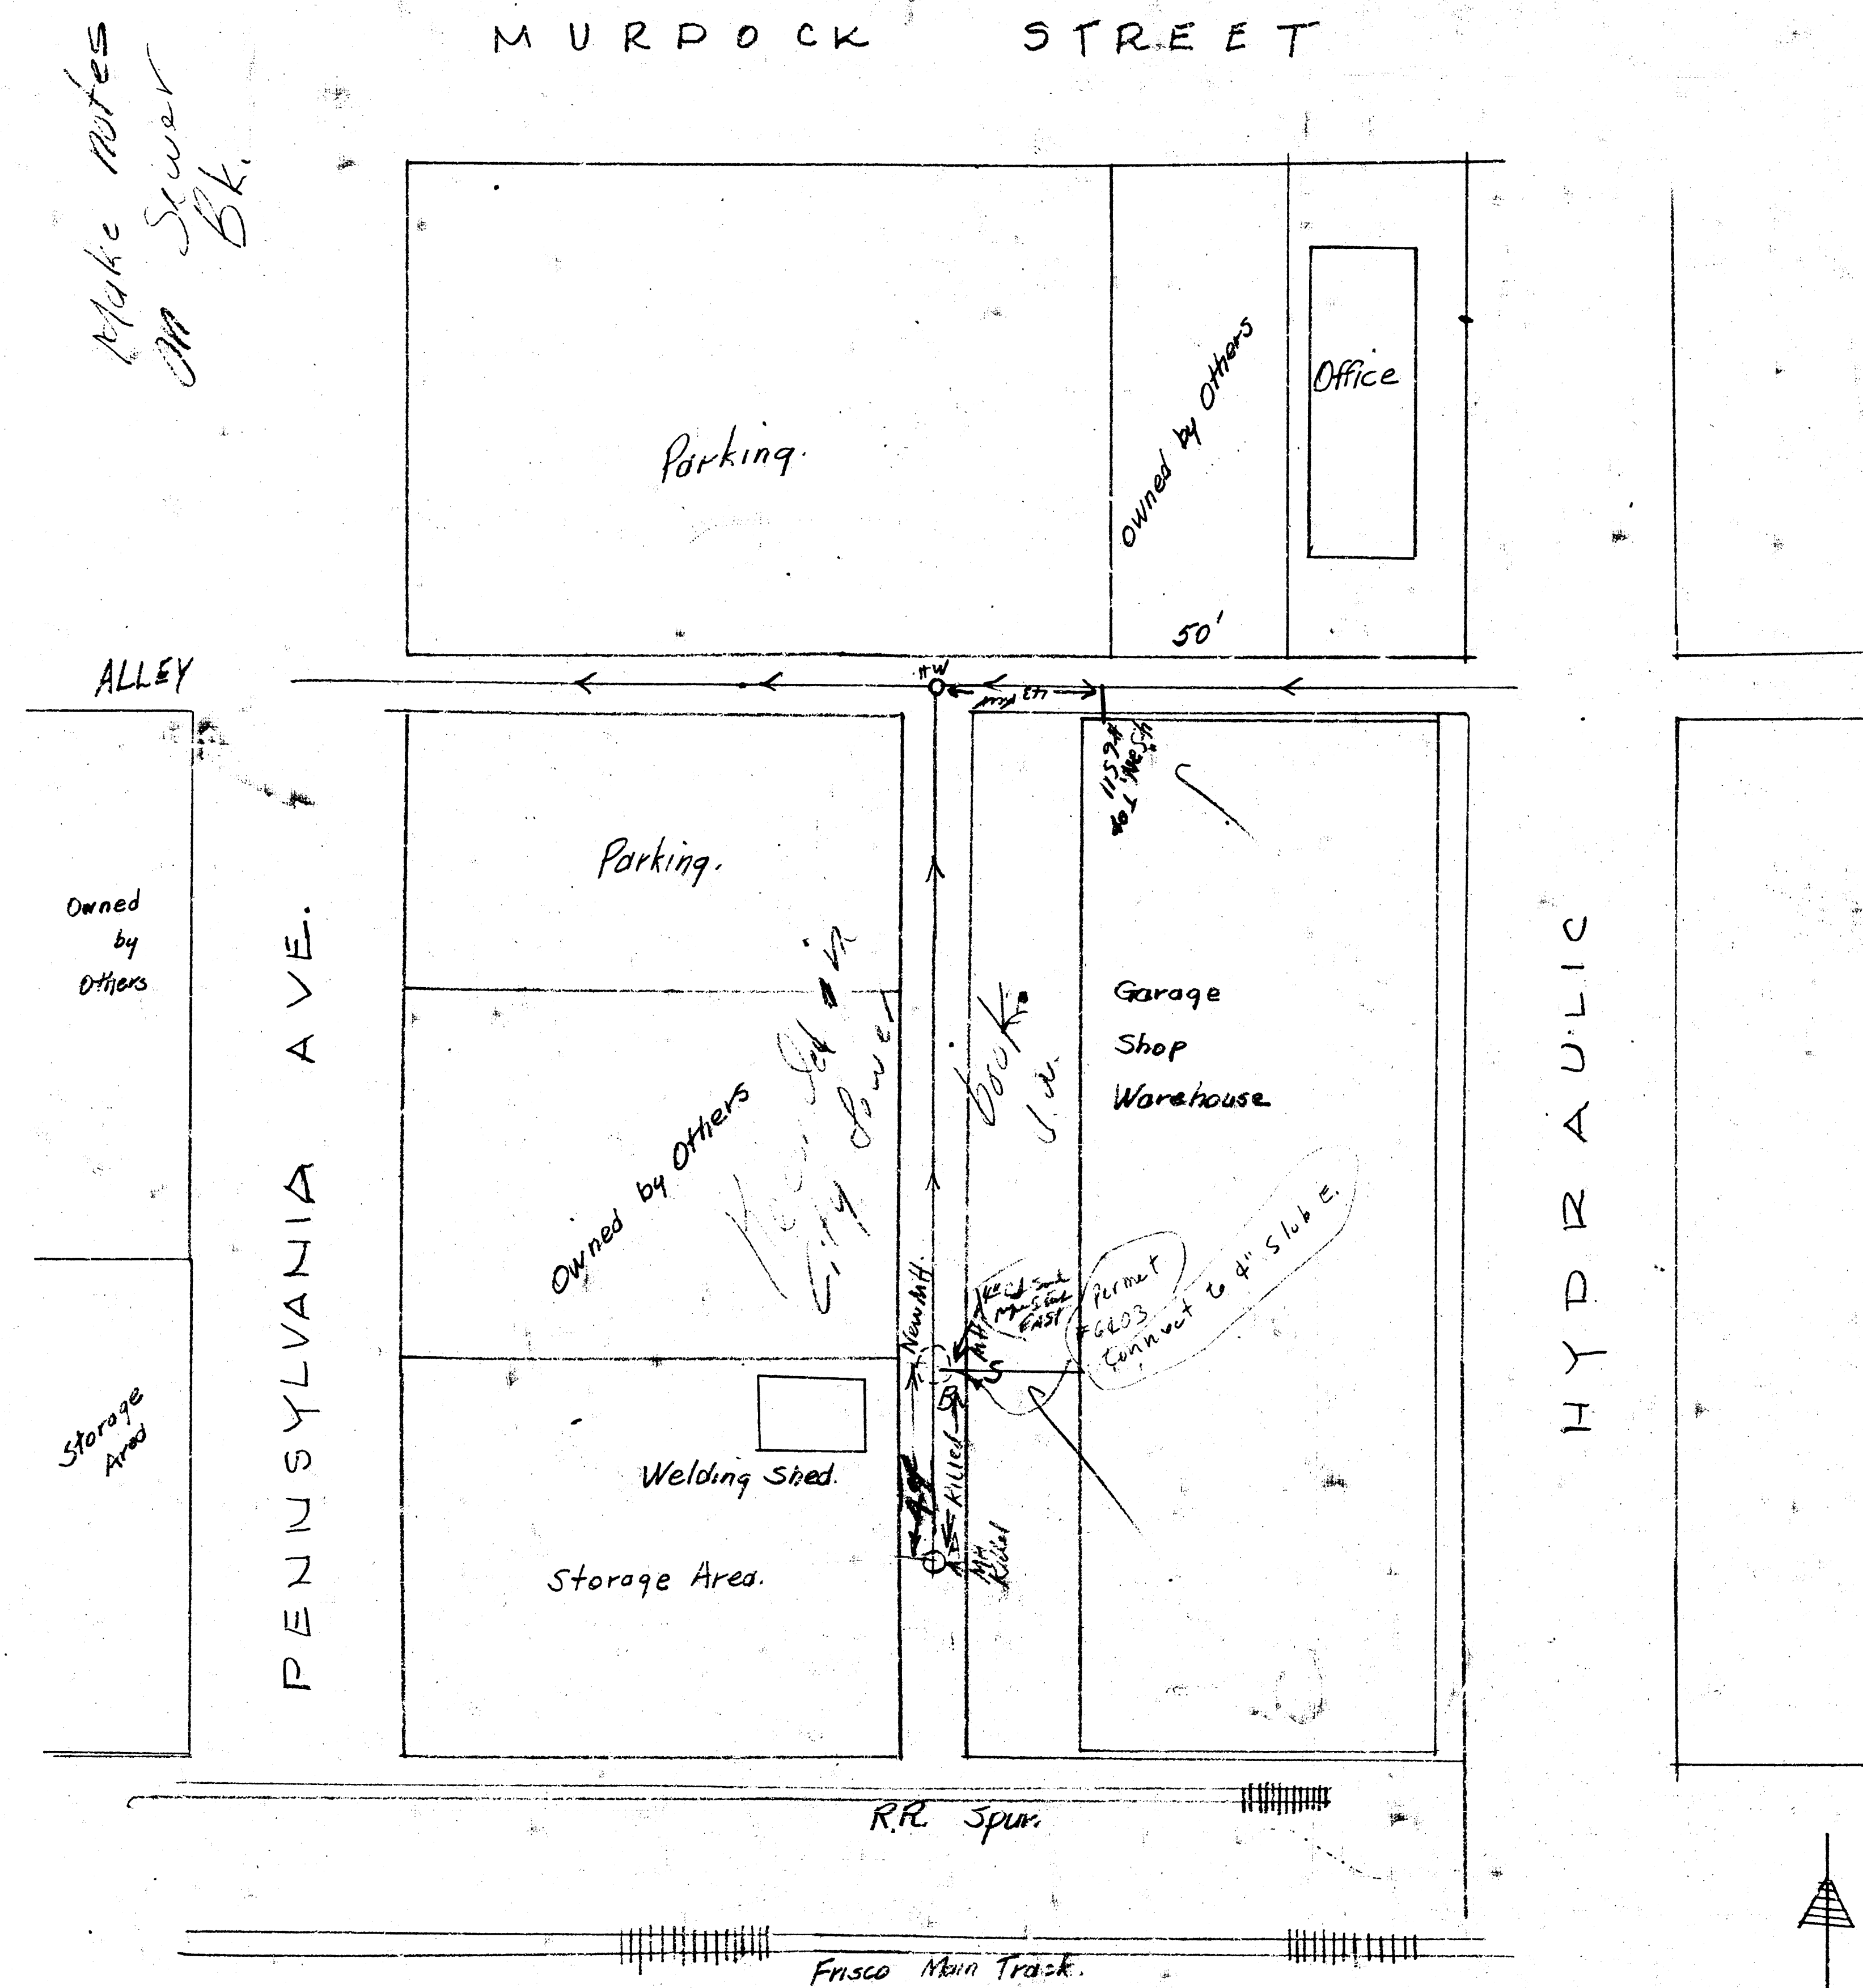

PLOT PLAN SCALE 1" = 30'

We propose to abandon sewer from point A to B. Construct new M.H. at B. Existing line has failed and is stopped between these points. Area paved and dirt cover at A is 6'±. Cover at B is 1'±. Sewer Service will not be required beyond point B. Contractor agrees to construct M.H. B as required.

Gas Service Building
M.G. Griffin

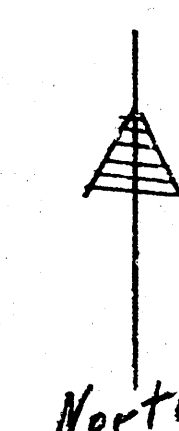

PLAN	DATE	BY	CHKD	NO.
NOTED	7-2-20			
NOTE BOOK				
NO.				

PROFILE	DATE	BY	CHKD	NO.
NOTED	7-2-20			
NOTE BOOK				
NO.				

