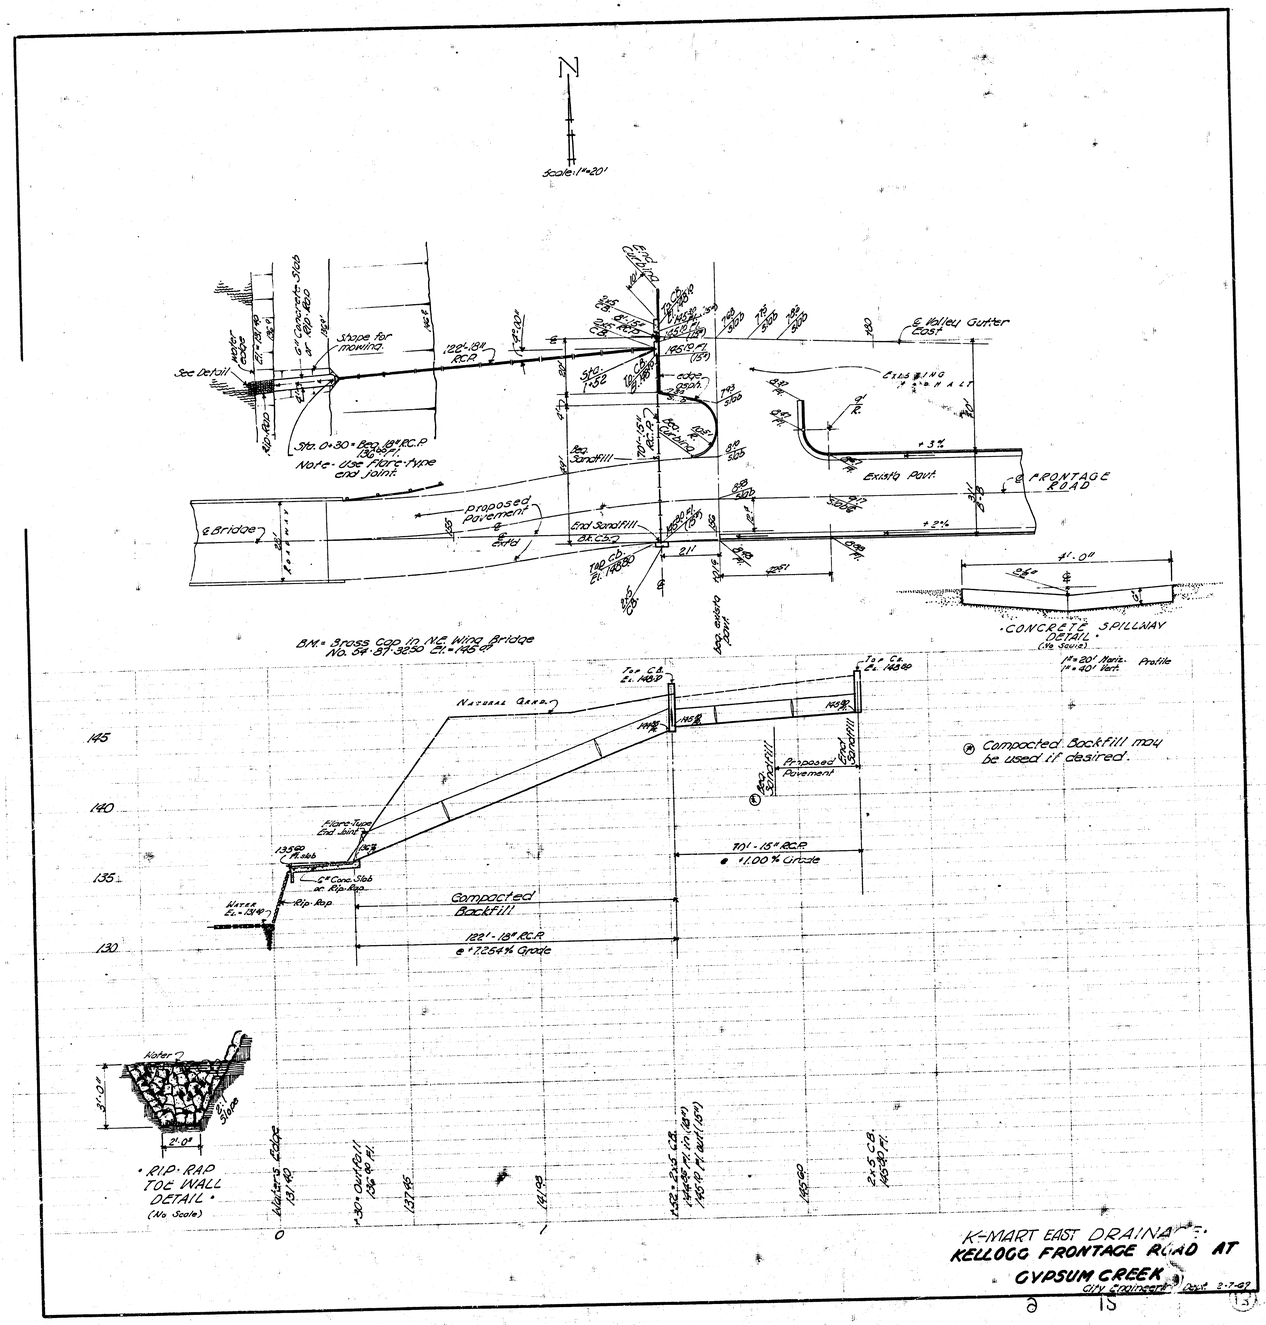

N
Scale: 1"=20'
See Detail
Shape for moving.
122'-18" RCP
Sta. 0+30 - Beg. 18" RCP (Tbl.)
Note - Use Flare-Type End Joint
Sta. 1+52
Existg Pavt.
E. FRONTAGE ROAD
E. Bridge
proposed pavement
End Sandfill
Beg. Sandfill
E. Rolled Gutter Cast.
CURBING
4'-0"
CONCRETE SPILLWAY DETAIL
(No Scale)
BM = Brass Cap in NE Wing Bridge
No. 64-37-3850 El. = 145.69
Natural Grade
Flare-Type End Joint
13580 Abt.
2" Conc. Slab on Rip-Rap
Rip-Rap
Water El. = 134.0
Compacted Backfill
122'-18" RCP @ 1.2254% Grade
701'-15" RCP @ 1.00% Grade
Proposed Pavement
End Sandfill
Beg. Sandfill
Compacted Backfill may be used if desired.
Water
3'-0"
Slope
21.0'
RIP-RAP TOE WALL DETAIL
(No Scale)
Profile
1"=20' Horiz.
1"=10' Vert.
K-MART EAST DRAINAGE
KELLOGG FRONTAGE ROAD AT GYPSUM CREEK

K mart

STORE NO.

DEVELOPED BY
COOGAN · WALTERS
SUITE 300 4501 RICHMOND
HOUSTON, TEXAS

HERBERT L. BERGER, ARCHITECT
2205 EAST DOUGLAS
WICHITA, KANSAS 67214

SHEET NO. P11

STORM SEWER NORTH OF K-MART EAST BUILDING
WICHITA, KANSAS

K-MART
FIN. FL. ELEVATION 1370

FOOD STORE

SCALE 1" = 60'-0"

602.5'

800'

14-6' BRANCHES STORM WATER K-MART #23, 6' FOOD STORE

FLOOD CONTROL LEVEE SYSTEM AND DRAINAGE

CITY OF WICHITA
DROP INLET
CB #'s 1, 2, 3, 4
(According City of Wichita Specs.)

DIA. 6'-0" I.D. REINFORCED CONCRETE CYLINDER

3'-0"

NOTE TO CONTRACTOR

This project will be constructed under the supervision of the CITY ENGINEER and conforming to the SPECIFICATIONS of the CITY OF WICHITA. The CONTRACTOR will reimburse the City of Wichita for all cost of Engineering and inspection.

CITY OF WICHITA

Approved does not relieve the contractor from any responsibility for errors or omissions, from not complying with applicable codes or regulations.

Date 7/14/66

Engineering Div.
































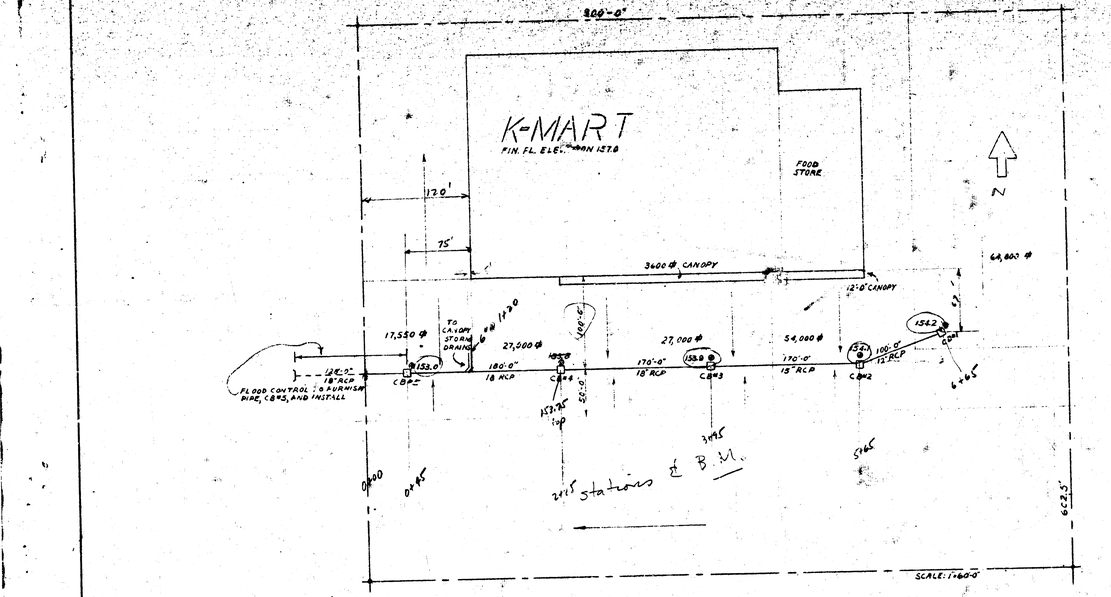

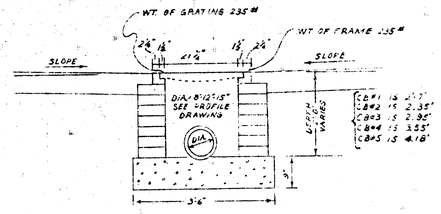


CITY OF WICHITA
DROP INLET
CB's #1,2,3,4,5
(ACCORDING CITY OF WICHITA SPECS.)

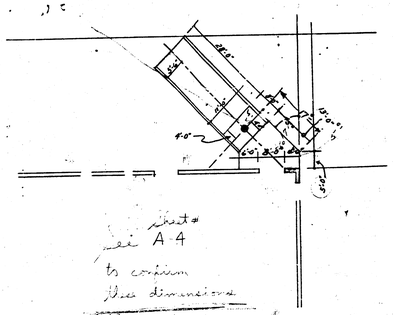

APPROVED AS NOTED
By CITY ENGINEER OF WICHITA
Sanitary Sewer
Storm Sewer
Driveway Approaches

CITY OF WICHITA
APPROVED. Approval does not relieve the contractor from the terms of the contract documents or for any failure in the equipment, work, or materials
Date 7/11/86
Engineering Div.

NOTE TO CONTRACTOR
This project will be constructed under the supervision of the CITY ENGINEER and conforming to the SPECIFICATIONS of the CITY OF WICHITA. The CONTRACTOR will reimburse the City of Wichita for all cost of engineering, inspection, and inspection.

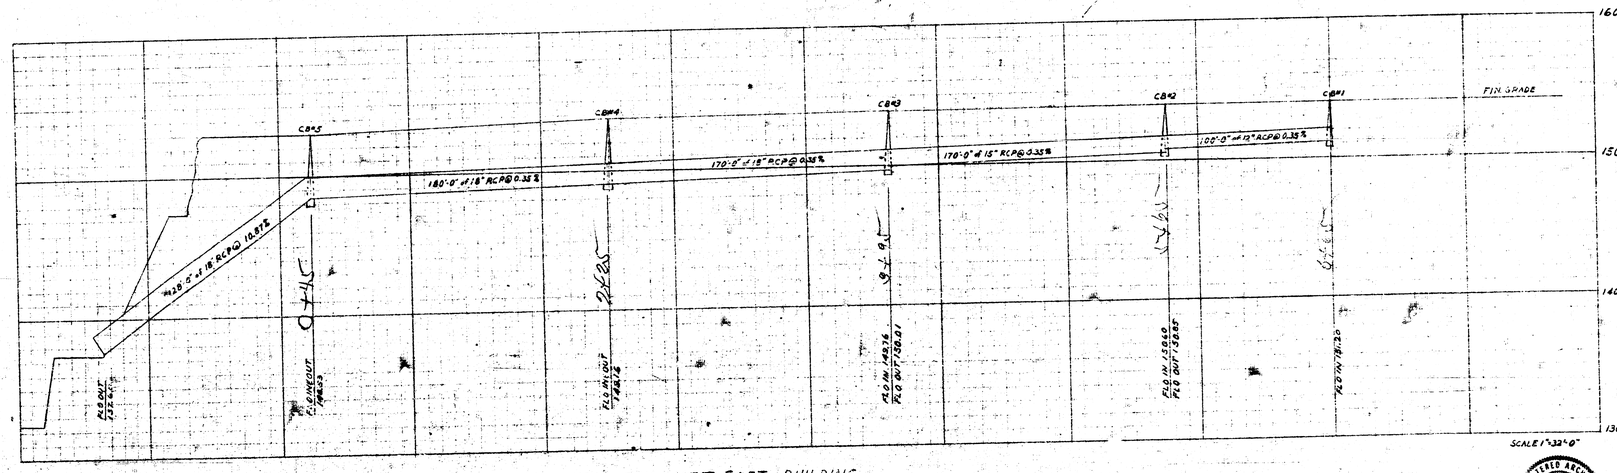

STORM SEWER SOUTH OF K-MART EAST BUILDING

K mart STORE NO.

SCALE:
SHEET NO. P12
OF 7 SHEETS
DATE: 2 D 10 '86

JOB NO.
REVISED:

BERGER ASSOCIATES
WICHITA, KANSAS