

NOTE TO CONTRACTOR

This project will be constructed under the supervision of the CITY ENGINEER and conforming to the SPECIFICATIONS of the CITY OF WICHITA. The CONTRACTOR will pay the City of Wichita for all costs of plan review, inspection and booking per contract.

APPROVED AS NOTED
By CITY ENGINEER OF WICHITA

Sanitary Sewers _____
 Storm Sewers 208 10/21/05
 Driveway Approaches _____
 Water Mains _____
 Paving _____


* Sta. 0+94 to Sta. 0+00 Only

REVISED NOVEMBER 20, 1985

**PRIVATE STORM WATER SEWER
 TO SERVE PART OF LOT 2 BLK 2,
 CHERRY CREEK HILLS ADDITION**

WICHITA, KANSAS

PROJECT NO. 488-76-245-80001-000-000-046

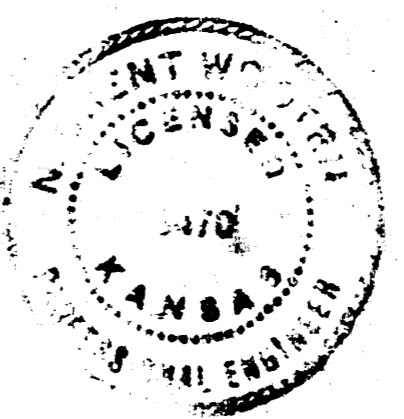


BAUGHMAN COMPANY, P.A.
 SURVEYING & ENGINEERING
 318/282-7271 • 330 LAURA • WICHITA, KANSAS 67211

FILMED FROM THE BEST



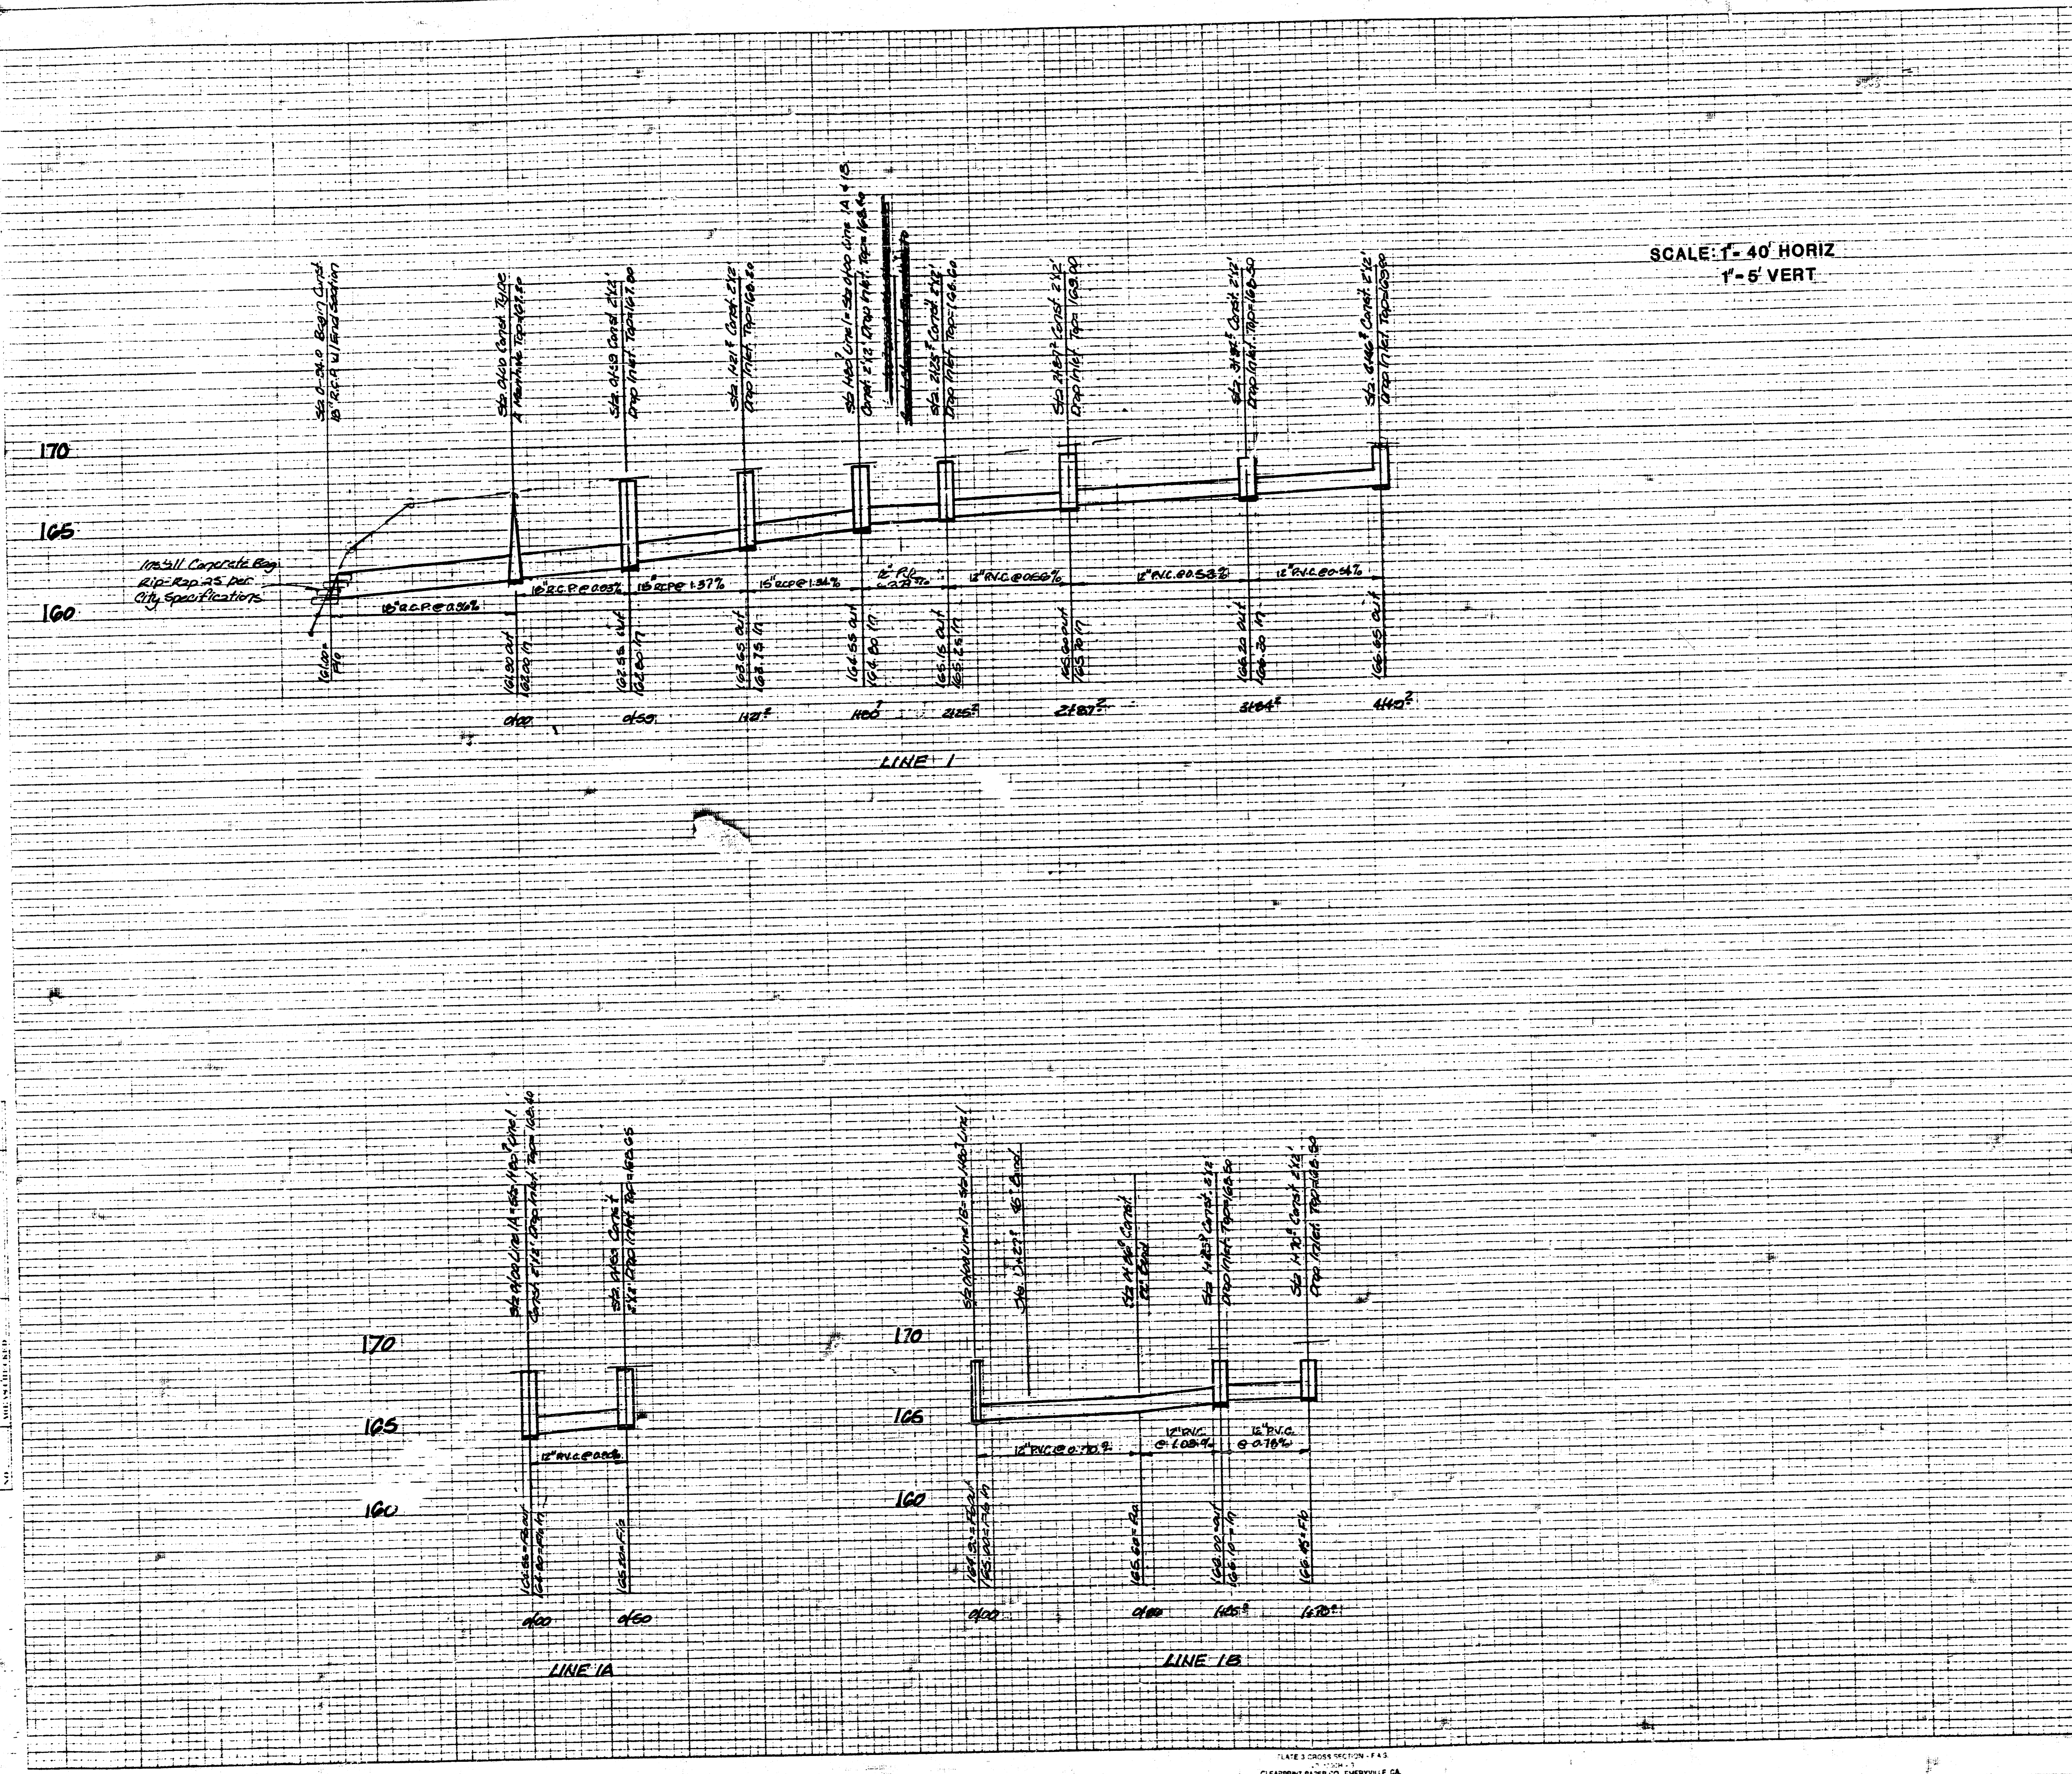

SCALE: 1" = 40' HORIZ
 1" = 5' VERT



BAUGHMAN COMPANY, P.A.
 SURVEYING & ENGINEERING
 316/282-7271 • 300 LAURA • WICHITA, KANSAS 67211