
PRIVATE STORM SEWER TO SERVE
COPELAND CORPORATION
3200 MAY
WICHITA, KANSAS 67213

PROJECT NO. 468-76-245-80001-000-000-004

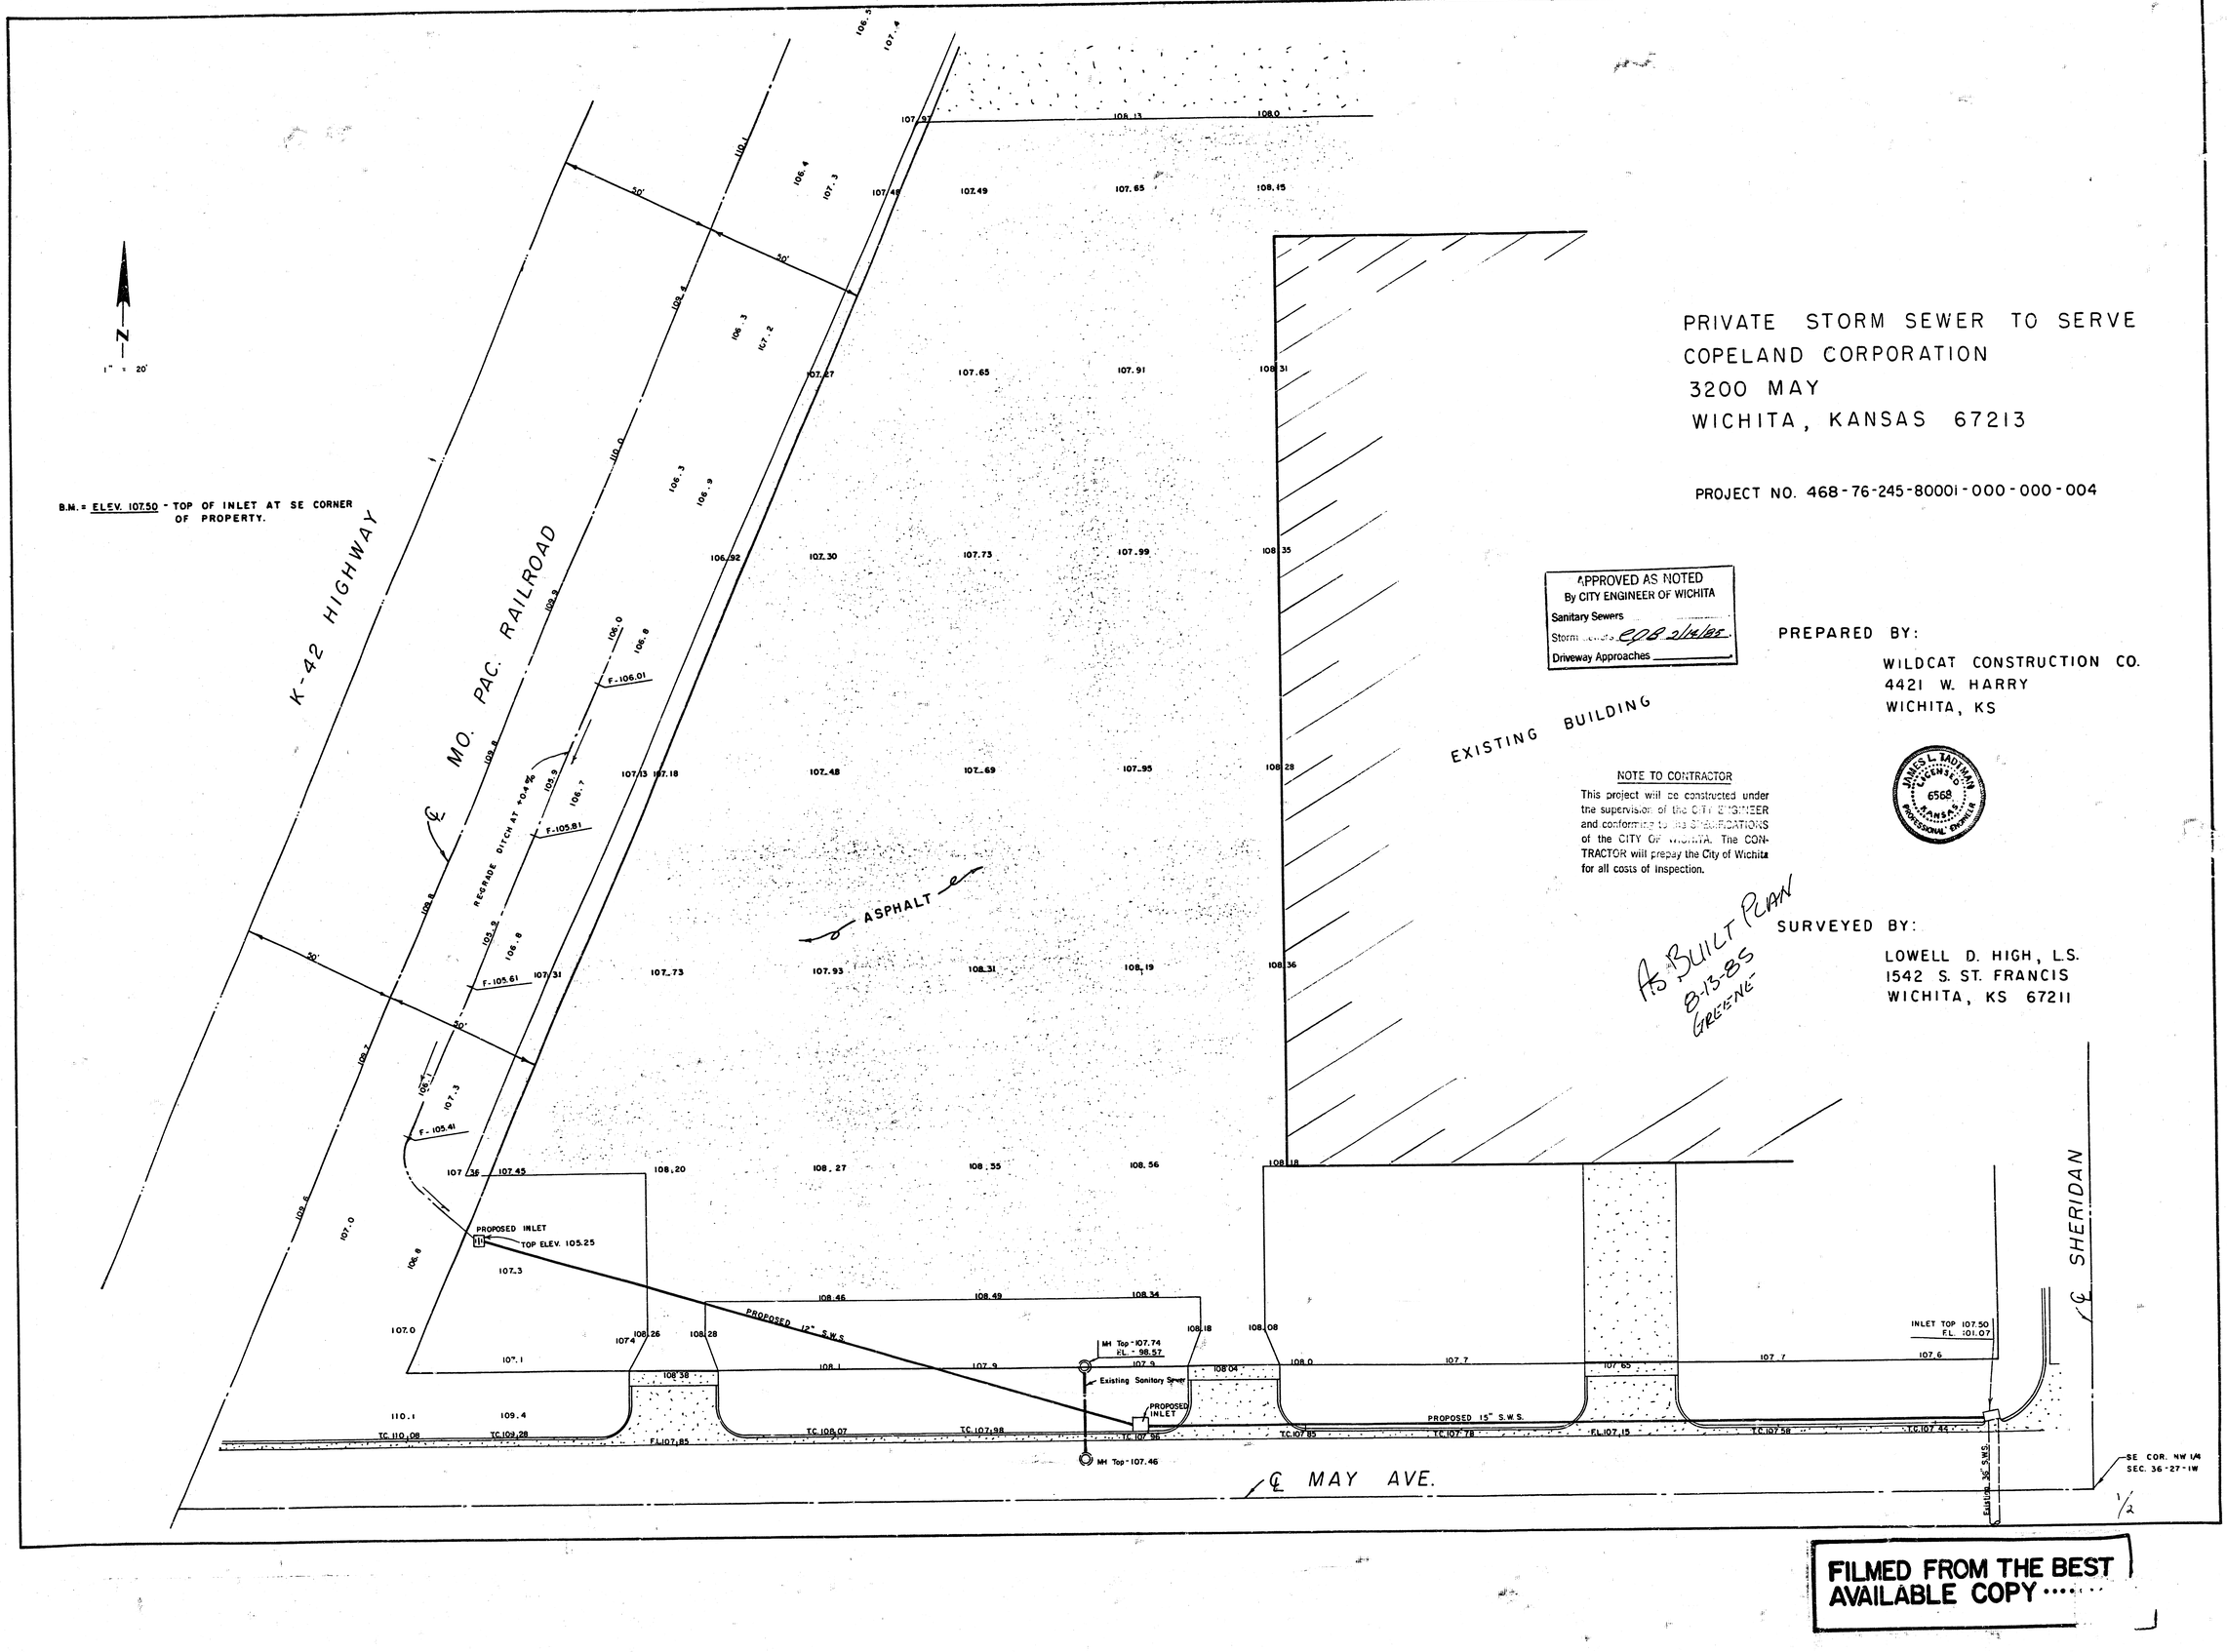

APPROVED AS NOTED
By CITY ENGINEER OF WICHITA
Sanitary Sewers
Storm ... 8/16/85
Driveway Approaches

PREPARED BY:

WILDCAT CONSTRUCTION CO.
4421 W. HARRY
WICHITA, KS

JAMES L. TADTMAN
LICENSED
6568
KANSAS
PROFESSIONAL ENGINEER

NOTE TO CONTRACTOR

This project will be constructed under the supervision of the CITY ENGINEER and conforming to its SPECIFICATIONS of the CITY OF WICHITA. The CONTRACTOR will prepay the City of Wichita for all costs of inspection.


As Built Plan
8-13-85
GREENE

SURVEYED BY:

LOWELL D. HIGH, L.S.
1542 S. ST. FRANCIS
WICHITA, KS 67211

1/2

FILMED FROM THE BEST AVAILABLE COPY

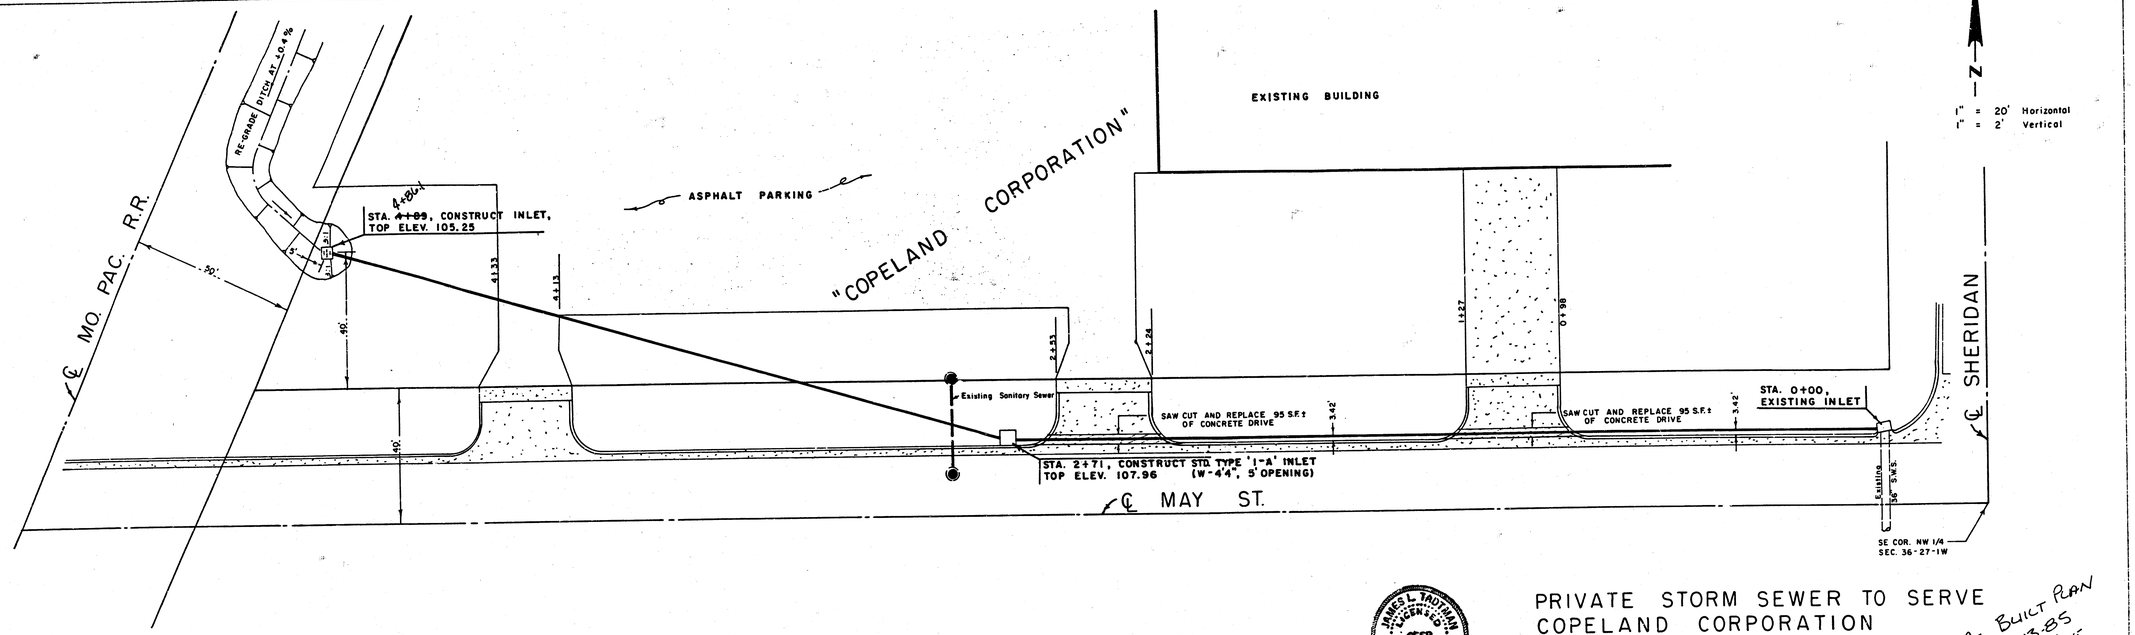

B.M. = ELEV. 107.50 - TOP OF INLET AT SE CORNER OF PROPERTY.

JAMES L. TRAUTMAN LICENSED 6568 KANSAS PROFESSIONAL ENGINEER

PRIVATE STORM SEWER TO SERVE COPELAND CORPORATION

As Built Plan 8-13-85 GREENE

PROJECT NO. 468-76-245-80001-000-000-004

PLAN — SURVEYED / PLOTTED / NOTE BOOK / No. / ALIGNMENT CHECKED / PT. OF BEG. / PT. OF END / BY / DATE

PROFILE — SURVEYED / PLOTTED / DRAWN / CHECKED / B.M. NOTED / STRUCTURE NOTATIONS CHECKED / NOTE BOOK / No. / BY / DATE

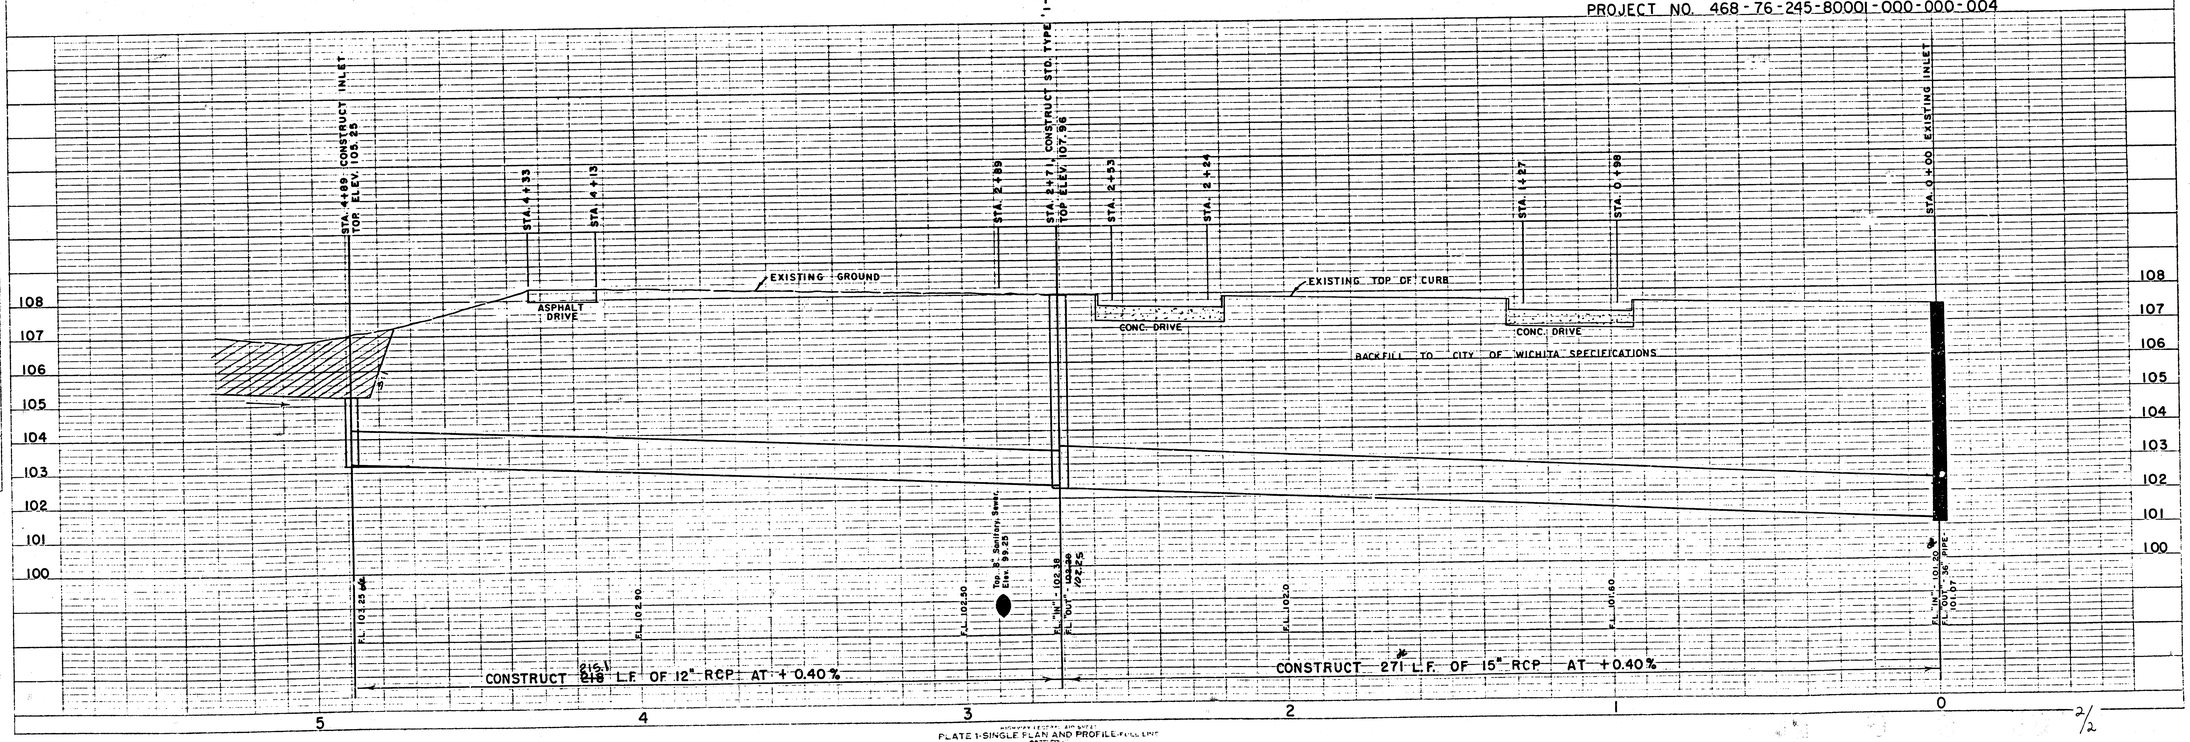


PLATE 1-SINGLE PLAN AND PROFILE-FULL LINE

2/2

FILMED FROM THE BEST AVAILABLE COPY.....